
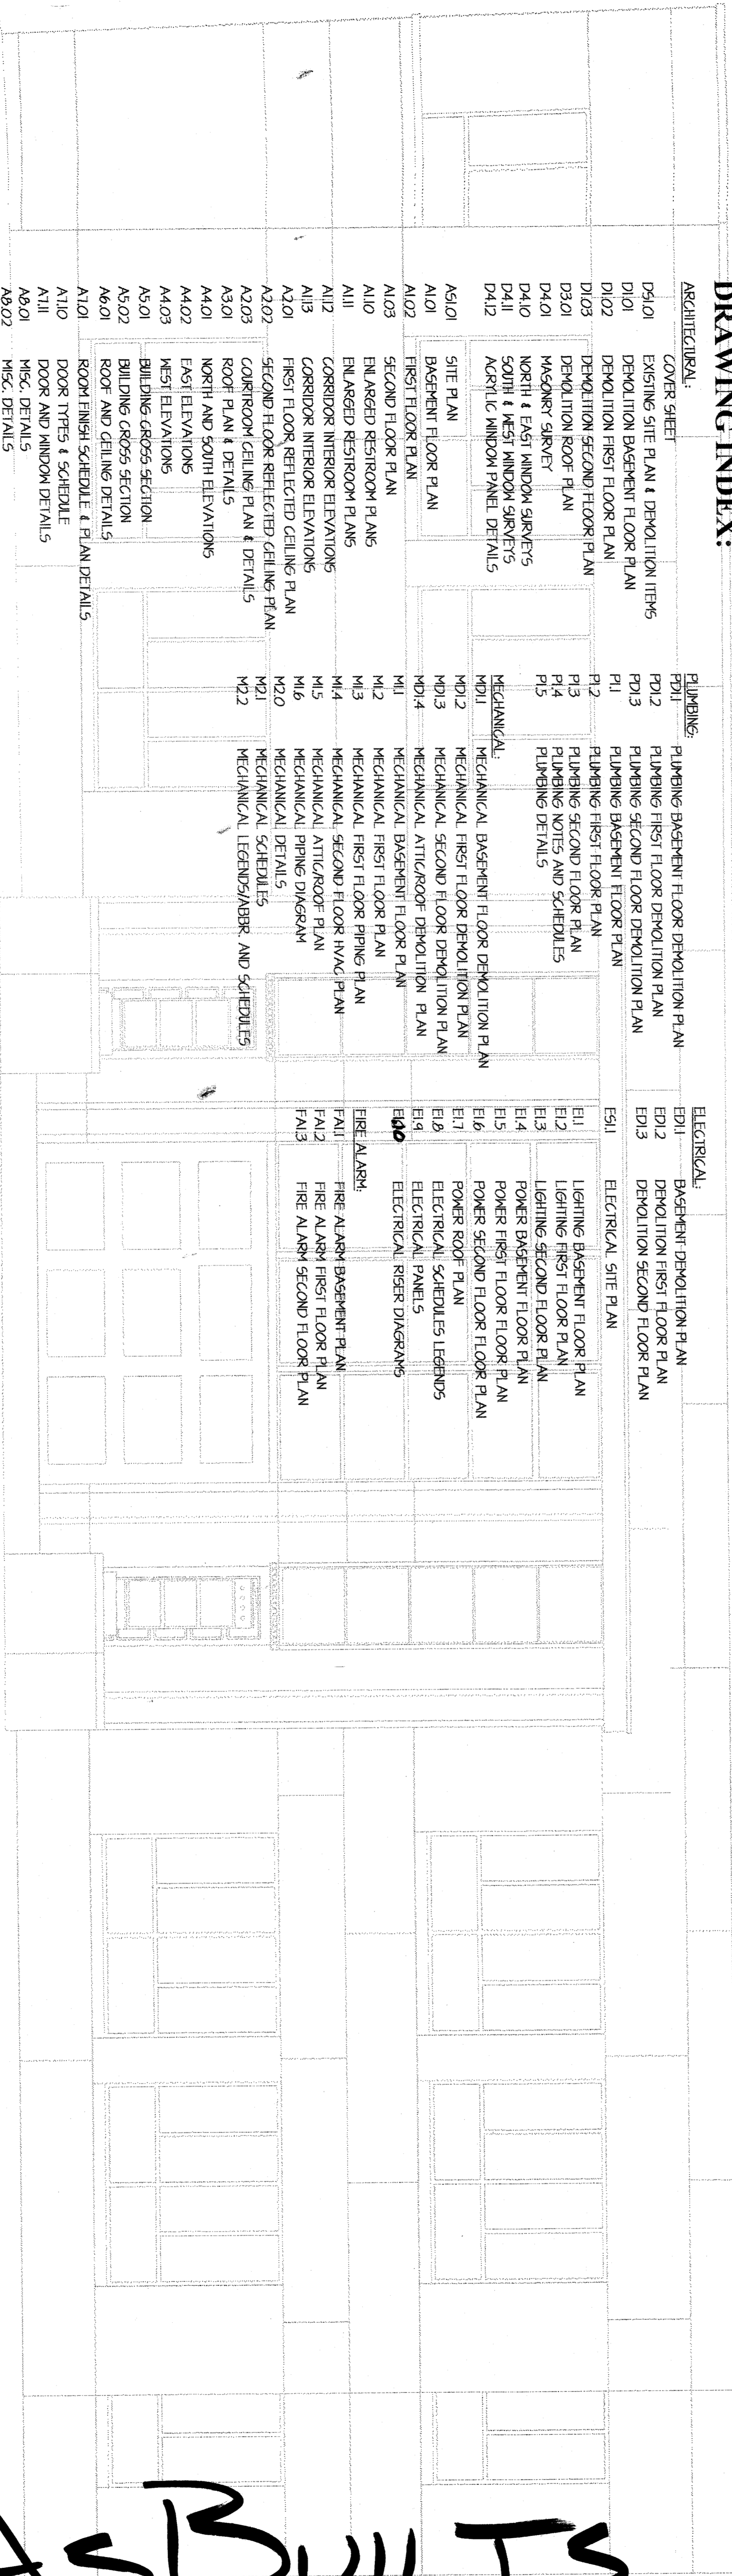


BURNET COUNTY COURTHOUSE RESTORATION AND RENOVATION

220 S. PIERCE STREET
BURNET, TEXAS 78611
JUDGE MARTIN McLEAN

PROJECT DATA	
BUILDING SQUARE FOOTAGE	
BASEMENT	3,551 S.F.
FIRST FLOOR	8,716 S.F.
SECOND FLOOR	1,021 S.F.
TOTAL	14,348 S.F.

AS BUILTS

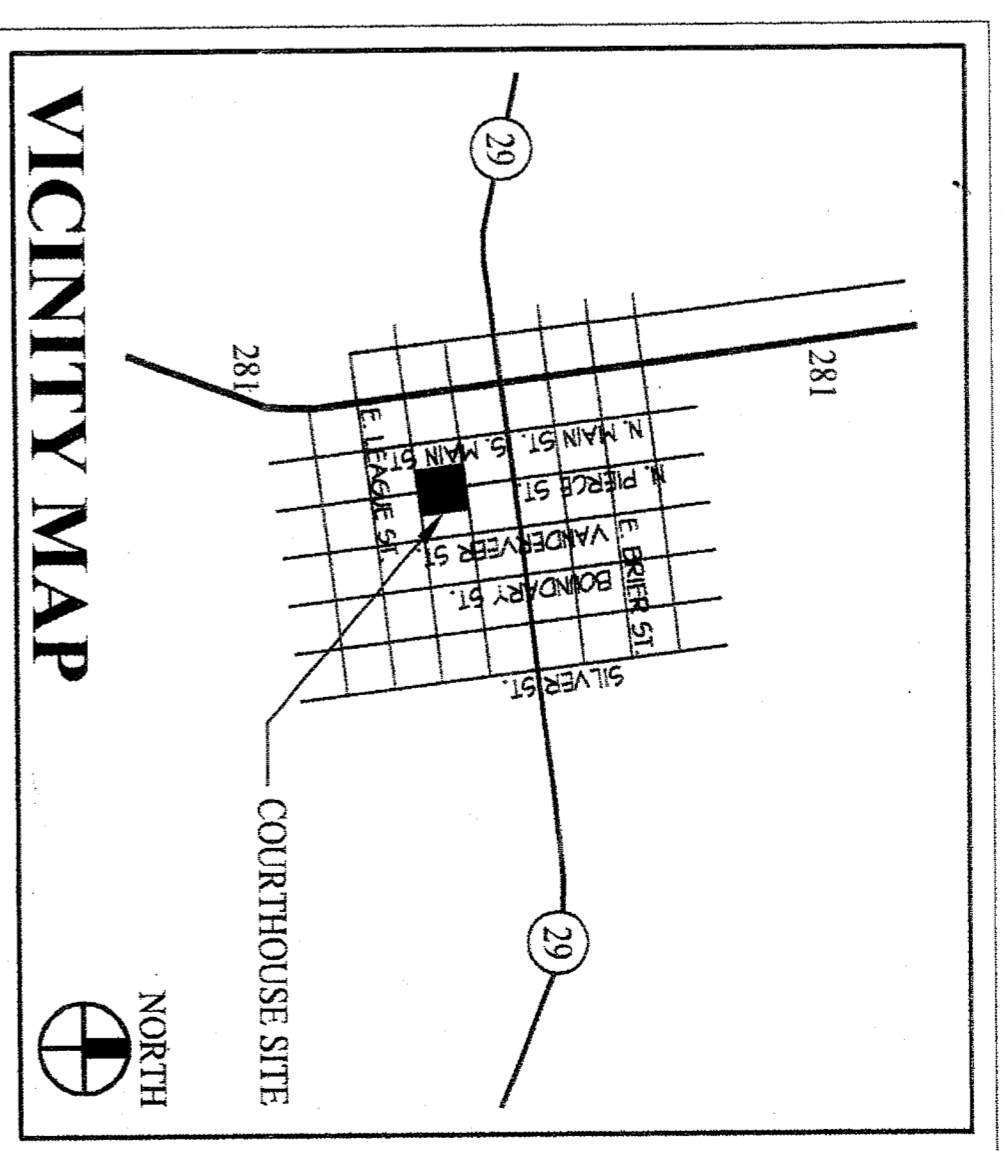

DRAWING INDEX:

ARCHITECTURAL:	PLUMBING:	ELECTRICAL:
COVER SHEET	P1.01 PLUMBING BASEMENT FLOOR DEMOLITION PLAN	E1.01 BASEMENT DEMOLITION PLAN
D1.01 EXISTING SITE PLAN & DEMOLITION ITEMS	P1.02 PLUMBING FIRST FLOOR DEMOLITION PLAN	E1.02 DEMOLITION FIRST FLOOR PLAN
D1.02 DEMOLITION BASEMENT FLOOR PLAN	P1.03 PLUMBING SECOND FLOOR DEMOLITION PLAN	E1.03 DEMOLITION SECOND FLOOR PLAN
D1.03 DEMOLITION FIRST FLOOR PLAN	P1.04 PLUMBING BASEMENT FLOOR PLAN	E1.04 ELECTRICAL SITE PLAN
D2.01 DEMOLITION SECOND FLOOR PLAN	P1.05 PLUMBING FIRST FLOOR PLAN	E1.05 LIGHTING BASEMENT FLOOR PLAN
D3.01 DEMOLITION ROOF PLAN	P1.06 PLUMBING SECOND FLOOR PLAN	E1.06 LIGHTING FIRST FLOOR PLAN
D4.01 MASONRY SURVEY	P1.07 PLUMBING NOTES AND SCHEDULES	E1.07 LIGHTING SECOND FLOOR PLAN
D4.02 NORTH & EAST WINDOW SURVEYS		E1.08 POWER BASEMENT FLOOR PLAN
D4.03 SOUTH & WEST WINDOW SURVEYS		E1.09 POWER FIRST FLOOR FLOOR PLAN
D4.04 AGRICULTURAL WINDOW PANEL DETAILS		E1.10 POWER SECOND FLOOR FLOOR PLAN
D4.05		E1.11 POWER ROOF PLAN
A1.01 SITE PLAN	MECHANICAL:	E1.12 POWER SECOND FLOOR FLOOR PLAN
A1.02 BASEMENT FLOOR PLAN	M1.01 MECHANICAL BASEMENT FLOOR DEMOLITION PLAN	E1.13 ELECTRICAL SCHEDULES LEGENDS
A1.03 FIRST FLOOR PLAN	M1.02 MECHANICAL FIRST FLOOR DEMOLITION PLAN	E1.14 ELECTRICAL PANEL S
A1.04 ENLARGED RESTROOM PLANS	M1.03 MECHANICAL SECOND FLOOR DEMOLITION PLAN	E1.15 ELECTRICAL RISER DIAGRAMS
A1.05 ENLARGED RESTROOM PLANS	M1.04 MECHANICAL ATTIC/ROOF DEMOLITION PLAN	
A1.06 CORRIDOR INTERIOR ELEVATIONS	M1.05 MECHANICAL FIRST FLOOR PIPING PLAN	FIRE ALARM:
A1.07 CORRIDOR INTERIOR ELEVATIONS	M1.06 MECHANICAL SECOND FLOOR HVAC PLAN	FA1.01 FIRE ALARM BASEMENT PLAN
A2.01 FIRST FLOOR REFLECTED CEILING PLAN	M1.07 MECHANICAL ATTIC/ROOF PLAN	FA1.02 FIRE ALARM FIRST FLOOR PLAN
A2.02 SECOND FLOOR REFLECTED CEILING PLAN	M1.08 MECHANICAL PIPING DIAGRAM	FA1.03 FIRE ALARM SECOND FLOOR PLAN
A2.03 COURTROOM CEILING PLAN & DETAILS	M1.09 MECHANICAL DETAILS	
A3.01 ROOF PLAN & DETAILS	M1.10 MECHANICAL LEGENDS/SYMBOLS AND SCHEDULES	
A4.01 NORTH AND SOUTH ELEVATIONS		
A4.02 EAST ELEVATIONS		
A4.03 WEST ELEVATIONS		
A5.01 BUILDING GROSS SECTION		
A5.02 BUILDING GROSS SECTION		
A6.01 ROOM AND CEILING DETAILS		
A7.01 ROOM FINISH SCHEDULE & PLAN DETAILS		
A1.10 DOOR TYPES & SCHEDULE		
A1.11 DOOR AND WINDOW DETAILS		
A1.12 MISC. DETAILS		
A1.13 MISC. DETAILS		

ARCHITECT

**11
15**

HAVEN THIBERTS ARCHITECTS INC.
807 ROCK STREET
GROKETTOWN, TEXAS 78626
TEL. 512.869.1104 FAX 512.869.1182

MECHANICAL/ELECTRICAL ENGINEER

**M
YERS &
ASSOCIATES**

455 HWY. 195, Georgetown, Tx. 78628
Ph. (512) 868-2058
Fx. (512) 868-6839

ENVIRONMENTAL & MATERIALS ENGINEER

HVJ ASSOCIATES, INC.
3604 SOUTH 2ND STREET
SUITE D-100
AUSTIN, TEXAS 78704
PH. (512) 441-4081
FX. (512) 443-3442


ISSUED FOR BID

DATE: 03/18/2002

AS BUILTS

DAVID YOUNG Do Not REMOVE

37

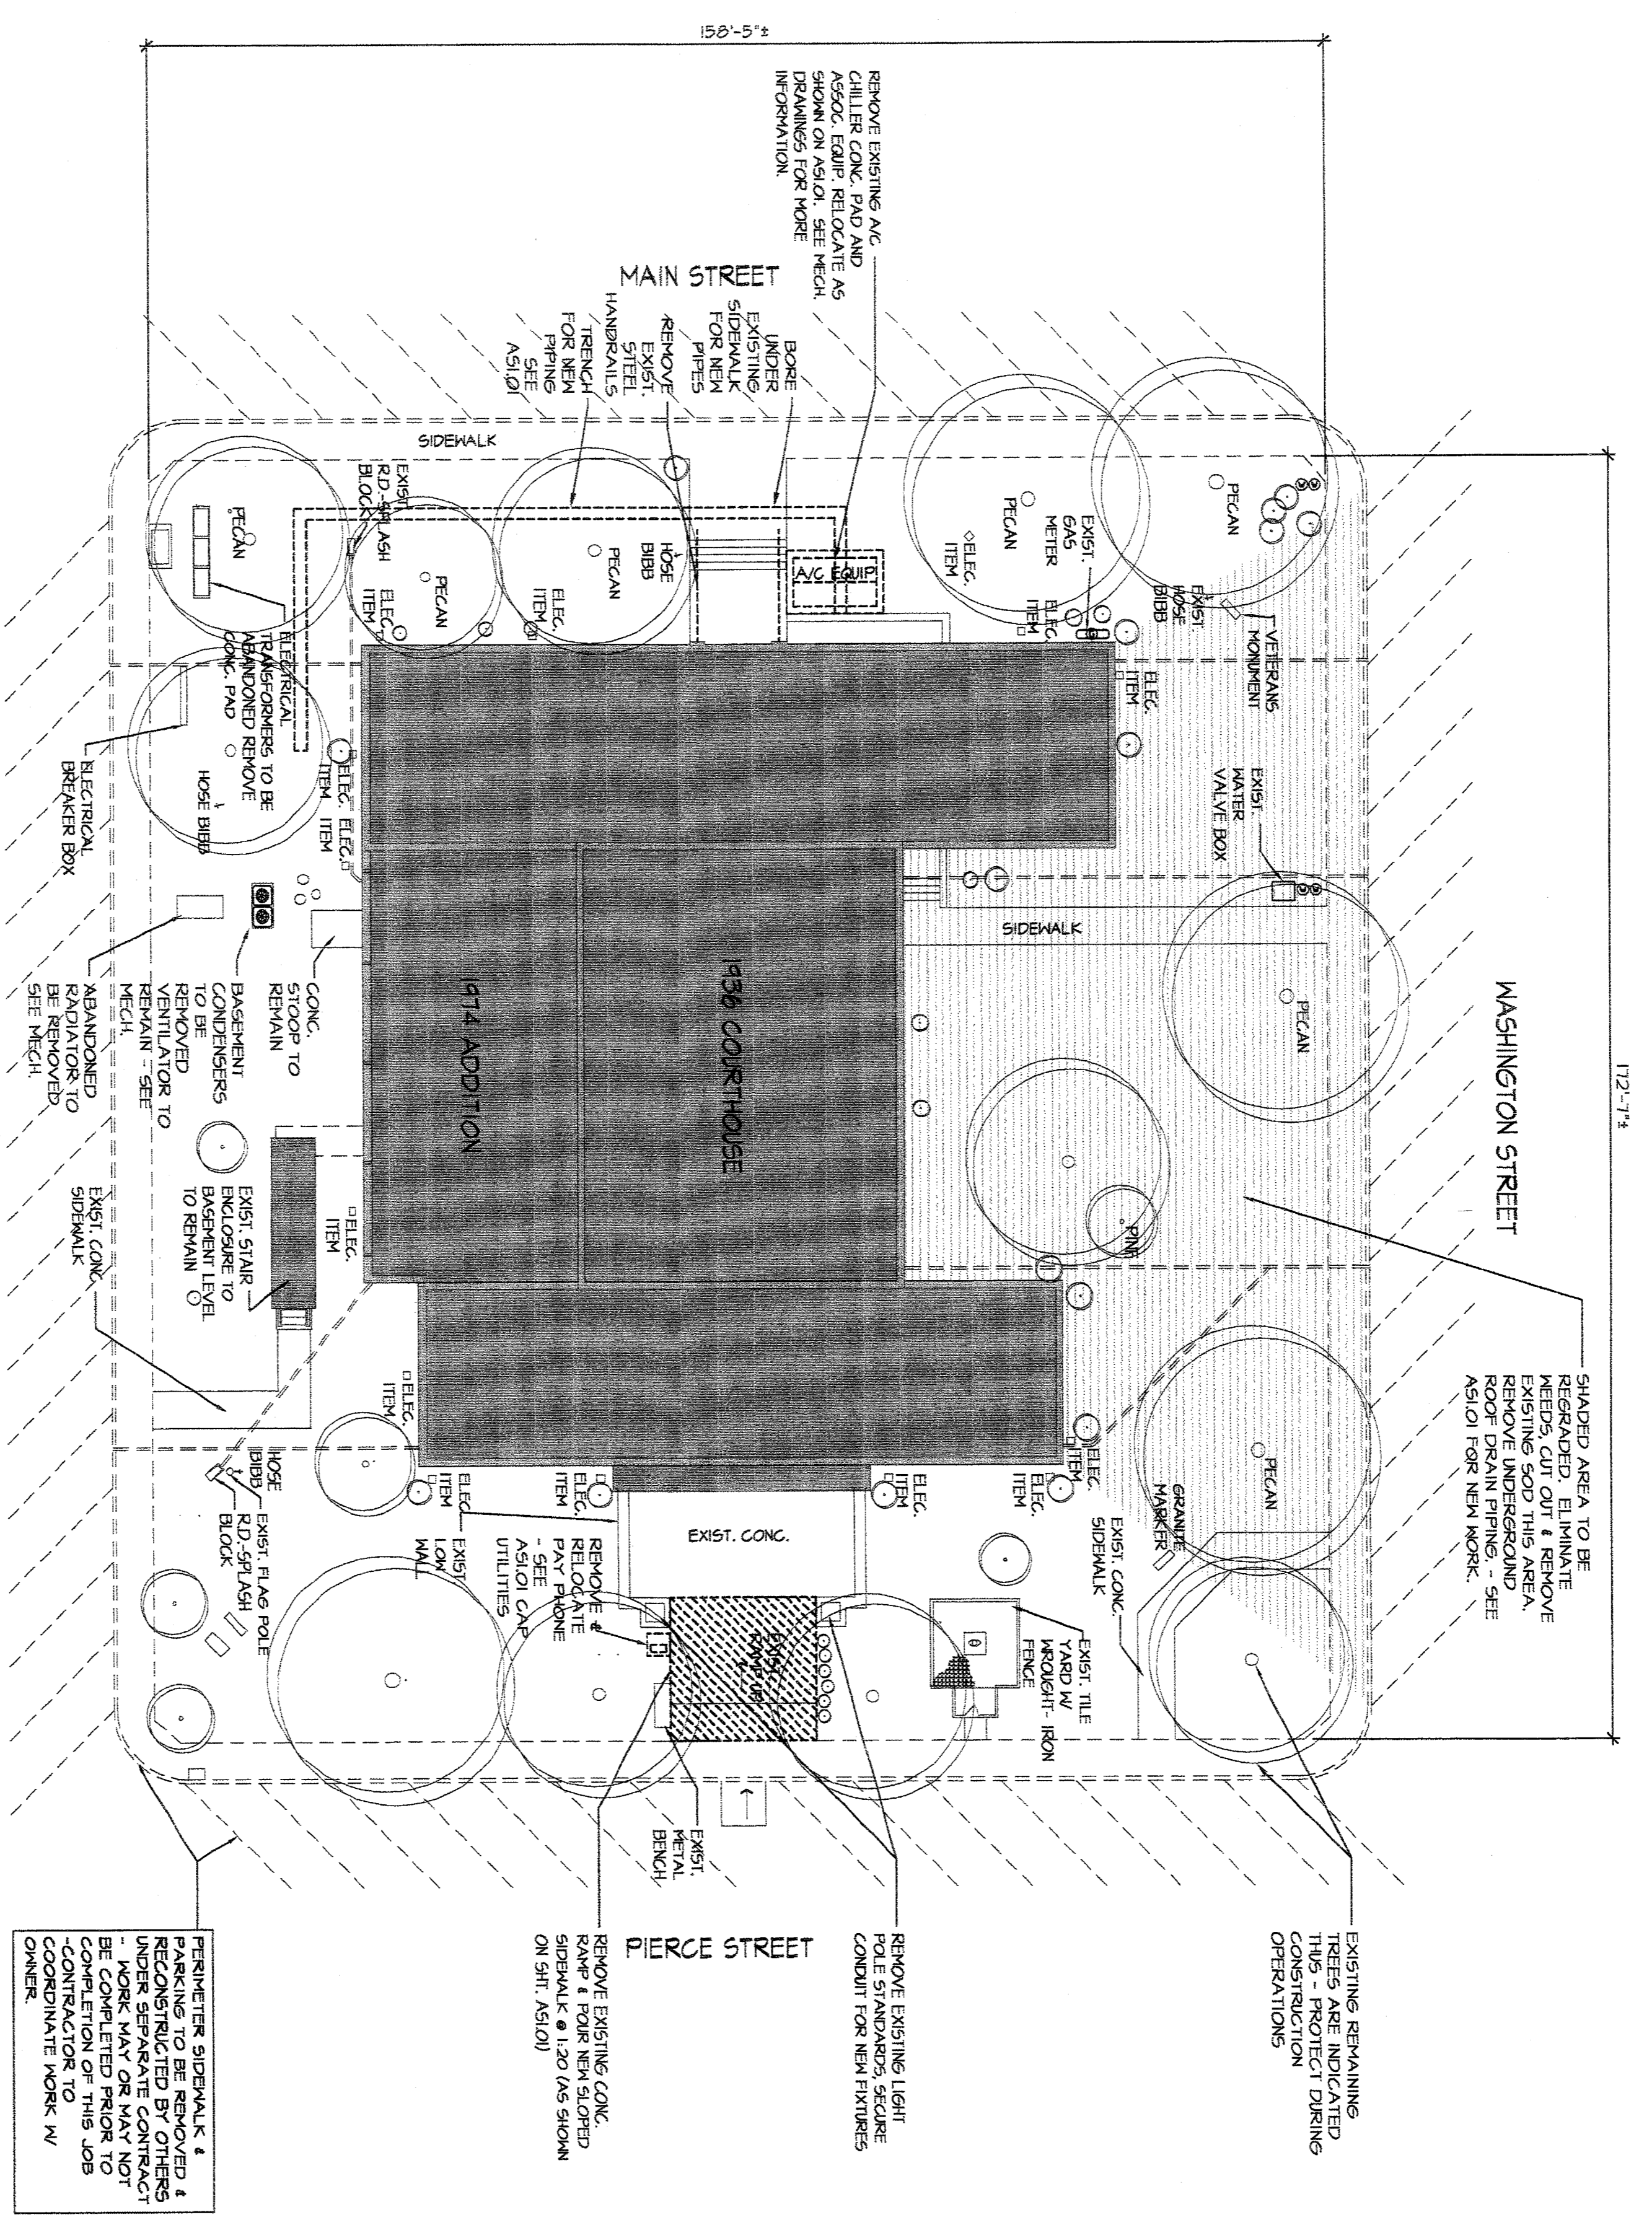

EXISTING SITE PLAN
SCALE: 1/16" = 1'-0"



ESI-01
1

REVISIONS


Sheet Title:
EXISTING SITE PLAN & DEMO. ITEMS

Project:
BURNET COUNTY COURTHOUSE
BURNET, TEXAS

ELBERT THURMAN ARCHITECTS, INC.
807 S. ROCK, SUITE 102
GEORGETOWN, TEXAS 78636
TEL. 512.869.1104 FAX 512.869.1362

11/13

Date: 3/18/2002
Proj. #: DSI.01
Drawn by: LCB
Issued for: BID

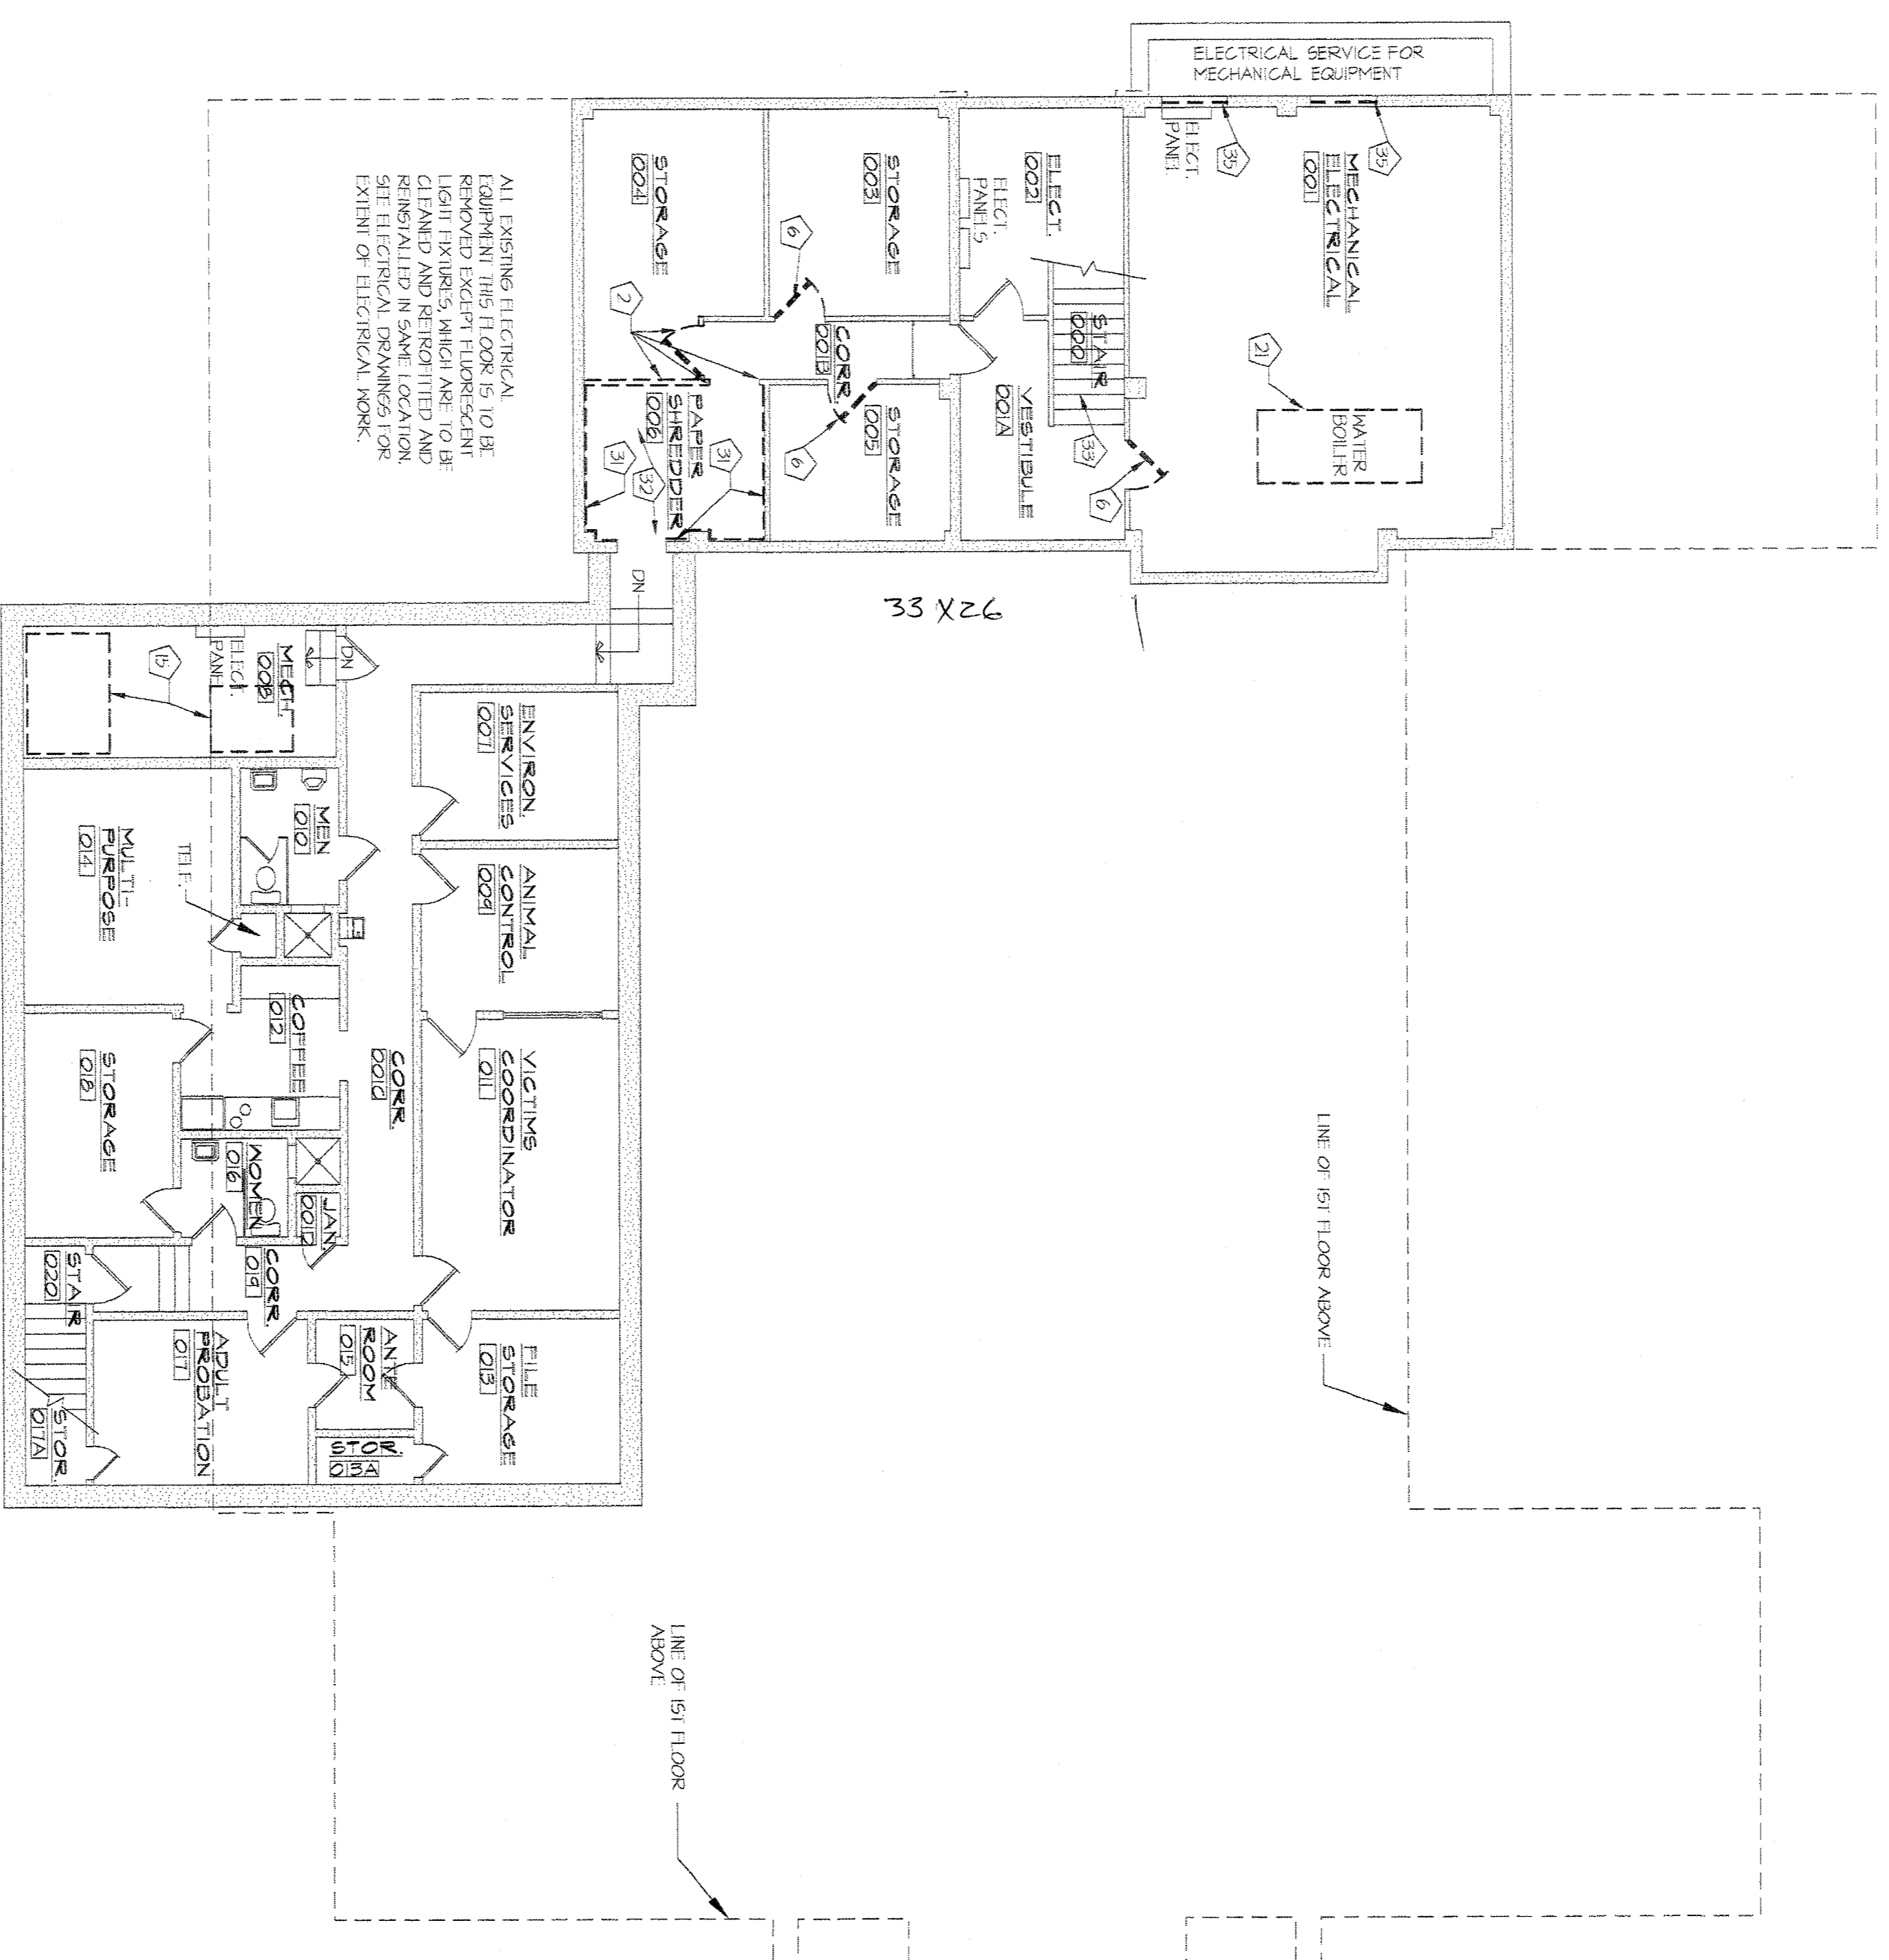

ALL EXISTING ELECTRICAL EQUIPMENT THIS FLOOR IS TO BE REMOVED EXCEPT FLOORSCANS, LIGHT FIXTURES, WHICH ARE TO BE REMOVED AND REINSTALLED IN SAME LOCATION. SEE ELECTRICAL DRAWINGS FOR EXHIBIT OF ELECTRICAL WORK.



- 1 REMOVE PORTION OF EXISTING WALL FOR NEW OPENING.
- 2 REMOVE EXISTING WALL TO STRUCTURE. REMOVE RELATED DOORS AND FRAME. SALVAGE DOORS AND MARK FOR RE-USE WHERE INDICATED. TURN OVER SALVAGED DOORS NOT DESIGNATED FOR RE-USE TO OWNER.
- 3 REMOVE EXISTING CAB PARTITION TO STRUCTURE.
- 4 REMOVE PORTION OF EXISTING WALL FOR NEW OPENING. OPENING TO BE LOCATED AT ORIGINAL WINDOW OPENING. WALL TO BE REMOVED FROM BELOW EXISTING LINTEL TO FINISH FLOOR.
- 5 REMOVE EXISTING ELECTRICAL EQUIPMENT - SEE ELECTRICAL DRAWINGS FOR MORE INFORMATION.
- 6 REMOVE EXISTING METAL DOORS. SALVAGE AND PLACE IN STORAGE AS DESIGNATED BY OWNER.
- 7 REMOVE AND SALVAGE EXISTING CASEWORK. PLACE IN STORAGE AS DESIGNATED BY OWNER.
- 8 REMOVE EXISTING PANELING FROM WALL.
- 9 REMOVE ALL SPACE MOUNTED ELECTRICAL CONCEIT, BOXES, WIRING, LIGHT FIXTURES, ETC. AT ALL OFFICE AREAS AT THE FIRST AND SECOND FLOORS. SEE ELECTRICAL PLANS FOR EXTENT OF WORK.
- 10 REMOVE EXISTING VINYL FLOOR TILE AND ADHESIVE.
- 11 FIELD FURNITURE IN CONFERENCE ROOMS REMOVED AND STORED UNDER FLOOR. FURNITURE TO BE REINSTALLED AS SHOWN ON THE RENOVATION DRAWINGS.
- 12 REMOVE EXISTING PLUMBING FIXTURES. SEE PLUMBING DRAWINGS.
- 13 REMOVE HANDRAIL AT THE THREE STEPS.
- 14 REMOVE EXISTING HANDRAILS.
- 15 MECHANICAL EQUIPMENT TO BE REMOVED. CAP ALL ELECTRICAL AND PLUMBING PIPING FLUSH WITH ADJACENT SURFACES. SEE MECH. DRAWINGS FOR MORE INFORMATION.
- 16 REMOVE EXISTING INTERIOR MOUNTED STORM WINDOWS.
- 17 REMOVE EXISTING EXTERIOR LIGHT POLE FIXTURE. CONDUIT TO REMAIN FOR INSTALLATION OF NEW FIXTURE.
- 18 REMOVE EXISTING WATER FOUNTAIN.
- 19 REMOVE EXISTING ENTRY DOORS.
- 20 REMOVE PORTION OF EXISTING WALL FOR INSTALLATION OF NEW DOOR.
- 21 REMOVE EXISTING WATER BOILER AND ALL ASSOCIATED PIPING AND CONTROLS. REFER TO MECHANICAL DRAWINGS FOR MORE INFORMATION.
- 22 REMOVE EXISTING A/C CHILLER AND CONC. PAD. SEE MECH. DRAWINGS FOR MORE INFORMATION.
- 23 REMOVE EXISTING METAL DOOR. SALVAGE FOR RELOCATION - SEE DOOR SCHEDULE ON SHEET A110.
- 24 REMOVE EXISTING MANGEL PARTITIONS. SALVAGE FOR REUSE IN NEW RESTROOMS. REMOVE MANGEL. DISPOSE AT OWNER'S DISCRETION.
- 25 REMOVE EXISTING FIRE EXTINGUISHER. RE-CHARGE EXTINGUISHERS AS REQUIRED. SALVAGE FOR REINSTALLATION.
- 26 REMOVE PORTION OF EXISTING WALL FOR NEW OPENING. OPENING TO BE LOCATED WHERE ORIGINAL WINDOW WAS INSTALLED. SILL HEIGHT TO BE 2'-5 1/2" AND HEADR 4'-5 3/4" ABOVE FINISH FLOOR.
- 27 RELOCATE EXISTING (2) VENDING MACHINES - SEE NEW PLAN A103.
- 28 REMOVE EXISTING VINYL TILE FLOORING. GRIND CONCRETE FLOOR TO RECEIVE NEW TERRAZZO TILE - SEE DETAIL B5A/D501.
- 29 REMOVE EXISTING VINYL TILE FLOORING. GRIND CONCRETE FLOOR TO RECEIVE NEW TERRAZZO TILE - SEE DETAIL B5A/D501.
- 30 REMOVE EXISTING DOOR AND FRAME.
- 31 REMOVE EXISTING WOOD WALL PANELING - PATCH AND REPAIR PLASTER SUBSTRATE FOR NEW PAINTED FINISH.
- 32 REMOVE EXISTING PLASTIC FOAM GULF-ON CEILING THE AREA.
- 33 REMOVE EXISTING CABINET AND PADDING FROM STAIRS. CLEAN CONCRETE SUBSTRATE FOR INSTALLATION OF NEW RUBBER TRENDS.
- 34 REMOVE EXISTING PLASTER AT WATER DAMAGED WALL - PREP WALL FOR NEW PLASTER REPAIR.
- 35 REMOVE EXISTING LAMINAR.
- 36 REMOVE PORTION OF WALL AT REIN. CONCRETE WALL.

KEYNOTES

APPLY TO SHEETS D1.01 - D1.03 ONLY


Sheet Title
**DEMOLITION
 BASEMENT
 FLOOR PLAN**

Project
**BURNET
 COUNTY
 COURTHOUSE
 BURNET, TEXAS**

11
17

HELVEN THIRTEEN ARCHITECTS INC.
 807 S. ROCK STREET, SUITE 102
 AUSTIN, TEXAS 78704
 TEL: 512.869.1001 FAX: 512.869.1362

Date: 3/18/2002
 Page #
 Drawing: LCB
 Issued for: BID
D1.01

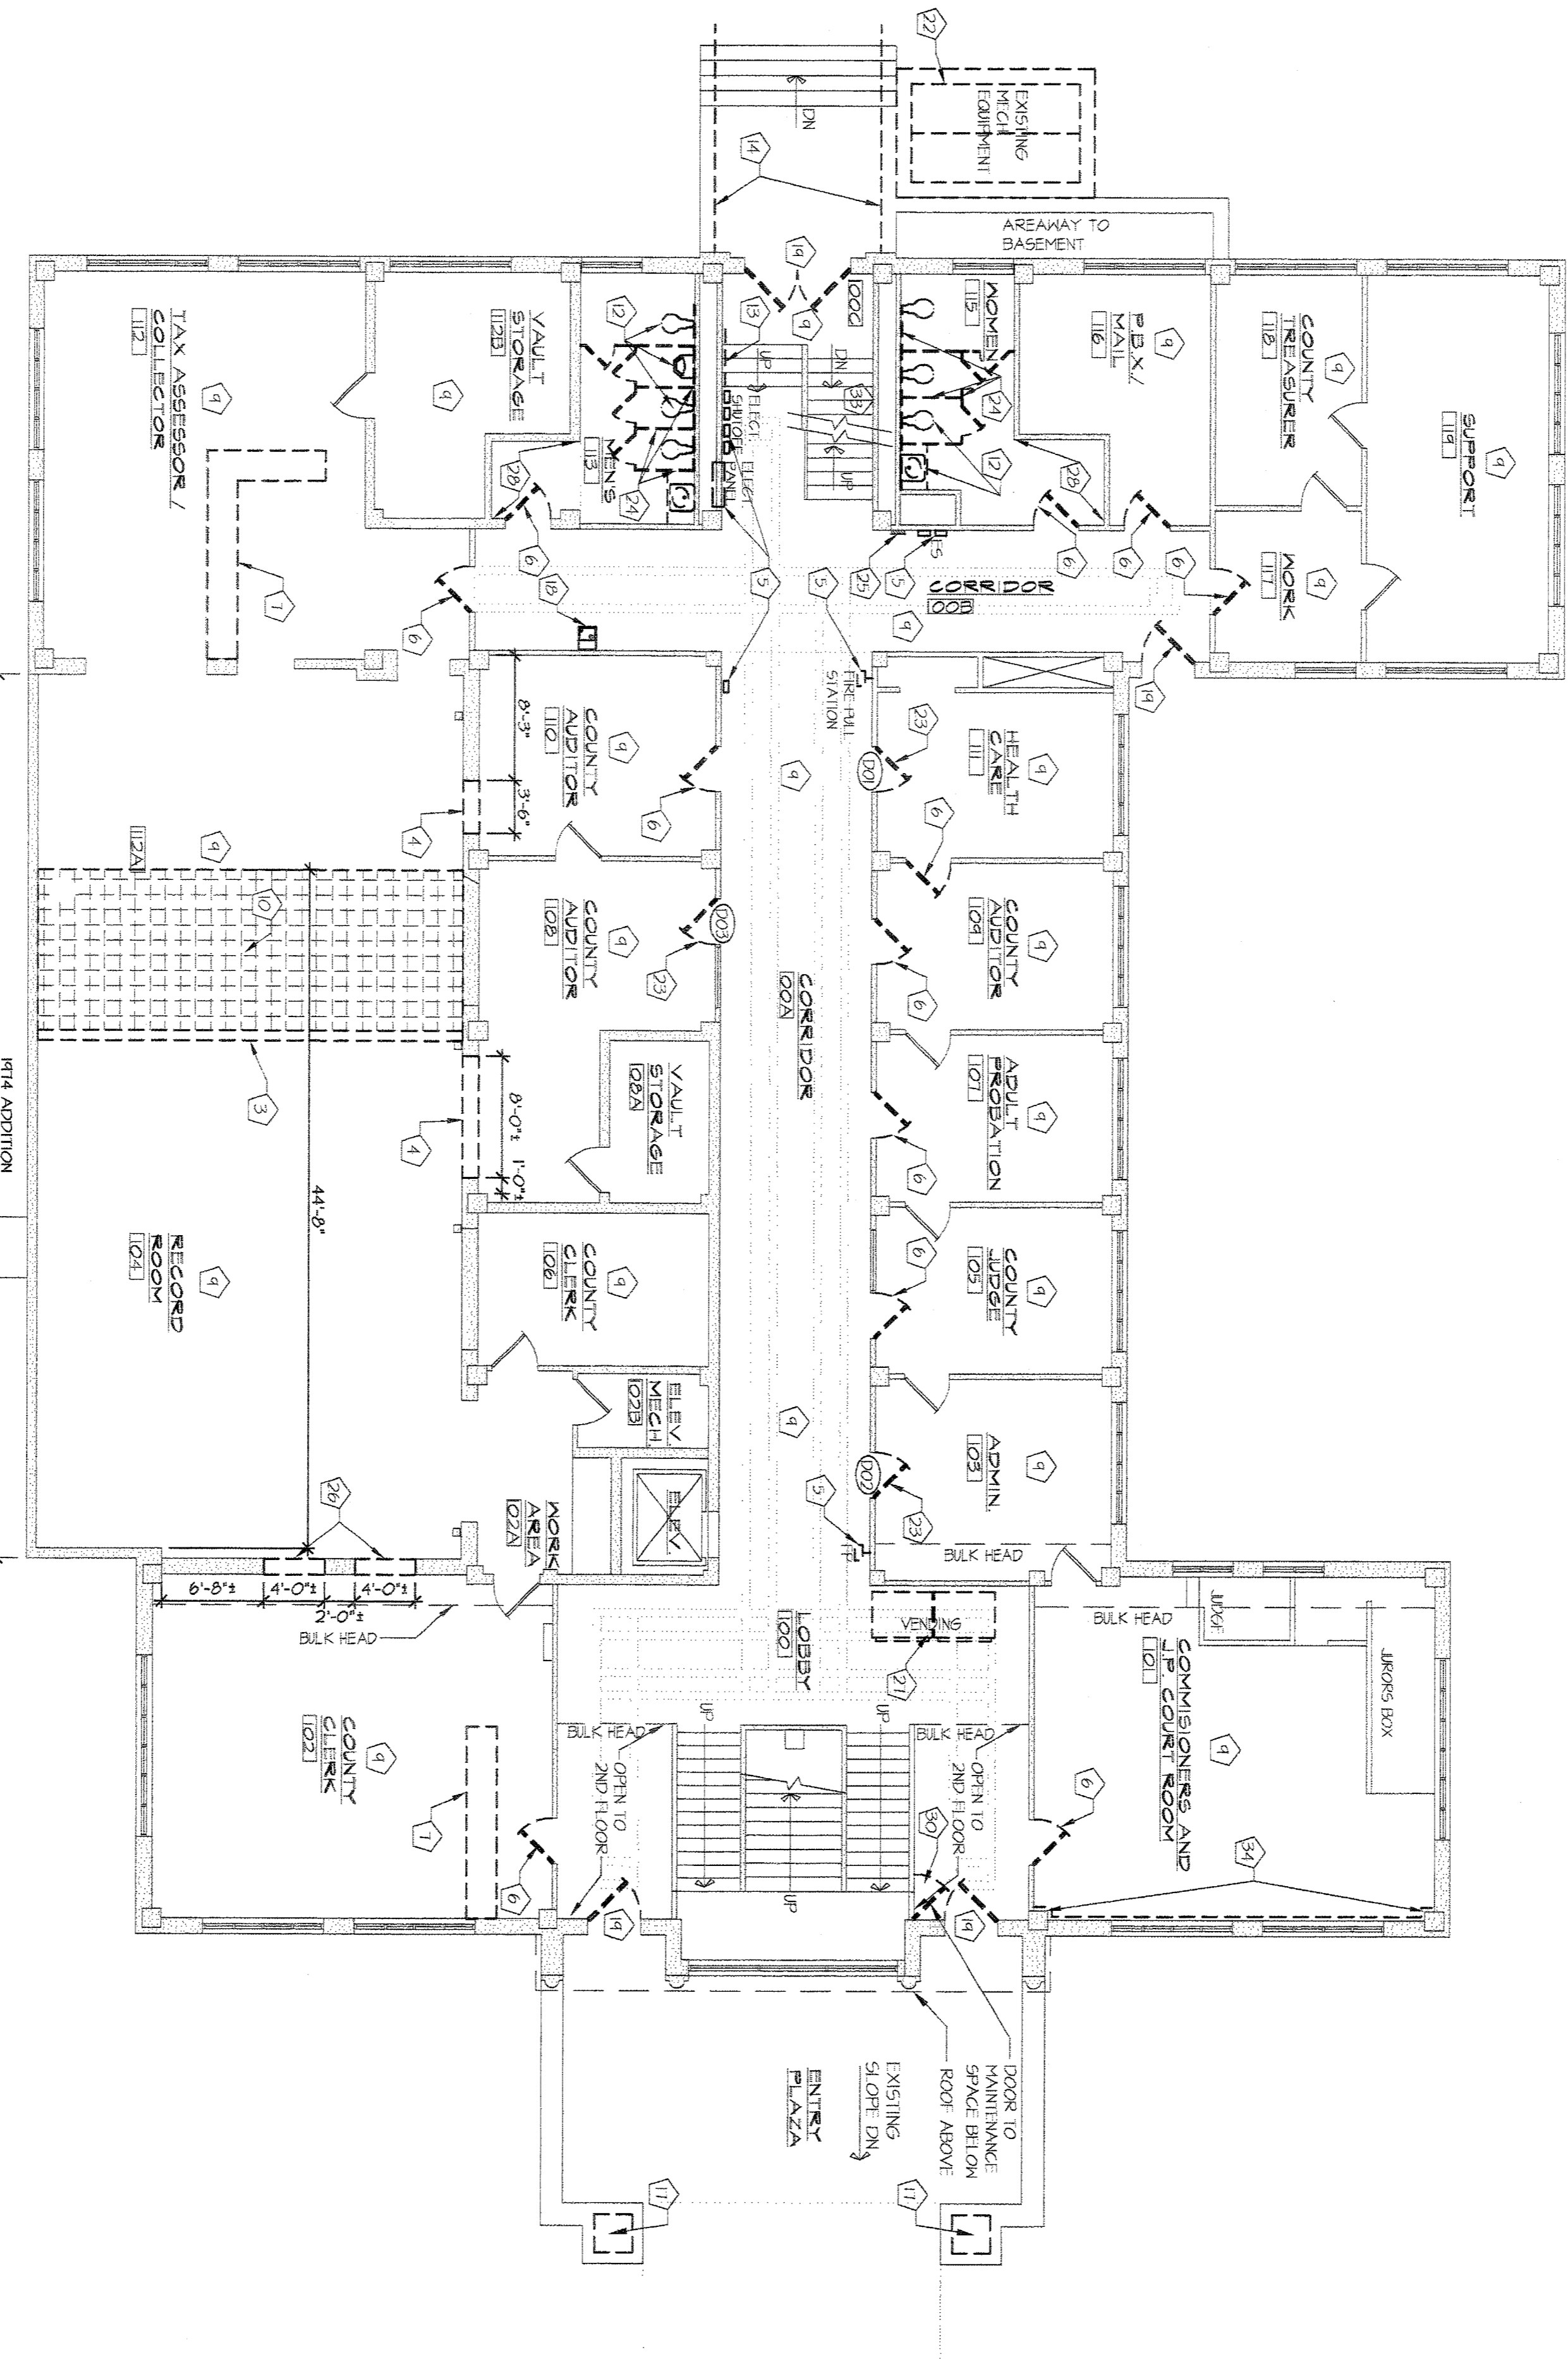

- 1 REMOVE PORTION OF EXISTING WALL FOR NEW OPENING.
- 2 REMOVE EXISTING WALL TO STRUCTURE. REMOVE SET AHEAD DOOR AND FRAME. SALVAGE DOORS AND MARK FOR RE-USE WHERE INDICATED. TURN OVER SALVAGED DOORS NOT DESIGNATED FOR RE-USE TO OWNER.
- 3 REMOVE EXISTING CMU PARTITION TO STRUCTURE.
- 4 REMOVE PORTION OF EXISTING WALL FOR NEW OPENING. OPENING TO BE LOCATED WHERE SHOWN. EXISTING PARTITION WALL TO BE REMOVED FROM BELOW EXISTING LEVEL TO FINISH FLOOR.
- 5 REMOVE EXISTING ELECTRICAL EQUIPMENT - SEE ELECTRICAL DRAWINGS FOR MORE INFORMATION.
- 6 REMOVE EXISTING METAL DOORS, SALVAGE AND PLACE IN STORAGE AS DESIGNATED BY OWNER.
- 7 REMOVE AND SALVAGE EXISTING CASEWORK. PLACE IN STORAGE AS DESIGNATED BY OWNER.
- 8 REMOVE EXISTING PANELING FROM WALL.
- 9 REMOVE ALL SURFACE MOUNTED ELECTRICAL CONDUIT, BOXES, WIRING, LIGHT FIXTURES, ETC. AT ALL OFFICE AREAS AT THE FIRST AND SECOND FLOORS. SEE ELECTRICAL PLANS FOR EXHIBIT OF WORK.
- 10 REMOVE EXISTING VINYL FLOOR TILE AND ADHESIVE.
- 11 FIXED FURNITURE IN CORRIDOR WAS REMOVED AND STORED UNDER PREVIOUS CONTRACT. E.C. TO COORDINATE REFINISHING OF THIS FURNITURE AND REINSTALL AS SHOWN ON THE RENOVATION DRAWINGS.
- 12 REMOVE EXISTING PLUMBING FIXTURES. SEE PLUMBING DRAWINGS.
- 13 REMOVE HANDRAIL AT THE THREE STAIRS.
- 14 REMOVE EXISTING HANDRAILS.
- 15 MECHANICAL EQUIPMENT TO BE REMOVED. CAP ALL ELECTRICAL AND PLUMBING PIPING FLUSH WITH ADJACENT SURFACES. SEE MECH. DRAWINGS FOR MORE INFORMATION.
- 16 REMOVE EXISTING INTERIOR MOUNTED STORM WINDOWS.
- 17 REMOVE EXISTING EXTERIOR LIGHT POLE FIXTURE. CONDUIT TO REMAIN FOR INSTALLATION OF NEW FIXTURE.
- 18 REMOVE EXISTING WATER FOUNTAIN.
- 19 REMOVE EXISTING ENTRY DOORS.
- 20 REMOVE PORTION OF EXISTING WALL FOR INSTALLATION OF NEW DOOR.
- 21 REMOVE EXISTING WATER BOILER AND ALL ASSOCIATED PIPING AND CONTROLS. REFER TO MECHANICAL DRAWINGS FOR MORE INFORMATION.
- 22 REMOVE EXISTING A/C CHILLER AND COND. PAK. SEE MECH. DRAWINGS FOR MORE INFORMATION.
- 23 REMOVE EXISTING METAL DOOR. SALVAGE FOR RELOCATION - SEE DOOR SCHEDULE ON SHEET A1.0.
- 24 REMOVE EXISTING MARBLE PARTITIONS. SALVAGE FOR REUSE IN NEW RESTROOMS. REMOVE MAINSCOT. DISPOSE AT OWNER'S DISCRETION.
- 25 REMOVE EXISTING FIRE EXTINGUISHER. RE-CHARGE EXTINGUISHERS AS REQUIRED. SALVAGE FOR REINSTALLATION.
- 26 REMOVE PORTION OF EXISTING WALL FOR NEW OPENING. OPENING TO BE LOCATED WHERE ORIGINAL WINDOW WAS INSTALLED. SILL HEIGHT TO BE 2'-9 3/4" AND HEADER 4'-5 3/4" ABOVE FINISH FLOOR.
- 27 RELOCATE EXISTING (2) VENDING MACHINES - SEE NEW PLAN A1.03
- 28 REMOVE EXISTING VINYL TILE FLOORING. GRIND CONCRETE FLOOR TO RECEIVE NEW TERSAZO TILE - SEE DETAIL D1/AD.01.
- 29 REMOVE EXISTING DOOR AND FRAME.
- 30 REMOVE EXISTING MOOD WALL PANELING - PATCH AND REPAIR PLASTER SUBSTRATE FOR NEW PAINTED FINISH.
- 31 REMOVE EXISTING PLASTIC FOAM GLE-ON CEILING THIS AREA.
- 32 REMOVE EXISTING CARPET AND PADDING FROM STAIRS. CLEAN CONCRETE SUBSTRATE FOR INSTALLATION OF NEW RUBBER TREADS.
- 33 REMOVE EXISTING PLASTER AT WATER DAMAGED WALL - PREP WALL FOR NEW PLASTER REPAIR.
- 34 REMOVE EXISTING LOWER.
- 35 REMOVE PORTION OF WALL AT REINF. CONCRETE WALL 1.

1 KEYNOTES
 APPLY TO SHEETS D1.01 - D1.03 ONLY

DEMOLITION FIRST FLOOR PLAN

SCALE: 1/8" = 1'-0"

D1-02

Sheet Title:
DEMOLITION FIRST FLOOR PLAN


Project:
BURNET COUNTY COURTHOUSE
 BURNETT, TEXAS



HERVEY THRENTON ARCHITECTS INC.
 GEORGETOWN, TEXAS 78626
 TEL 512.669.1064 FAX 512.869.1362

Date: 03/18/2002
 Drawn by: LCB
 Issued for: BMD

D1.02

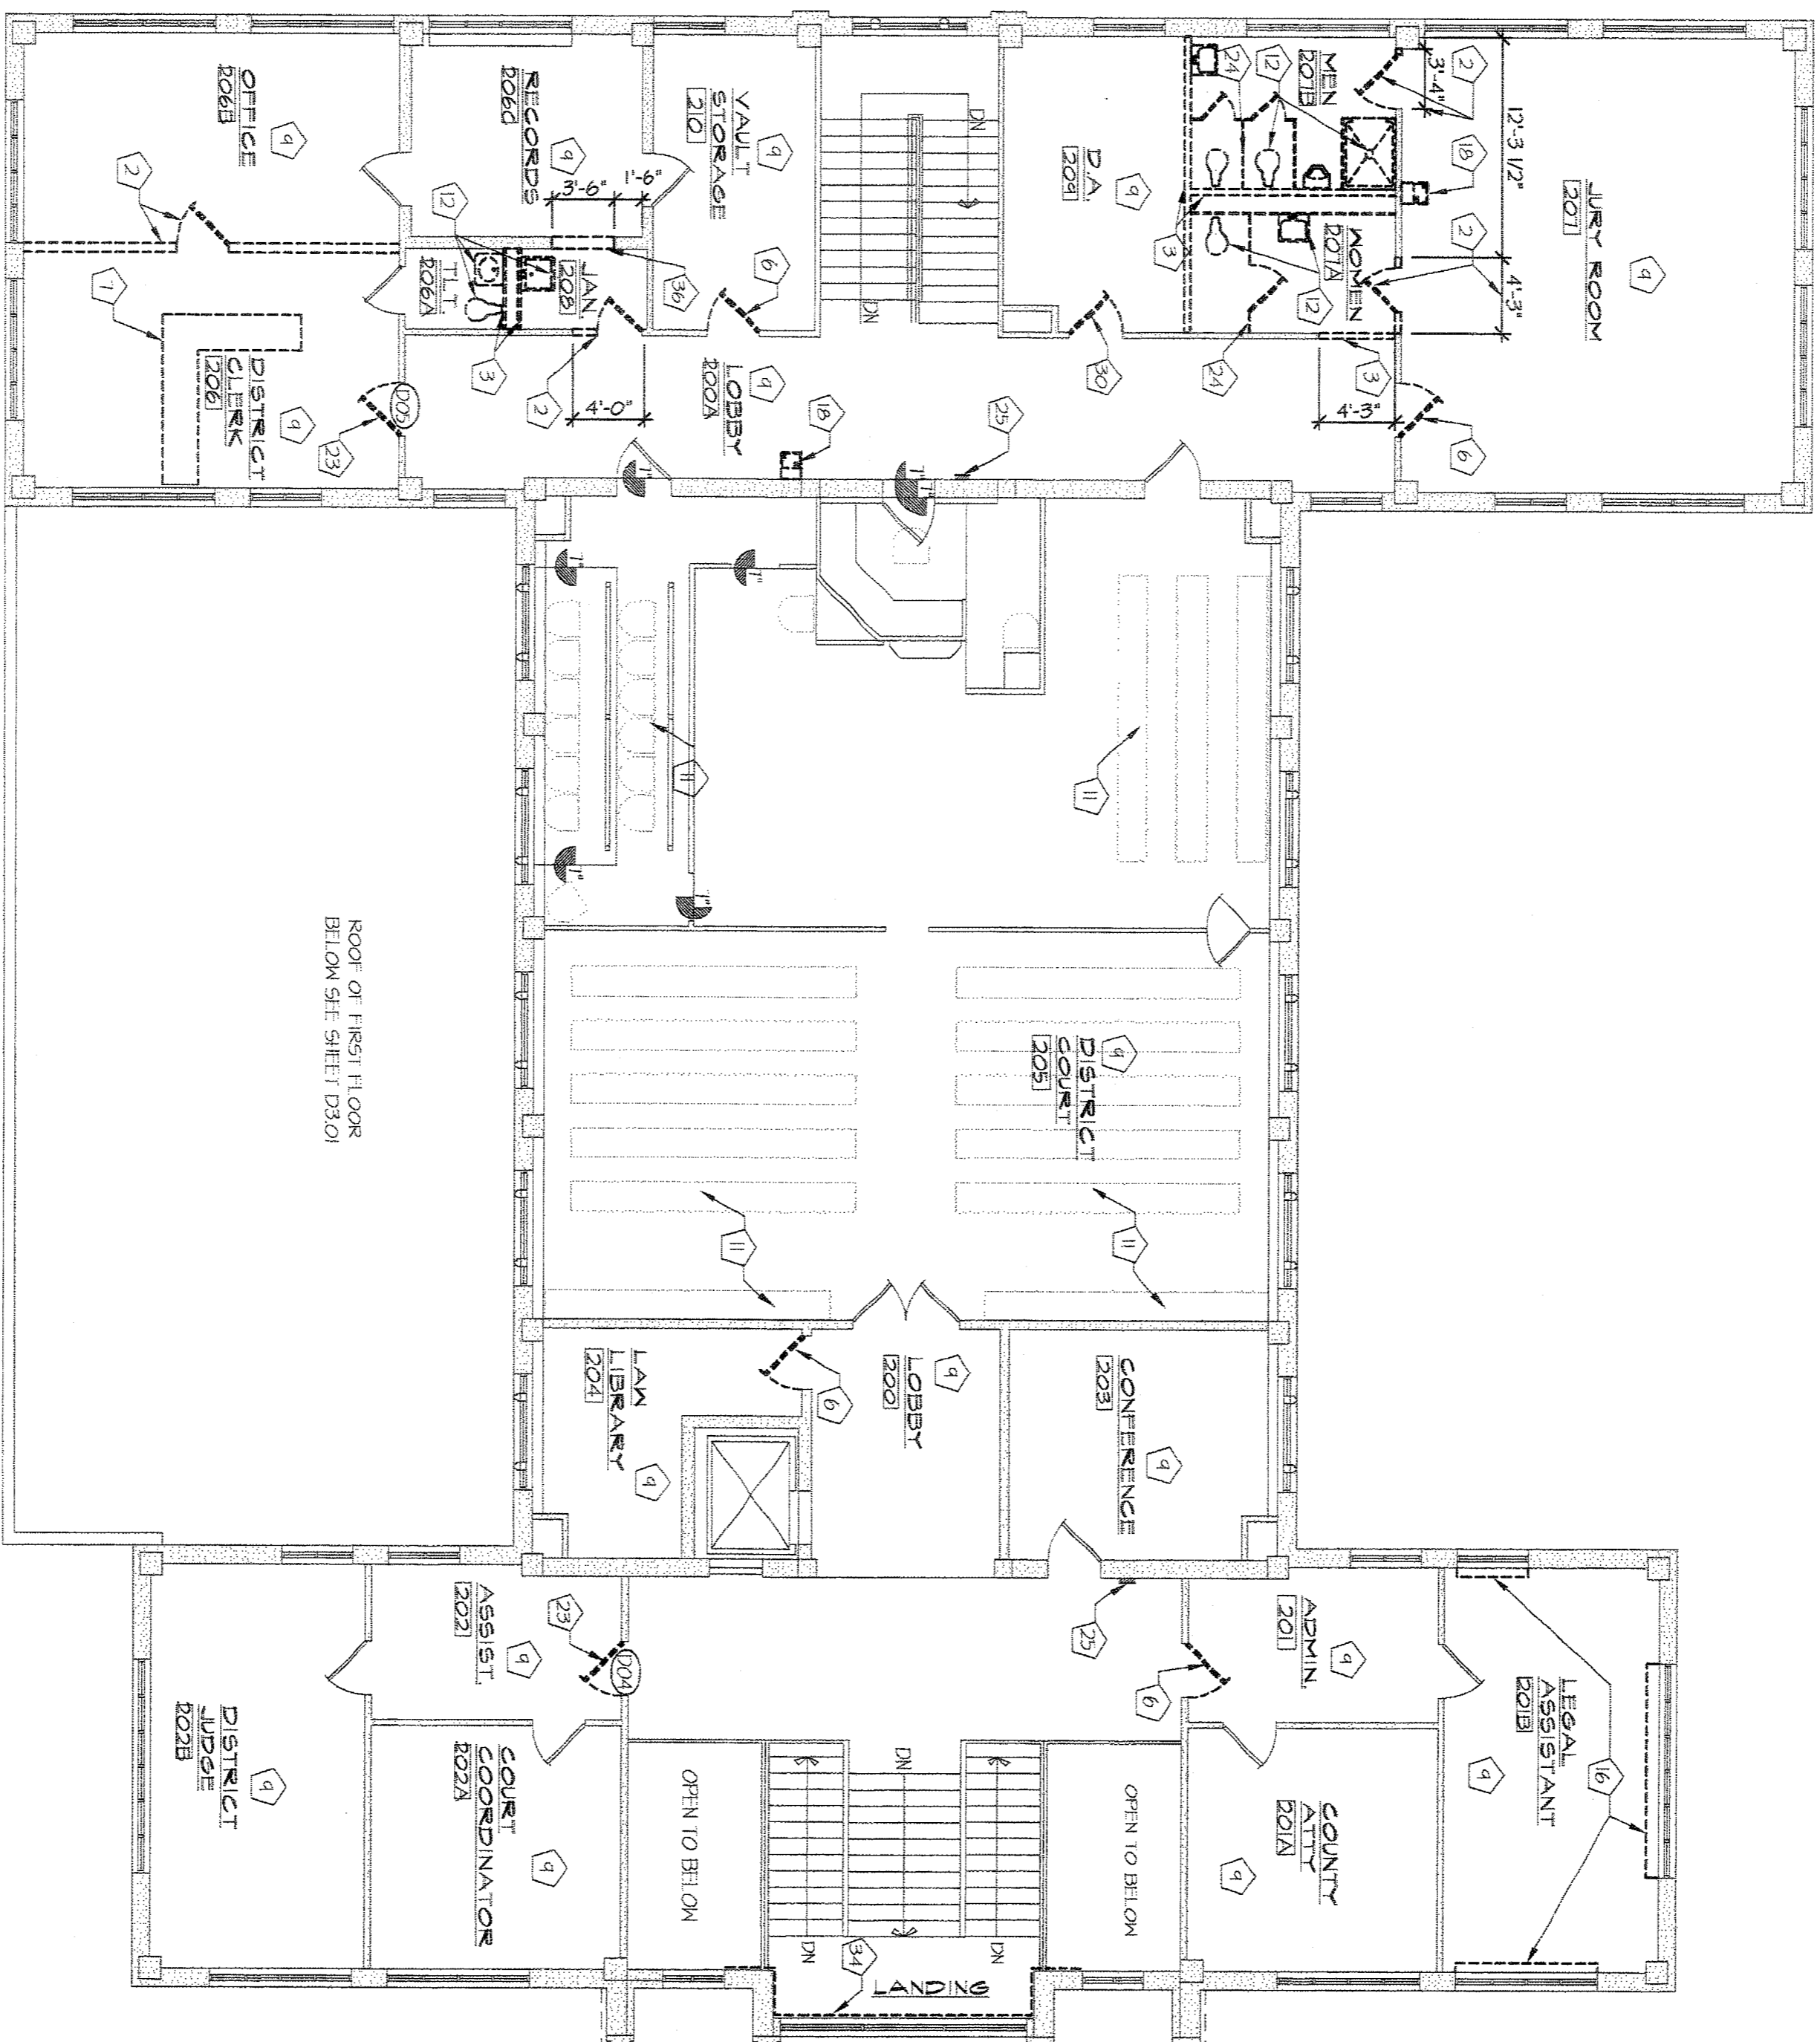

DEMOLITION SECOND FLOOR PLAN

SCALE: 1/8" = 1'-0"

D1-03

1

- 1 REMOVE PORTION OF EXISTING WALL FOR NEW OPENING.
- 2 REMOVE EXISTING WALL TO STRUCTURE. REMOVE RELATED DOORS AND FRAME. SALVAGE DOORS AND MARK FOR RE-USE WHERE INDICATED. TURN OVER SALVAGED DOORS NOT DESIGNATED FOR RE-USE TO OWNER.
- 3 REMOVE EXISTING CMU PARTITION TO STRUCTURE.
- 4 REMOVE PORTION OF EXISTING WALL FOR NEW OPENING. OPENING TO BE LOCATED AT ORIGINAL WINDOW OPENING. WALL TO BE REMOVED FROM BELOW EXISTING LINTEL TO FINISH FLOOR.
- 5 REMOVE EXISTING ELECTRICAL EQUIPMENT - SEE ELECTRICAL DRAWINGS FOR MORE INFORMATION.
- 6 REMOVE EXISTING METAL DOORS, SALVAGE AND PLACE IN STORAGE AS DESIGNATED BY OWNER.
- 7 REMOVE AND SALVAGE EXISTING CASEWORK. PLACE IN STORAGE AS DESIGNATED BY OWNER.
- 8 REMOVE EXISTING PANELING FROM WALL.
- 9 REMOVE ALL GREESE MOUNTED ELECTRICAL CABINET, BOXES, MARKING LIGHT FIXTURES, ETC. AT ALL OFFICE AREAS ON THE FIRST AND SECOND FLOORS. SEE ELECTRICAL PLANS FOR EXTENT OF WORK.
- 10 REMOVE EXISTING VINYL FLOOR TILE AND ADHESIVE.
- 11 FIXED FURNITURE IN COURTROOM WAS REMOVED AND STORED UNDER PREVIOUS CONTRACT. G.C. TO COORDINATE REFINISHING OF THIS FURNITURE AND REINSTALL, AS SHOWN ON THE RELOCATION DRAWINGS.
- 12 REMOVE EXISTING PLUMBING FIXTURES. SEE PLUMBING DRAWINGS.
- 13 REMOVE HANDRAIL AT THE THREE STEPS.
- 14 REMOVE EXISTING HANDRAILS.
- 15 MECH/ELEC. EQUIPMENT TO BE REMOVED. CAP ALL ELECTRICAL AND PLUMBING PIPING FLUSH WITH ADJACENT SURFACES. SEE MECH DRAWINGS FOR MORE INFORMATION.
- 16 REMOVE EXISTING INTERIOR MOUNTED STORM WINDOWS.
- 17 REMOVE EXISTING EXTERIOR LIGHT POLE FIXTURE. CONDUIT TO REMAIN FOR INSTALLATION OF NEW FIXTURE.
- 18 REMOVE EXISTING WATER FOUNTAIN.
- 19 REMOVE EXISTING WATER FOUNTAIN.
- 20 REMOVE PORTION OF EXISTING WALL FOR INSTALLATION OF NEW DOOR.
- 21 REMOVE EXISTING WATER BOILER AND ALL ASSOCIATED PIPING AND CONTROLS. REFER TO MECHANICAL DRAWINGS FOR MORE INFORMATION.
- 22 REMOVE EXISTING A/C CHILLER AND CONC. PAD. SEE MECH DRAWINGS FOR MORE INFORMATION.
- 23 REMOVE EXISTING METAL DOOR. SALVAGE FOR RELOCATION - SEE DOOR SCHEDULE ON SHEET A110.
- 24 REMOVE EXISTING MARBLE PARTITIONS. SALVAGE FOR REUSE IN NEW RESTROOMS. REMOVE WAINCOT, DISPOSE AT OWNER'S DISCRETION.
- 25 REMOVE EXISTING FIRE EXTINGUISHER. RE-CHARGE EXTINGUISHERS AS REQUIRED. SALVAGE FOR REINSTALLATION.
- 26 REMOVE PORTION OF EXISTING WALL FOR NEW OPENING. OPENING TO BE LOCATED WHERE ORIGINAL WINDOW WAS INSTALLED. SILL HEIGHT TO BE 2'-5 1/2" AND HEADER 4'-5 1/2" ABOVE FINISH FLOOR.
- 27 RELOCATE EXISTING (2) VENDING MACHINES - SEE NEW PLAN A103.
- 28 REMOVE EXISTING VINYL TILE FLOORING, GRIND CONCRETE FLOOR TO RECEIVE NEW TERRAZZO TILE - SEE DETAIL D14B01.
- 29 NOT USED.
- 30 REMOVE EXISTING DOOR AND FRAME.
- 31 REMOVE EXISTING WOOD WALL PANELING - PATCH AND REPAIR PLASTER SUBSTRATE FOR NEW PAINTED FINISH.
- 32 REMOVE EXISTING PLASTIC FLOOR GLUE-ON CEILING THIS AREA.
- 33 REMOVE EXISTING CARPET AND PADDING FROM STAIRS. CLEAN CONCRETE SUBSTRATE FOR INSTALLATION OF NEW RUBBER TREADS.
- 34 REMOVE EXISTING PLASTER AT WATER DAMAGED WALL - PREP WALL FOR NEW PLASTER REPAIR.
- 35 REMOVE EXISTING LAMBER.
- 36 REMOVE PORTION OF WALL AT REINFC. CONCRETE VAULT.


KEYNOTES

APPLY TO SHEETS D1-01 - D1-06 ONLY.

REVISIONS


Sheet Title:
DEMOLITION SECOND FLOOR PLAN

Project:
BURNET COUNTY COURTHOUSE
BURNET, TEXAS

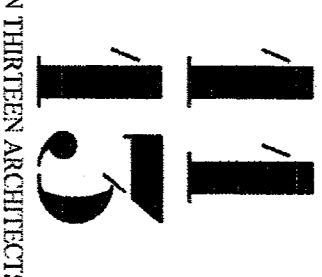

Project:
EILEEN THIRTEEN ARCHITECTS INC.
807 S. ROCK, SUITE 102
GEOURGETOWN, TEXAS 78636
TEL: 512.869.1104 FAX: 512.869.1862

Date: 03/18/2002
Page #: 1
Drawn by: LCB
Issued for: BID
D1.03

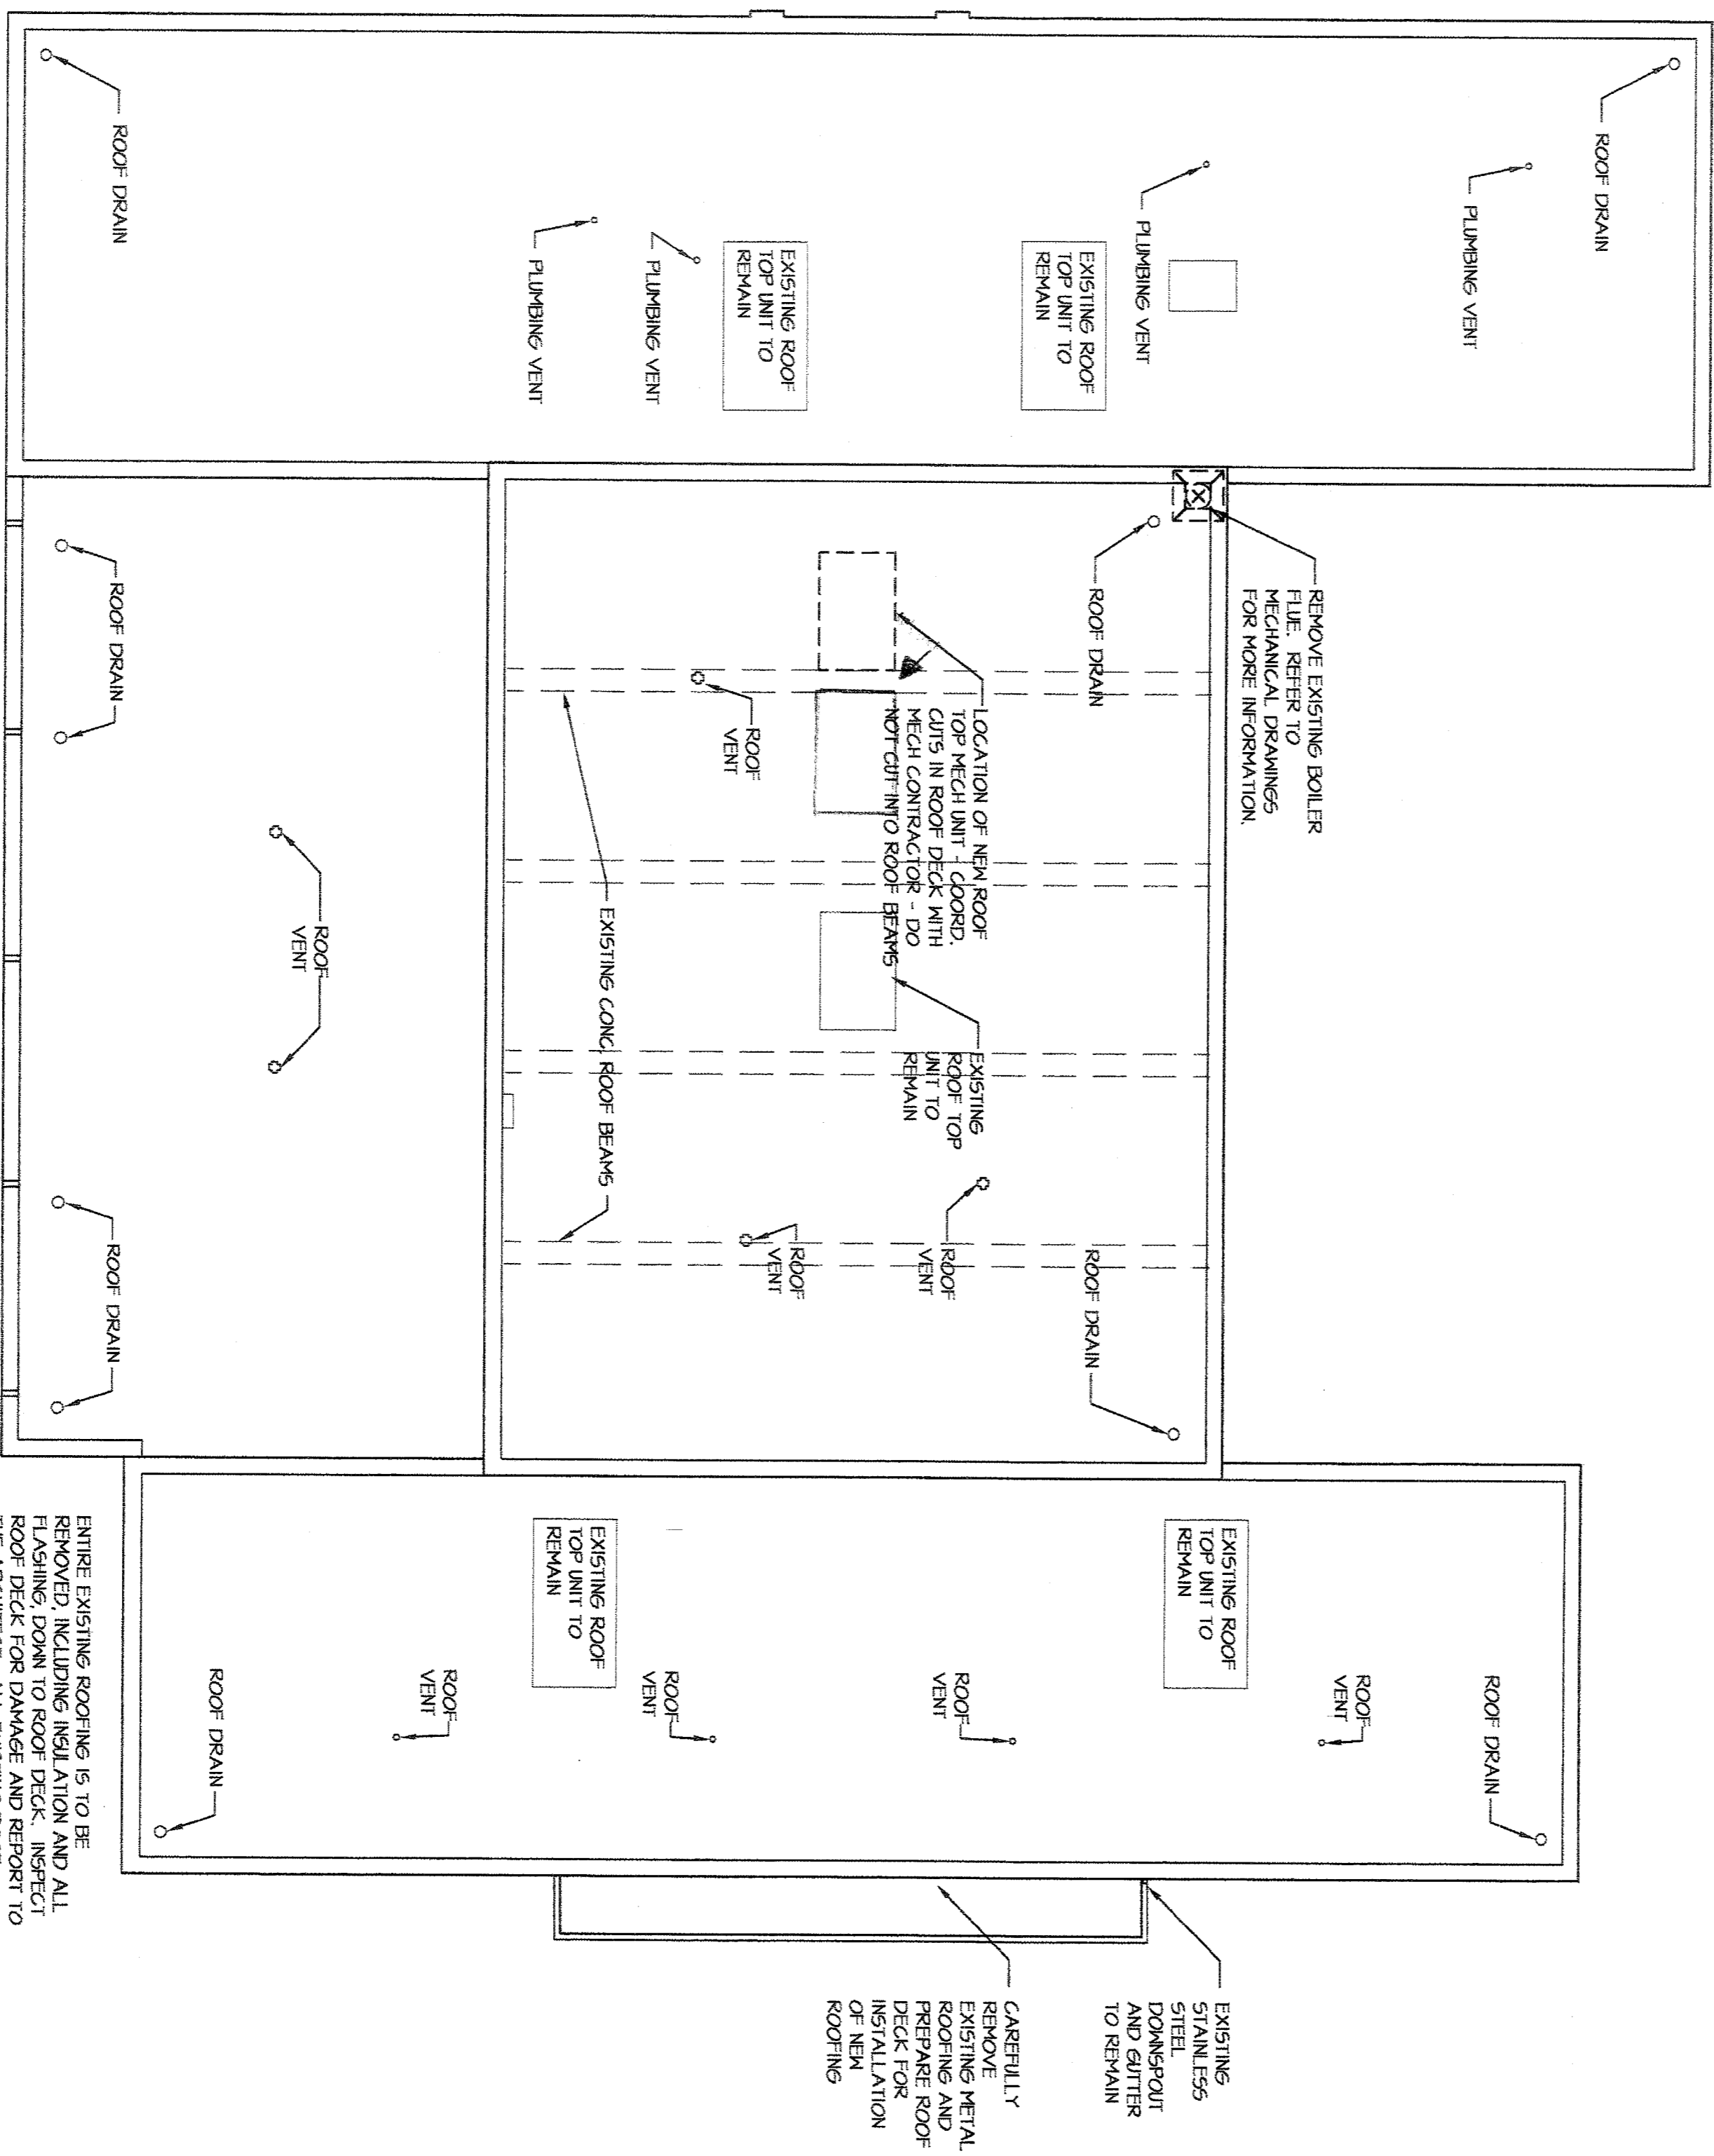

ENTIRE EXISTING ROOFING IS TO BE REMOVED, INCLUDING INSULATION AND ALL FLASHING DOWN TO ROOF DECK. INSPECT THE ARCHITECT. ALL EXISTING ROOF DRAINS AND ROOF VENTS ARE TO REMAIN. INFORMATION ON NEW ROOF PENETRATIONS.

EXISTING STAINLESS STEEL DOWNSPOUT AND FLASHING TO REMAIN
 CAREFULLY REMOVE EXISTING METAL ROOFING AND PREFABRICE ROOF DECK FOR INSTALLATION OF NEW ROOFING


ROOF PLAN DEMOLITION WORK

SCALE: 1/8" = 1'-0"

REVISIONS


DEMOLITION ROOF PLAN

BURNET COUNTY COURTHOUSE
 BURNET, TEXAS

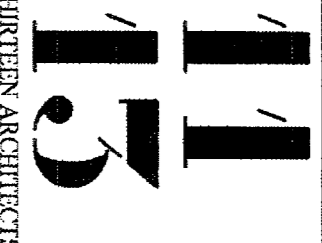

ELVEN THIRTTEN ARCHITECTS, INC.
 807 S. ROCK, SUITE 102
 GROESBECK, TEXAS 78626
 TEL: 512.869.1104 FAX: 512.869.1162

Project: **BURNET COUNTY COURTHOUSE**
 Date: 3/18/2002
 Drawn by: LCB
 Issued for: BID
D3.01

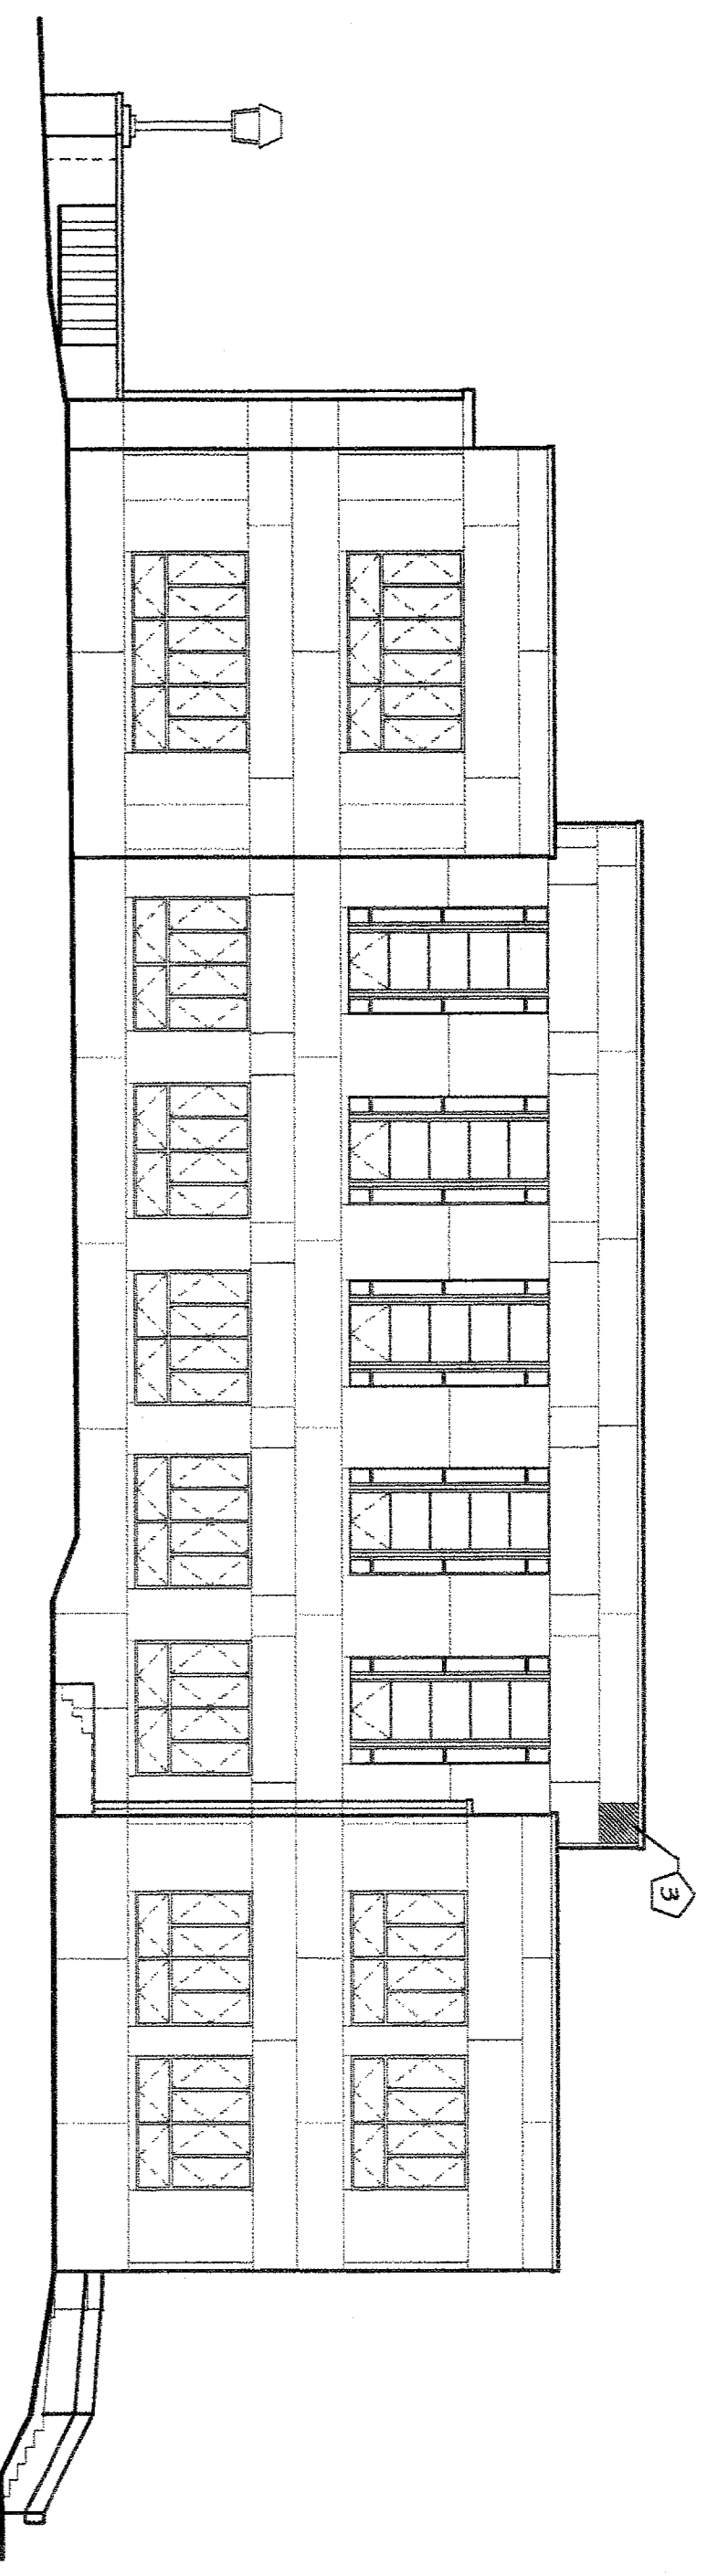


NOTE: ALL SURFACES OF NORTH ELEVATION HEAVILY MILDEWED AND STAINED

EXISTING NORTH ELEVATION

SCALE: 3/32" = 1'-0"

D4-01

12

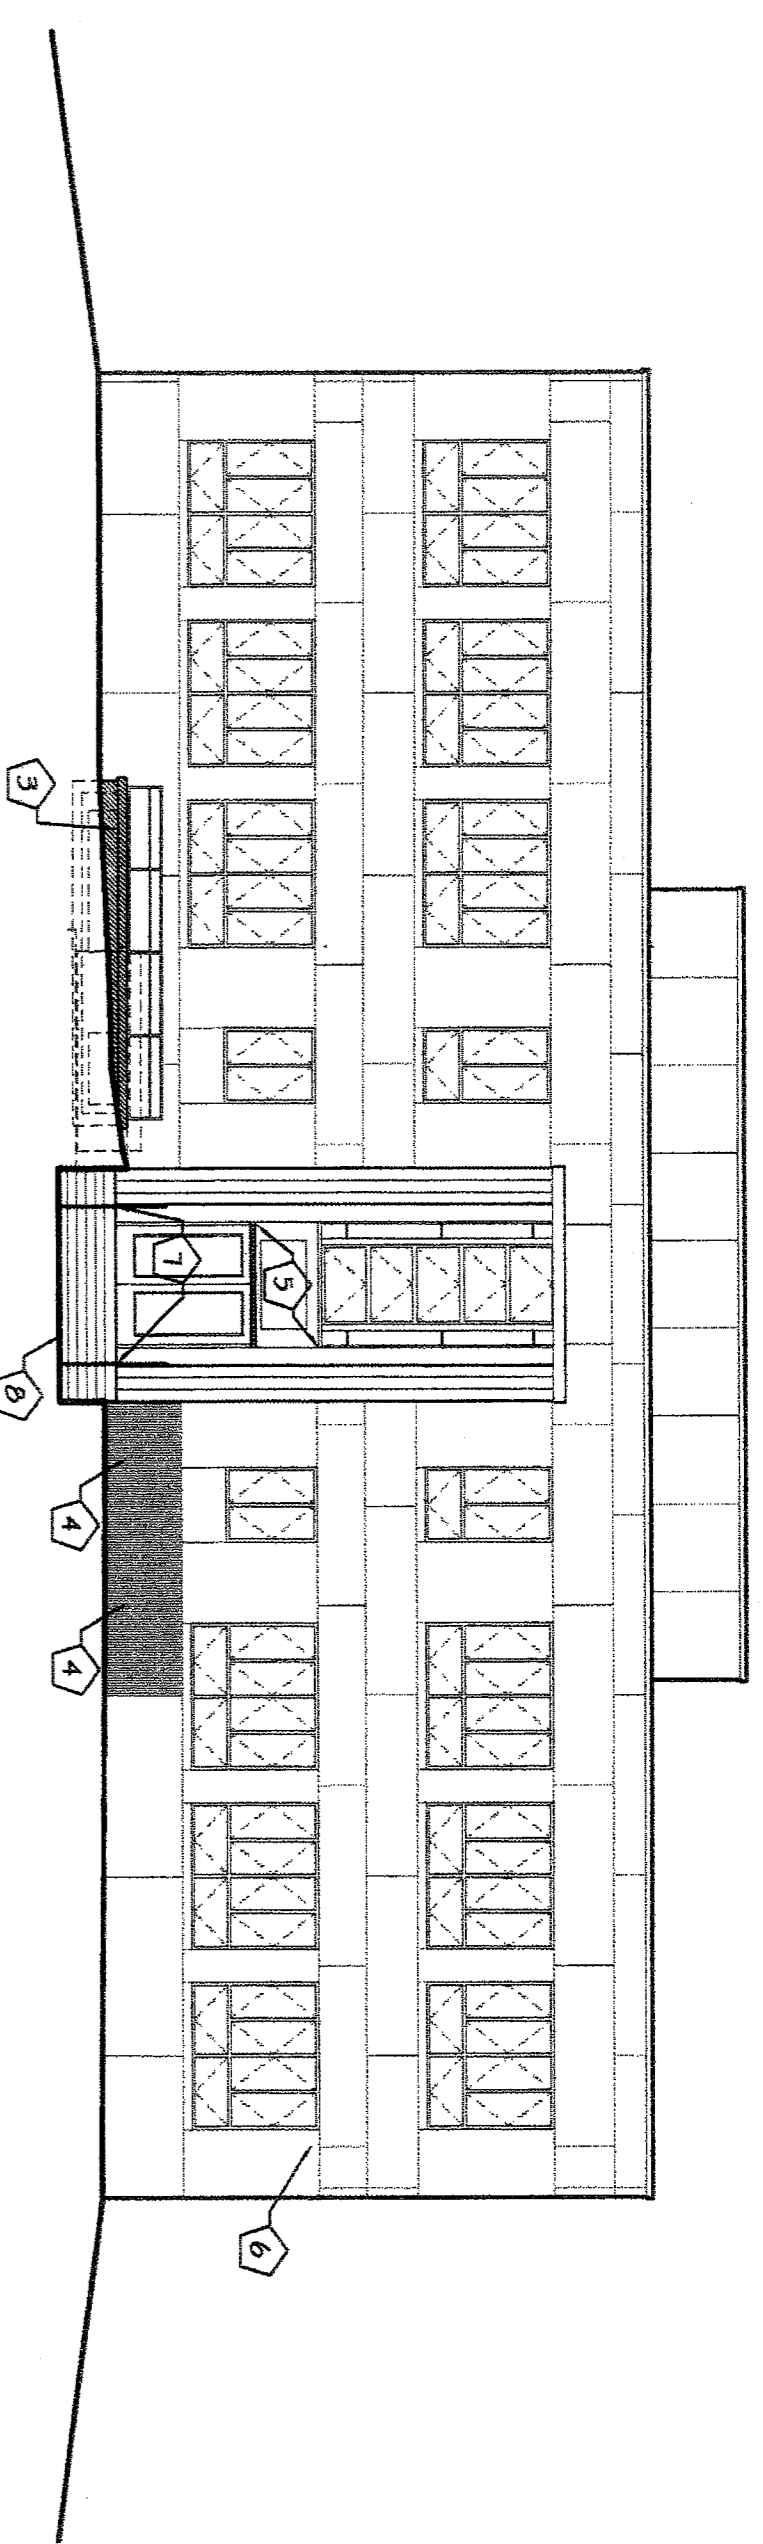


EXISTING WEST ELEVATION

SCALE: 3/32" = 1'-0"

D4-01

4

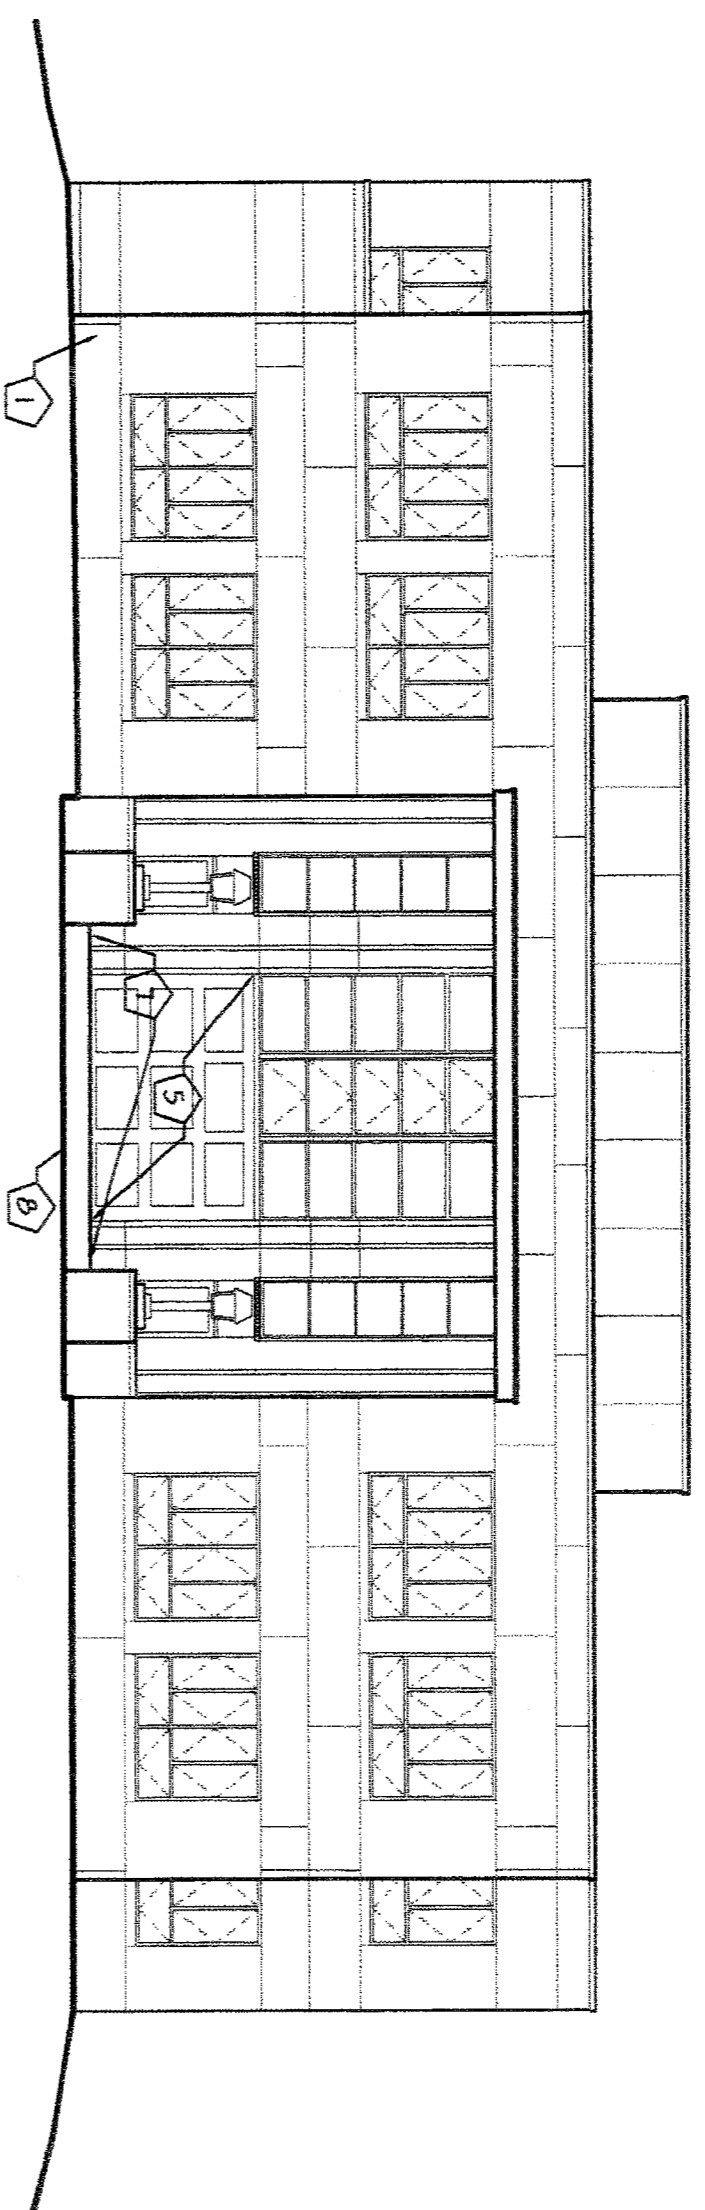


EXISTING EAST ELEVATION

SCALE: 3/32" = 1'-0"

D4-01

11

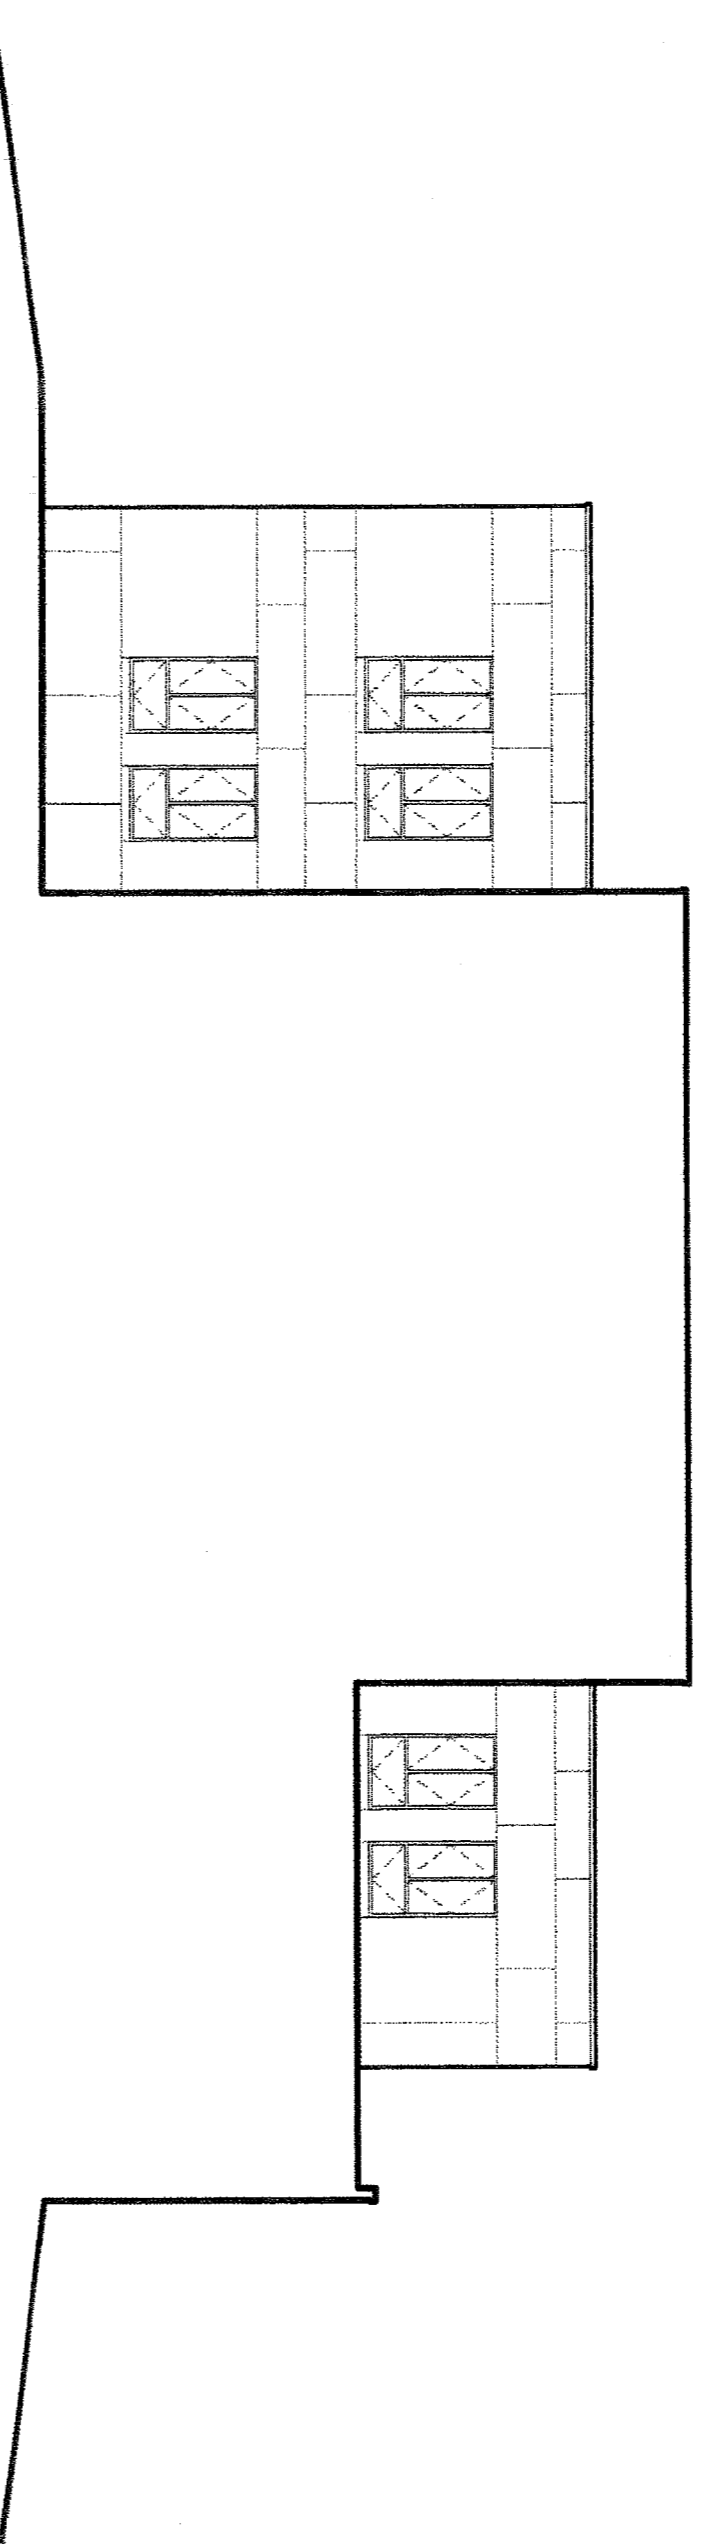


EXISTING WEST ELEVATION

SCALE: 3/32" = 1'-0"

D4-01

3

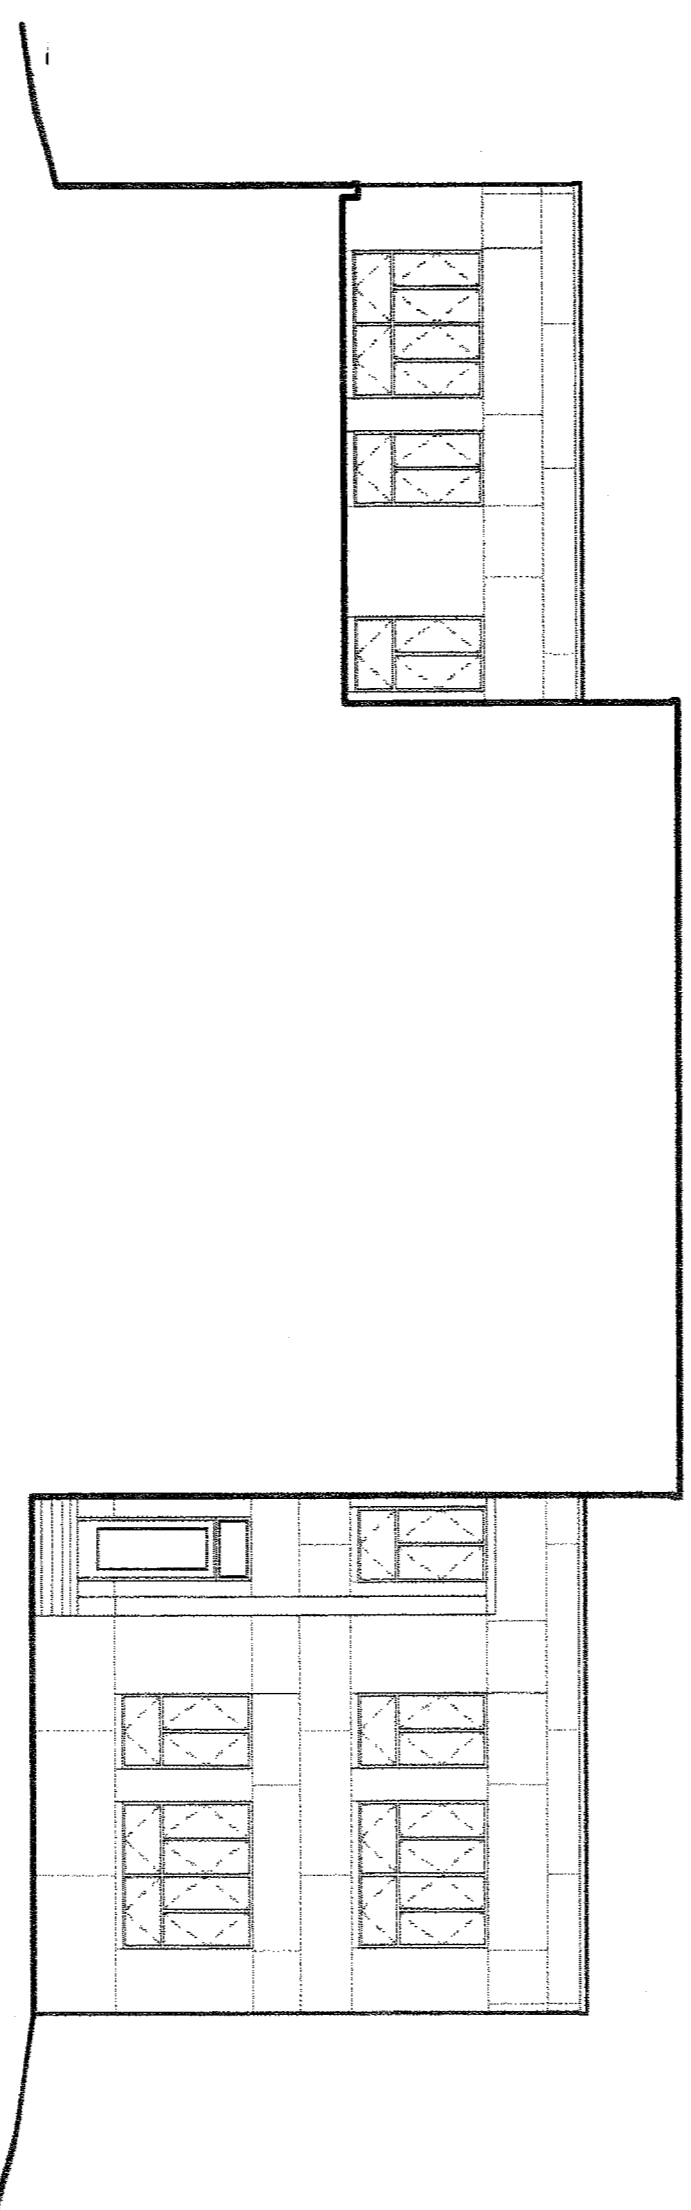


EXISTING EAST ELEVATION

SCALE: 3/32" = 1'-0"

D4-01

10

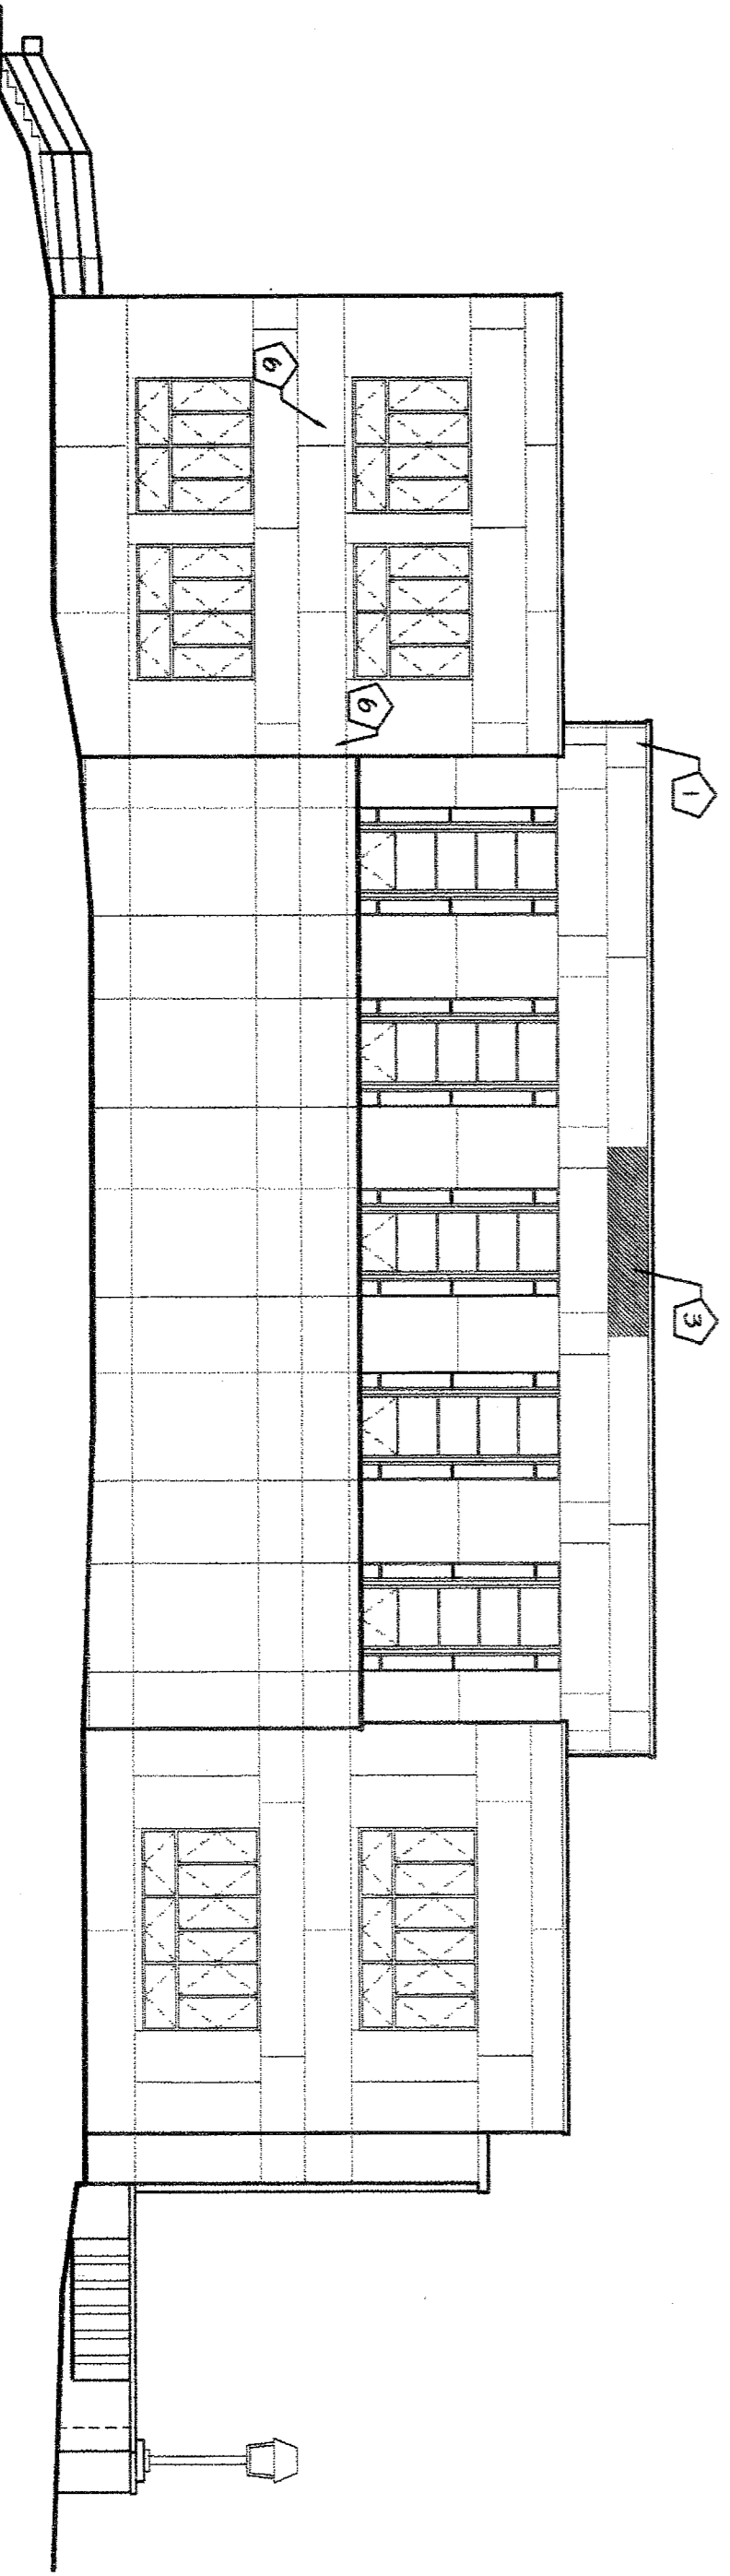


EXISTING SOUTH ELEVATION

SCALE: 3/32" = 1'-0"

D4-01

9

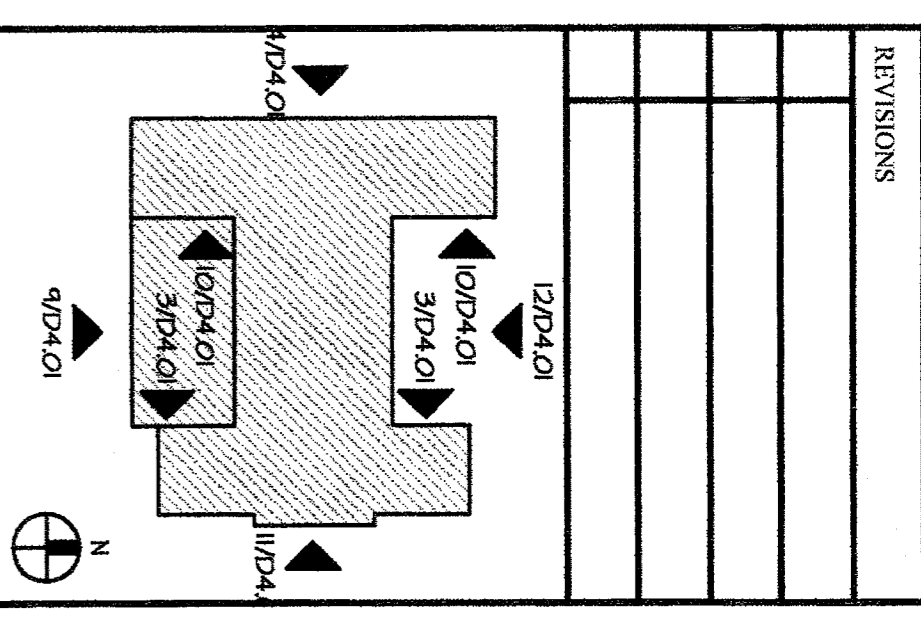

KEY PLAN

- EXISTING MASONRY FACADE CONDITION**
- 1 CRACKED GRANITE PANEL
 - 2 NOT USED
 - 3 RUST STAINS ON GRANITE
 - 4 EFFLORESCENCE ON GRANITE
 - 5 EXISTING CARVED GRANITE RELIEF
 - 6 CHIPPED GRANITE PANEL
 - 7 SPALLING MORTAR JOINT AT BASE OF GRANITE
 - 8 SPALLING MORTAR JOINT AT BASE OF STEPS OR RAMP

KEYNOTES

MASONRY KEYS

2


Project:
BURNET COUNTY COURTHOUSE
 BURNET, TEXAS

Sheet Title:
MASONRY SURVEY

ELLEN THIRTEEN ARCHITECTS INC.
 807 S. ROCK, SUITE 102
 GEORGETOWN, TEXAS 78626
 TEL: 512.869.1104 FAX: 512.869.1802

11
15

Date: 03/18/2002
 Page #: **D4.01**
 Drawn by: LCB
 Issued for: BID

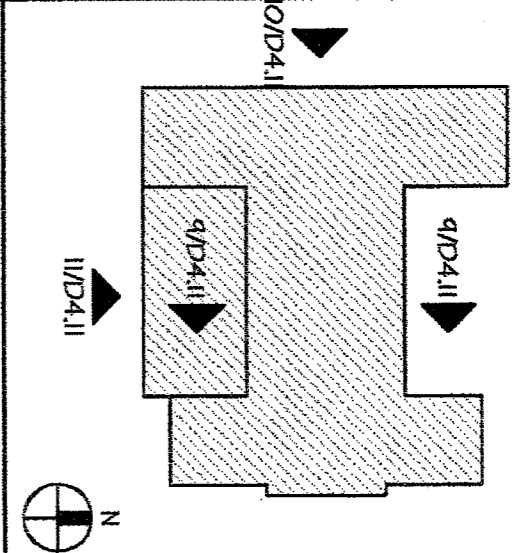


KEY PLAN

GEN. NOTES - ACTION ITEMS
WINDOW NOTES

APPLY TO SHEETS D4.10 - D4.11 ONLY


- DO NOT REMOVE EXISTING STEEL WINDOW SECTIONS. ALL WINDOWS HAVE BEEN STRIPPED OF EXISTING GLASS AND PAINT. REMOVE SEALING COMPOUND AND RESIDUE WITH GLAZING COMPUND PER SPECIFICATION AND REFLACE GLASS AS REQUIRED PER THE WINDOW SURVEY CHART.
- ALL WINDOWS TO RECEIVE NEW WEATHERSTRIPPING.
- REPAINT INTERIOR AND EXTERIOR SURFACE OF ALL EXISTING STEEL WINDOW FRAMES PER THE SPECIFICATION.
- CLEAN ALL EXISTING WINDOWS, REMOVE BINDS & CLEAN REMNANT BINDS AFTER INTERIOR ASPHALTIC PANELS INSTALLED.
- REMOVE ALL WINDOW LEVERS, CATALOGUE, BOX INDIVIDUALLY, LABEL AND RETURN TO OWNER.
- ALL OPERATING SASHES SHALL BE SCORED SAFT.
- ALL WINDOW OPENINGS TO RECEIVE INTERIOR ASPHALTIC MAGNETIC WINDOW PANELS - SEE DETAILS 1.4, 1.11 - D4.12.
- PAINT EXISTING STEEL LINTELS THAT HAVE BEEN STRIPPED AND PREPARED BY PREVIOUS CONTRACT.

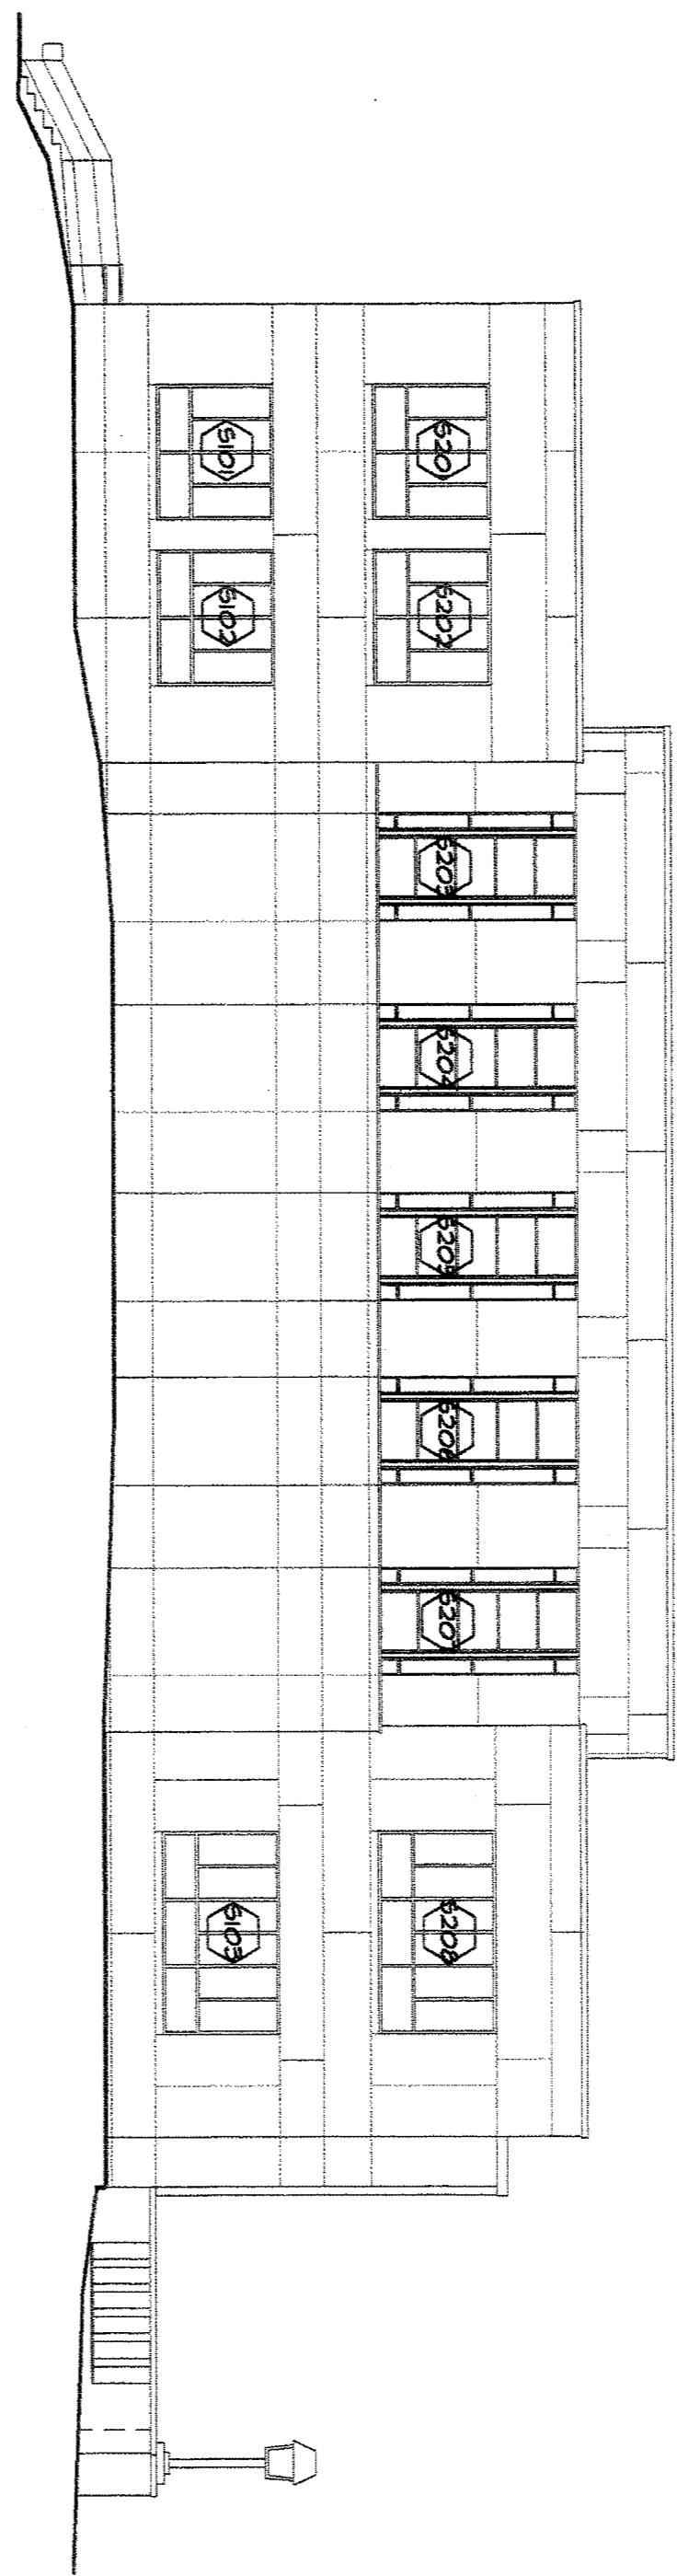

EXISTING SOUTH ELEVATION

SCALE: 3/32" = 1'-0"


11

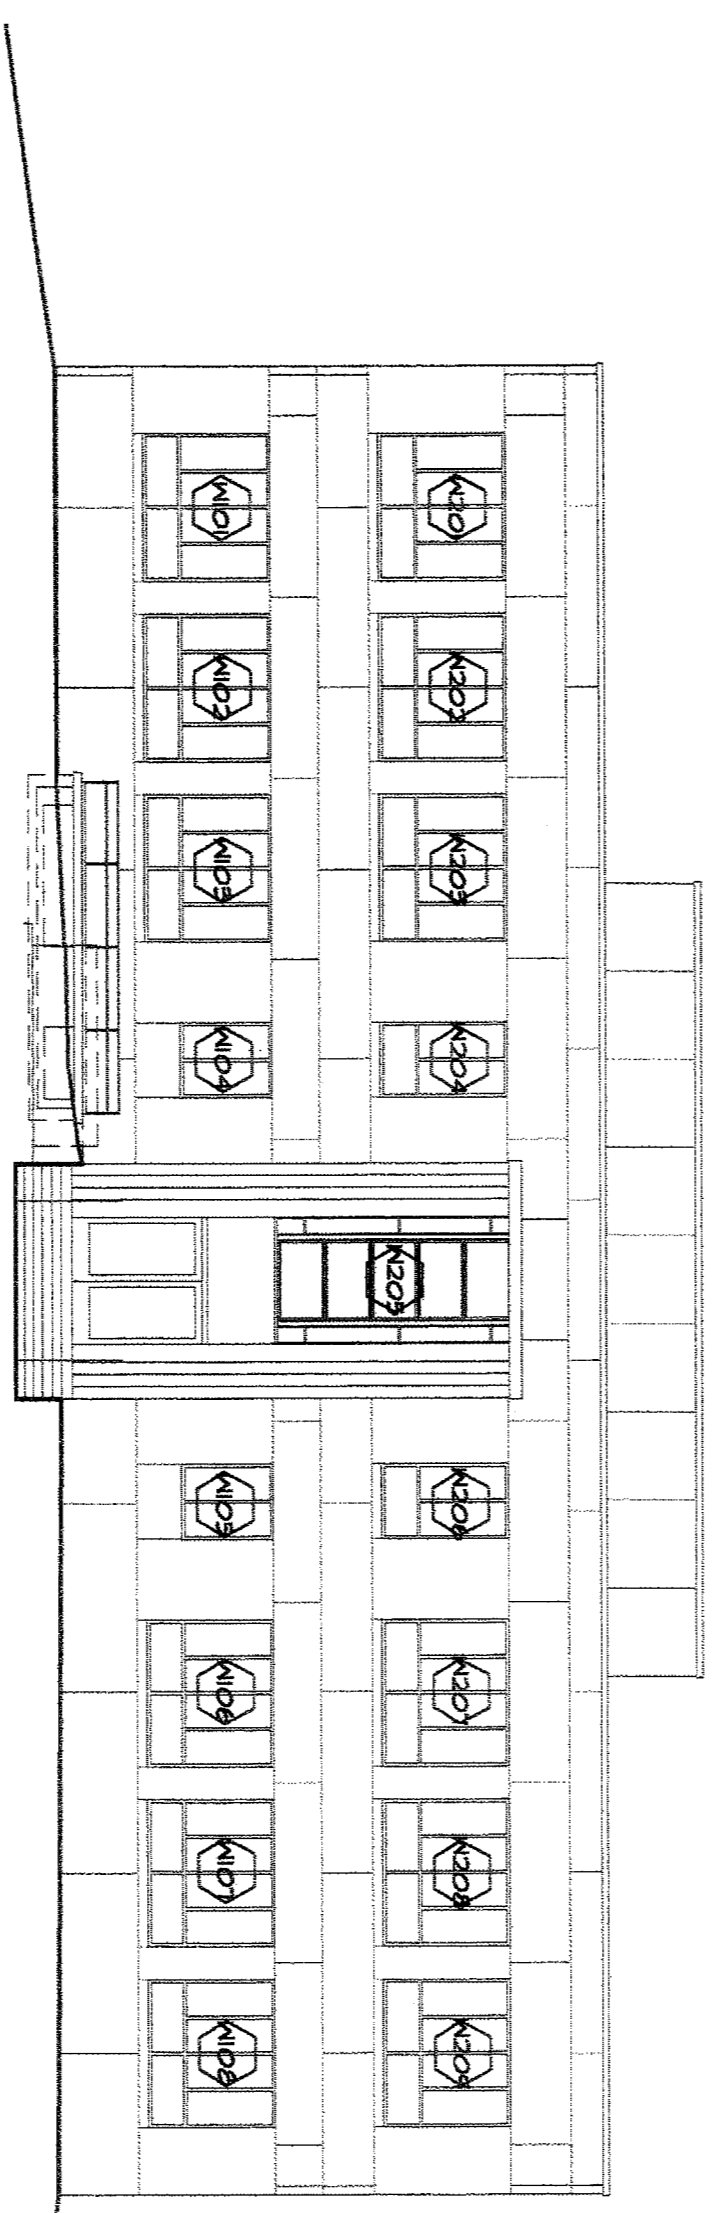

EXISTING WEST ELEVATION

SCALE: 3/32" = 1'-0"

10

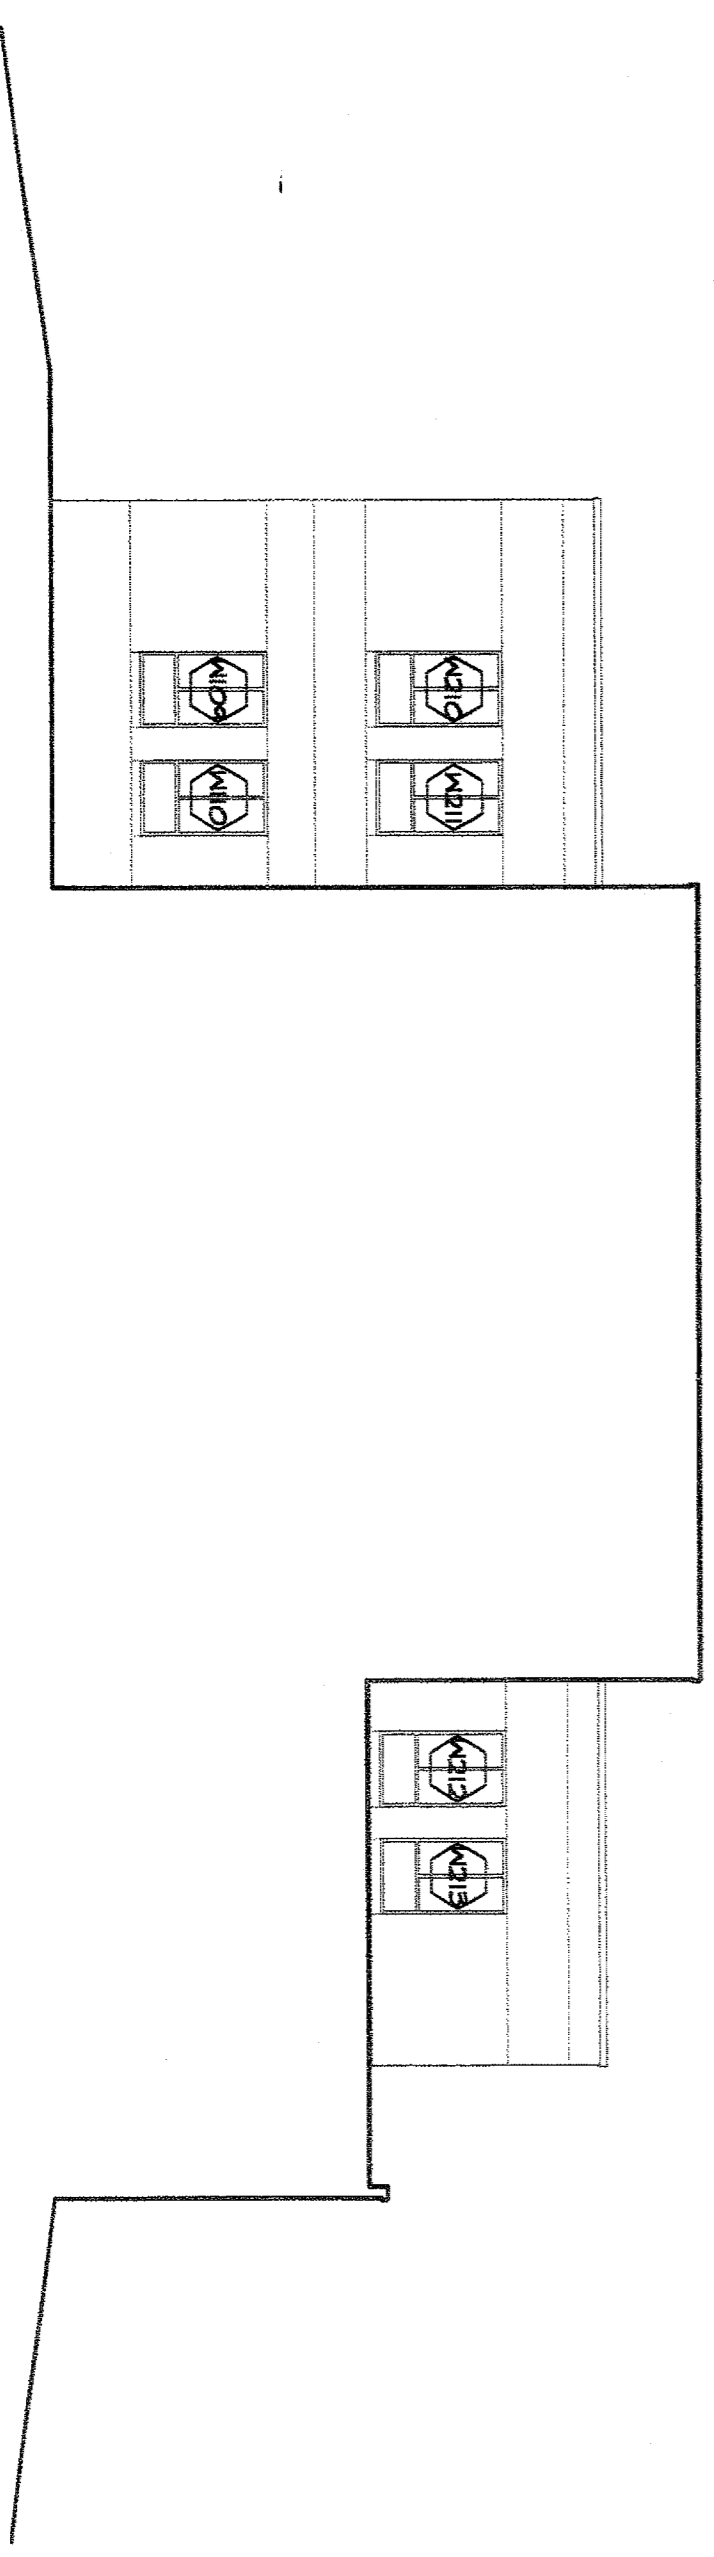

EXISTING WEST ELEVATION

SCALE: 3/32" = 1'-0"

9

Item #	Window #	Window Type	Sash			Frame			Operating Device / Hardware			Int. Alum. Ext. Alum.		E. Sill. Sill/Glass Leaks	Other				
			A	B	C	D	E	A	B	C	D	E	F			G	H	I	T
S101	C																		
S102	C																		
S103	D																		
S201	C																		
S202	C																		
S203	A																		
S204	A																		
S205	A																		
S206	A																		
S207	A																		
S208	D																		

Condition: Corroded - CR, Missing - M, Finish

Rehabilitation: Repair - RR (See Specifications), Replace - R

WINDOW SURVEY - SOUTH ELEVATION

3

Item #	Window #	Window Type	Sash			Frame			Operating Device / Hardware			Int. Alum. Ext. Alum.		E. Sill. Sill/Glass Leaks	Other				
			A	B	C	D	E	A	B	C	D	E	F			G	H	I	T
W101	C																		
W102	C																		
W103	C																		
W104	B																		
W105	B																		
W106	C																		
W107	C																		
W108	C																		
W109	B																		
W110	B																		
W201	C																		
W202	C																		
W203	C																		
W204	B																		
W205	A																		
W206	B																		
W207	C																		
W208	C																		
W209	C																		
W210	B																		
W211	B																		
W212	B																		
W213	B																		

Condition: Corroded - CR, Missing - M, Finish


Rehabilitation: Repair - RR (See Specifications), Replace - R

WINDOW SURVEY - WEST ELEVATION

1

Sheet Title:
SOUTH & WEST WINDOW SURVEYS





Project:
BURNETT COUNTRY COURTHOUSE
BURNETT, TEXAS

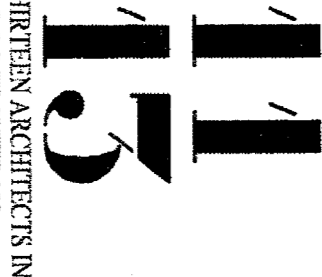


ELEVN THIRTEEN ARCHITECTS INC.
807 S. ROCK SUITE 102
GEORGETOWN, TEXAS 78624
TEL 512.893.1104 FAX 512.897.1562

Date: 03/18/2002
Drawn by: LCB
Issued for: BID

Sheet: **D4.11**

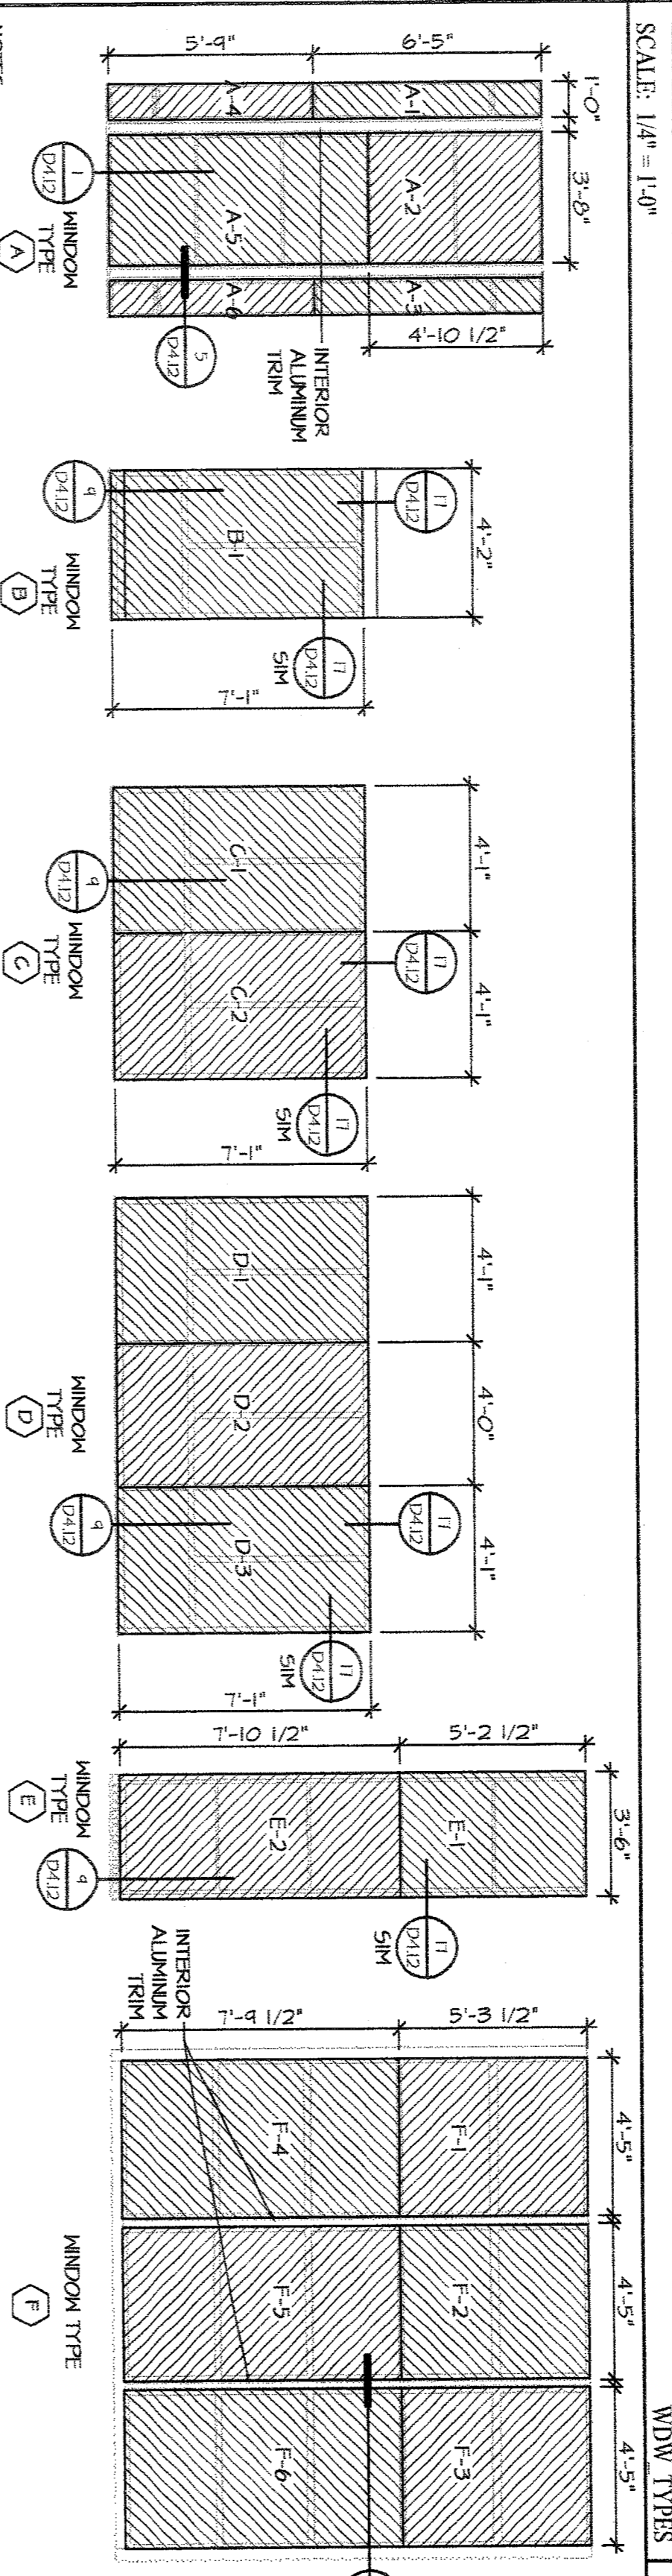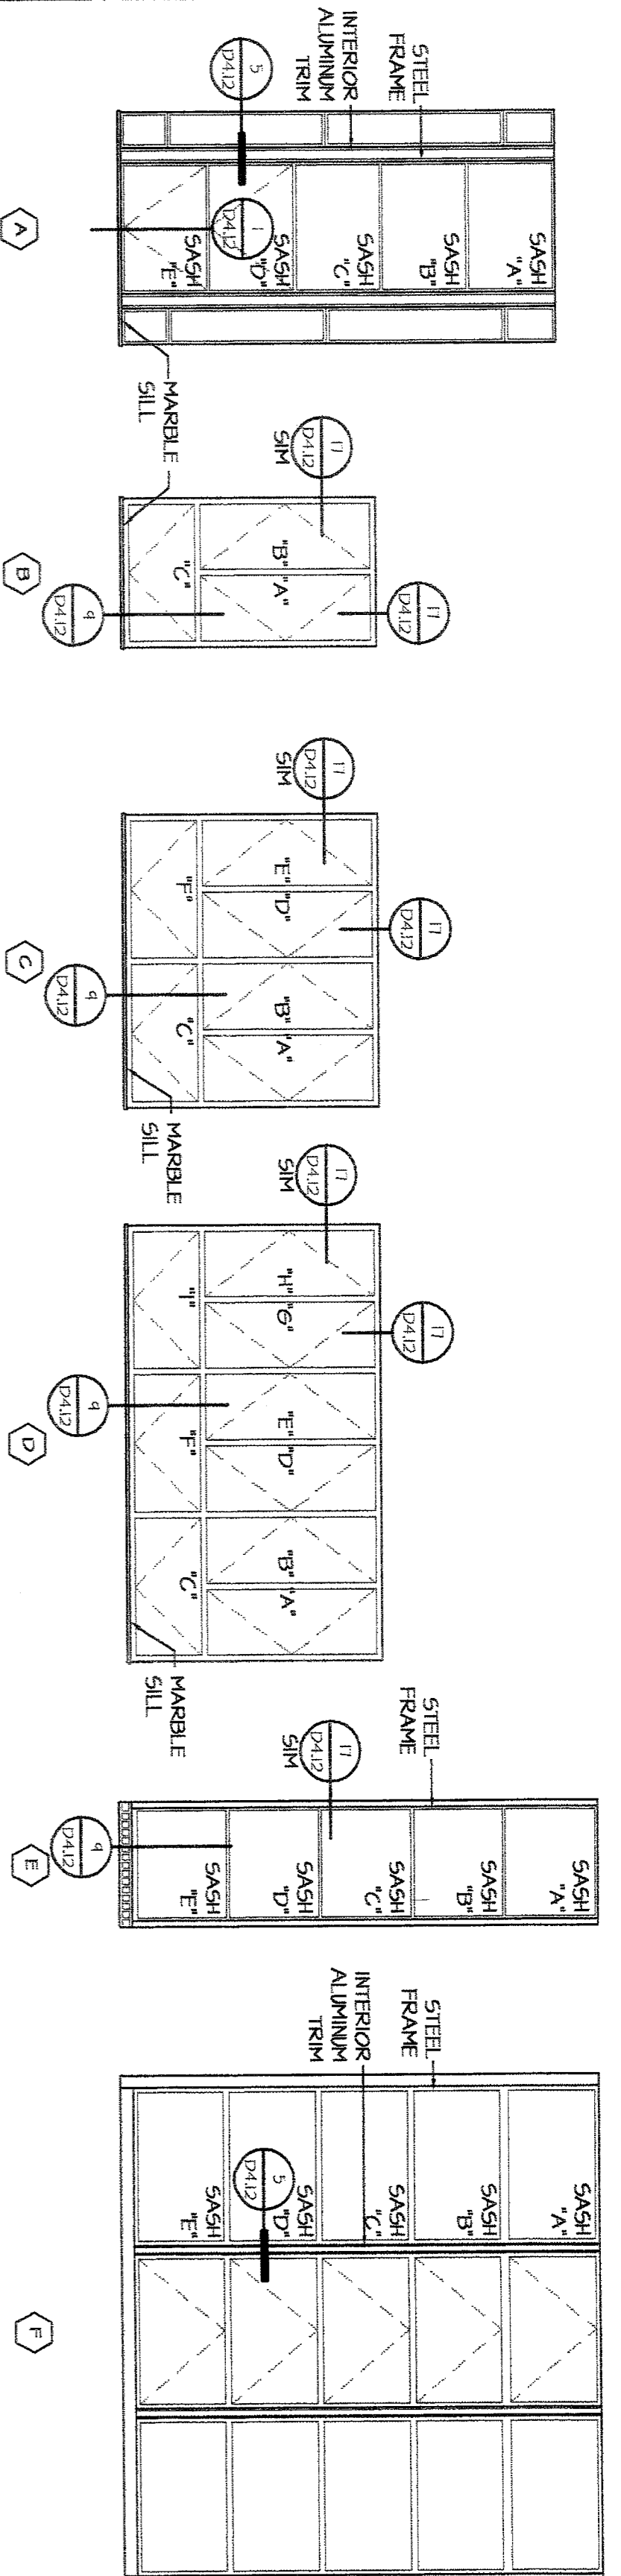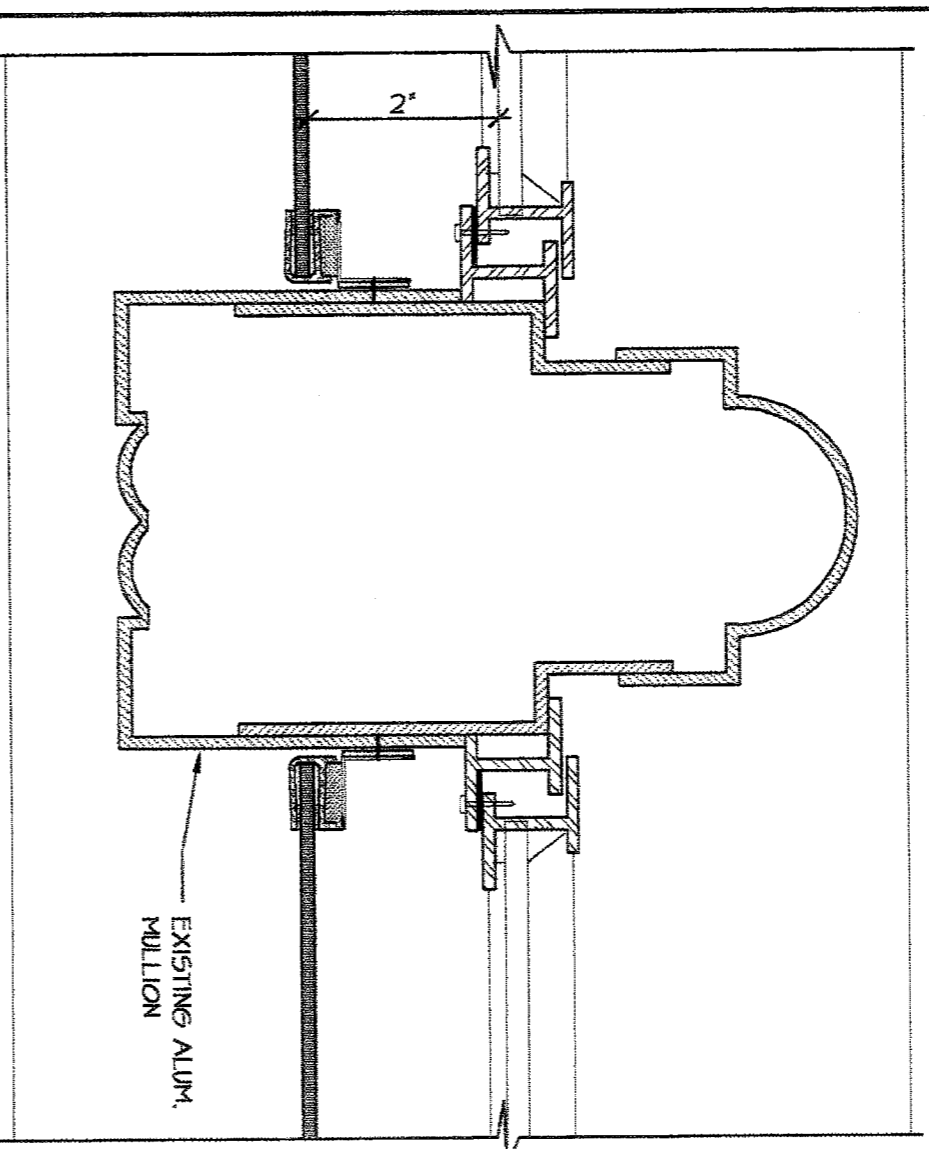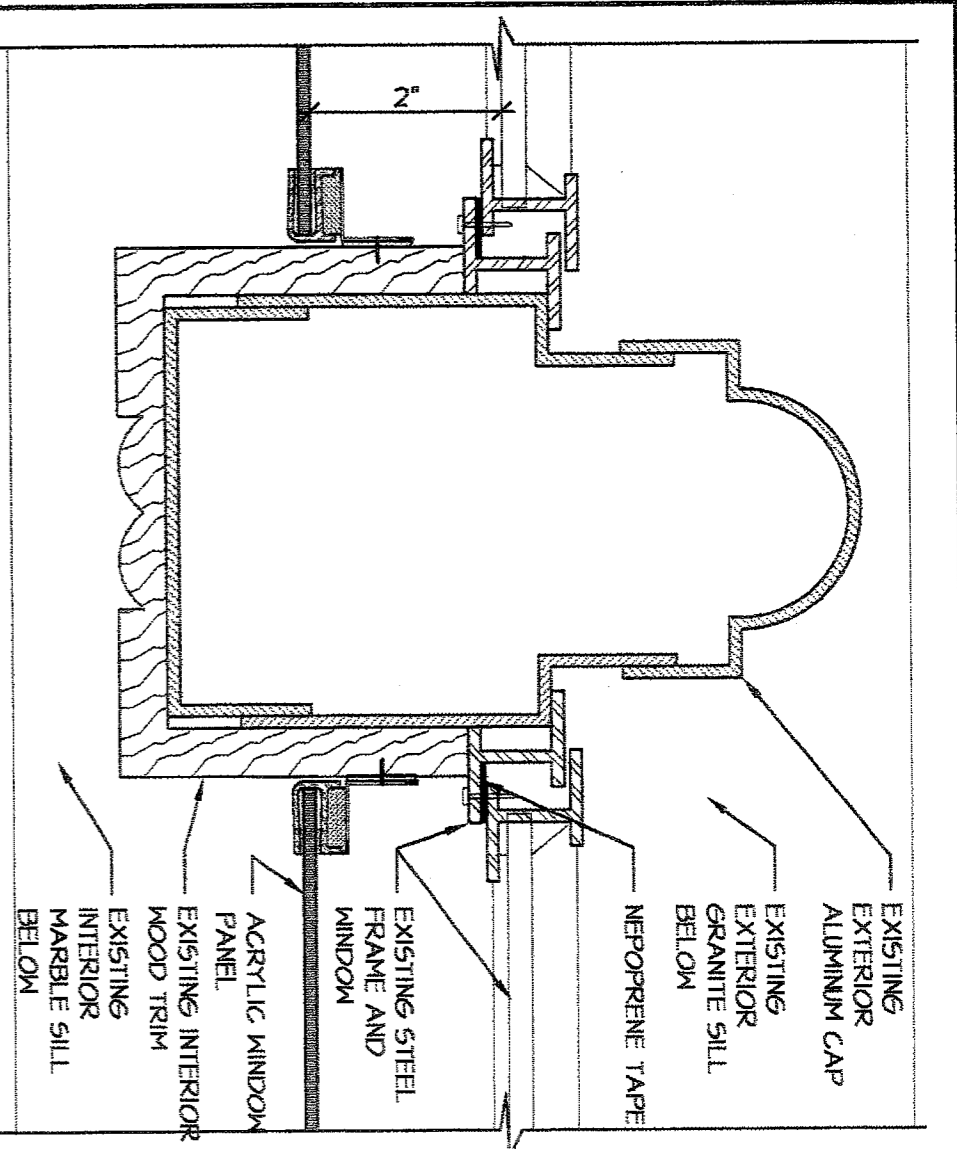




- GEN. NOTES - ACTION ITEMS**
WINDOW NOTES
APPLY TO SHEETS D4.10 - D4.11 ONLY
- DO NOT REMOVE EXISTING STEEL WINDOW SECTIONS. ALL WINDOWS HAVE BEEN STRIPPED OF OLD PAINT AND PREPARED FOR NEW FINISH BY THE CONTRACTOR. REFER TO SPECIFICATIONS AND REFINISH GLASS AS REQUIRED FOR THE WINDOW SURVEY CHART.
 - ALL WINDOWS TO RECEIVE NEW HEATERS/STRIPPING.
 - REPAINT INTERIOR AND EXTERIOR SURFACE OF ALL EXISTING STEEL WINDOW FRAMES PER THE SPECIFICATIONS.
 - CLEAN ALL EXISTING WINDOWS, REMOVE BLINDS & CLEAN REINSTALL BLINDS AFTER INTERIOR ACRYLIC PANELS INSTALLED.
 - REMOVE ALL WINDOW LEVERS, CATALOGUE, BOX INDIVIDUALLY LABEL, AND RETURN TO OWNER.
 - ALL OPERATING SASHES SHALL BE SCREWED SHUT.
 - ALL WINDOW OPENINGS TO RECEIVE INTERIOR ACRYLIC MAGNETIC WINDOW PANELS - SEE DETAILS D4.1 & D4.12.
 - PAIN EXISTING STEEL LINTELS THAT HAVE BEEN STRIPPED AND PREPARED BY PREVIOUS CONTRACT.

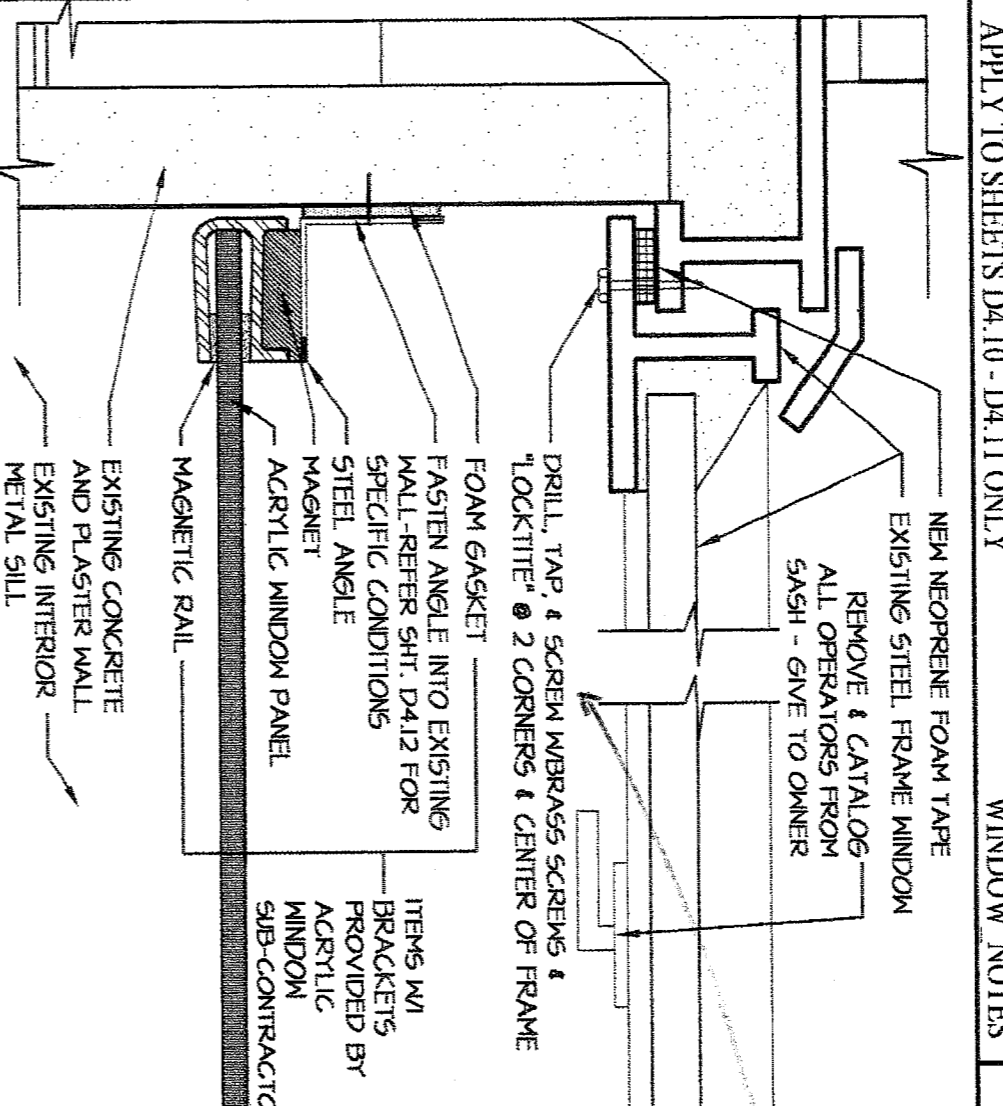

MULLION DET. - WINDOW A
SCALE: 6" = 1'-0"
08A001

ACRYLIC WINDOW PANEL LAYOUT
SCALE: 1/4" = 1'-0"

TYP. ACRYLIC WINDOW PANEL
SCALE: FULL SCALE
08A017

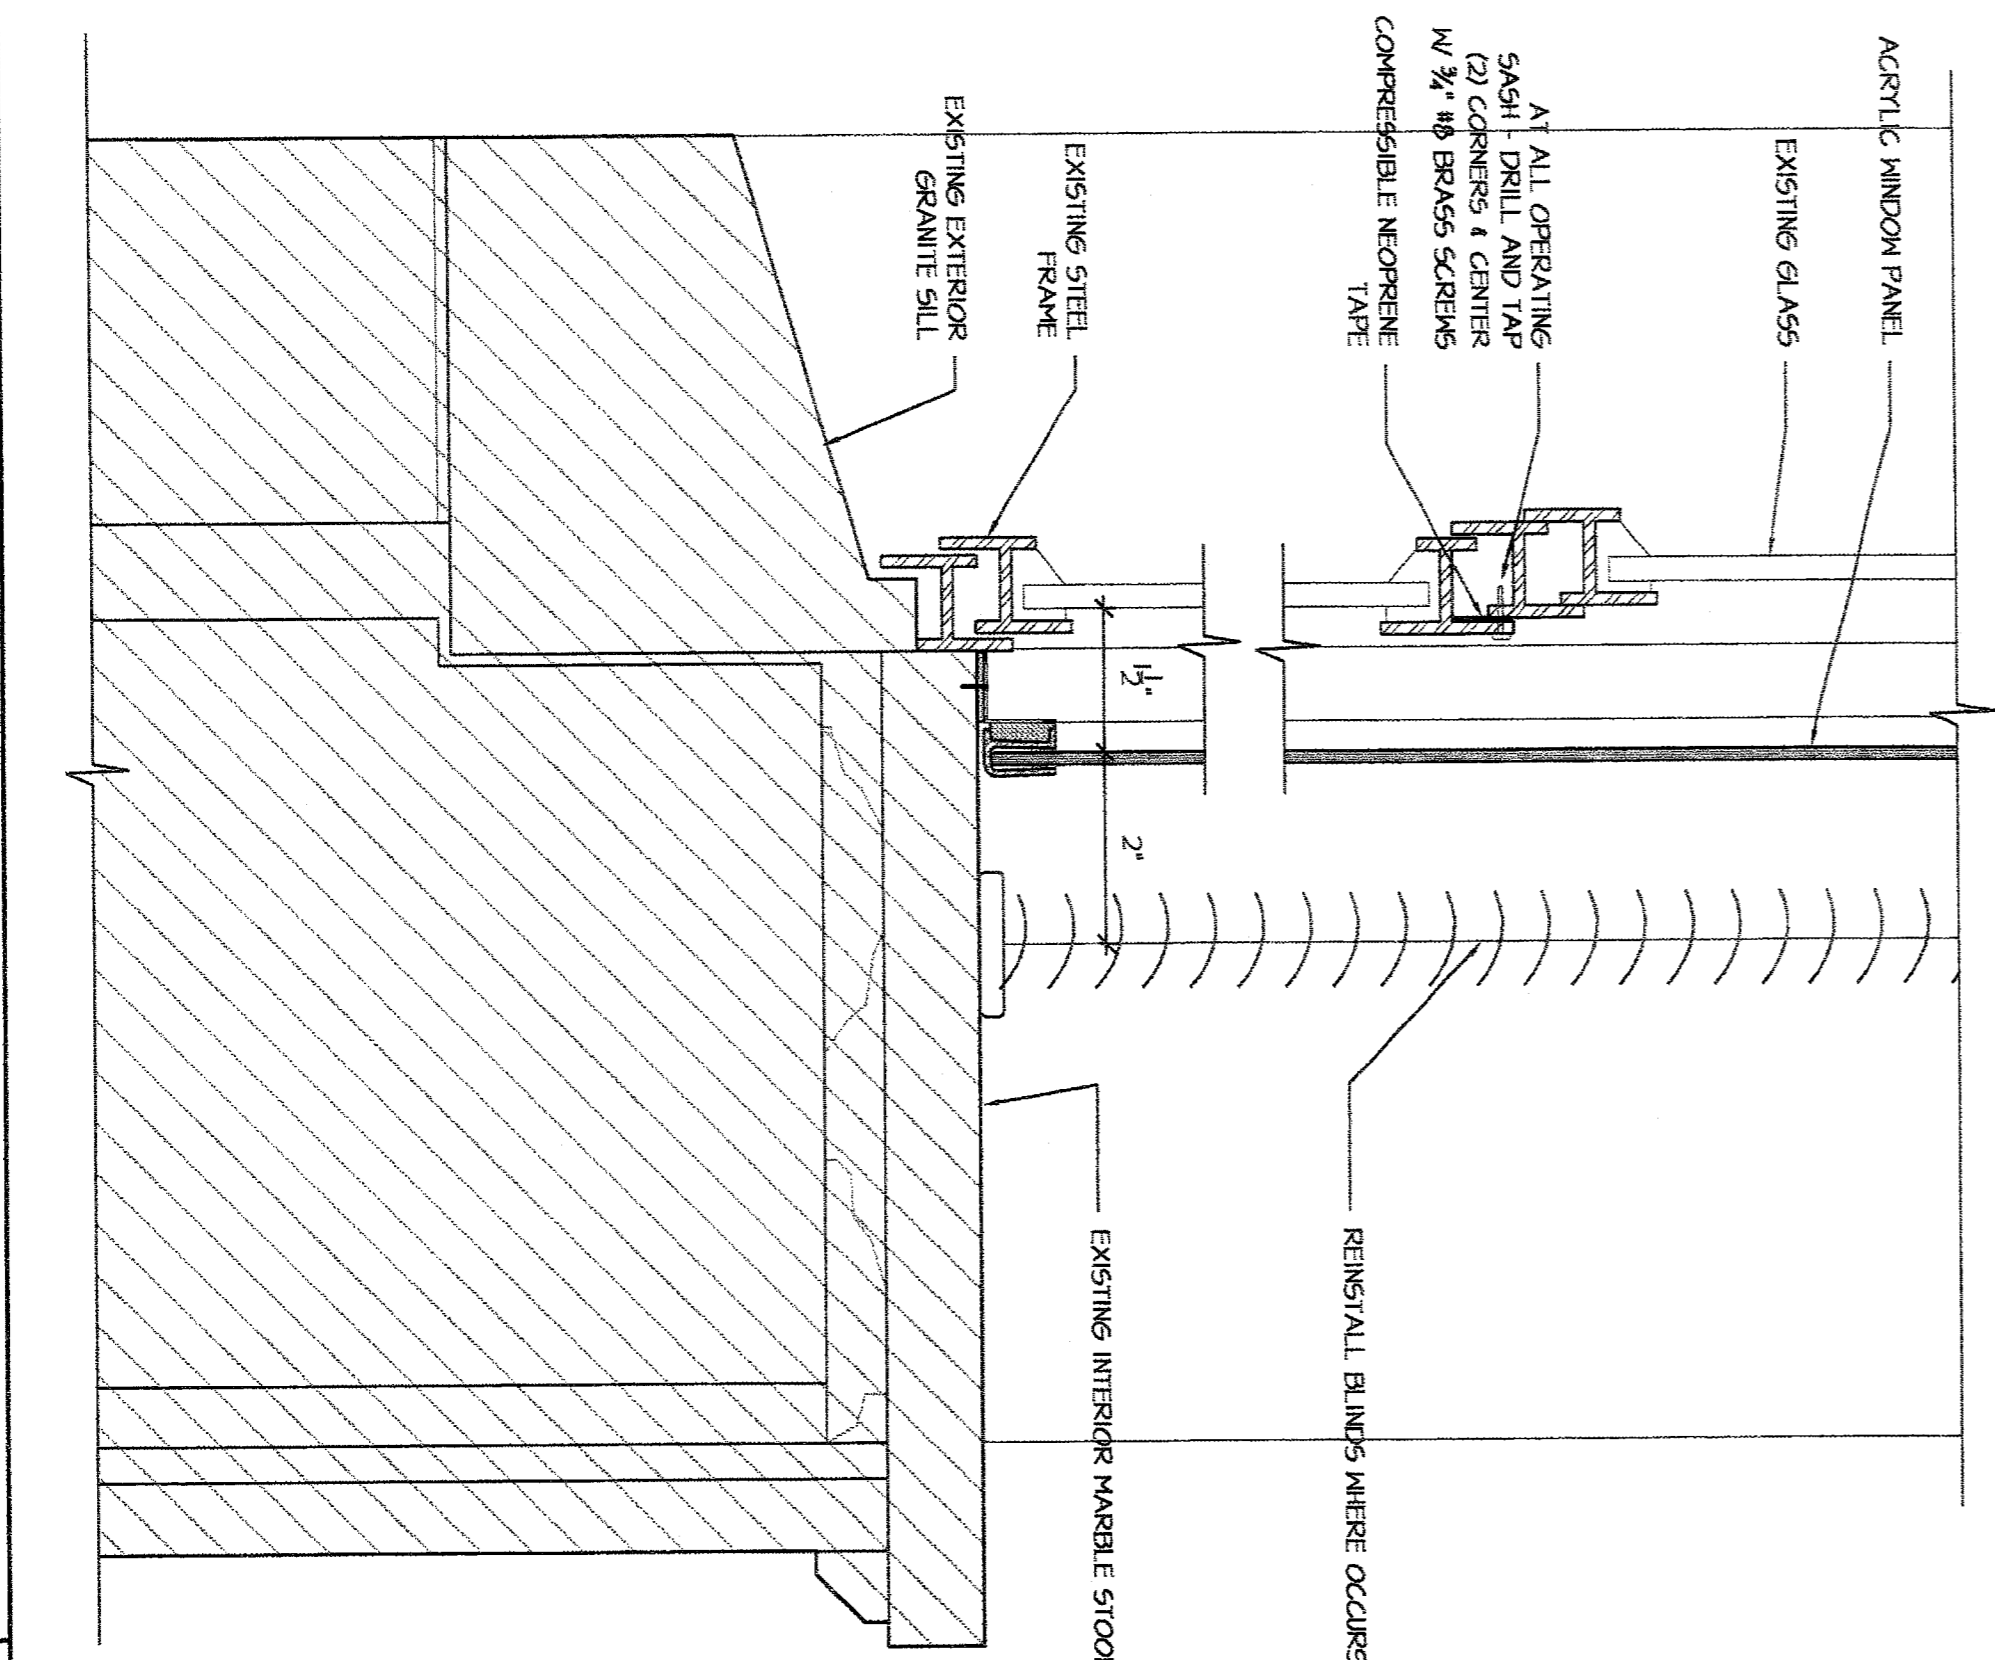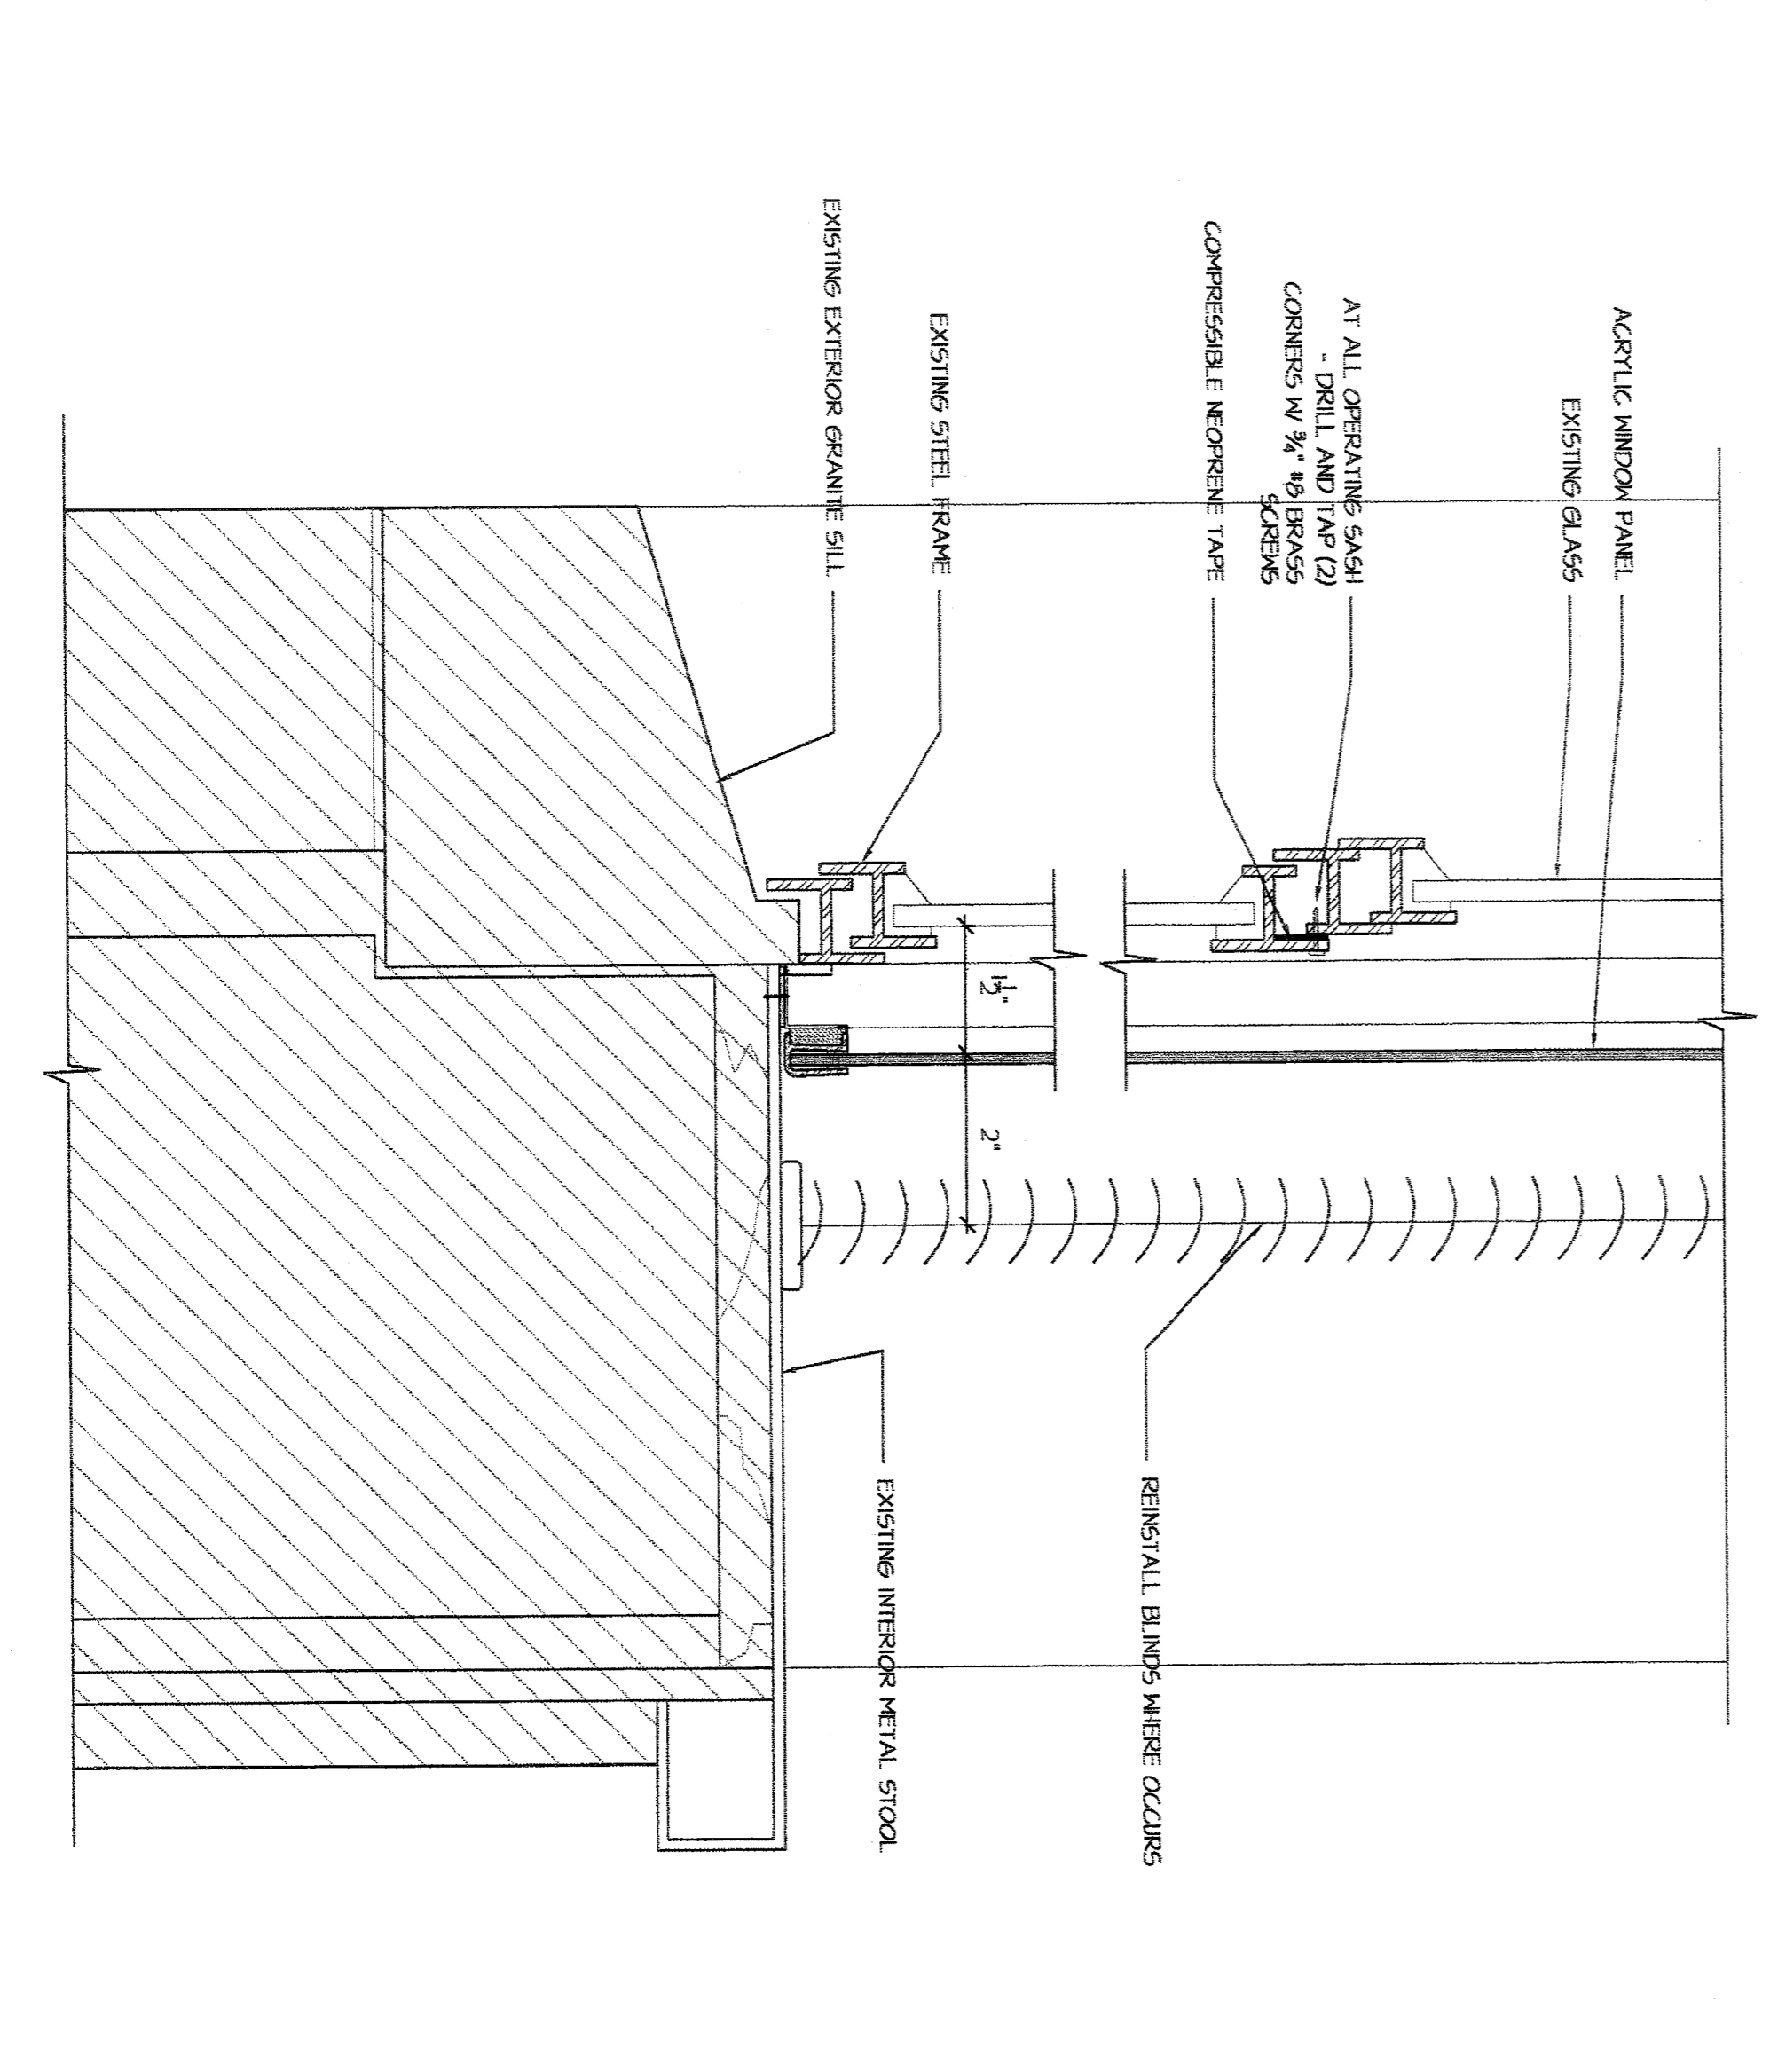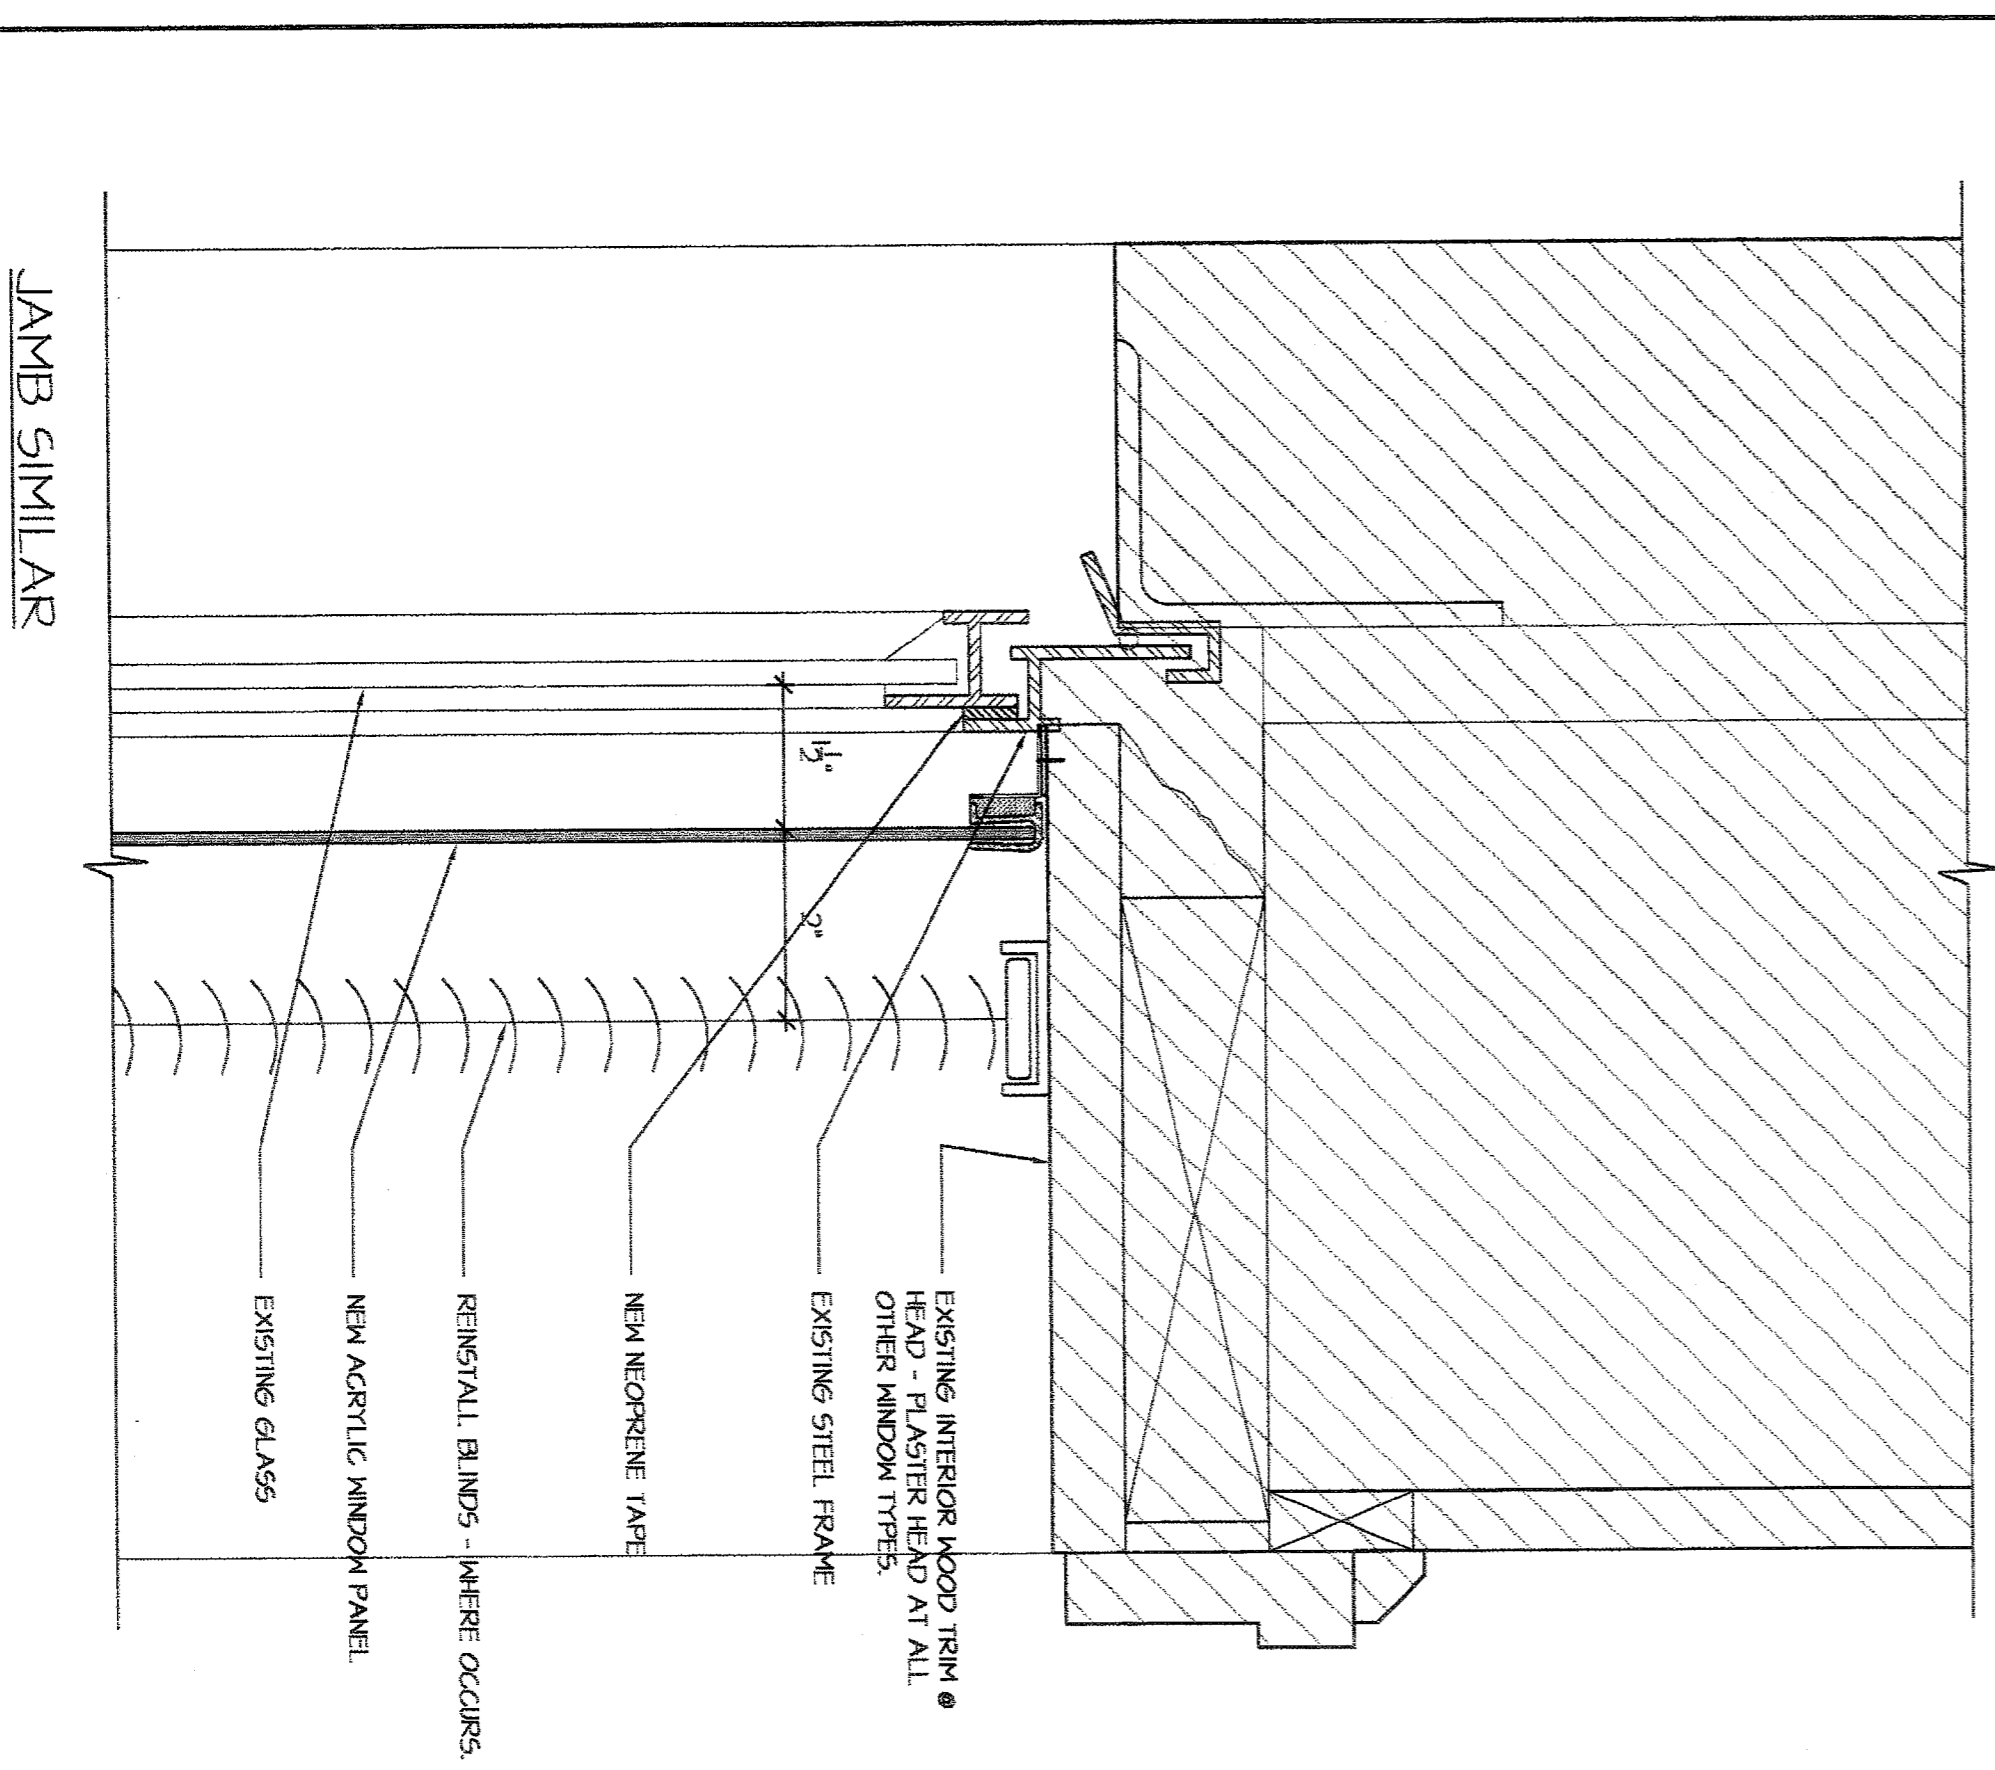


HEAD DET. WIN. TYPE C - SIM @ A,B,D,E,&F
SCALE: 6" = 1'-0"
08A023

SILL DETAIL WINDOW TYPE C - SIMILAR @ B & D
SCALE: 6" = 1'-0"
08A022

SILL DETAIL WINDOW A
SCALE: 6" = 1'-0"
08A002

REVISIONS

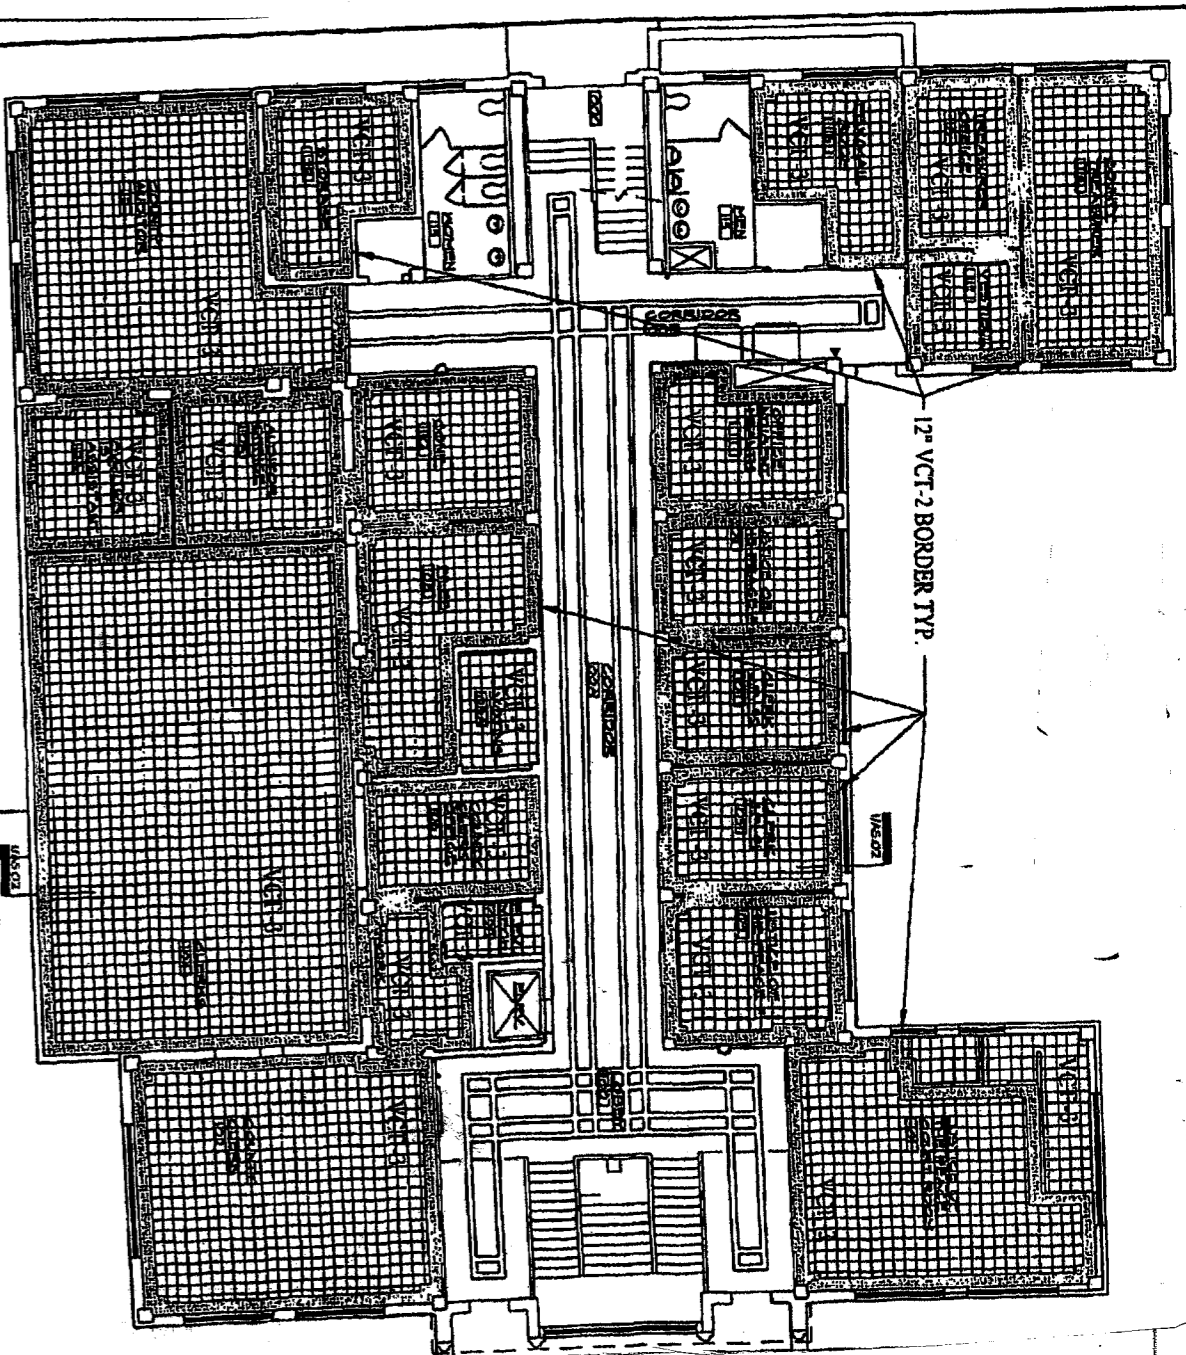


15
VCT FLOOR PATTERNS
FIRST FLOOR
BURNET COUNTY COURTHOUSE
RESTORATION AND RENOVATION

Sheet #
Project:
Date: 9/18/2002

COLOR LEGEND

Burnet County Courthouse Restoration and Renovation
Rubber Stair Treads - Solter Industries, Krueger, Dark Green
Rubber base - Kopppe, P131, Bisque
VCT1 - Azrock, V-994-Gamtree, *Candydawn AL-64 Smith Fe Clay - Red*
VCT2 - Azrock, V-938, Balsam - *Green*
VCT3 - Azrock, V-874, Desert Haze - *Tan*
(Reference SKA17 and SKA18 for VCT patterns.)

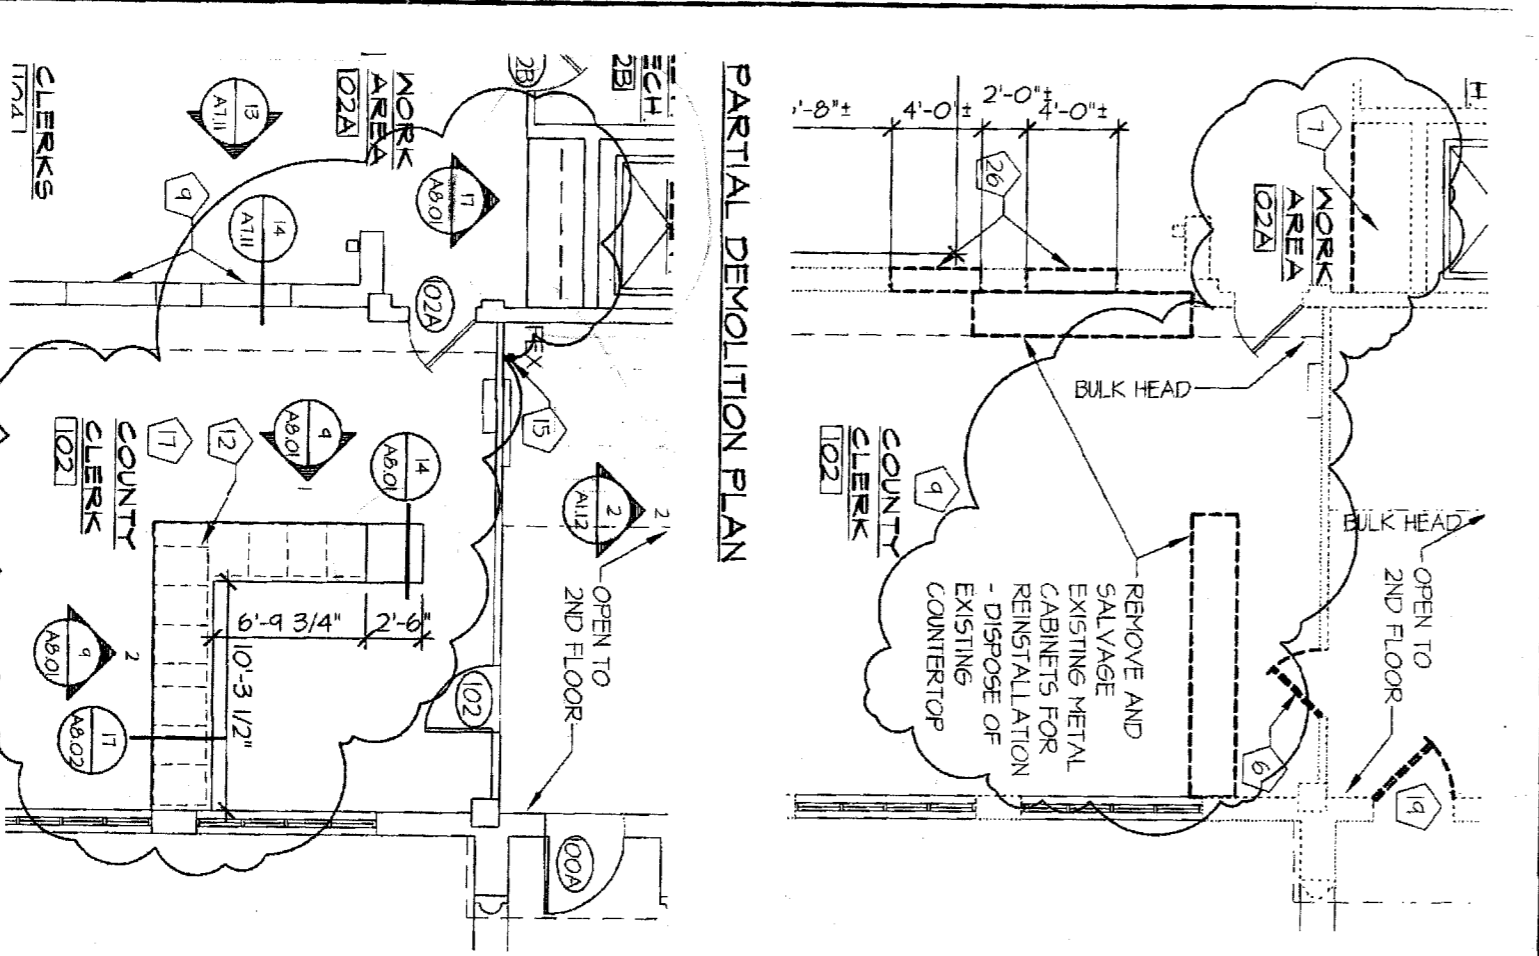

PARTIAL FIRST FLOOR PLAN

11
CASEWORK DETAILS
COUNTY CLERK AREA
BURNET COUNTY COURTHOUSE
RESTORATION AND RENOVATION



Sheet #
Project:
Date: 5/17/02

FIRST FLOOR PLAN

SCALE: 1/8" = 1'-0"


COUNTER @ COUNTY CLERK 17

SCALE: 1" = 1'-0"

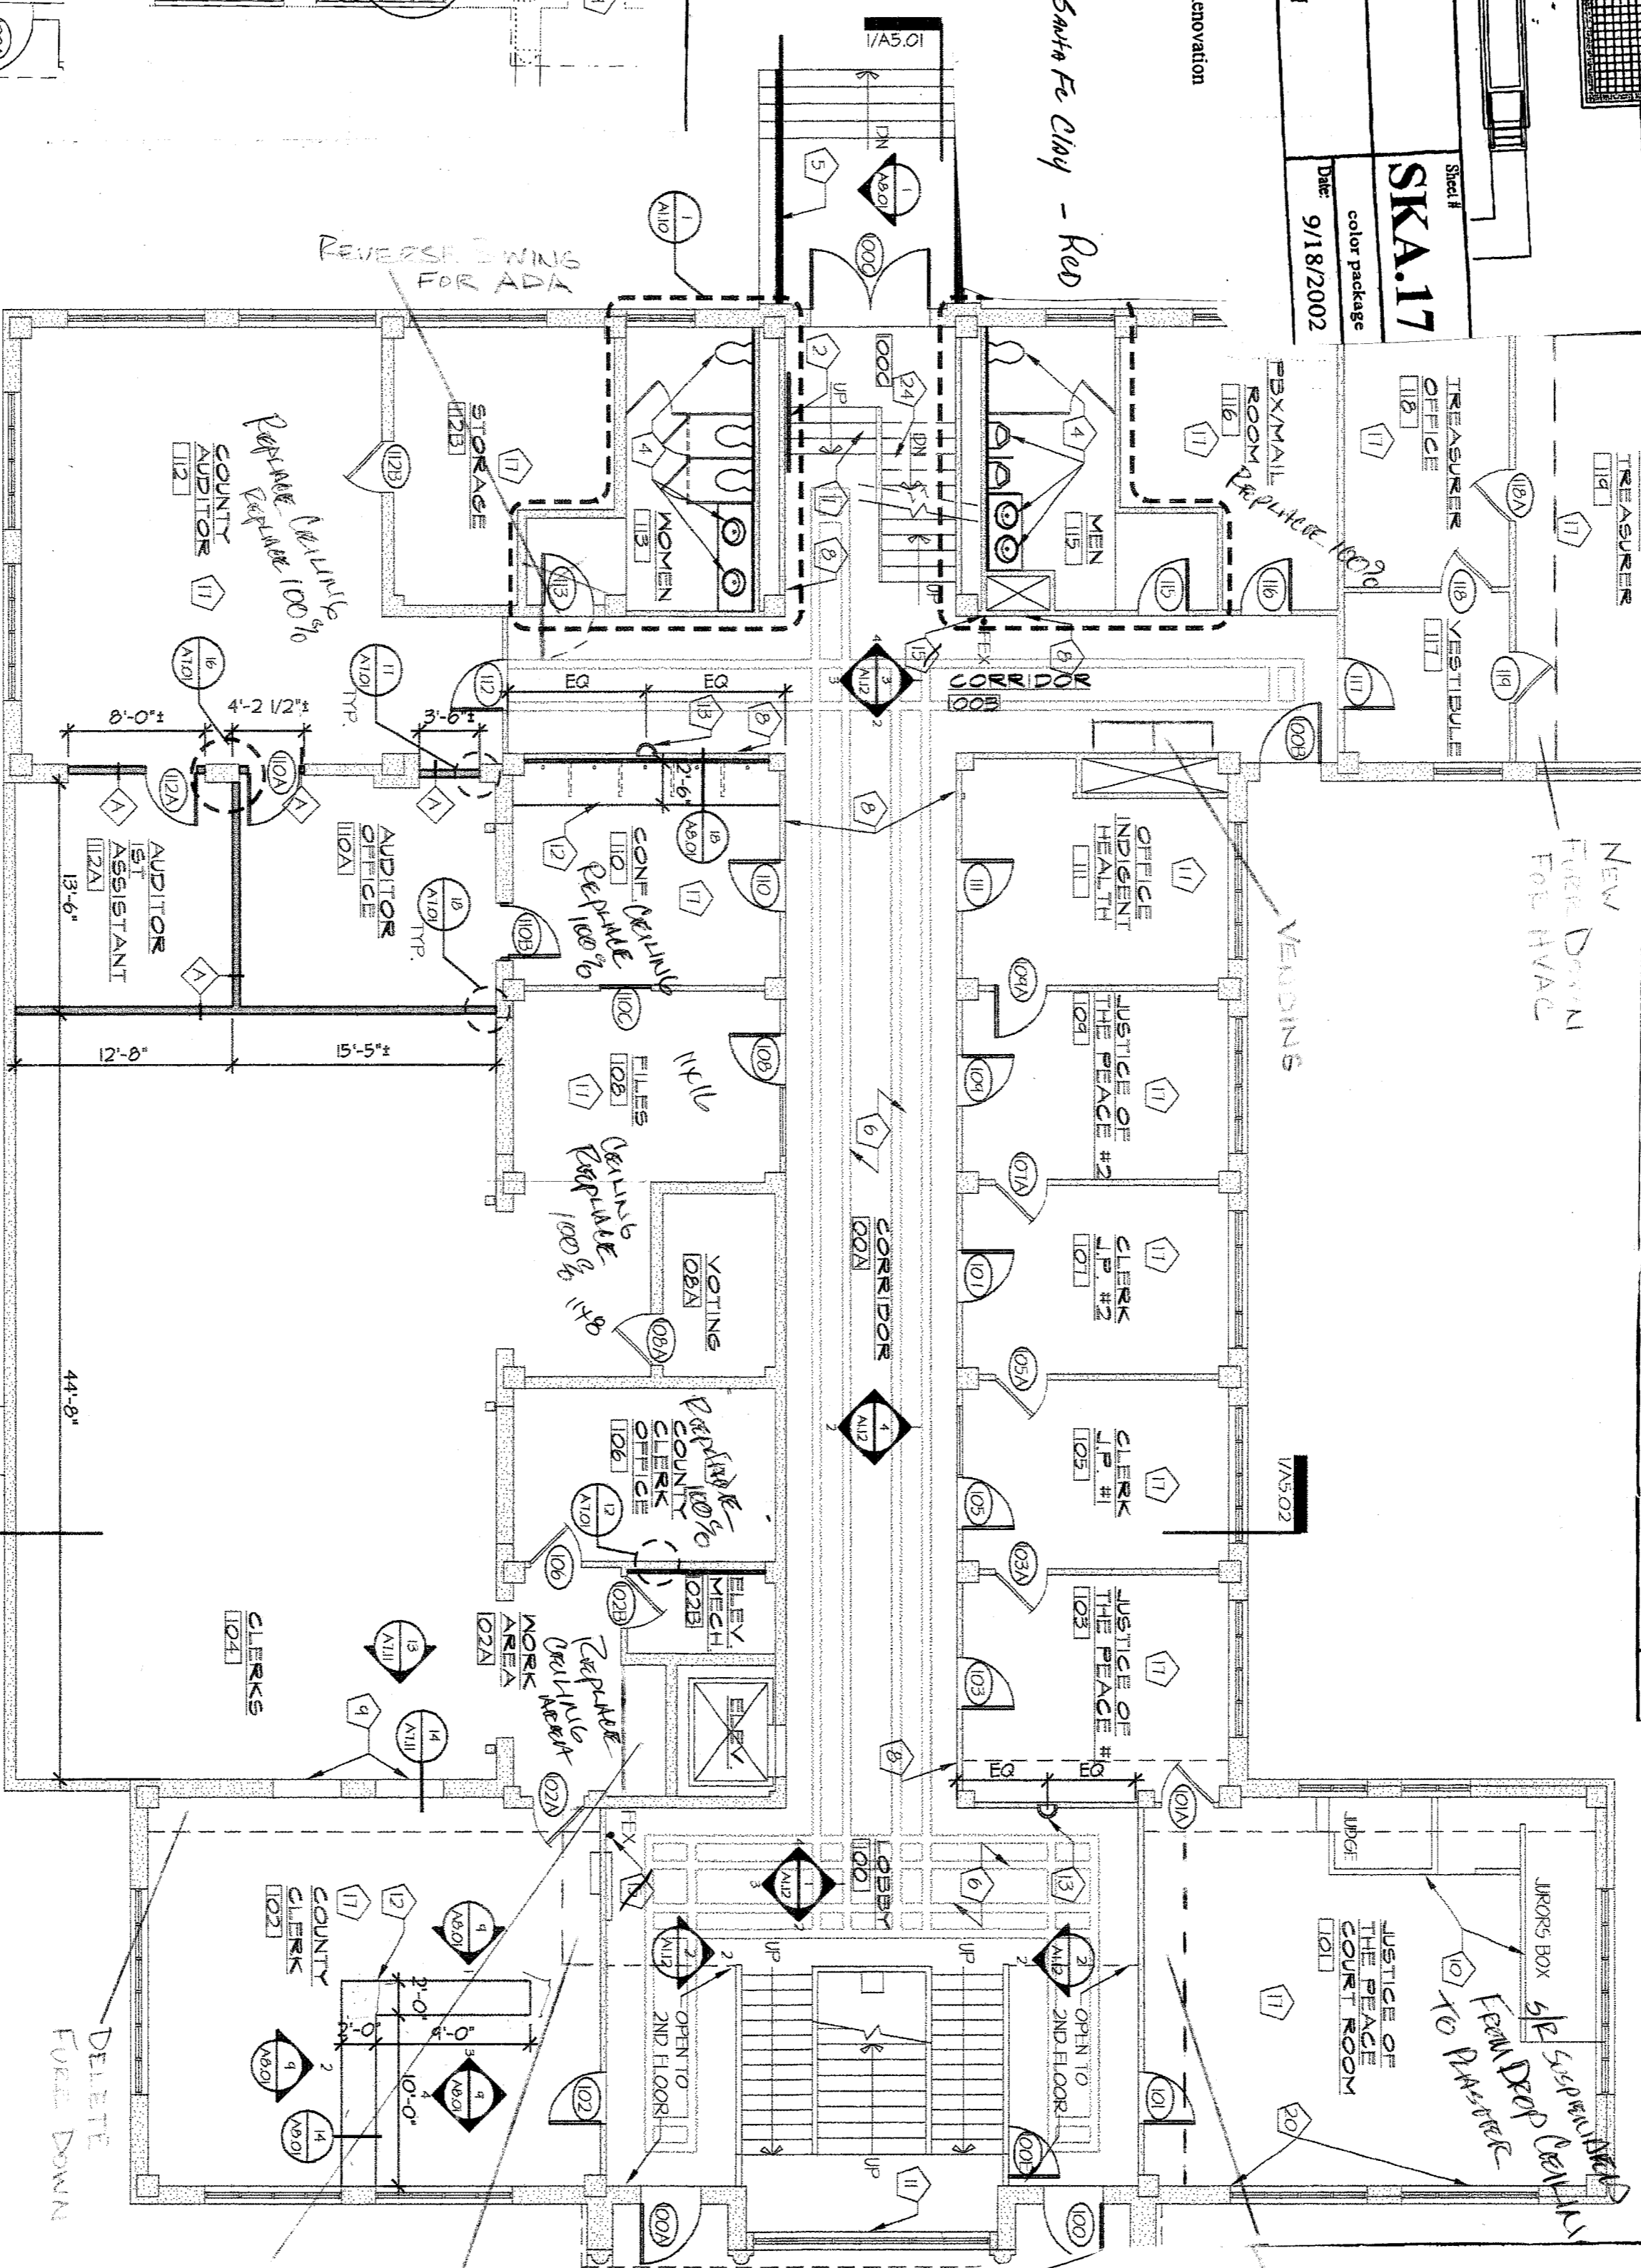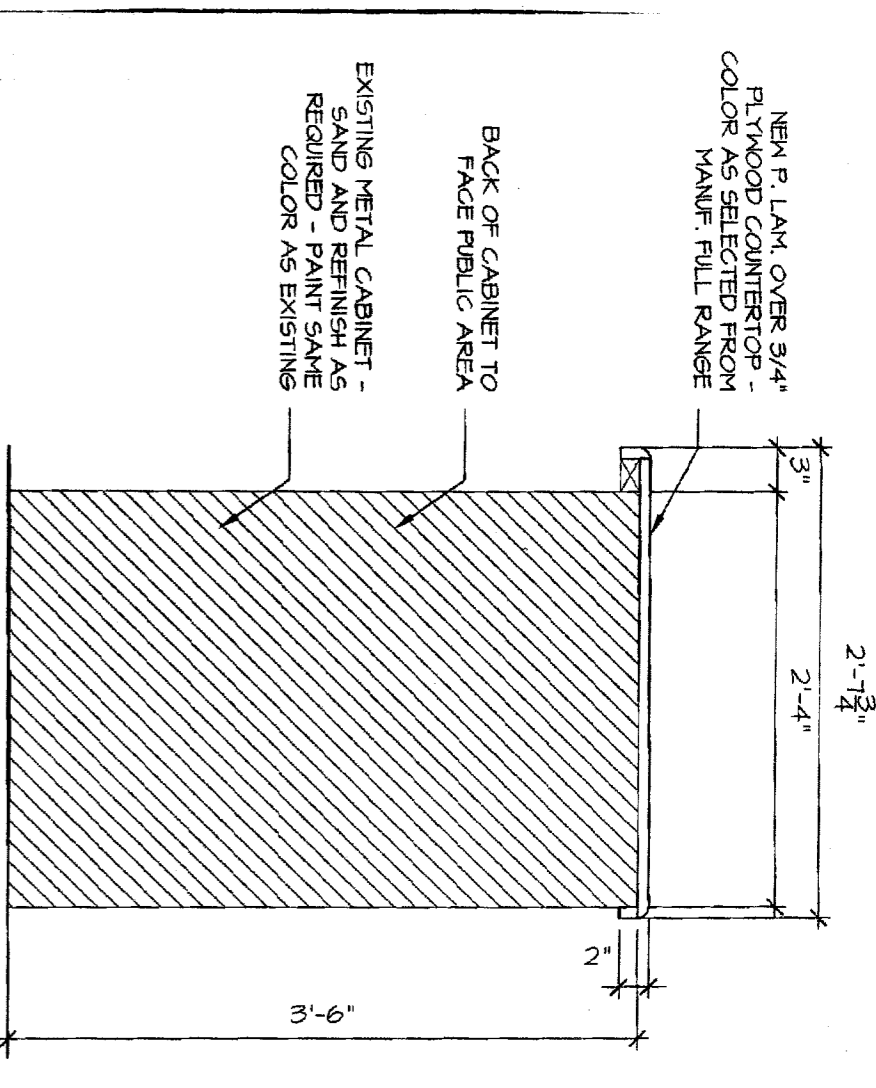

SKA09
REVISED CEILING IN ROOM 101, 102
REF: A101
BURNET COUNTY COURTHOUSE
RESTORATION AND RENOVATION

Sheet #
Project:
Date: 8/7/2002

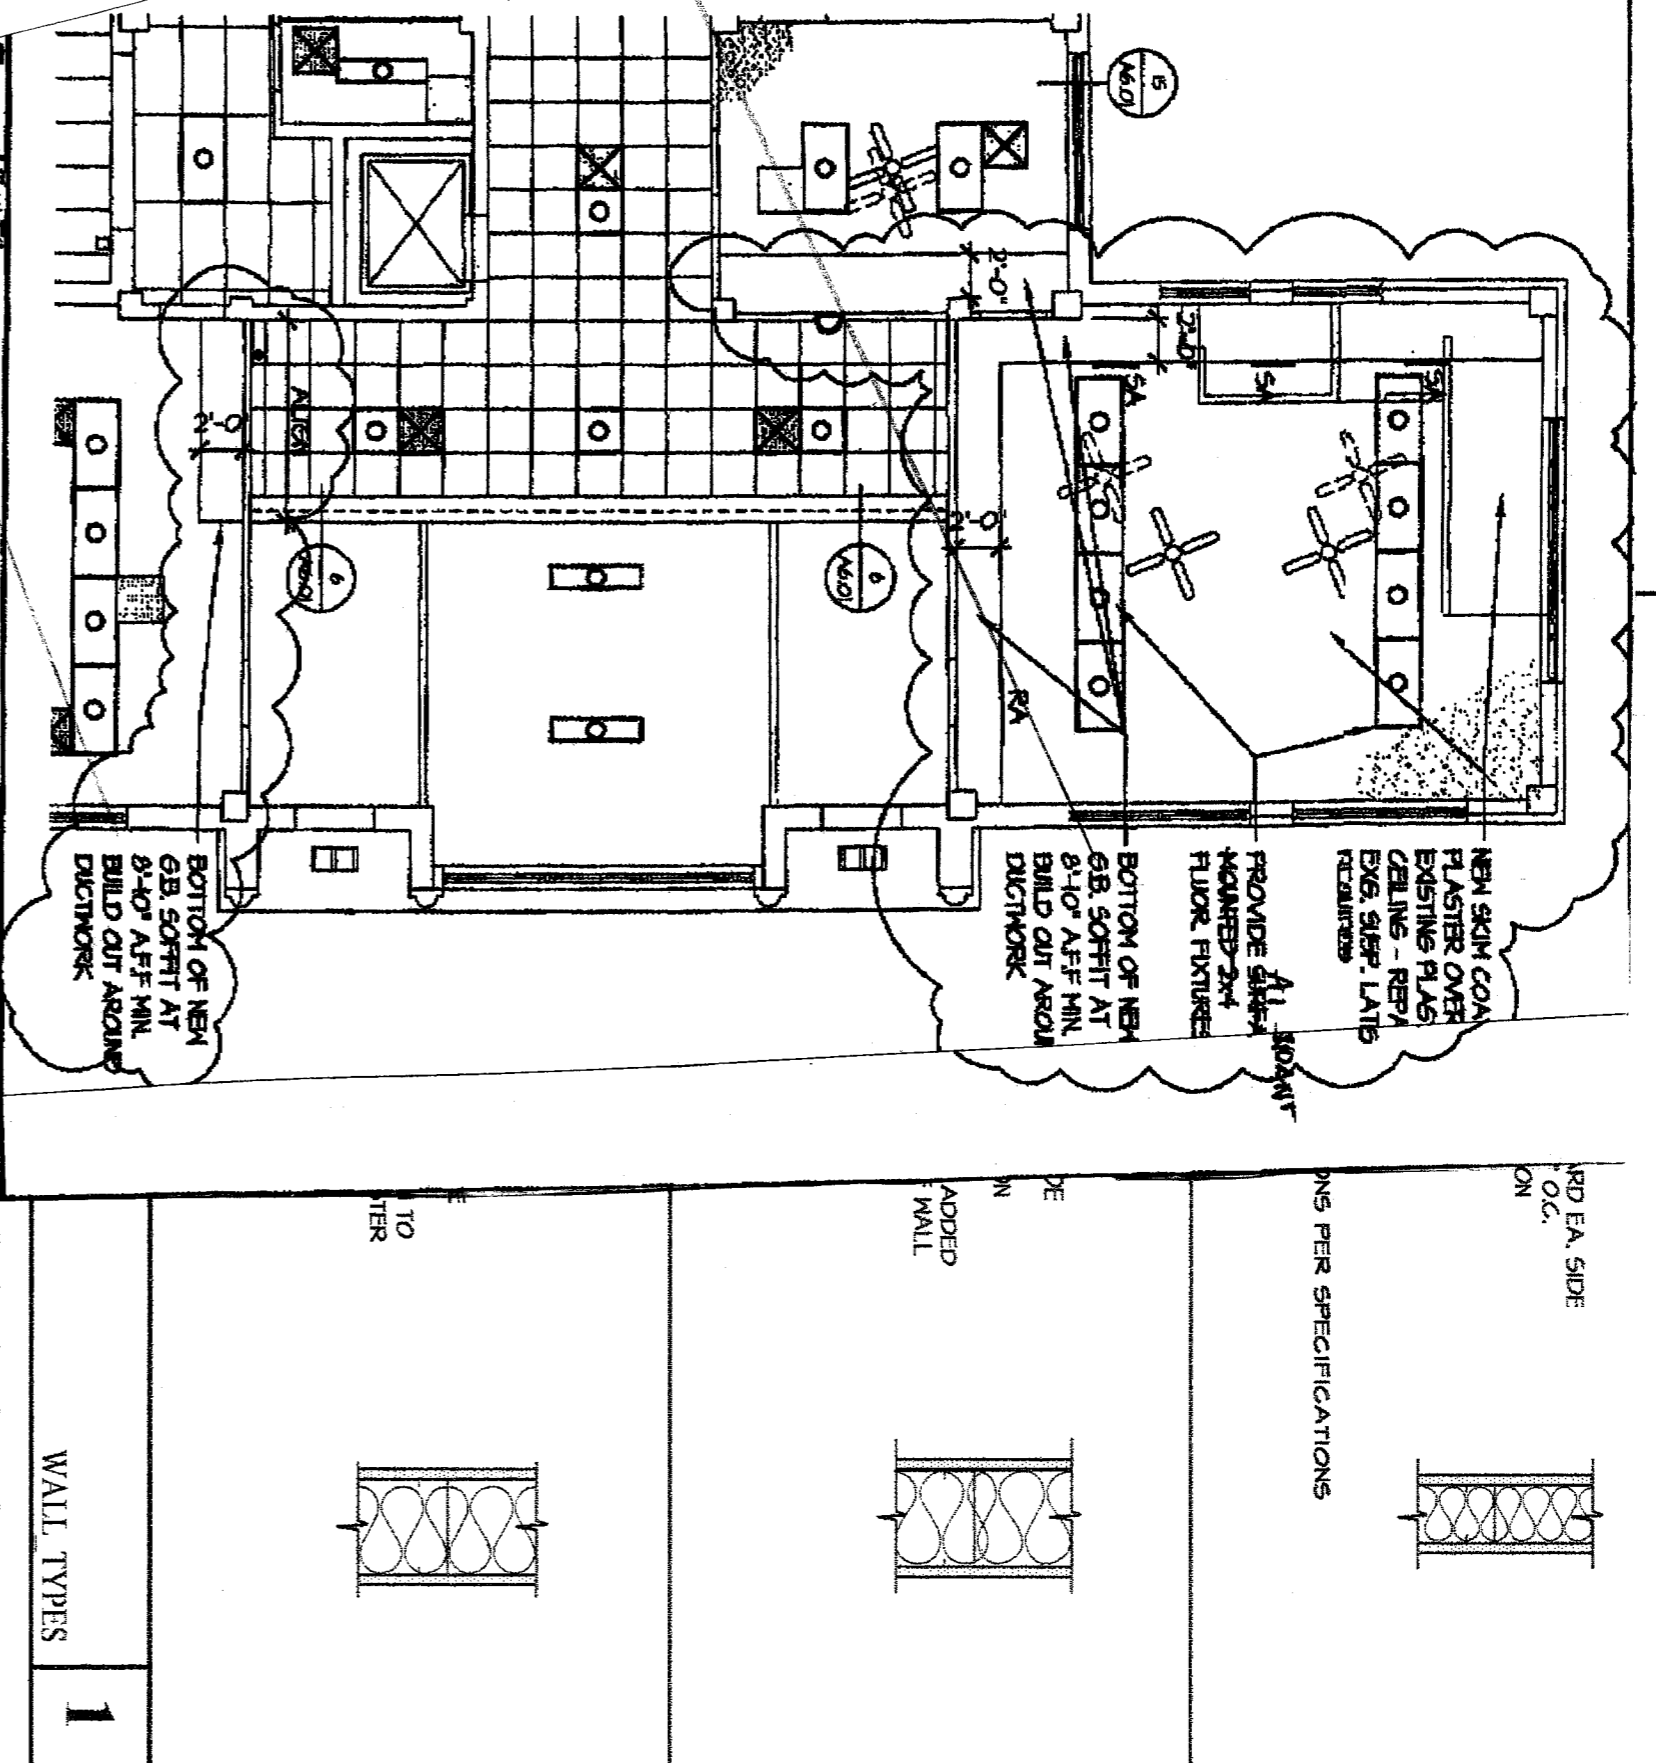

KEYNOTES

APPLY TO SHEETS A1.01-A1.03 ONLY

- 1. PROVIDE AND INSTALL NEW ELECTRICAL RACEWAY SYSTEM AT THE BASE OF THE FIRST AND SECOND FLOOR PLASTER OFFICE WALLS (ADA MINIMUM HEIGHT OF 5' A.F.F.). NEST CONDUIT LEADING TO LIGHT SWITCHES INTO PLASTER WALLS. SEE ELECTRICAL DRAWINGS FOR MORE INFORMATION. PATCH & REPAIR ALL CUT PLASTER. REFER DTL. IIV6.02.
- 2. PROVIDE AND INSTALL NEW CUSTOM ALUMINUM SANGING GATE TO MATCH EXISTING ORIGINAL GATE - SEE DETAIL IIV6.01.
- 3. NEW LOCATION FOR (2) EXISTING VENDING MACHINES.
- 4. PATCH AND REPAIR PLASTER AT WINDOW WALL.
- 5. REPLACE DAMAGED HANSCOT CAP - SEE DETAIL IIV6.01.
- 6. PATCH AND REPAIR EXISTING PLASTER WALL WHERE PANELING WAS REMOVED - REFER TO NEW PLAN.
- 7. PROVIDE NEW RUBBER STAIR TREADS PER SPECIFICATIONS. REFER DTL. 3VA.01.
- 8. NEW LOWERS SEE MECHANICAL FOR SIZE.
- 9. REPAIR CORNER ROOM FURNITURE INCLUDING WOOD BENCHES AND JAY CHAIRS AND REINSTALL AS SHOWN ON PLAN. COORDINATE WITH OWNER REGARDING LOCATION OF STORED FURNITURE.

11
BURNET COUNTY COURTHOUSE
BURNET, TEXAS

Project:
Sheet #
Date: 03/18/2002
Drawn by: LCB
Issued for: BID


A1.02

REVEN THIRTEEN ARCHITECTS INC.
807 S. ROCK STREET, SUITE 100
DALLAS, TEXAS 75201
TEL: 512.689.1004 FAX: 512.689.1362


FIRST FLOOR PLAN

Sheet #
Project:
Date: 8/7/2002


NO.	REVISIONS

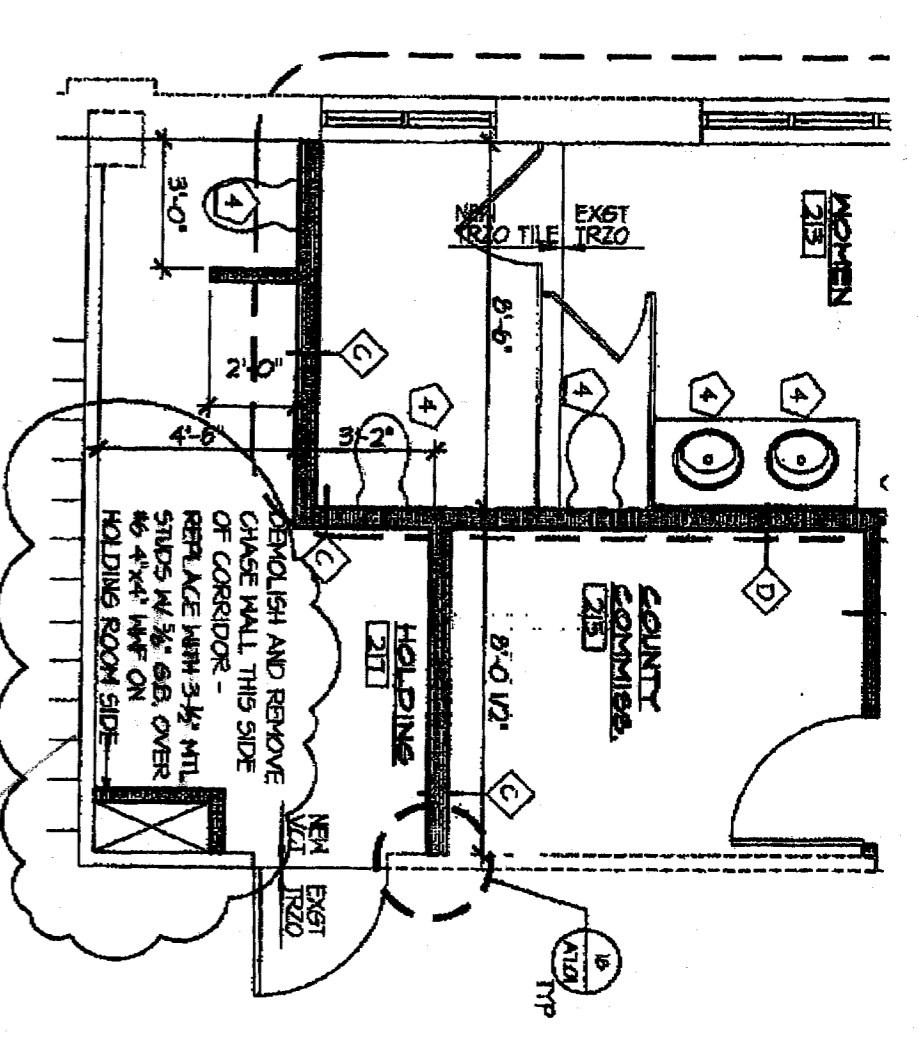

11 15
 SHEET TITLE: REVISED CHAIR IN ROOM 217
 PROJECT: BURNETT COUNTY COURTHOUSE RESTORATION AND RENOVATION
 REF: A1.03
 DATE: 8/7/2002
SKA.10
 REF: 08

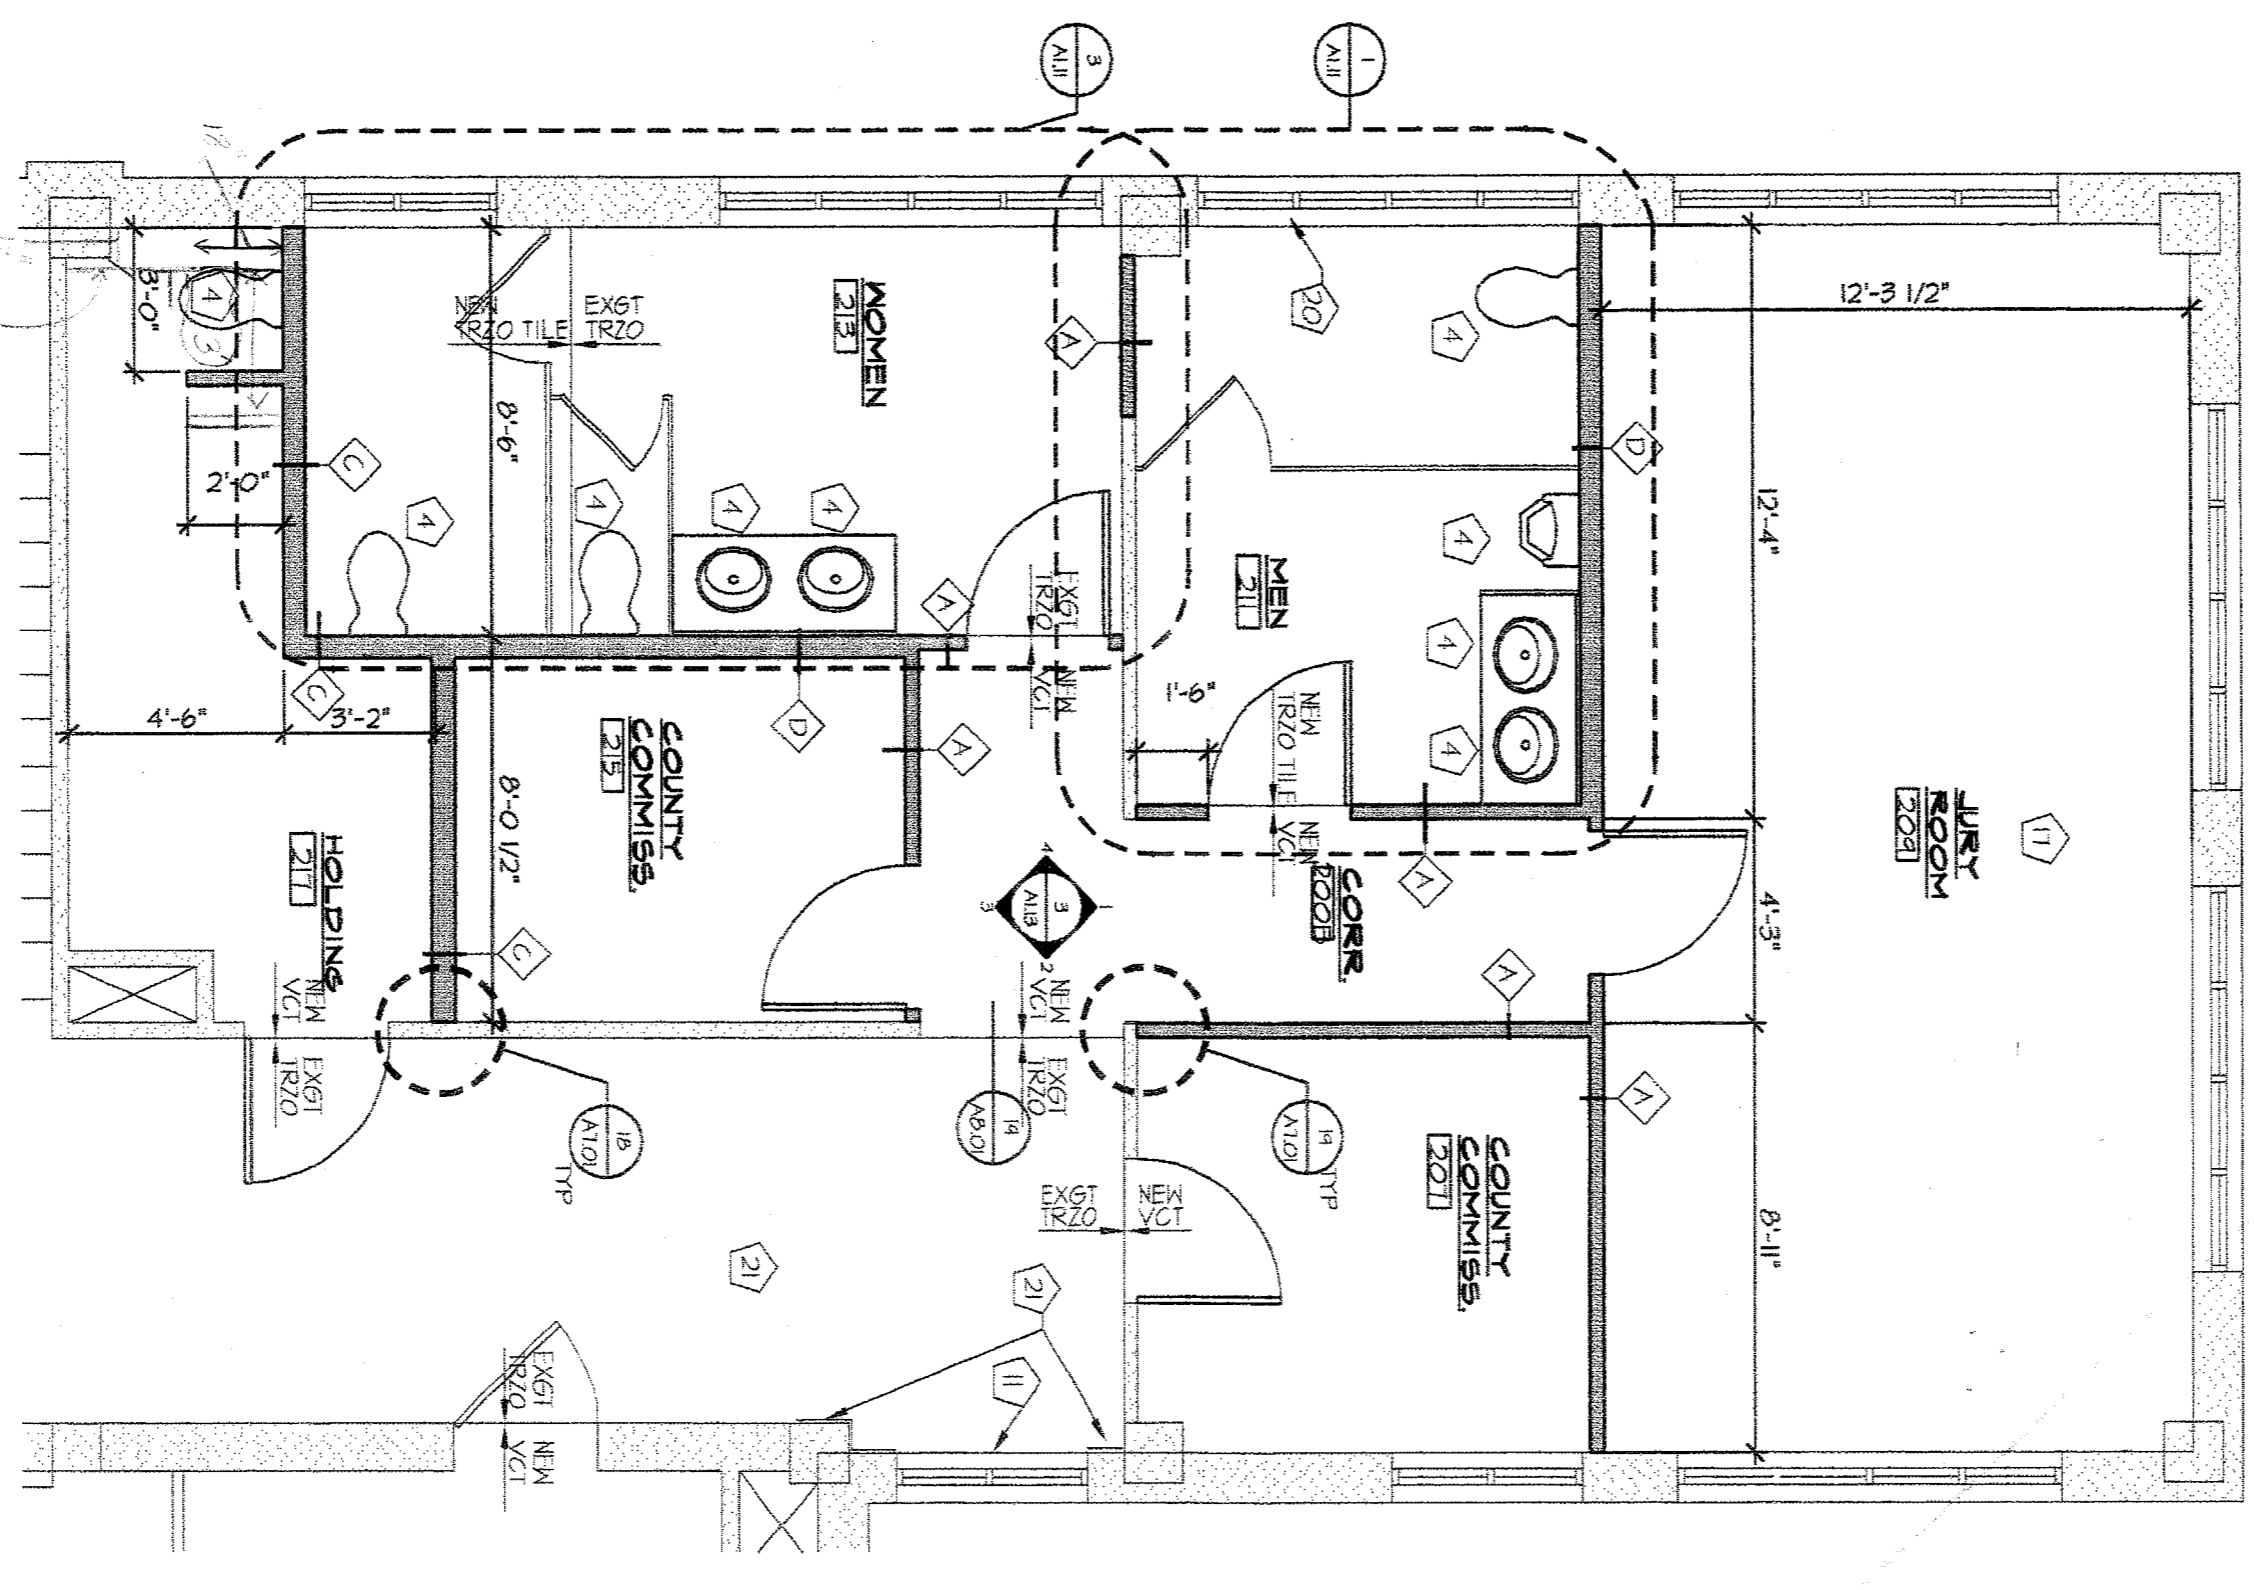


ENLARGED PLAN
 SCALE 1/4" = 1'-0"

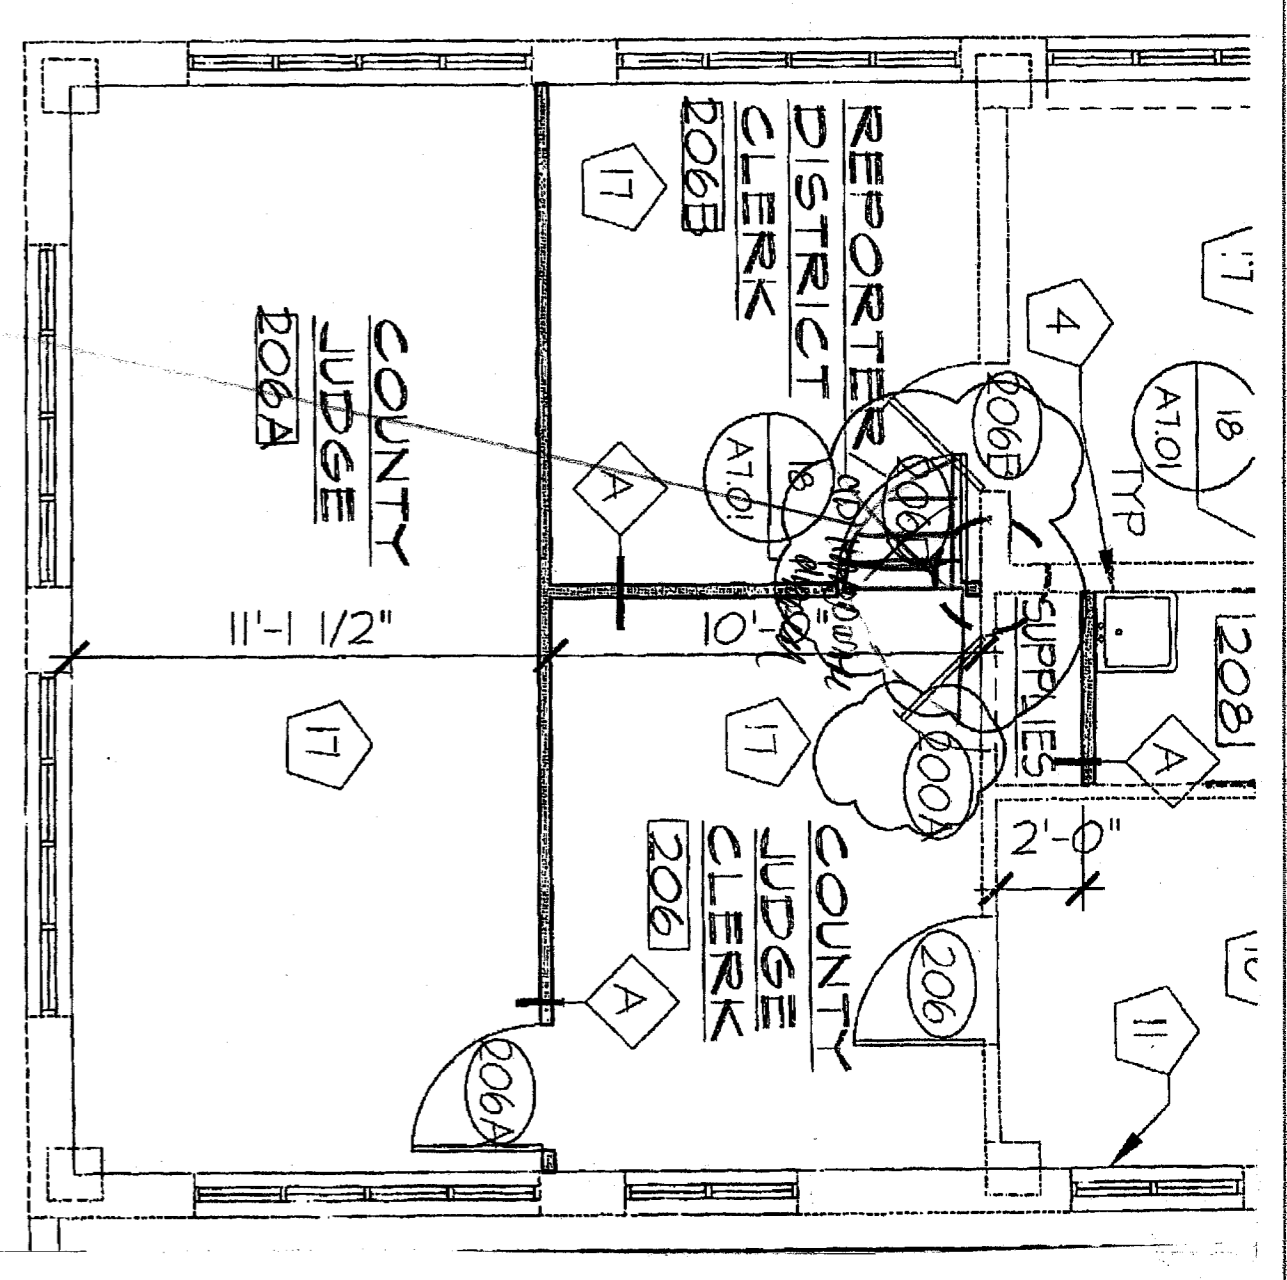


PARTIAL SECOND FLOOR PLAN
 SCALE 1/4" = 1'-0"

11 15
 SHEET TITLE: ADD DOOR 206D
 PROJECT: BURNETT COUNTY COURTHOUSE RESTORATION AND RENOVATION
 REF: A1.03
 DATE: 8/23/2002
SKA.14
 REF: 12

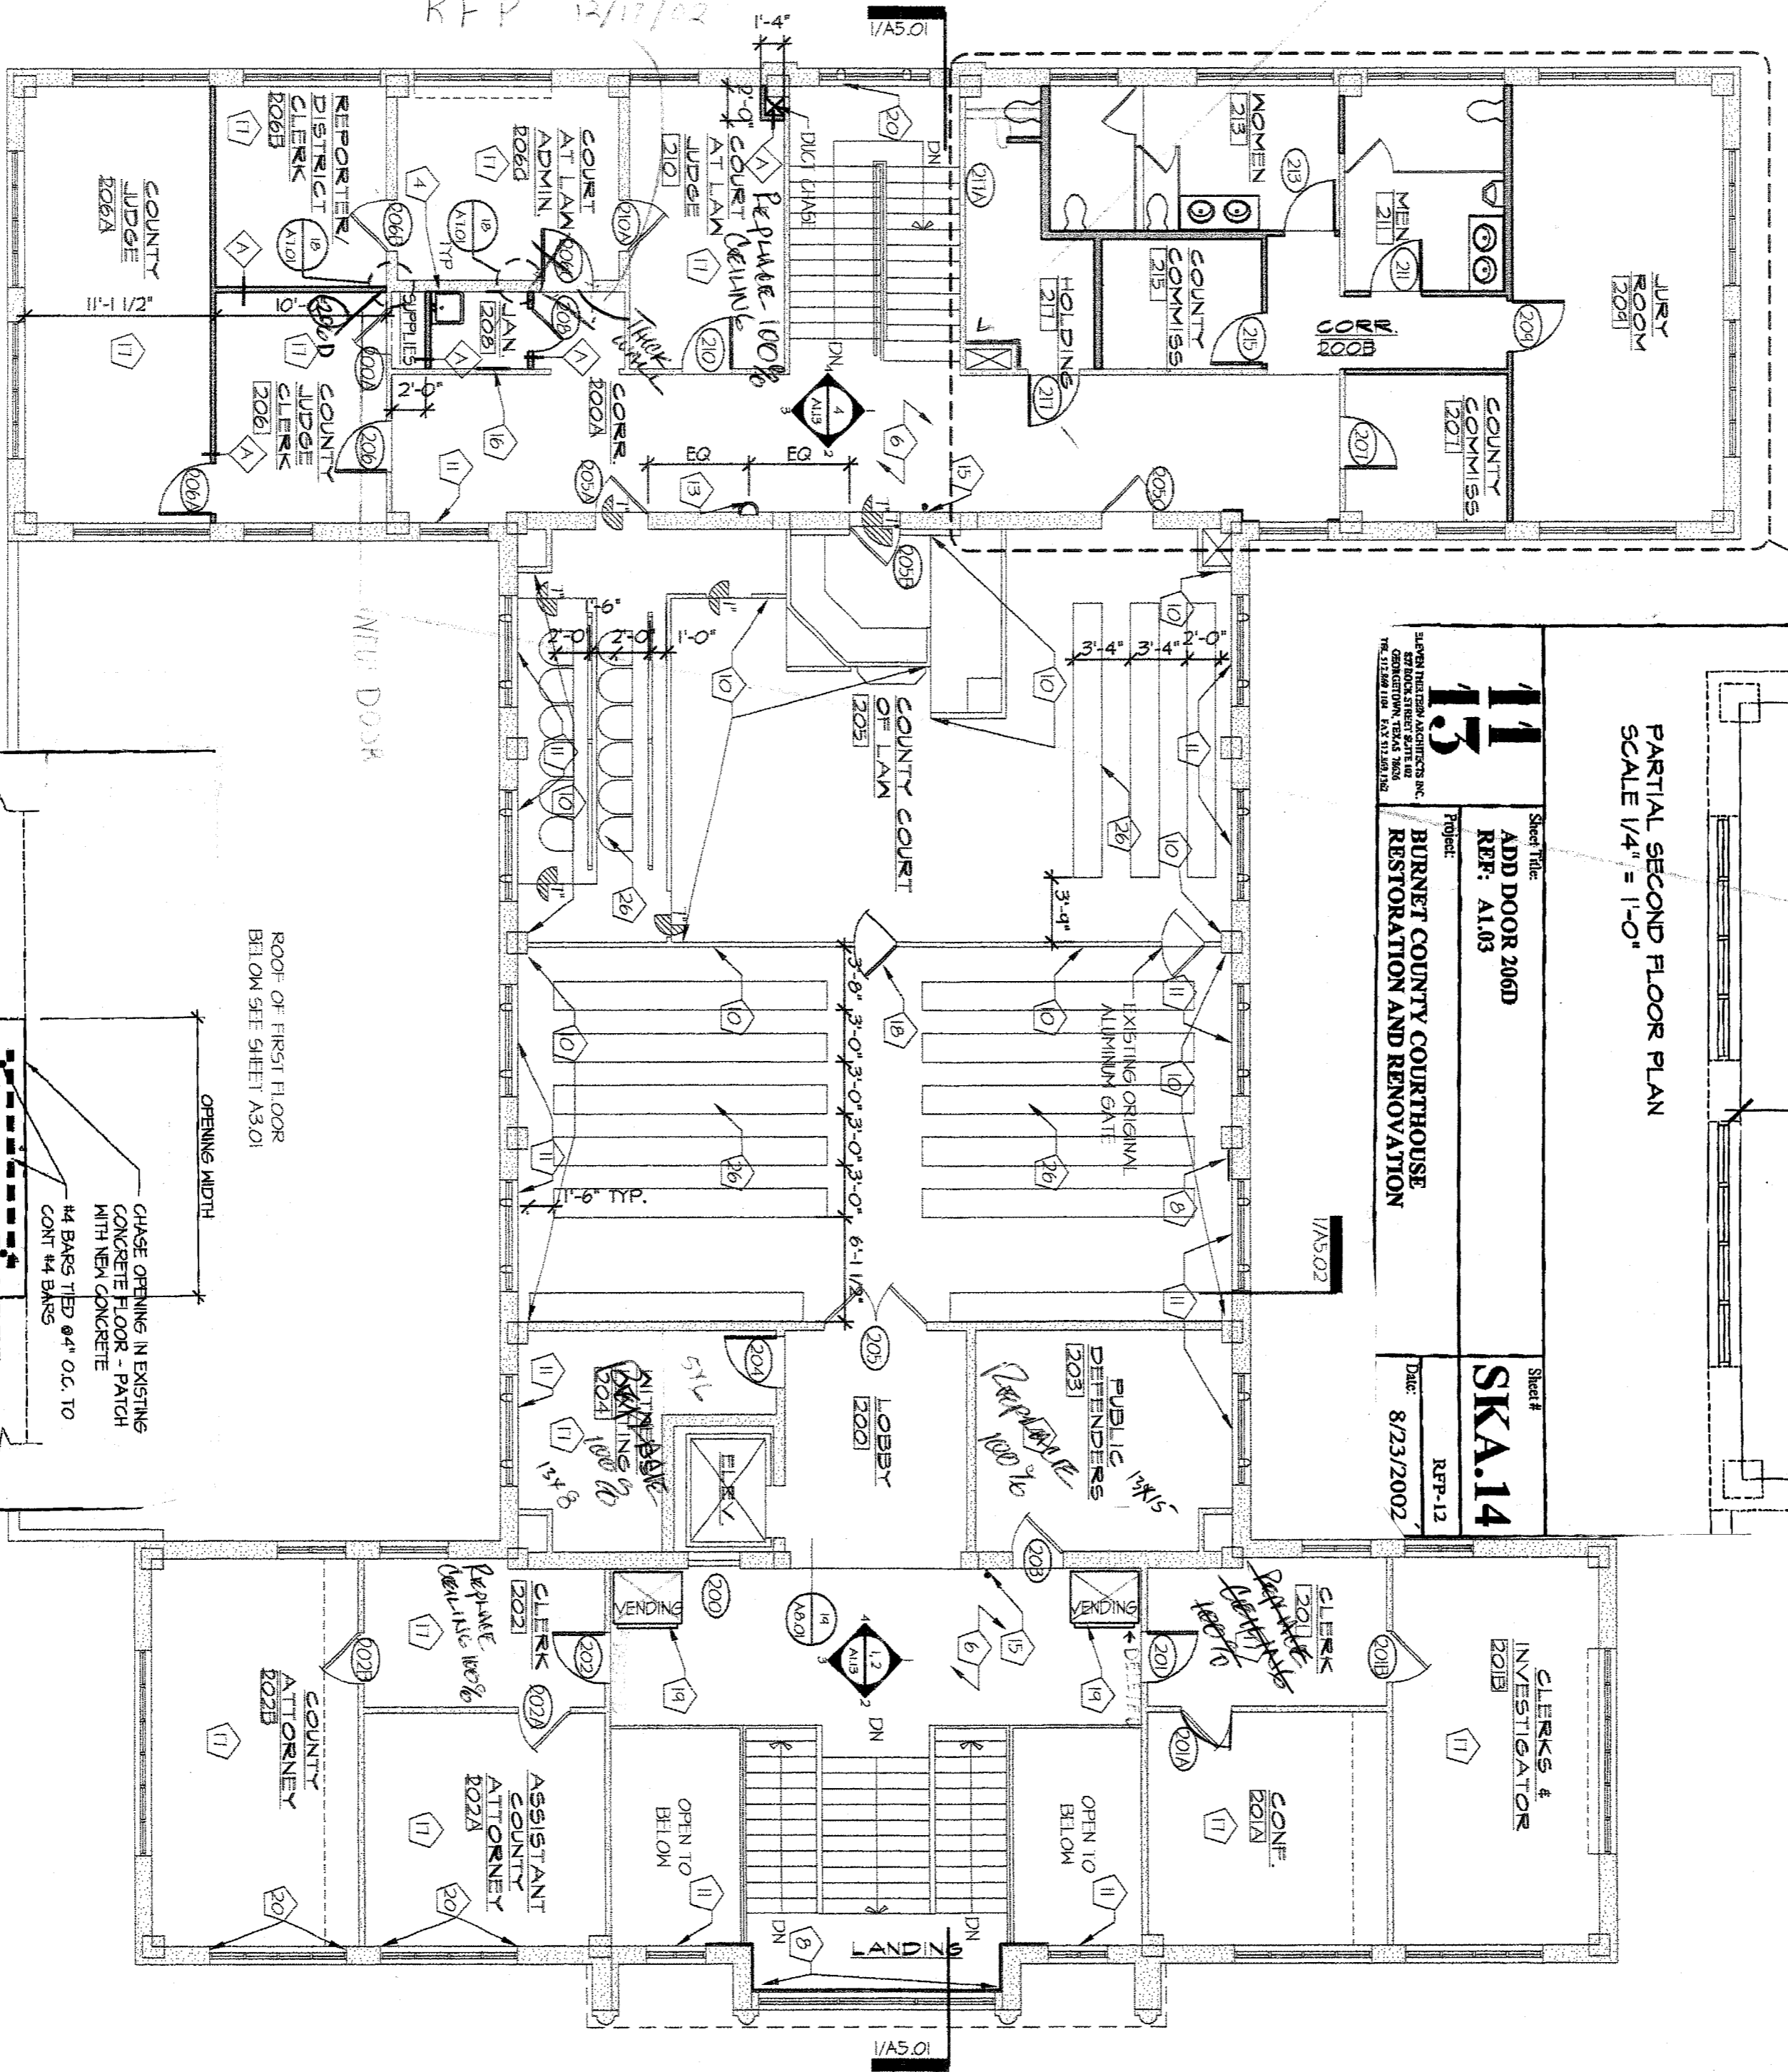


SECOND FLOOR PLAN
 SCALE 1/8" = 1'-0"

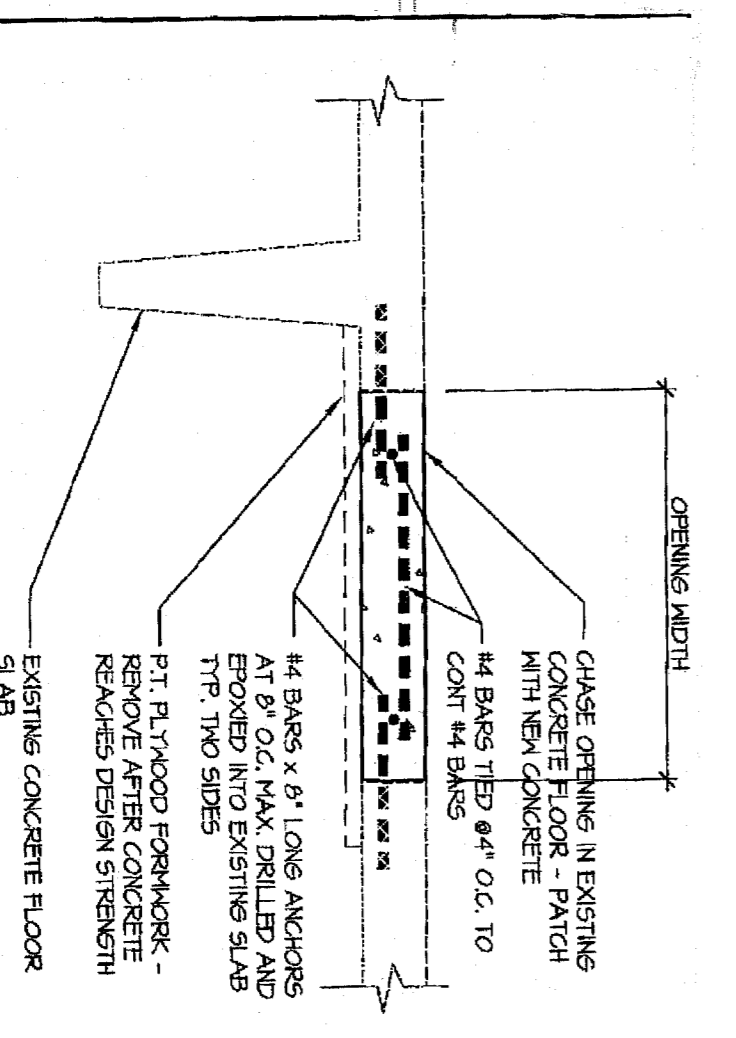

CONCRETE FLOOR SLAB REPAIR
 SCALE: 1-1/2" = 1'-0"
SKA.16
 REF: 03A000

11 15
 SHEET TITLE: CONCRETE FLOOR SLAB REPAIR
 PROJECT: BURNETT COUNTY COURTHOUSE RESTORATION AND RENOVATION
 REF: A1.03
 DATE: 9/18/2002
SKA.16
 REF: 03A000

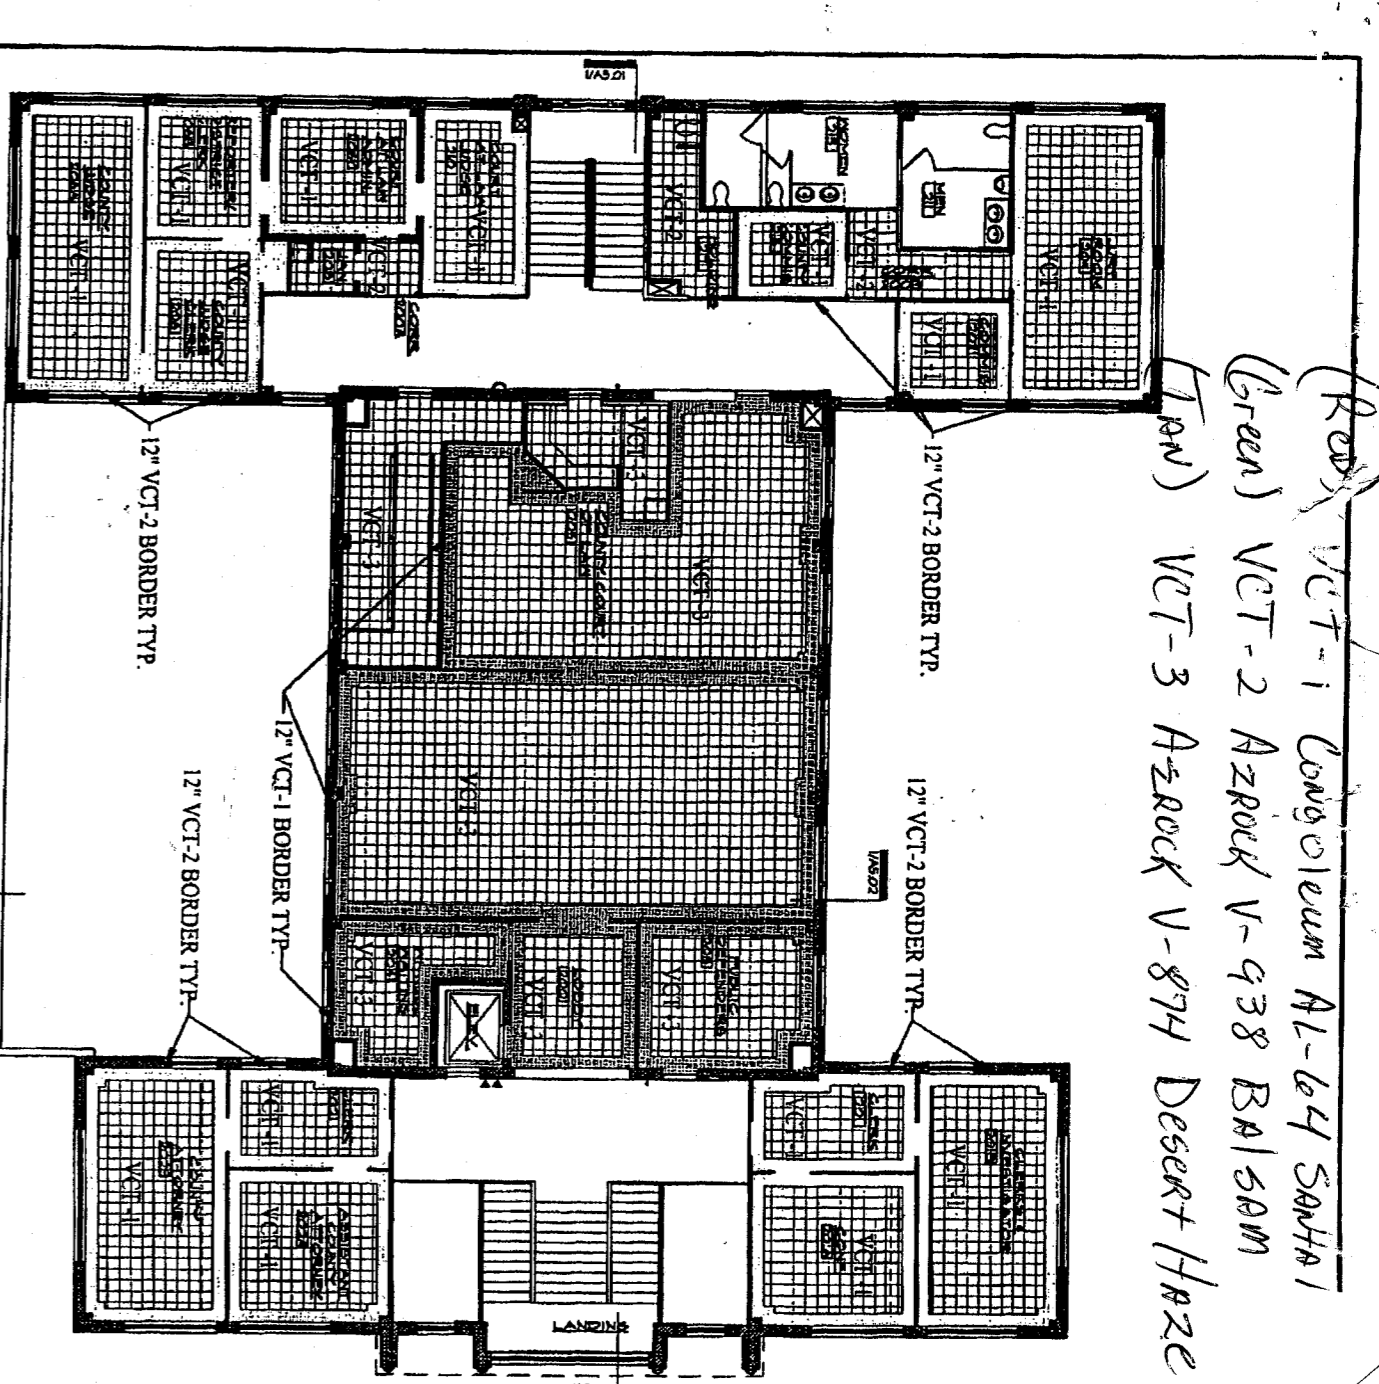

11 15
 SHEET TITLE: VCT FLOOR PATTERNS SECOND FLOOR
 PROJECT: BURNETT COUNTY COURTHOUSE RESTORATION AND RENOVATION
 REF: A1.03
 DATE: 9/18/2002
SKA.18
 REF: 03A000

COLOR LEGEND

- 1 NEW INTERIOR: Rubber Stair Treads - Stoler Industries, Konegert, Dark Green
- 2 NEW LIGHT S1 Rubber base - Korppa, #2333-Bisque
- 3 NEW PLUMBING VCT-1 - Azrock, V-934-Gamete, Congoleum AL-64 Sahara (Green)
- 4 NEW EXTERIOR VCT-2 - Azrock, V-938, Balsam - Green
- 5 IN THE LOBBY VCT-3 - Azrock, V-874, Desert Haze - Tan (Reference SKA.17 and SKA.18 for VCT patterns)
- 6 CLEAN AND HEETS THE ALUMINUM CARP
- 7 POLISH AND SEAL MARBLE MANSOET. INSTALL NEW GROUT WHERE MISSING AT GRIND AND POLISH TERRAZZO ON THE STAIRS AT THIS AREA
- 8 PATCH AND REPAIR DAMAGED PLASTER THIS AREA OF WALL WHERE ELECTRICAL EQUIPMENT WAS REMOVED - SEE INTERIOR ELEVATIONS AND ELECTRICAL DRAWINGS
- 9 NEW OPENING IN WALL WHERE ORIGINAL HSS WINDOWS WERE INFILLED. - SEE DETAIL 18A.01
- 10 STRIP VARNISH FROM HULLORK. PREPARE FOR NEW CLEAR COAT - REFER SPECIFICATIONS
- 11 CLEAN AND POLISH MARBLE WINDOW SILLINGS
- 12 NEW HULLORK AND COUNTER - SEE DETAILS
- 13 INSTALL ORIGINAL CERAMIC WATER FOUNTAIN SUPPLIED BY OWNER. IN ORIGINAL LOCATION. SEE PLUMBING DRAWINGS FOR MORE INFORMATION
- 14 REINSTALL EXISTING WALL WITH LIKE MATERIALS, TOOTH AND MATCH MASONRY CORERS AT MASONRY WALLS. PAINT TO MATCH EXISTING ADJACENT WALLS
- 15 REINSTALL EXISTING FIRE EXTINGUISHER ON NEW BRACKET AS SPECIFIED - SEE 4A.01 FOR DETAIL
- 16 NEW HOOK STRIP MOUNTED AT 54" A.F.F. IN JANITORS CLOSET SEE SPEC5.
- 17 PROVIDE AND INSTALL NEW ELECTRICAL RACKWAY SYSTEM AT THE BASE OF THE FIRST AND SECOND FLOOR PLASTER DITCH WALLS (ADA MINIMUM HEIGHT OF 15 FT.) (SEE DETAIL 18A.01) PROVIDE LIGHT SWITCHES INTO PLASTER WALLS. SEE PLASTER. REFER DTL. 18A.02
- 18 PROVIDE AND INSTALL NEW DESIGN ALUMINUM SWINGING GATE TO MATCH EXISTING ORIGINAL GATE - SEE DETAIL 18A.01
- 19 NEW LOCATION FOR (2) EXISTING VENDING MACHINES
- 20 PATCH AND REPAIR PLASTER AT WINDOW WALL
- 21 REPLACE DAMAGED MANSOET CAP - SEE DETAIL 18A.01
- 22 REFACE DAMAGED 6 STUD WALL - SEE DETAIL 18A.01
- 23 PATCH AND REPAIR EXISTING PLASTER WALL WHERE PANELING WAS REMOVED - PREP FOR NEW PAINT
- 24 PROVIDE NEW RUBBER STAIR TREADS PER SPECIFICATIONS. REFER DTL. 3A.01
- 25 NEW LOWERS SEE MECHANICAL FOR SIZE
- 26 REFINISH COURTROOM FURNITURE INCLUDING WOOD BENCHES AND JURY CHAIRS AND REINSTALL AS SHOWN ON PLAN. COORDINATE WITH OWNER REGARDING LOCATION OF STORAGE FURNITURE

KEYNOTES

APPLY TO SHEETS A1.01-A1.03 ONLY


SECOND FLOOR PLAN
 PROJECT: BURNETT COUNTY COURTHOUSE
 BURNETT, TEXAS

11 15
 ELEVEN THIRTEEN ARCHITECTS INC.
 807 S. ROCK SUITE 102
 GEORGETOWN, TEXAS 78626
 TEL: 512.869.1104 FAX: 512.899.1862

A1.03
 SHEET
 DATE: 03/18/2002
 DRAWN BY: LCB
 CHECKED BY: BID


REVISIONS

(Red) VCT-1 Congoleum AL-64 Sahara
 (Green) VCT-2 Azrock V-938 BAI 50M
 (Tan) VCT-3 Azrock V-874 Desert Haze

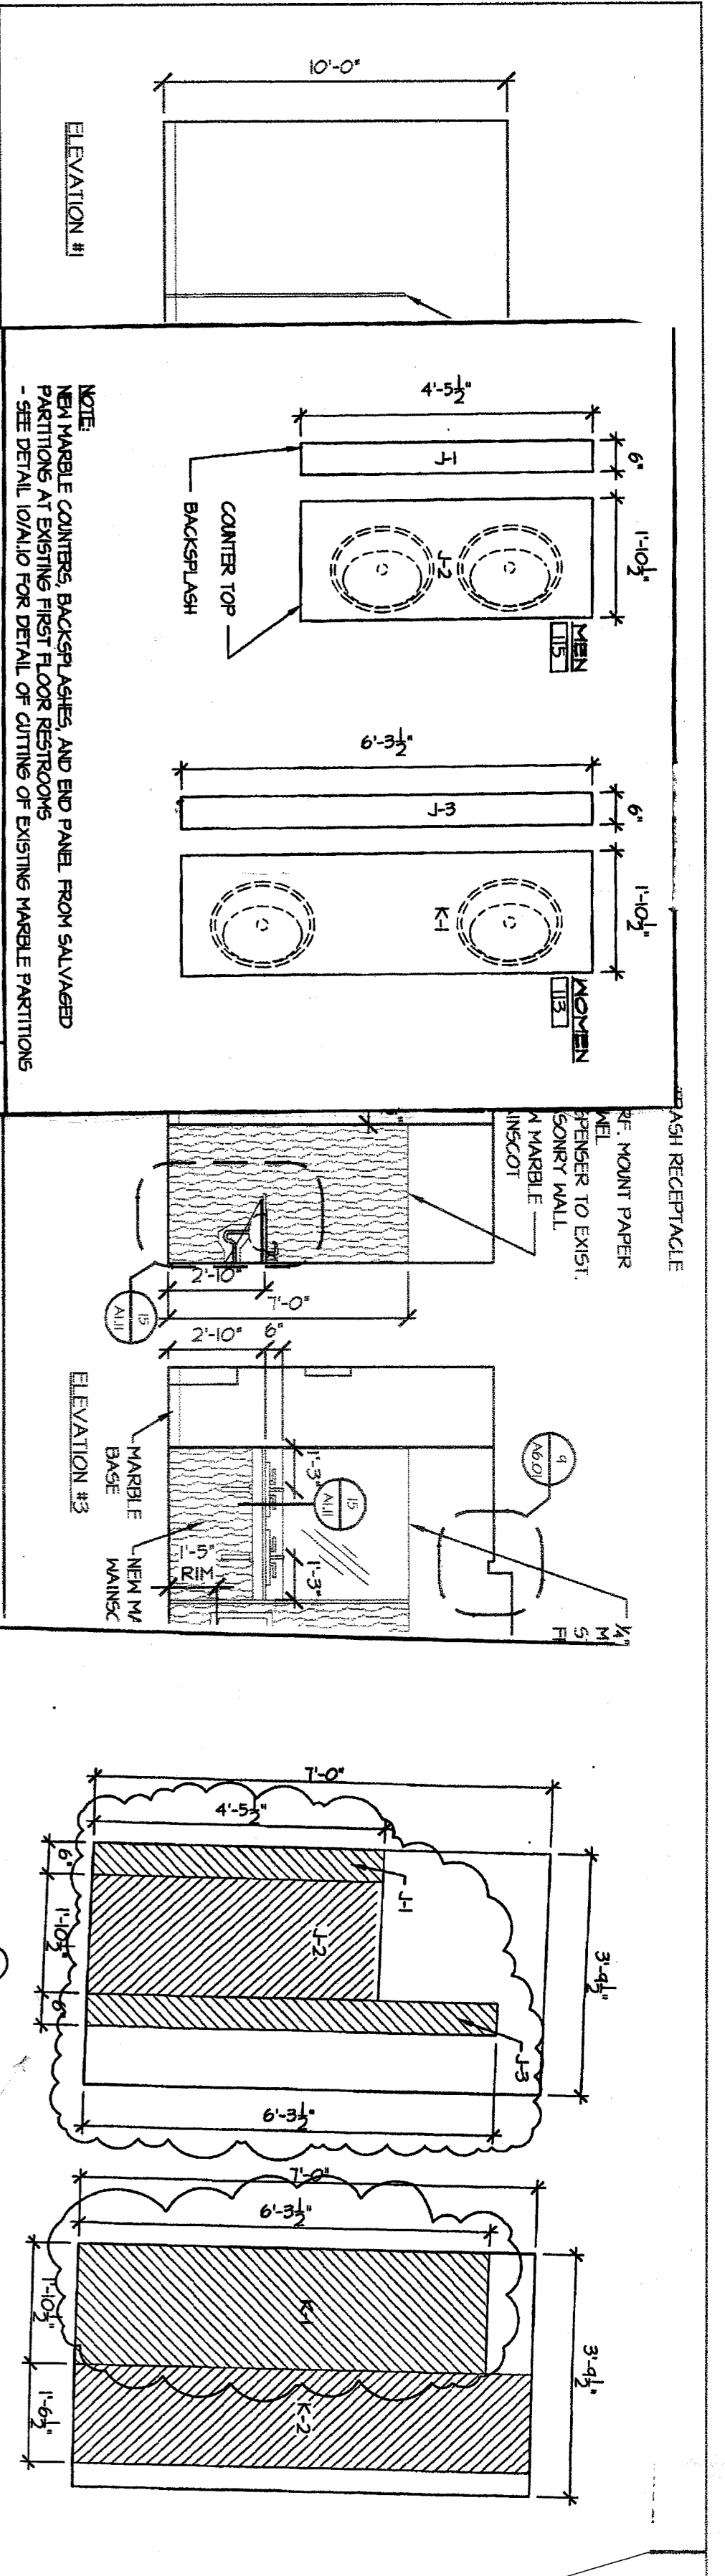


FIRST FLOOR NEW MARBLE COUNTERS

SCALE: 1/4" = 1'-0"
 06A1010

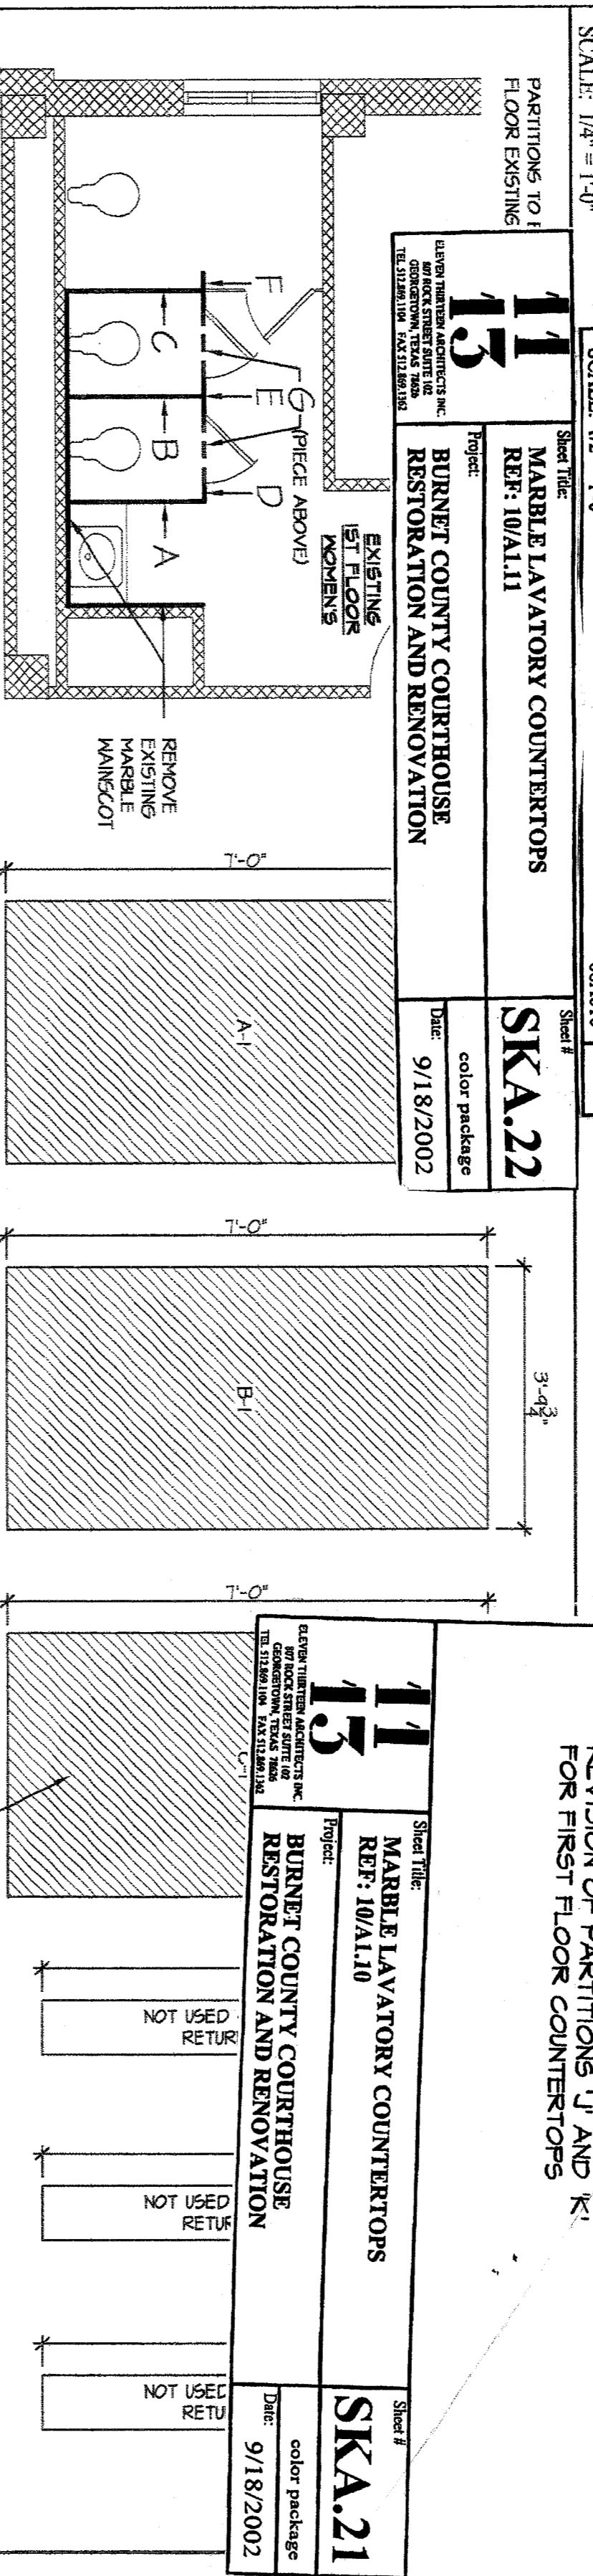


FIRST FLOOR MARBLE LAVATORY COUNTERTOPS

SCALE: 1/4" = 1'-0"
 06A1011

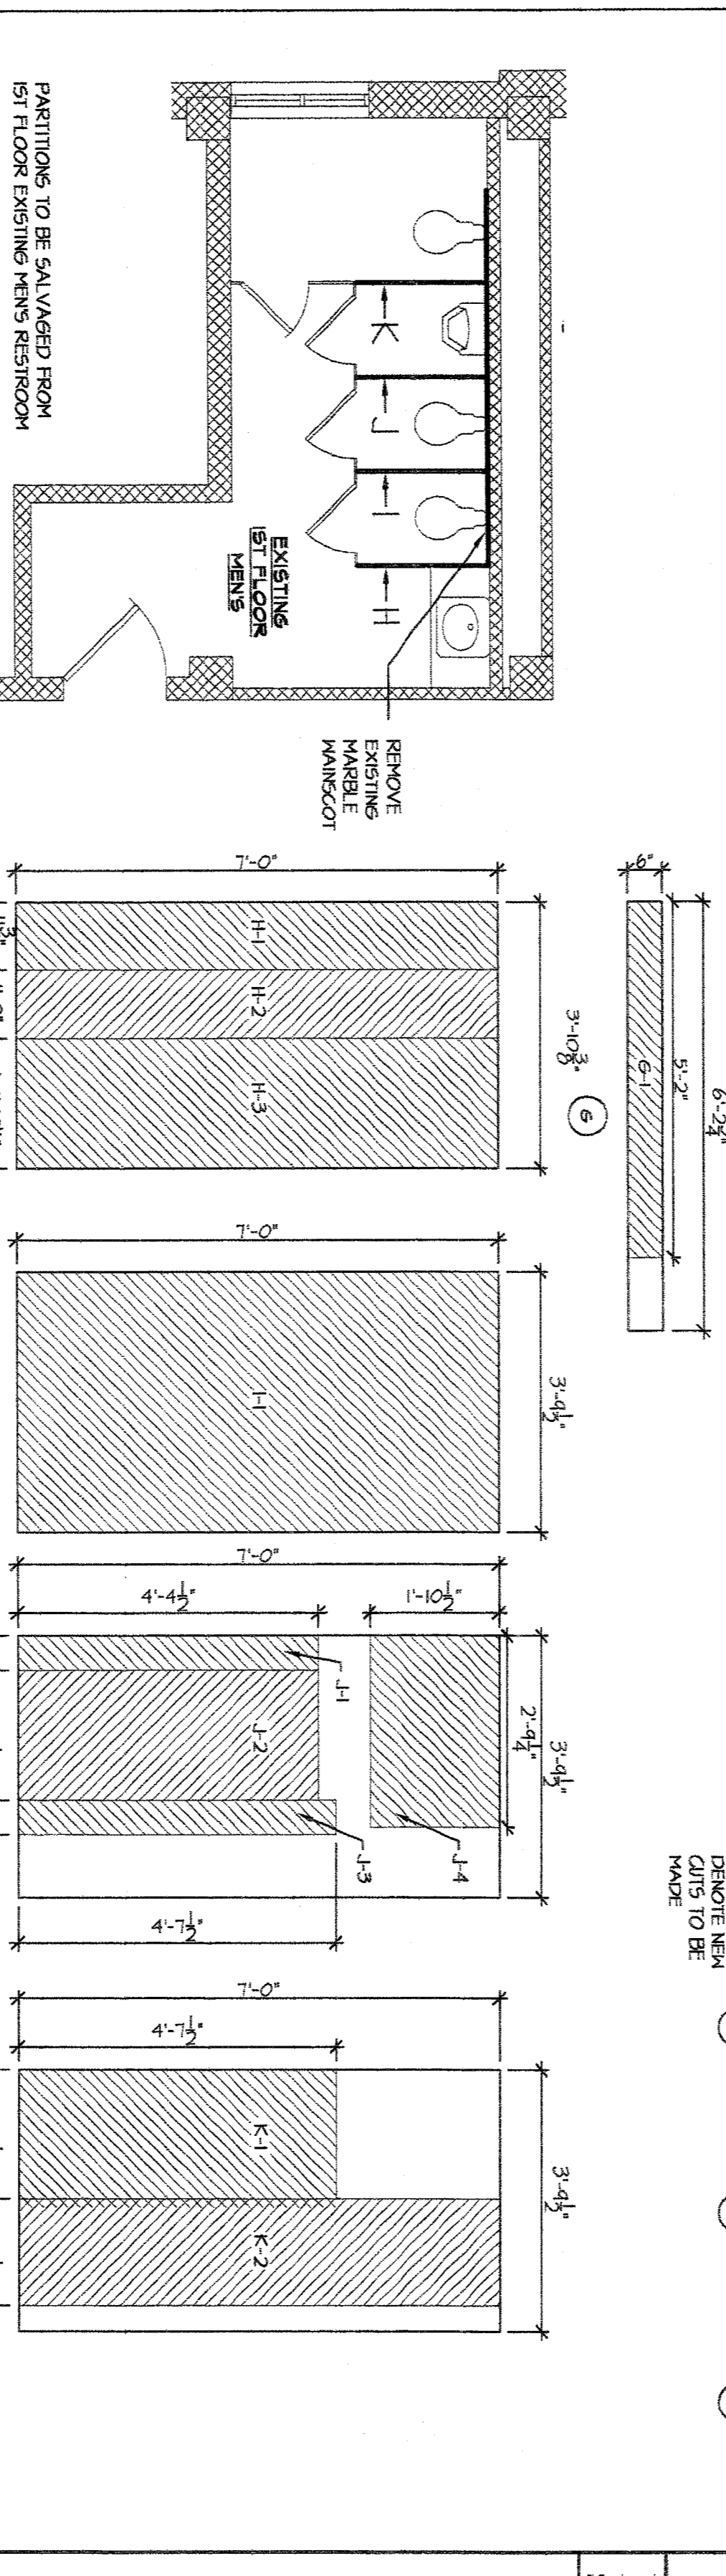


FIRST FLOOR MEN'S RESTROOM

SCALE: 1/2" = 1'-0"
 06A1015

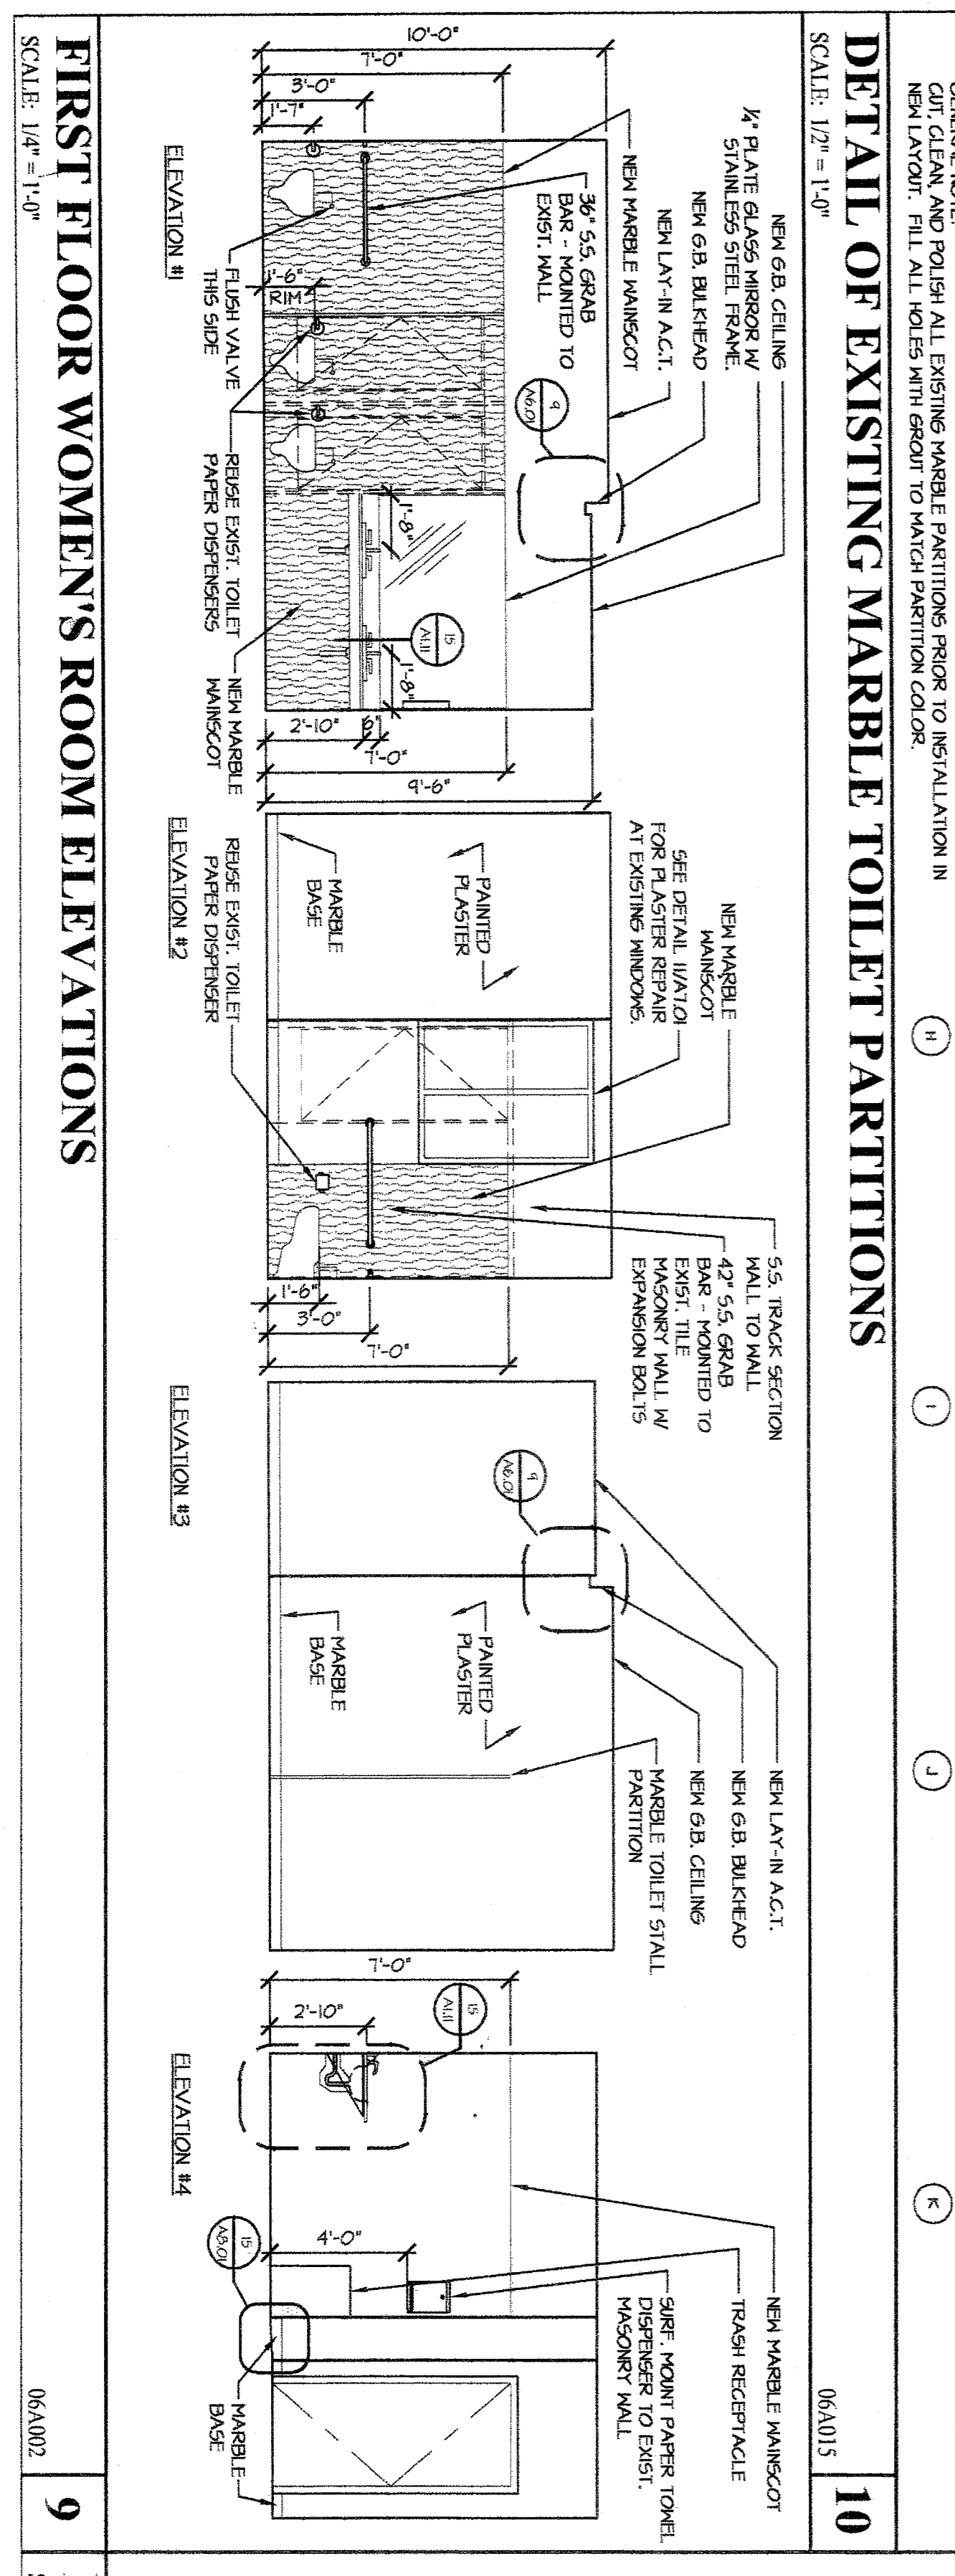


FIRST FLOOR WOMEN'S ROOM ELEVATIONS

SCALE: 1/4" = 1'-0"
 06A1002

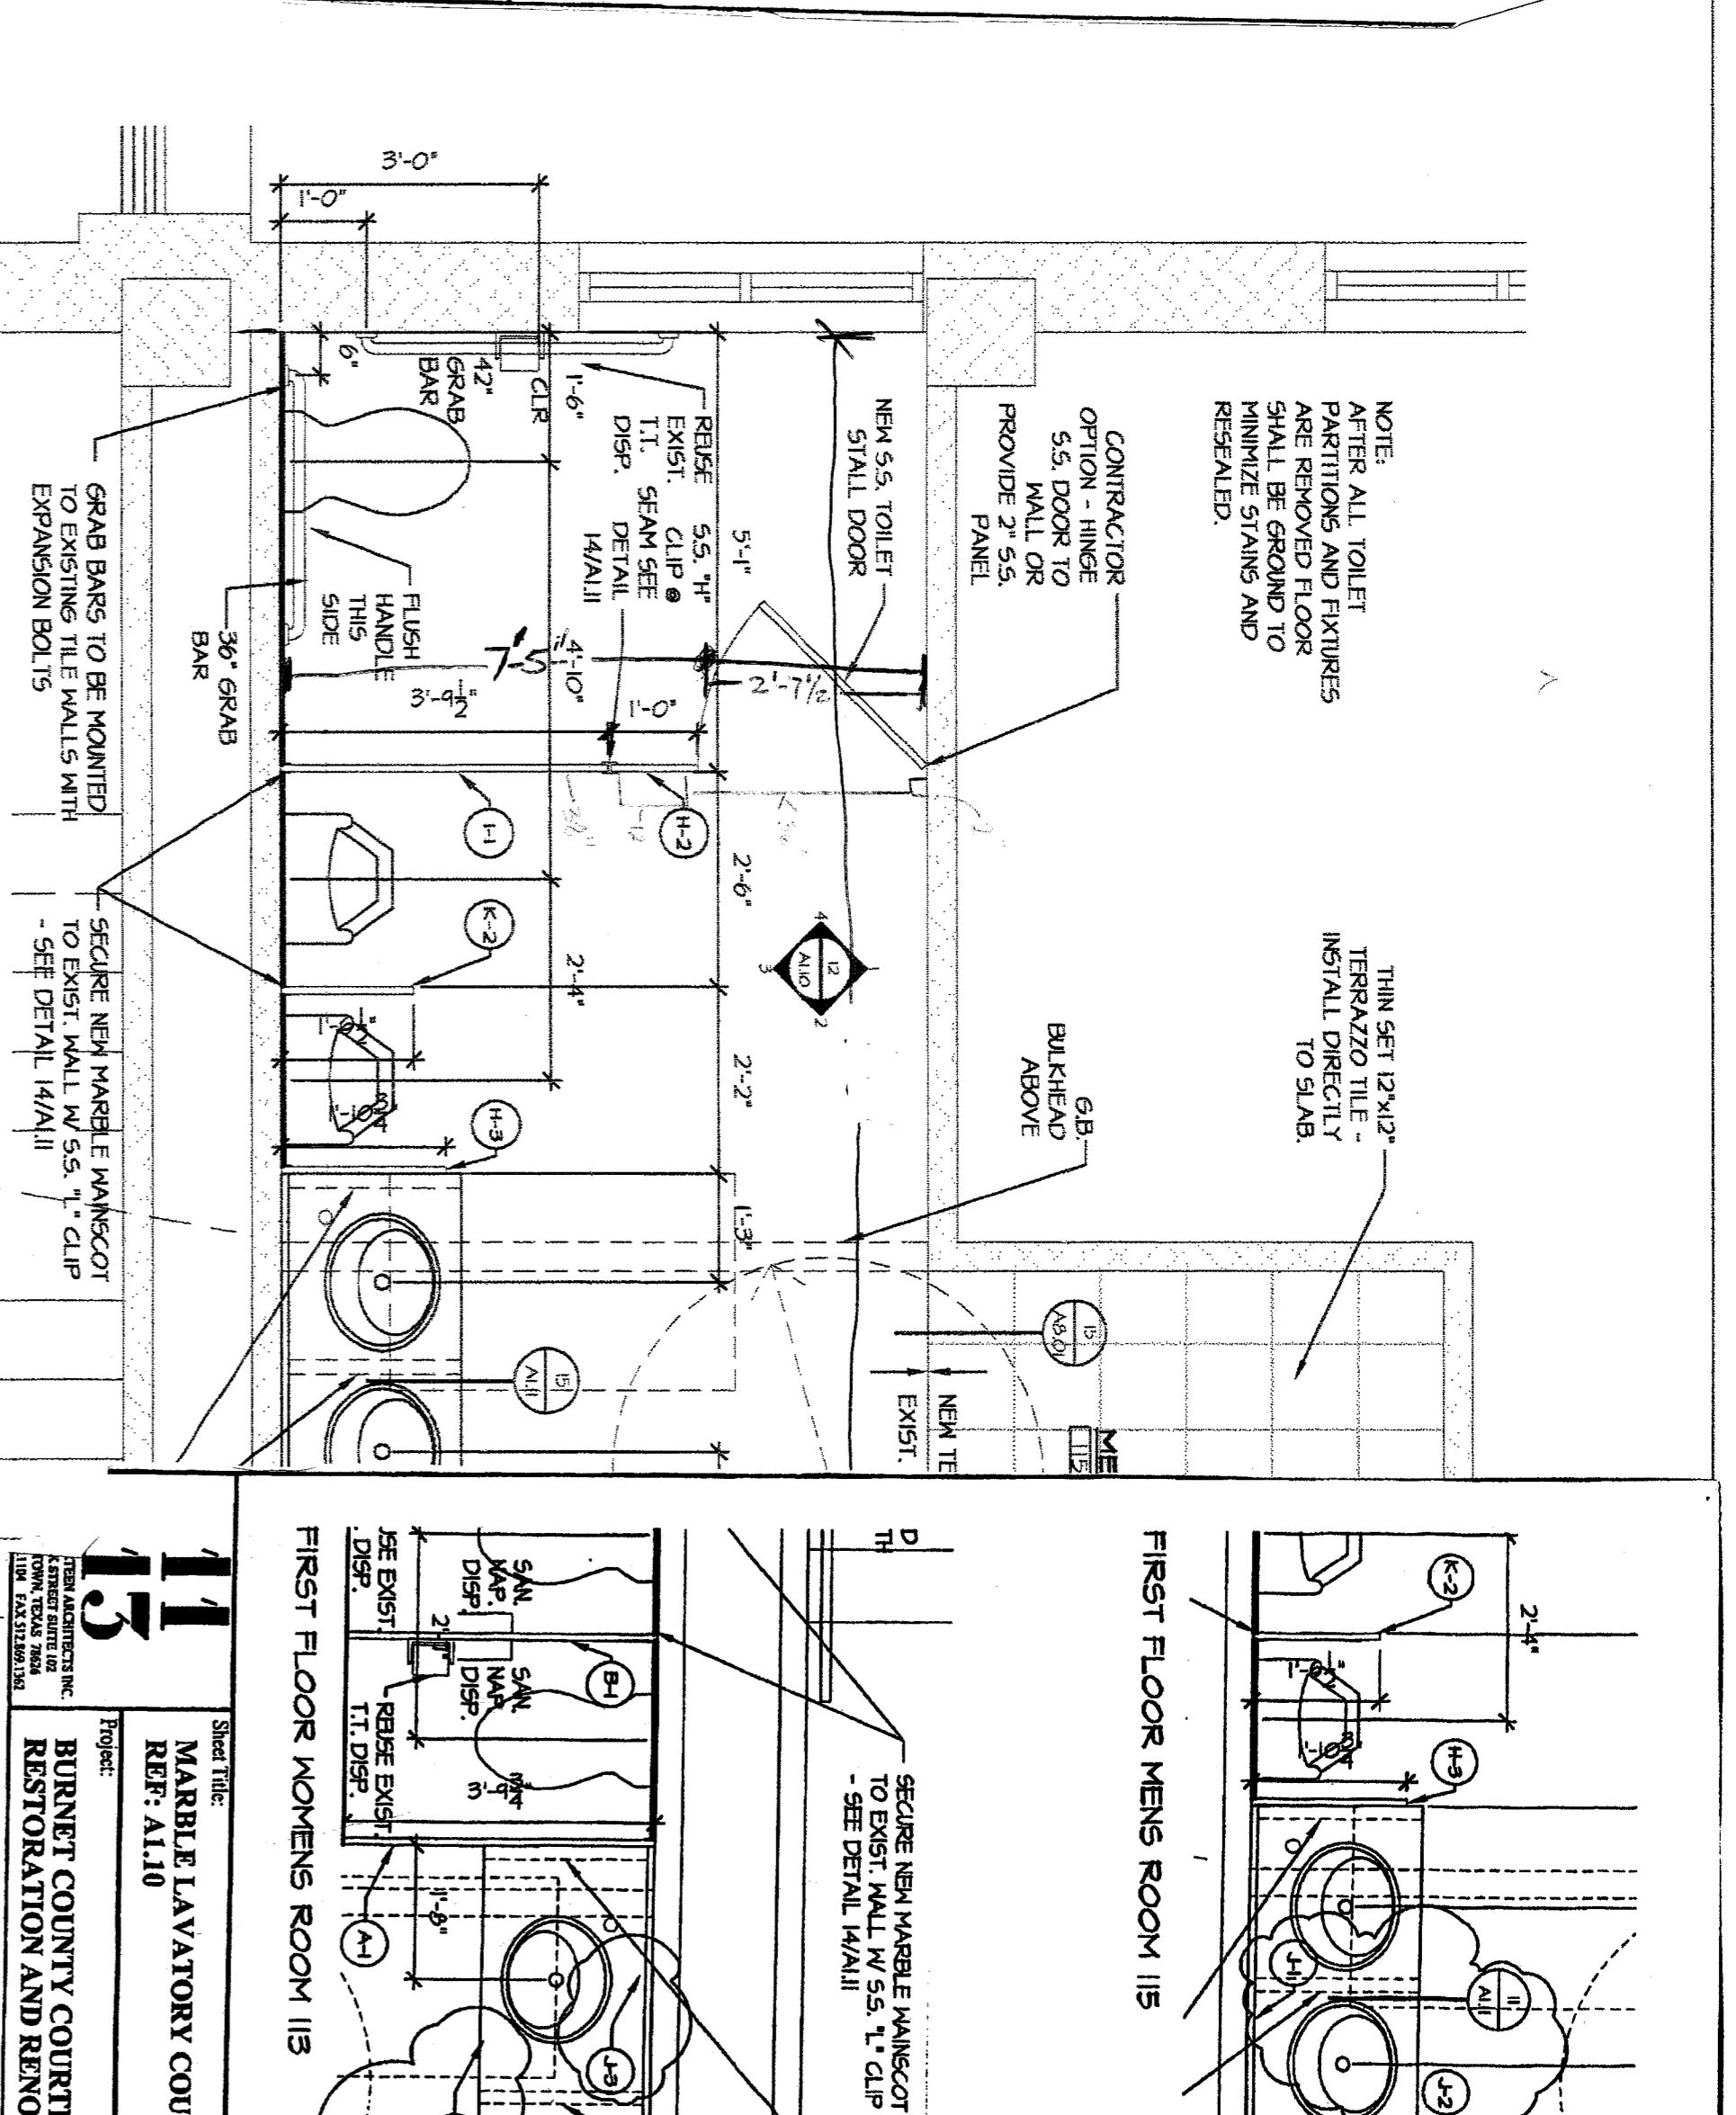


FIRST FLOOR MEN'S RESTROOM

SCALE: 1/2" = 1'-0"
 A1-10

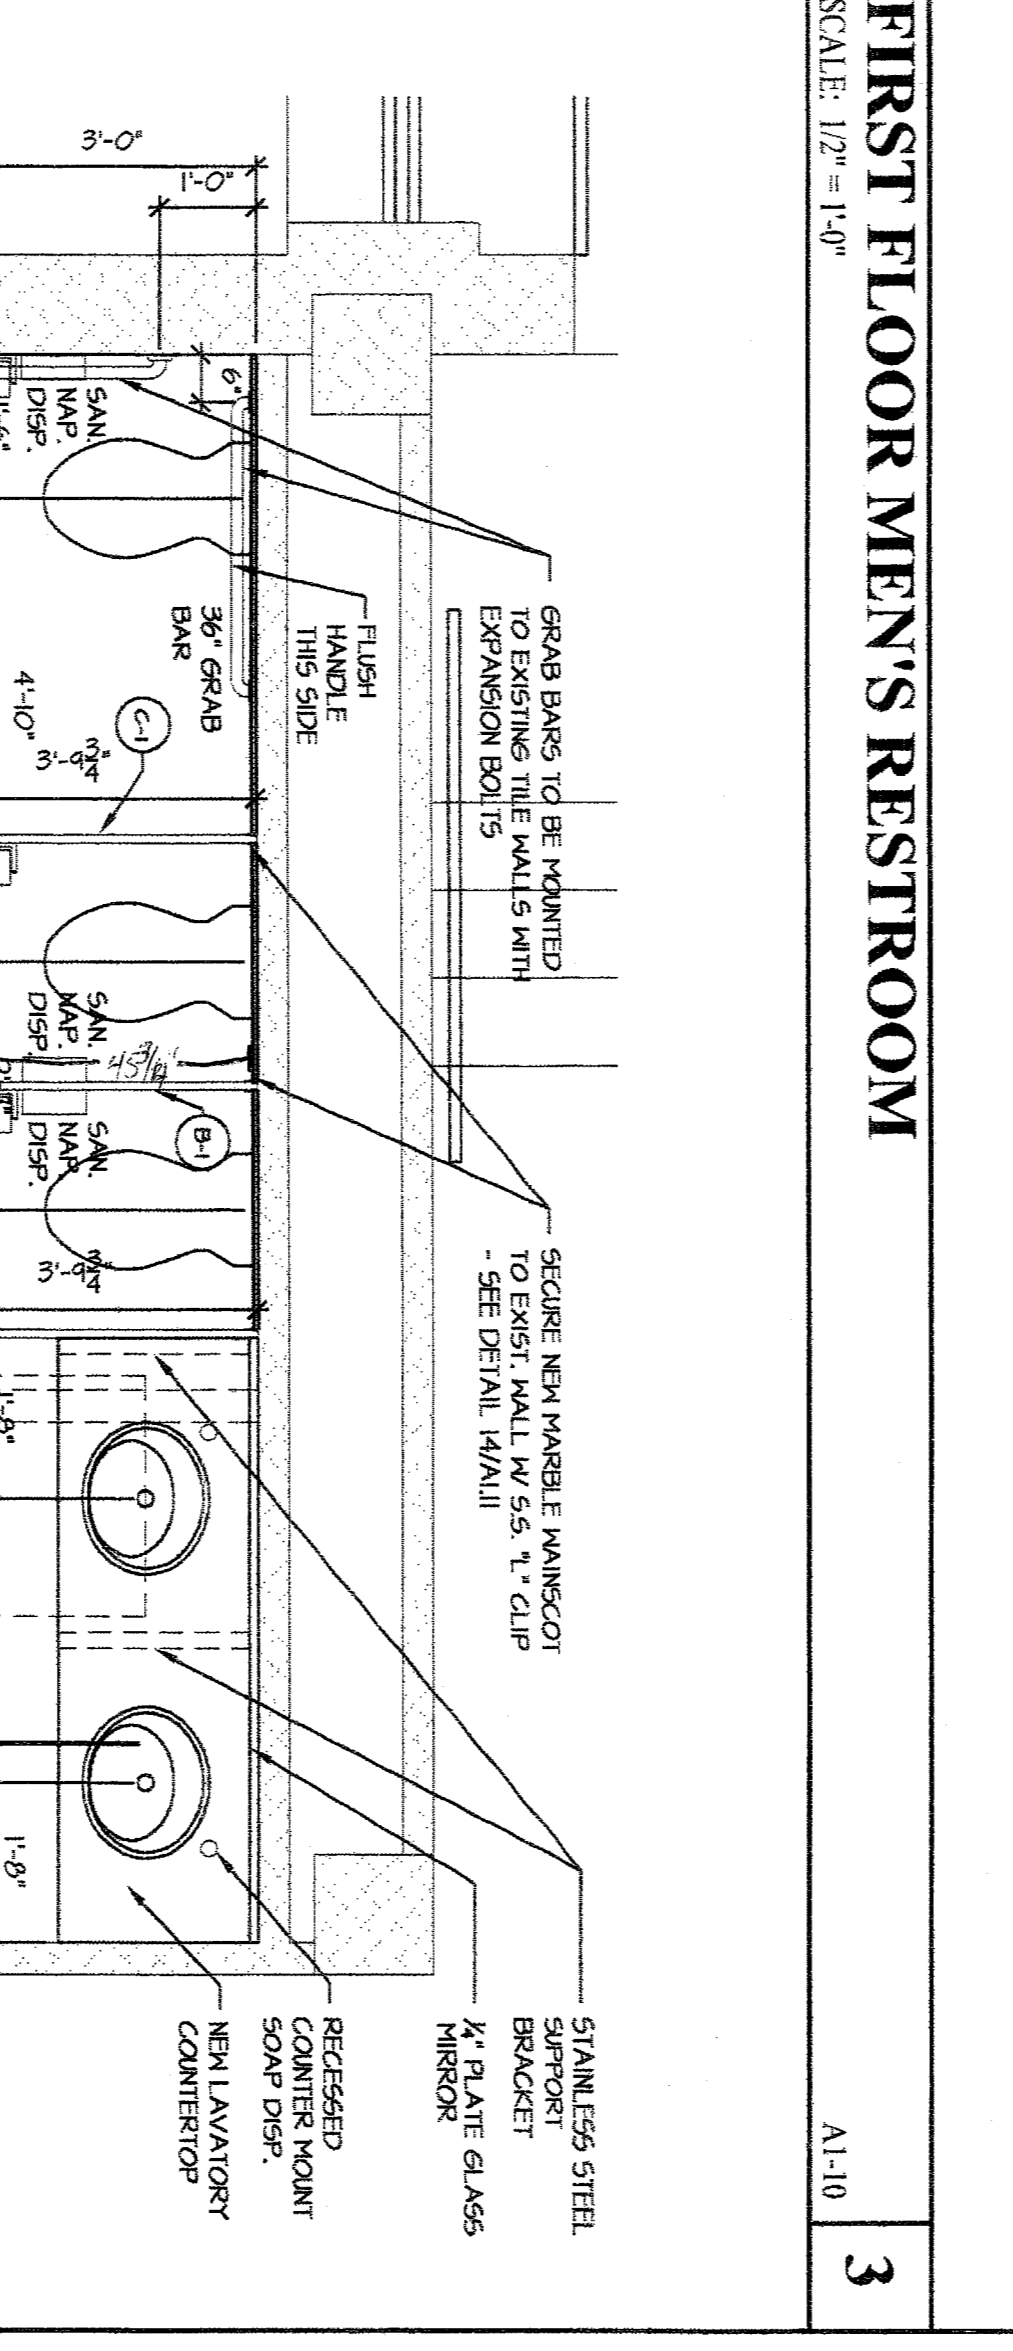


FIRST FLOOR WOMEN'S RESTROOM

SCALE: 1/2" = 1'-0"
 A1-10

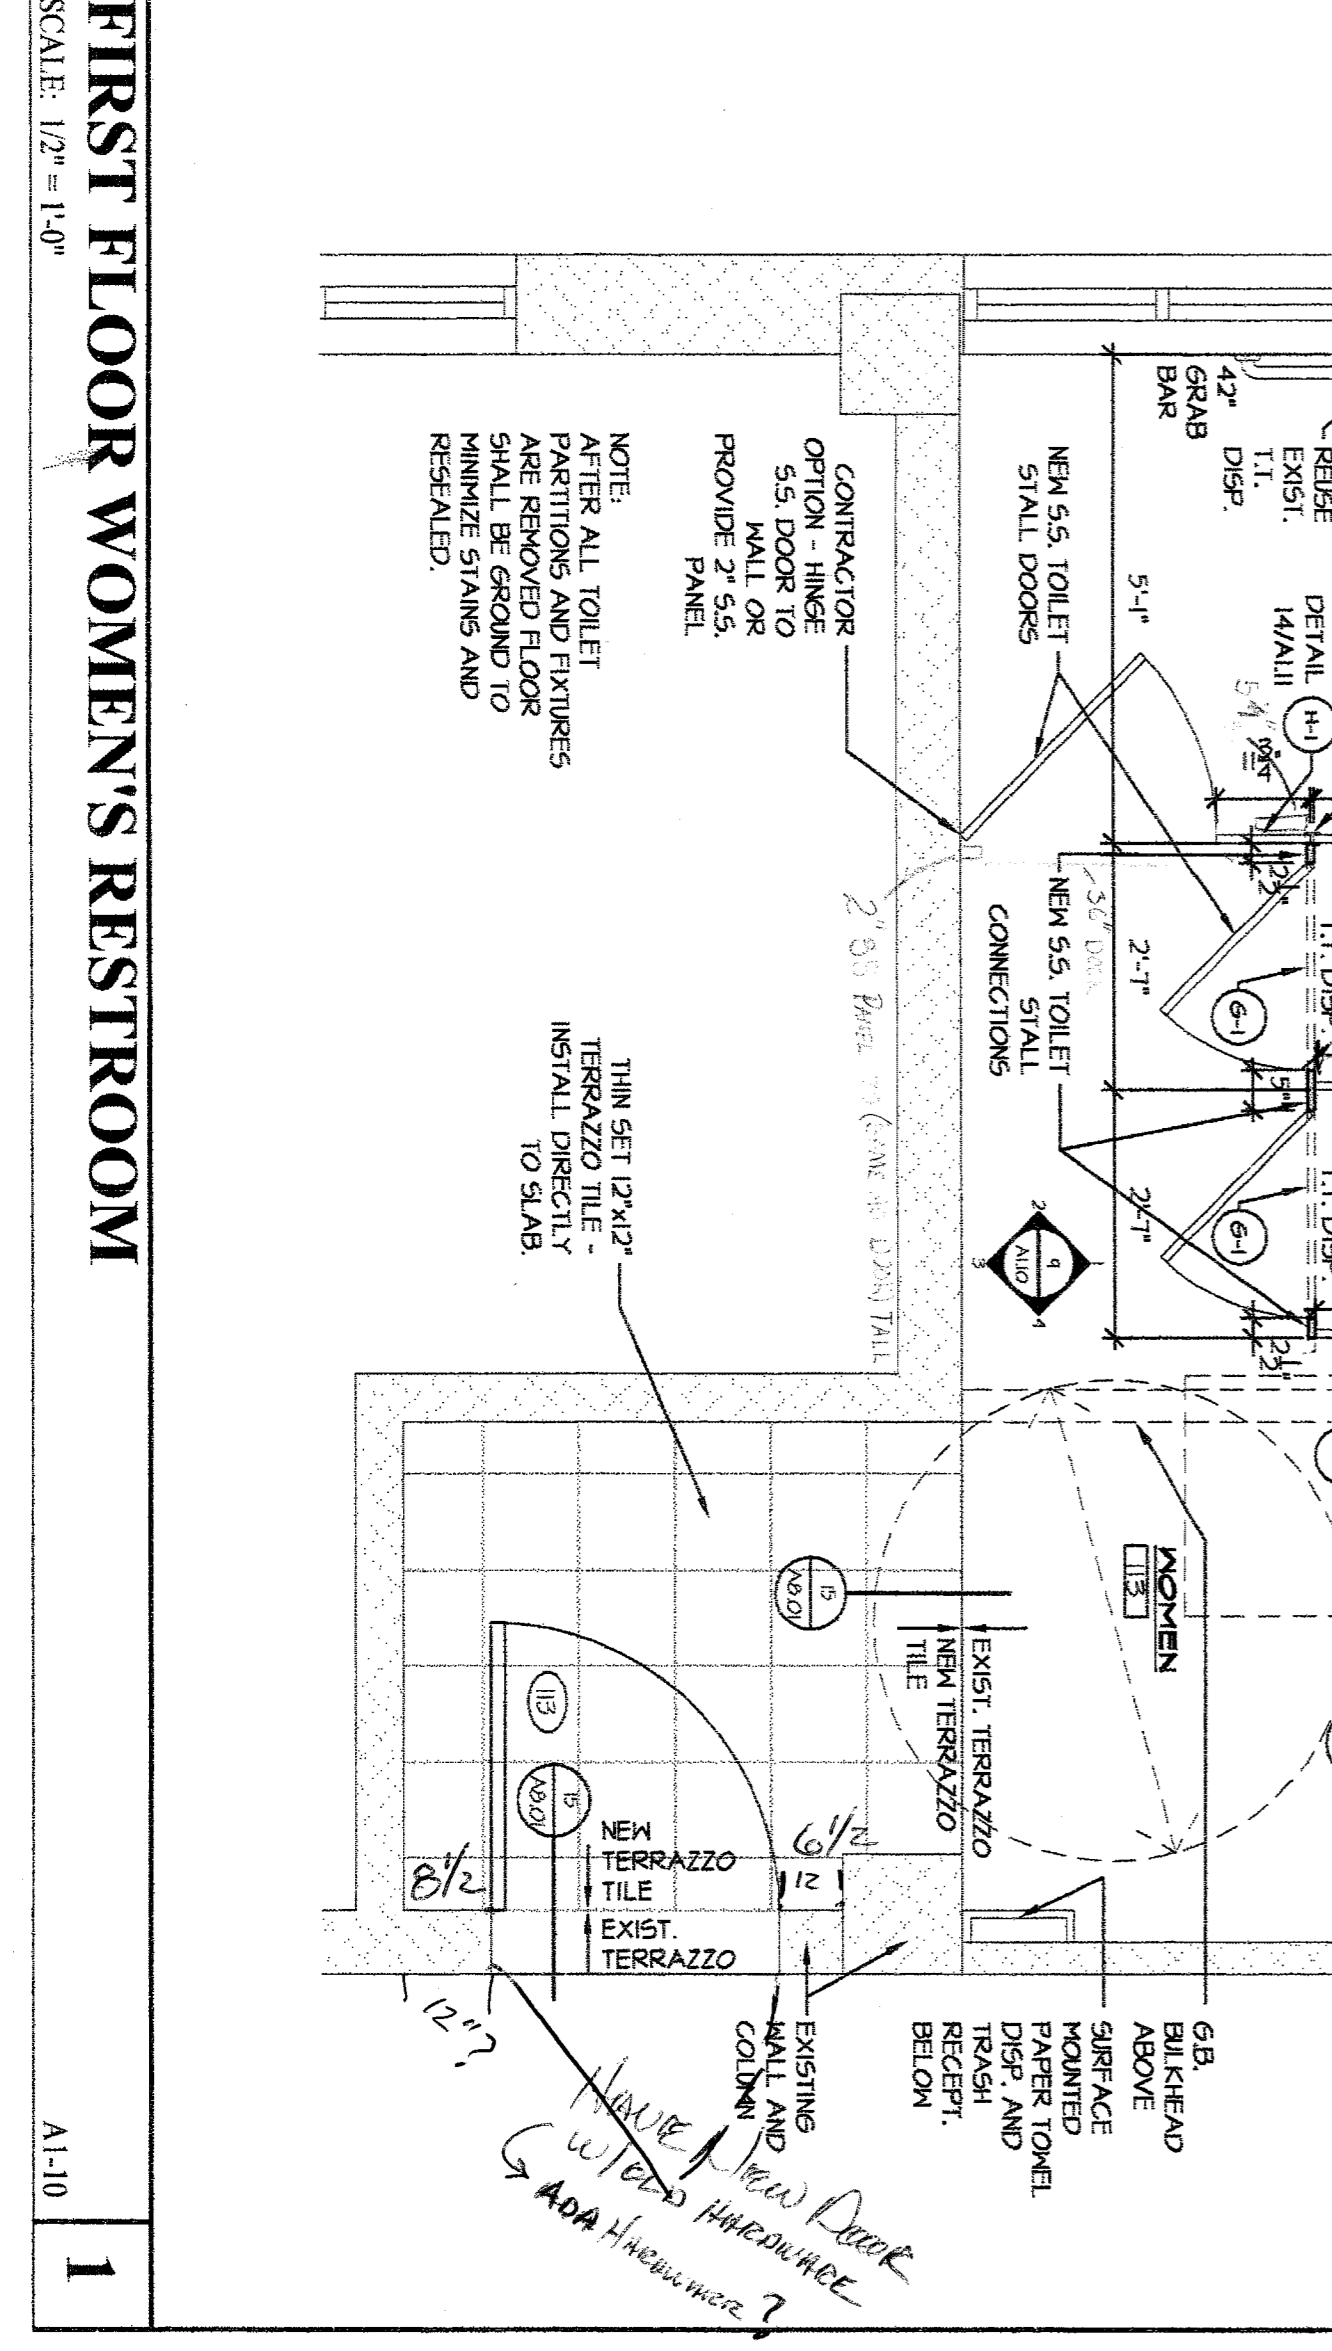


FIRST FLOOR WOMEN'S RESTROOM

SCALE: 1/2" = 1'-0"
 A1-10

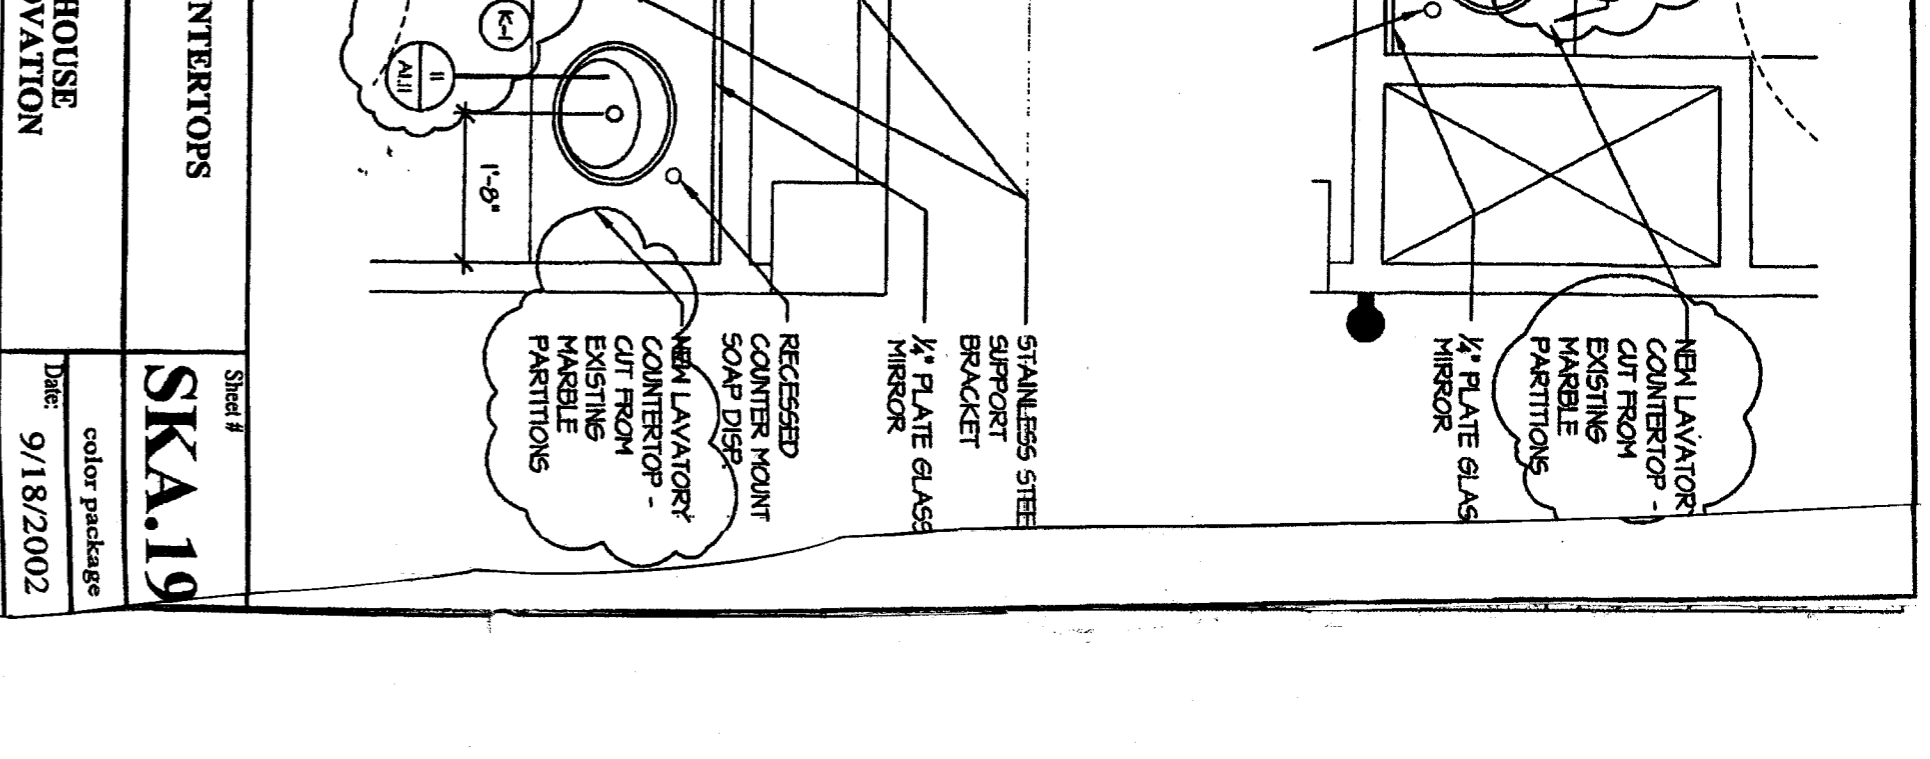


FIRST FLOOR MEN'S ROOM ELEVATIONS

SCALE: 1/2" = 1'-0"
 A1-10

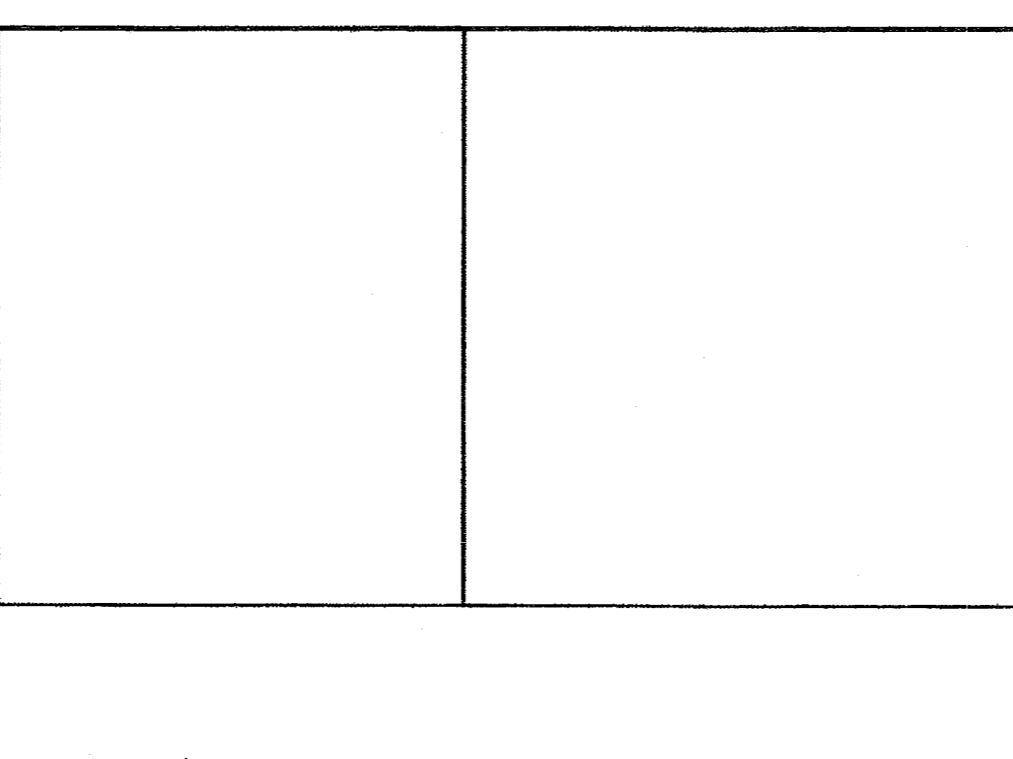

FIRST FLOOR WOMEN'S ROOM ELEVATIONS

SCALE: 1/2" = 1'-0"
 A1-10

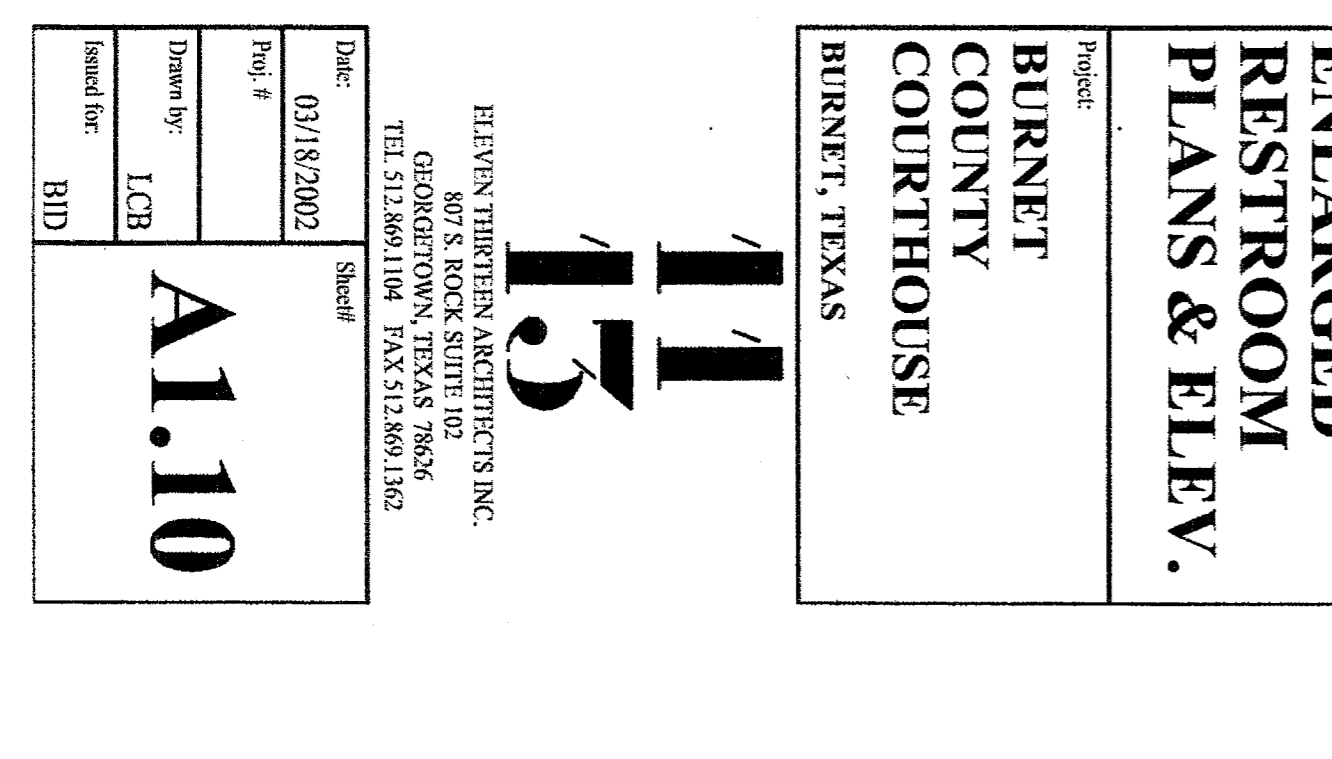

FIRST FLOOR WOMEN'S ROOM ELEVATIONS

SCALE: 1/2" = 1'-0"
 A1-10

Project: **BURNETT COUNTY COURTHOUSE**
 BURNETT, TEXAS


Sheet Title: **ENLARGED RESTROOM PLANS & ELEV.**

Sheet: **11-13**


HEVEN THIRTEEN ARCHITECTS INC.
 805 S. ROCK STREET, SUITE 102
 GEORGETOWN, TEXAS 75220
 TEL: 512.869.1193 FAX: 512.869.1192

Date: 03/18/2002
 Drawn by: LCB
 Issued for: BID


Scale: **A1-10**

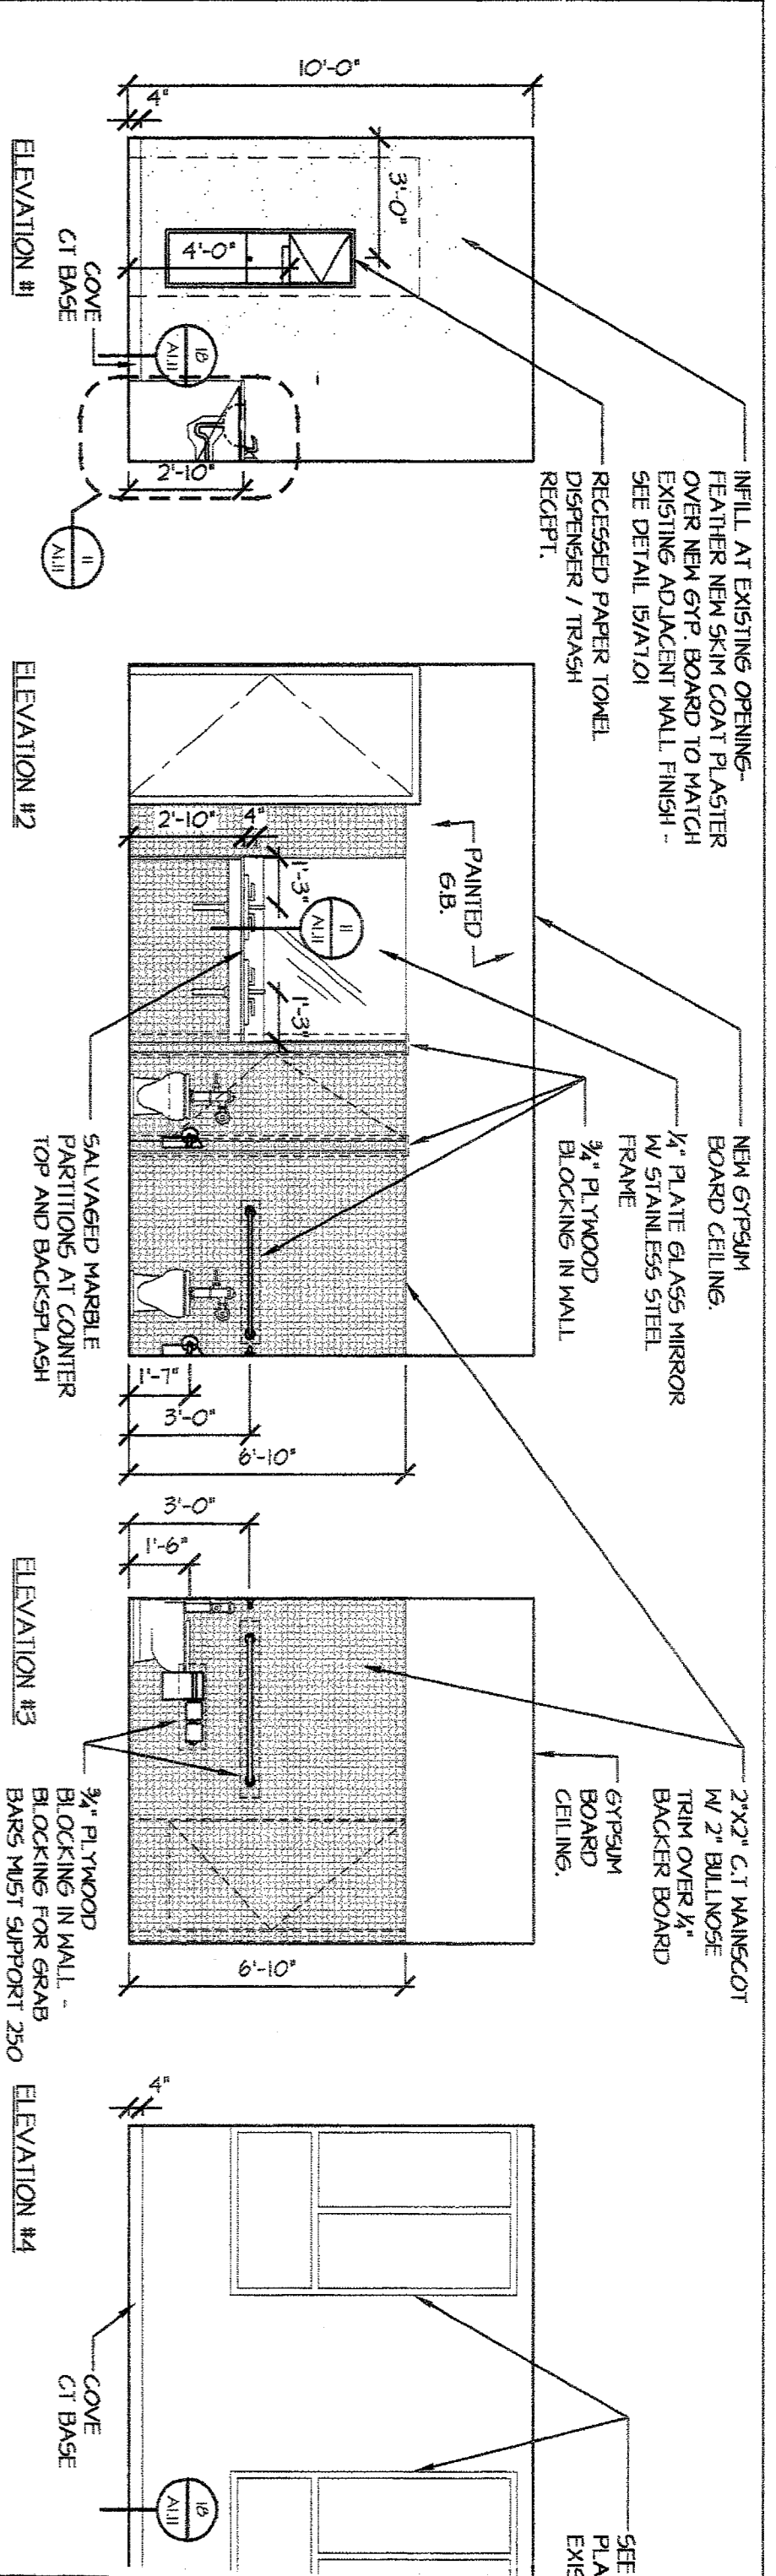


SECOND FLOOR WOMEN'S ROOM ELEVATIONS
 SCALE: 1/4" = 1'-0"

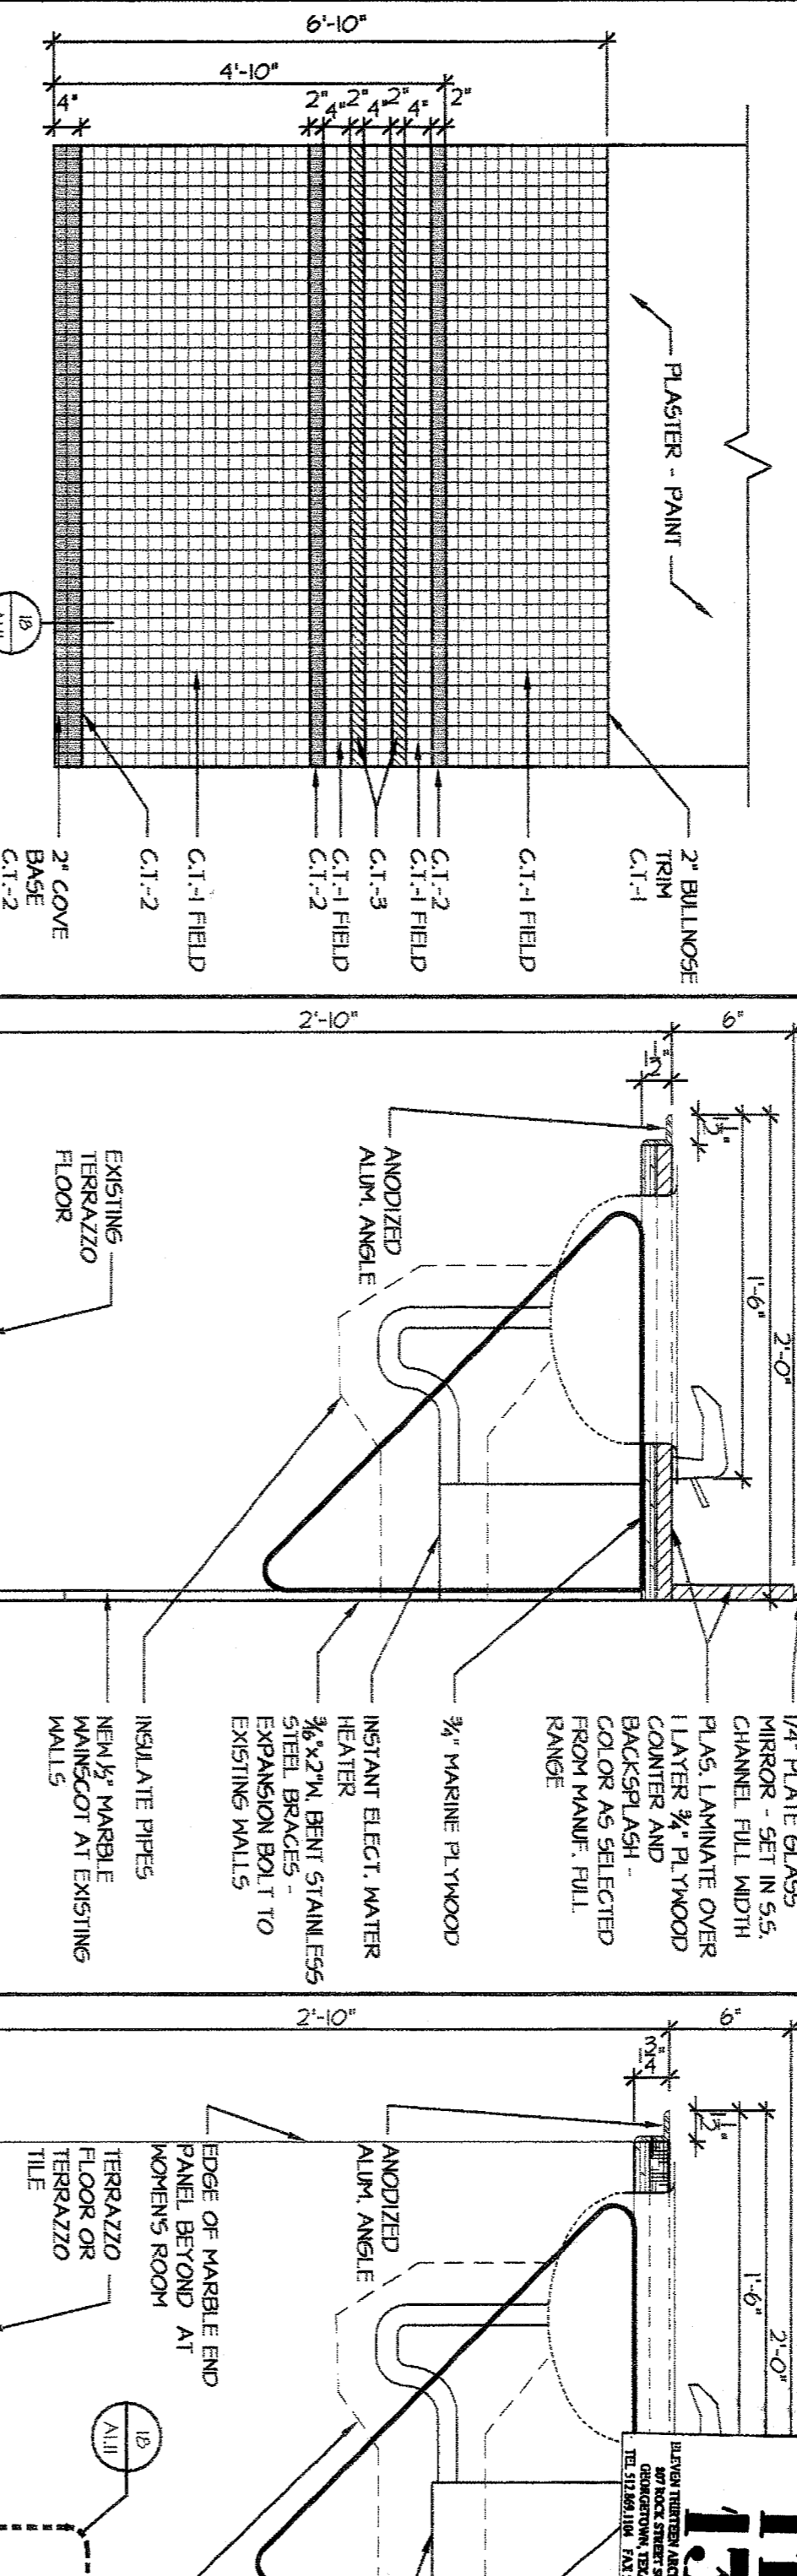


CERAMIC WALL TILE PATT. 19
 SCALE: 1/2" = 1'-0"

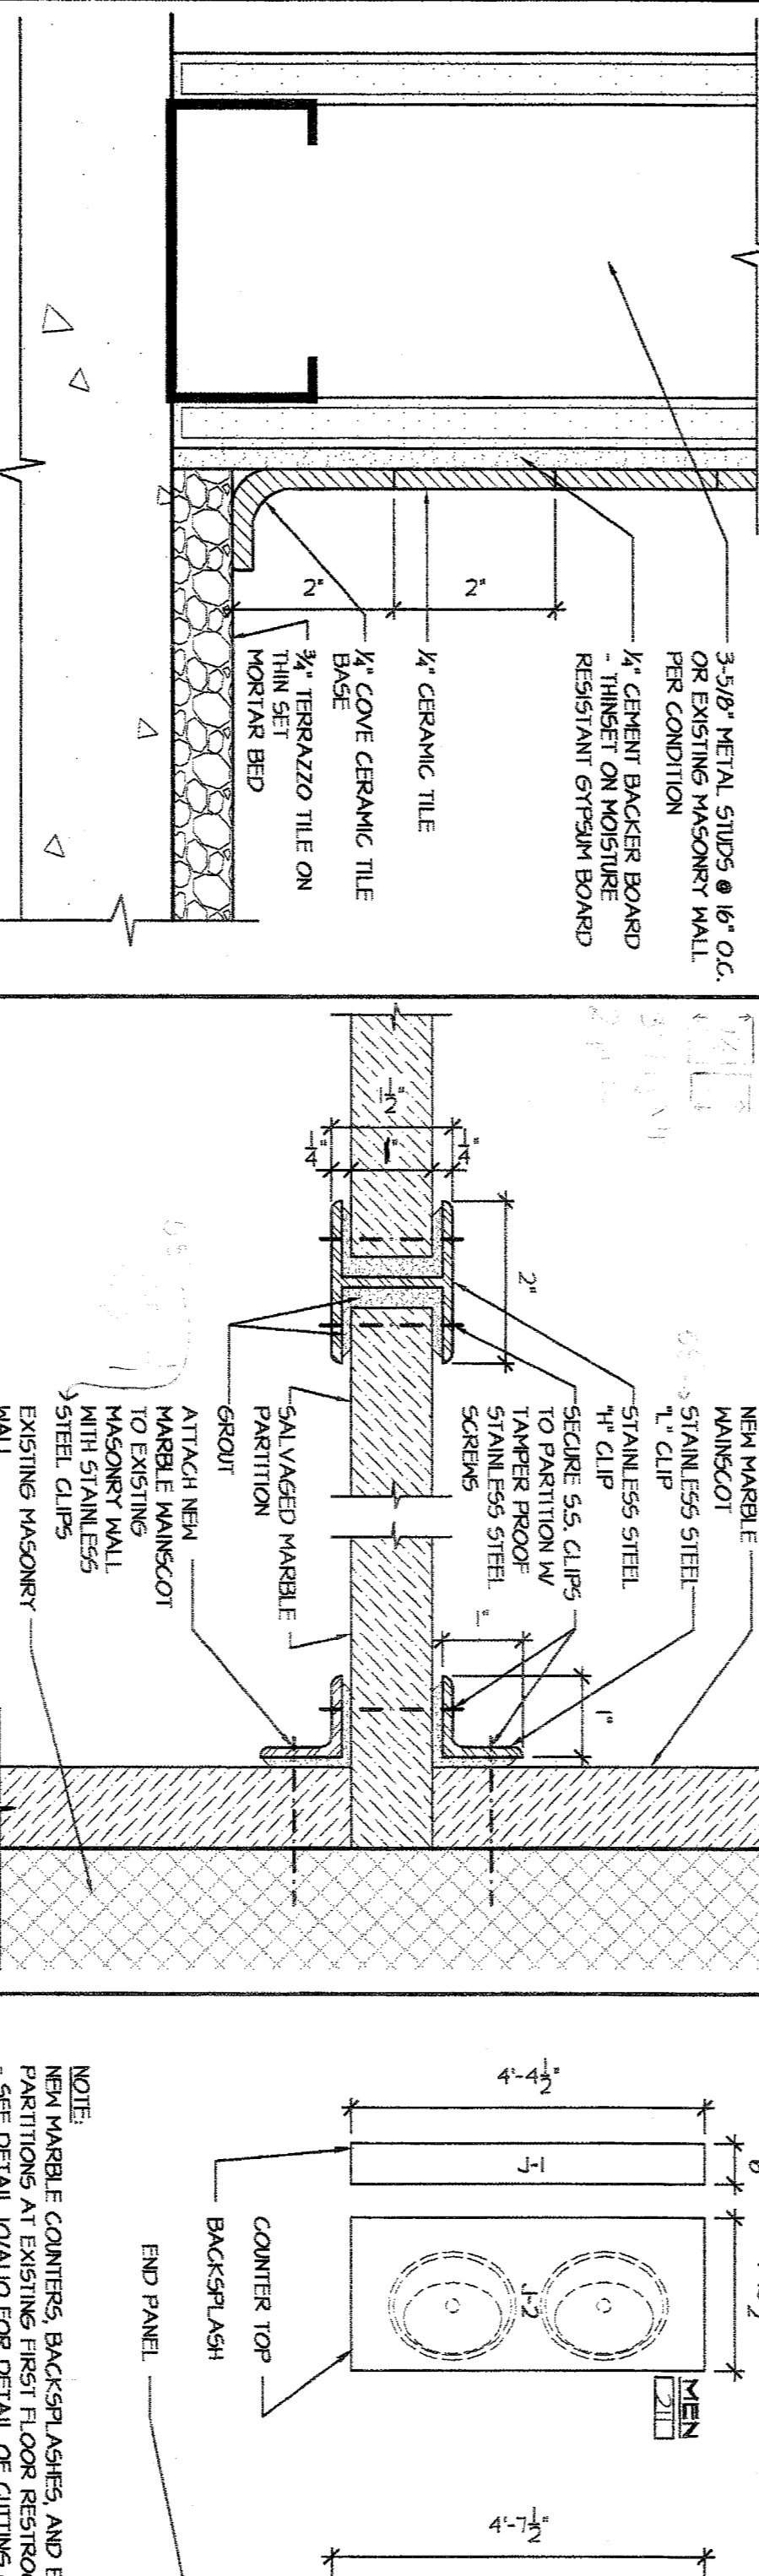


SECT. @ MARBLE COUNTER 15
 SCALE: 1/2" = 1'-0"

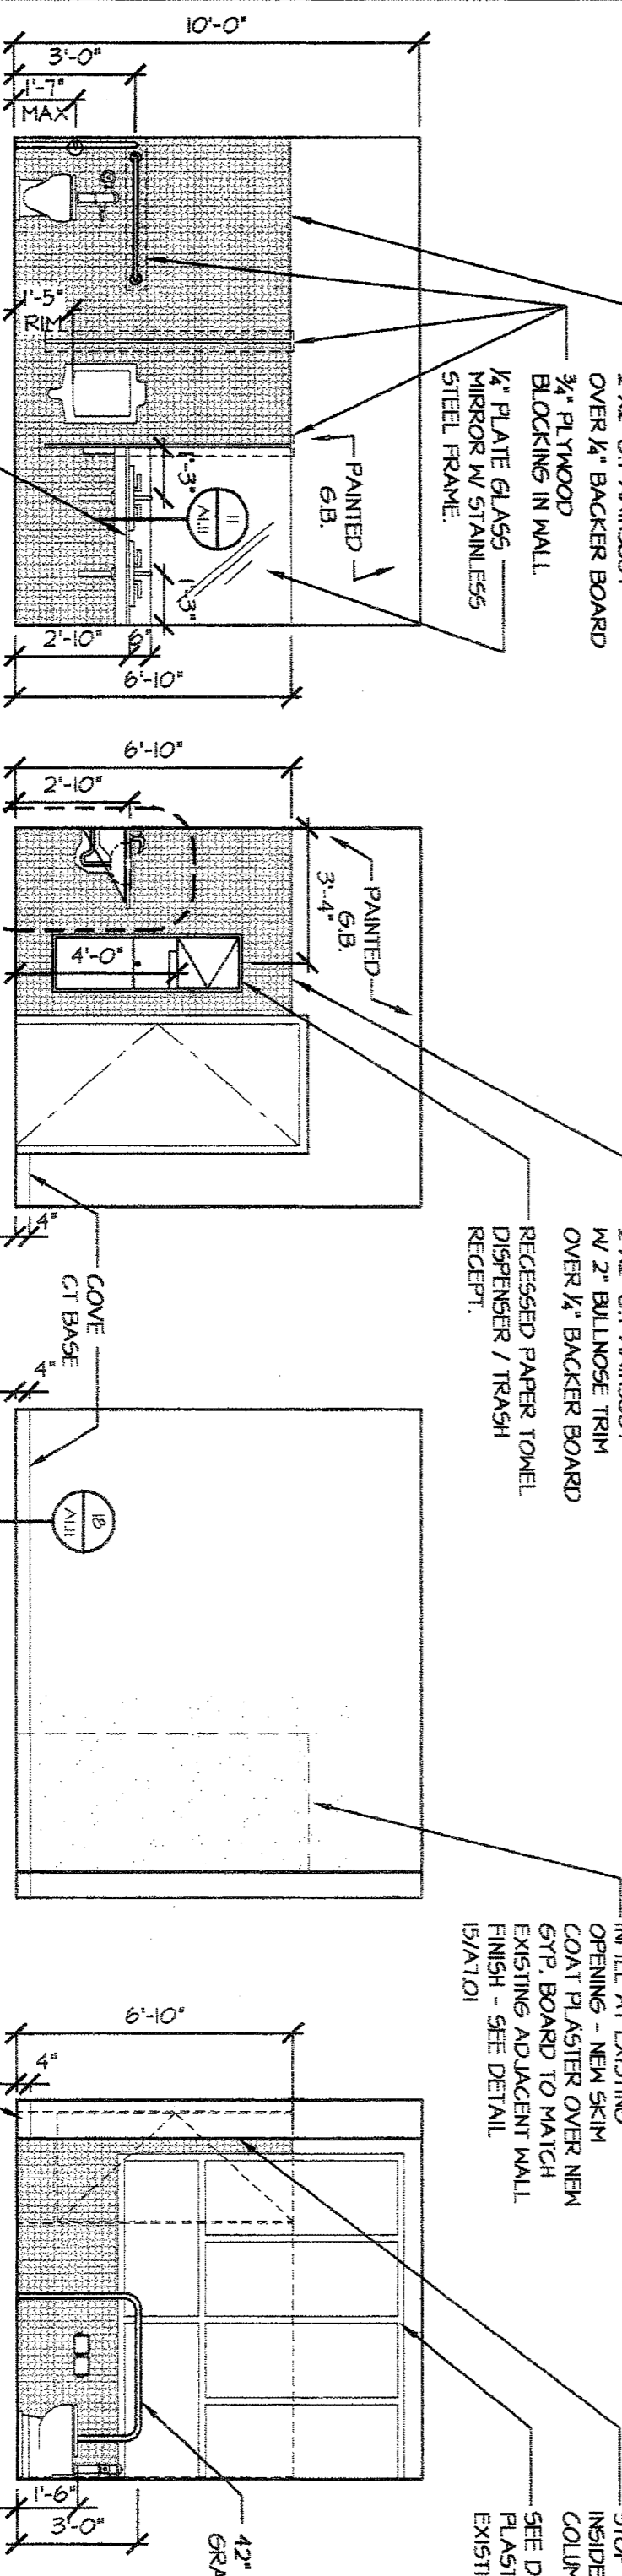


SECOND FLOOR MEN'S ROOM ELEVATIONS
 SCALE: 1/4" = 1'-0"

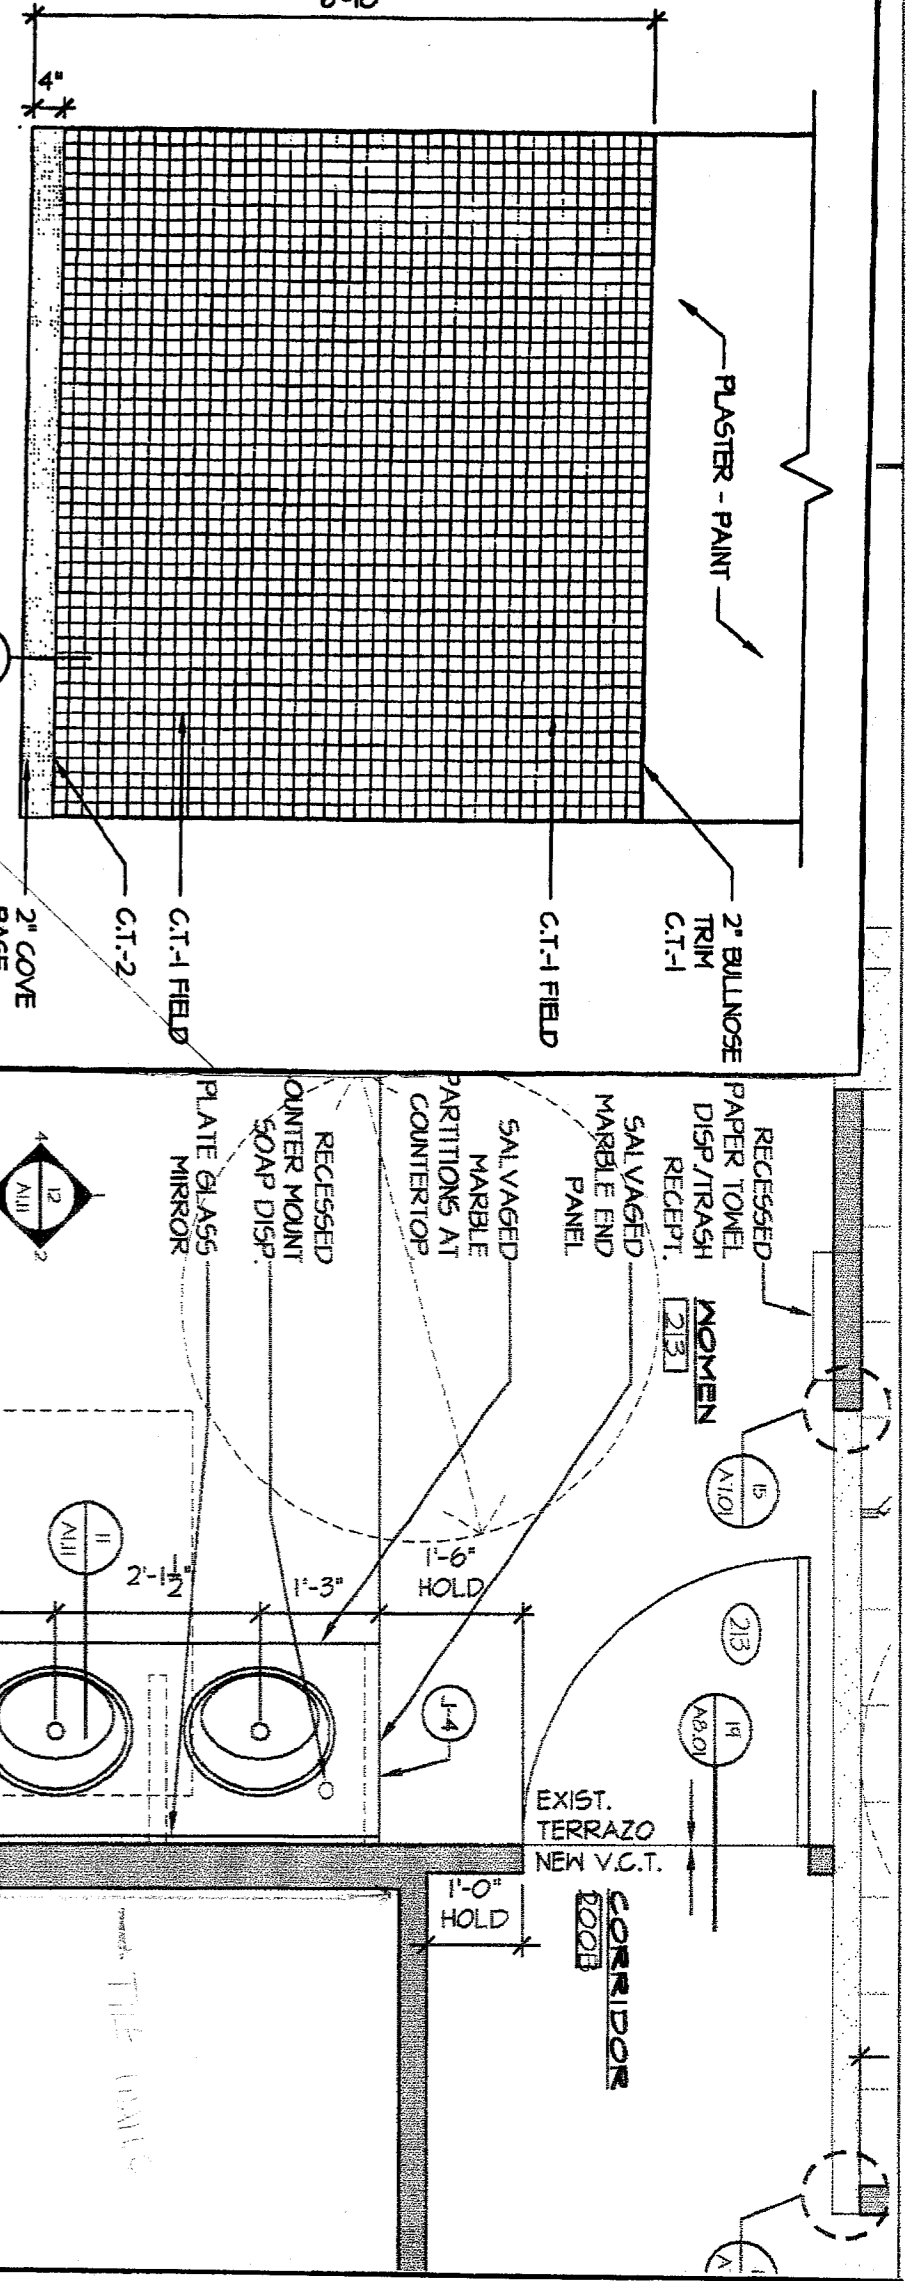


CERAMIC WALL TILE PATT. 19
 SCALE: 1/2" = 1'-0"

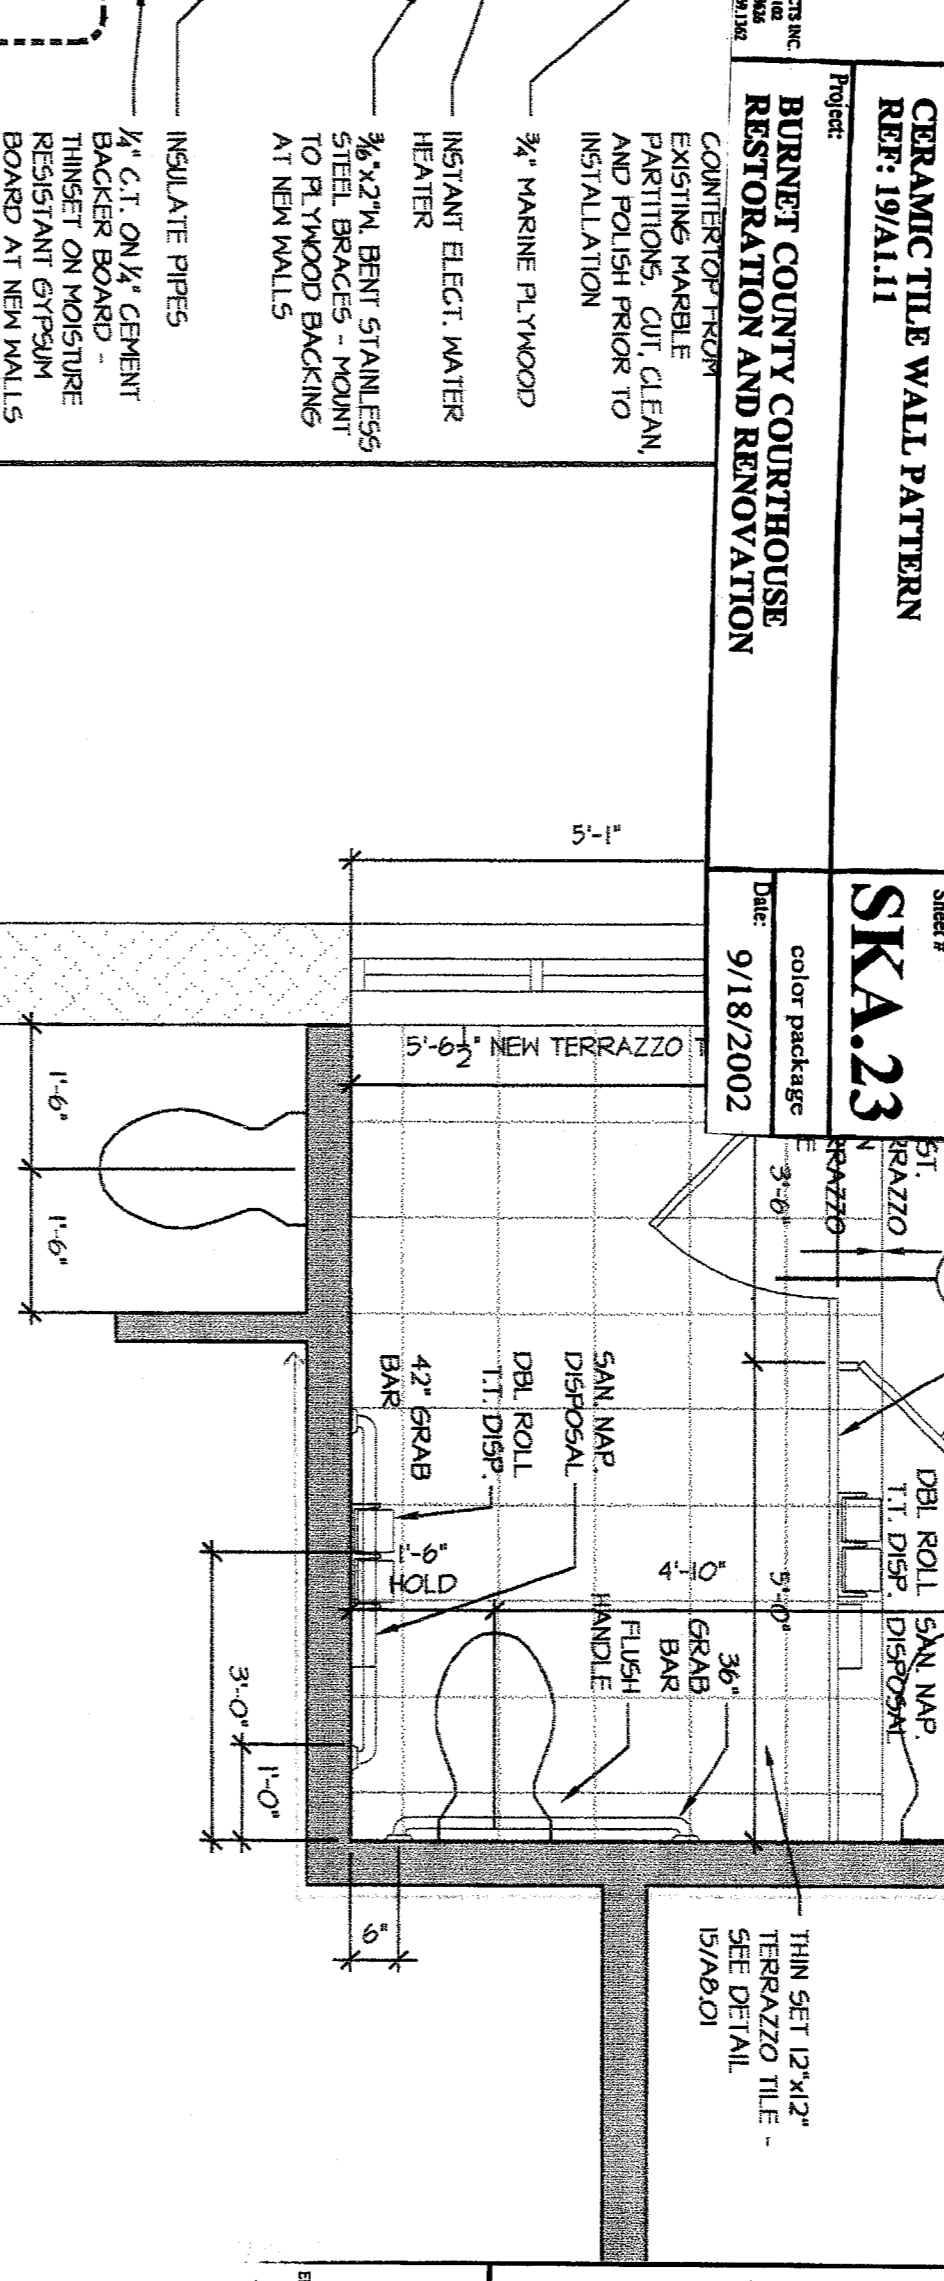


SECT. @ MARBLE COUNTER 11
 SCALE: 1/2" = 1'-0"

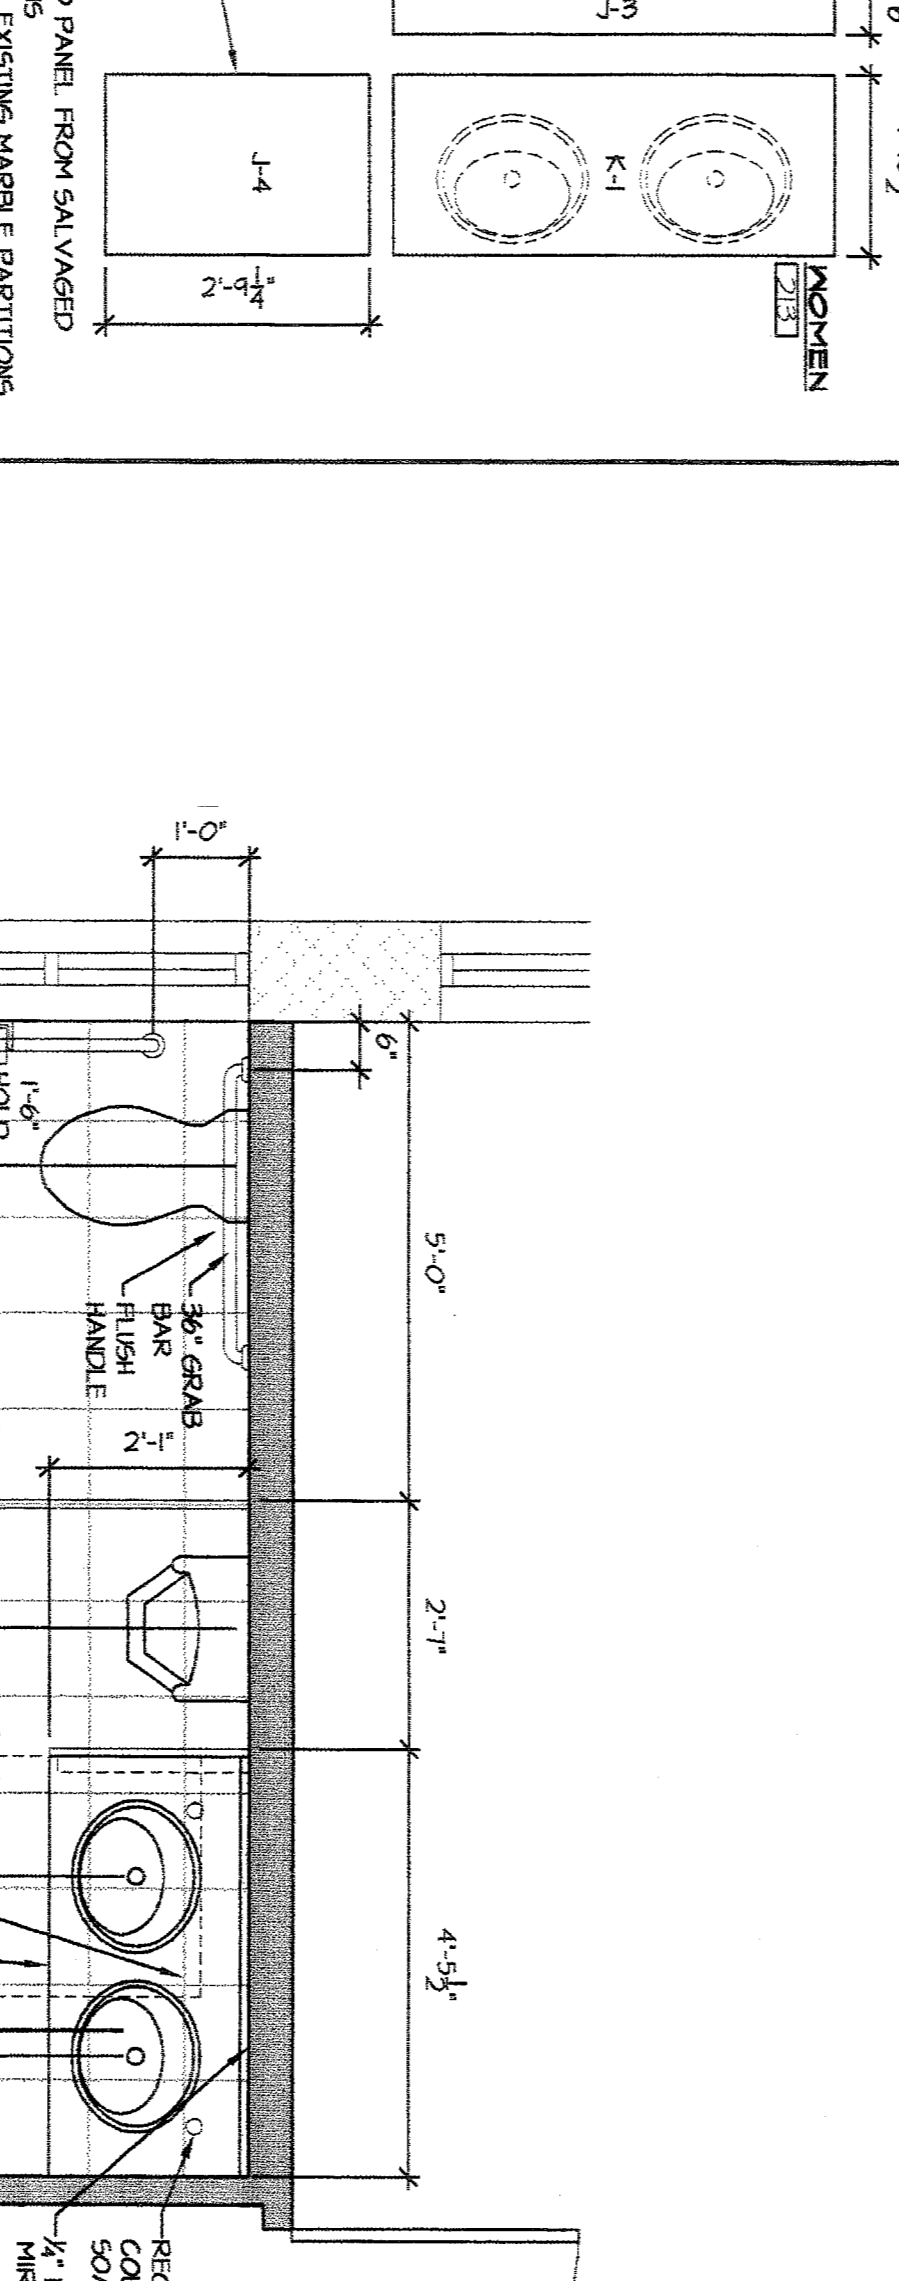


SECT. @ MARBLE COUNTER 11
 SCALE: 1/2" = 1'-0"

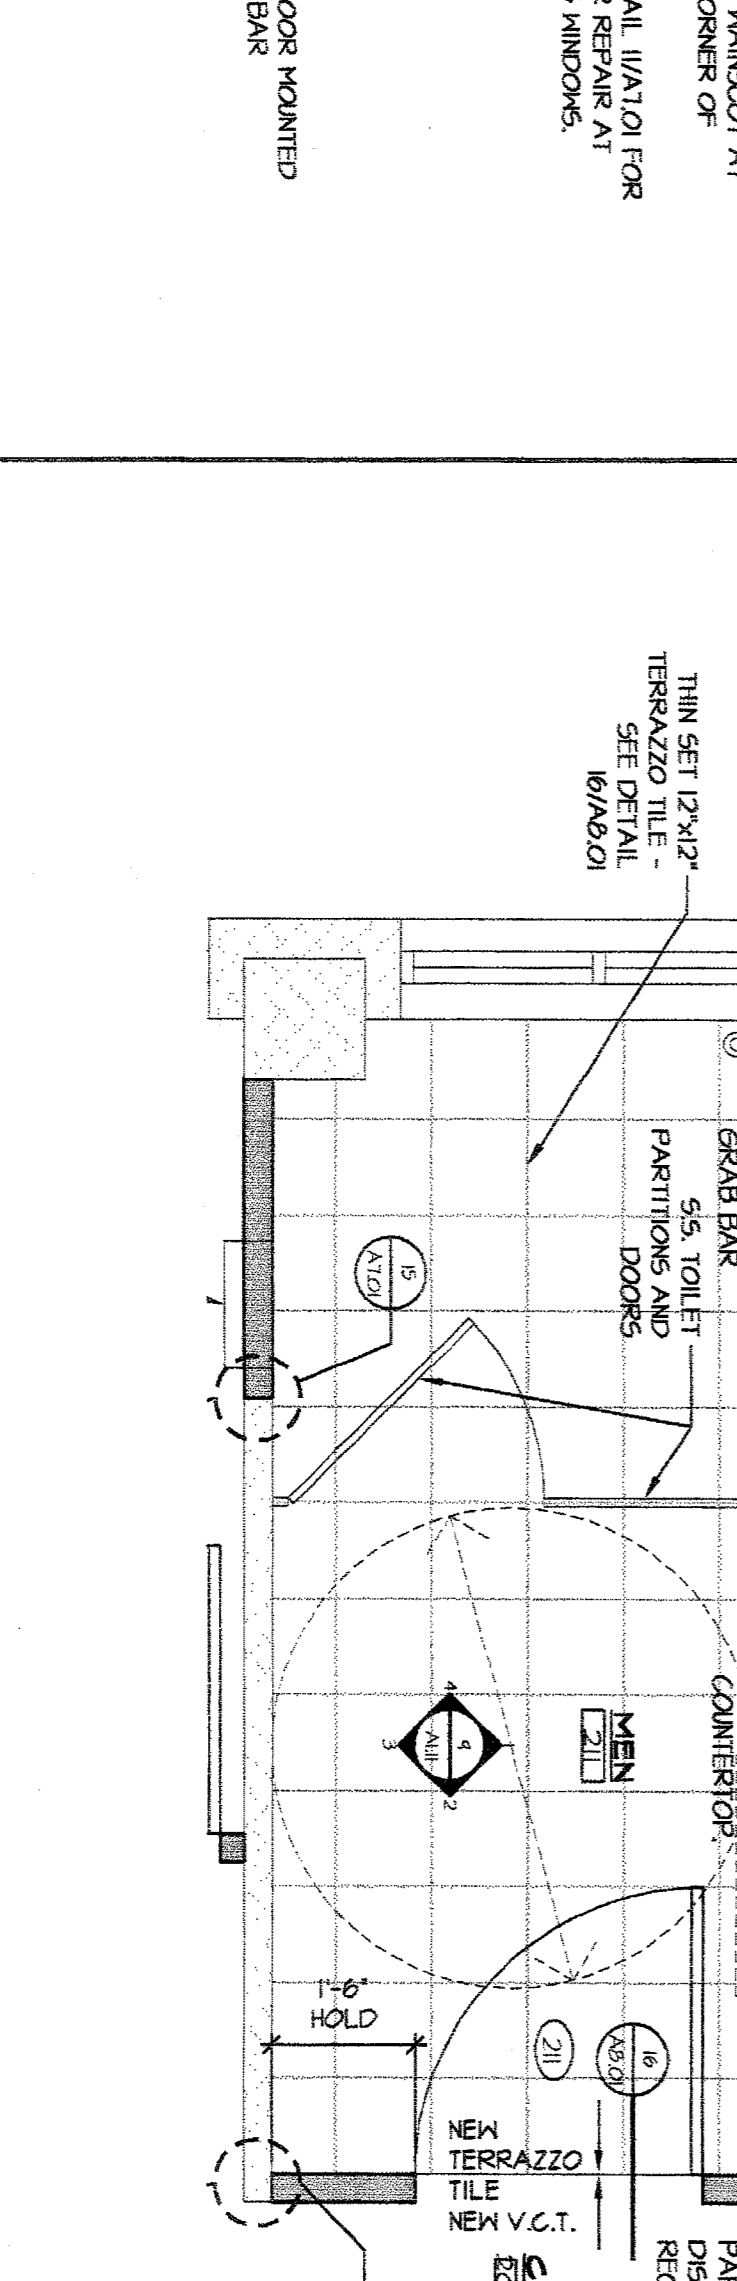


SECOND FLOOR MEN'S RESTROOM
 SCALE: 1/2" = 1'-0"

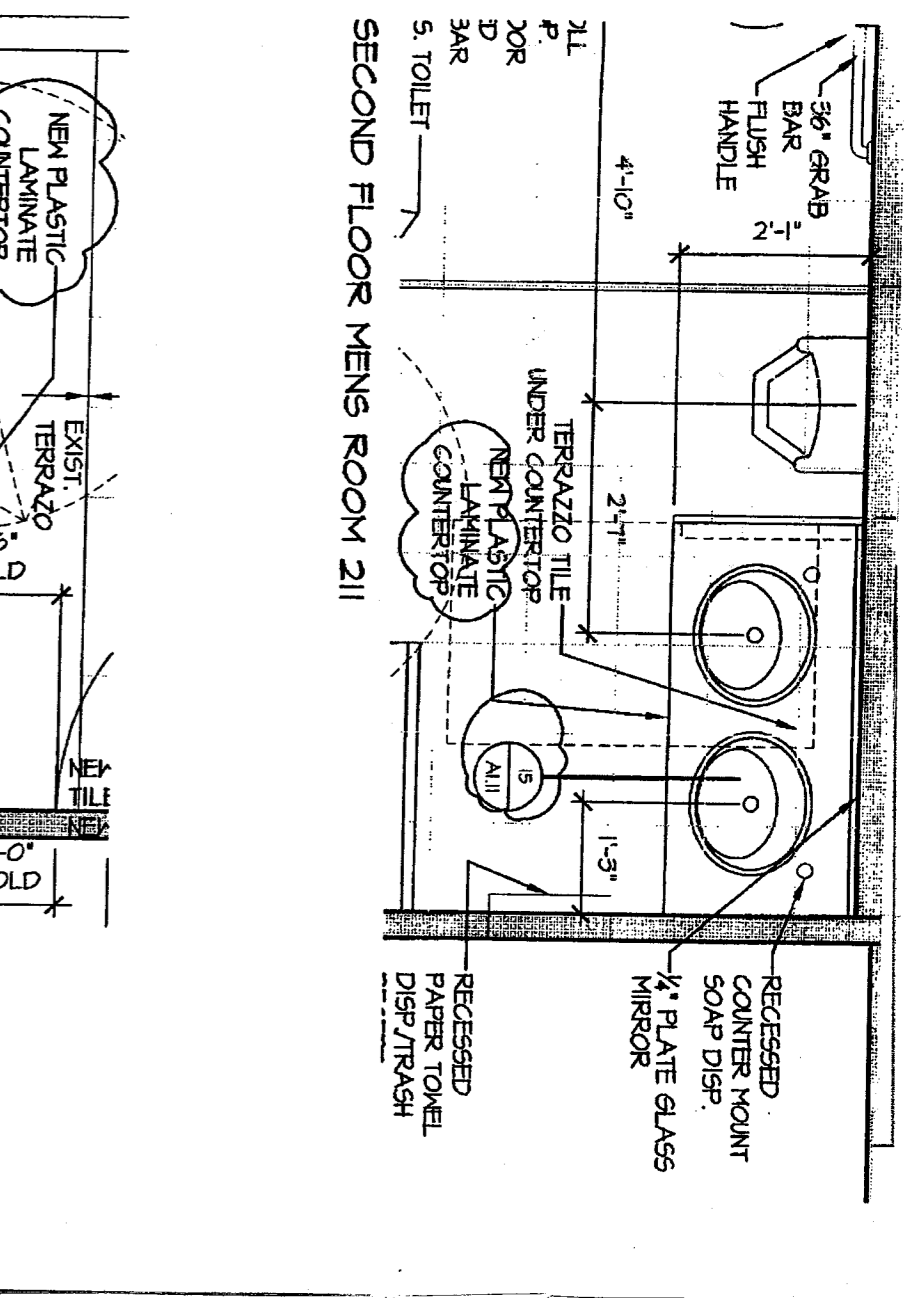


SECT. @ MARBLE COUNTER 11
 SCALE: 1/2" = 1'-0"

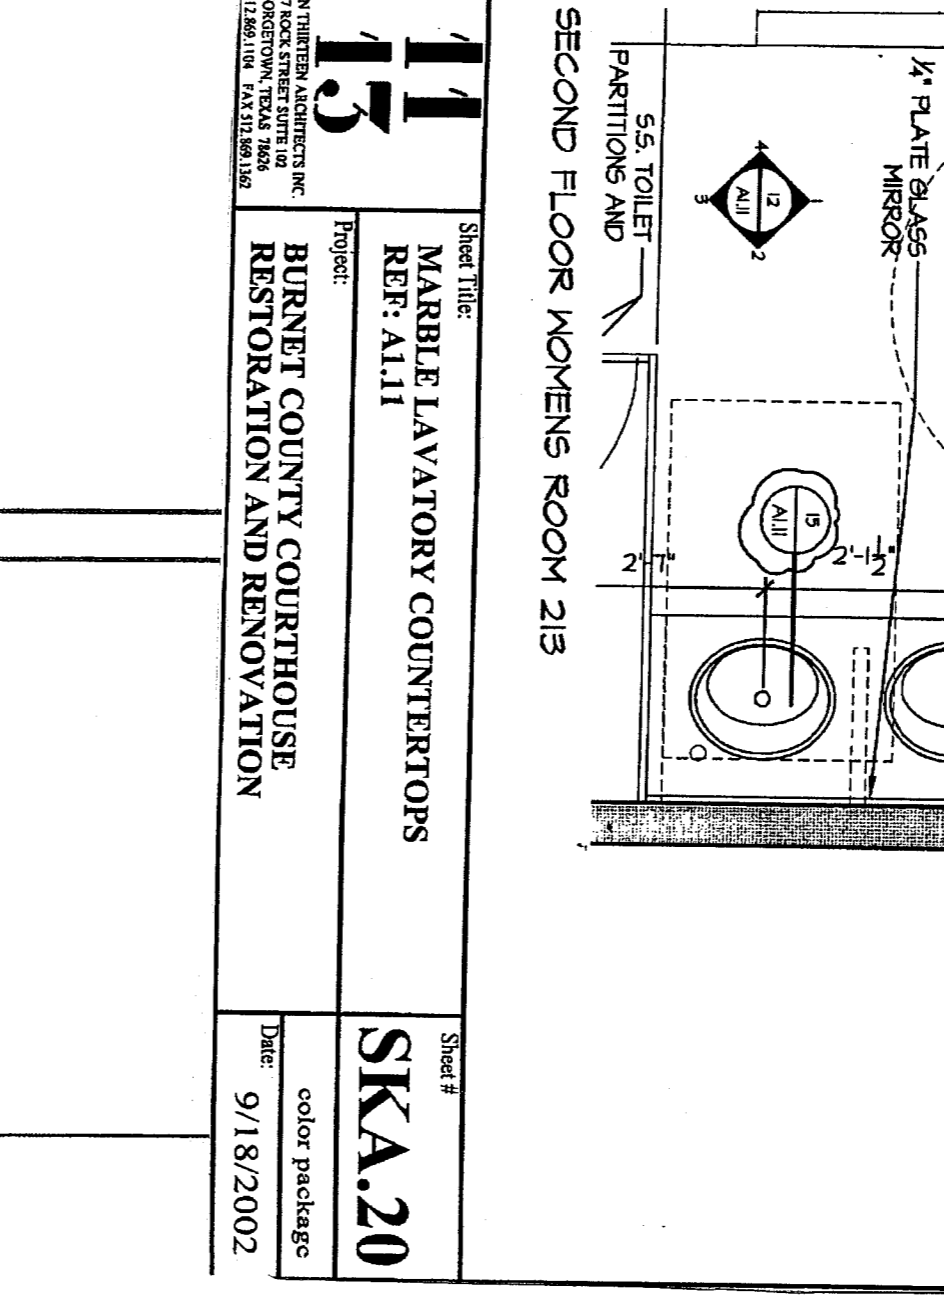


SECT. @ MARBLE COUNTER 11
 SCALE: 1/2" = 1'-0"

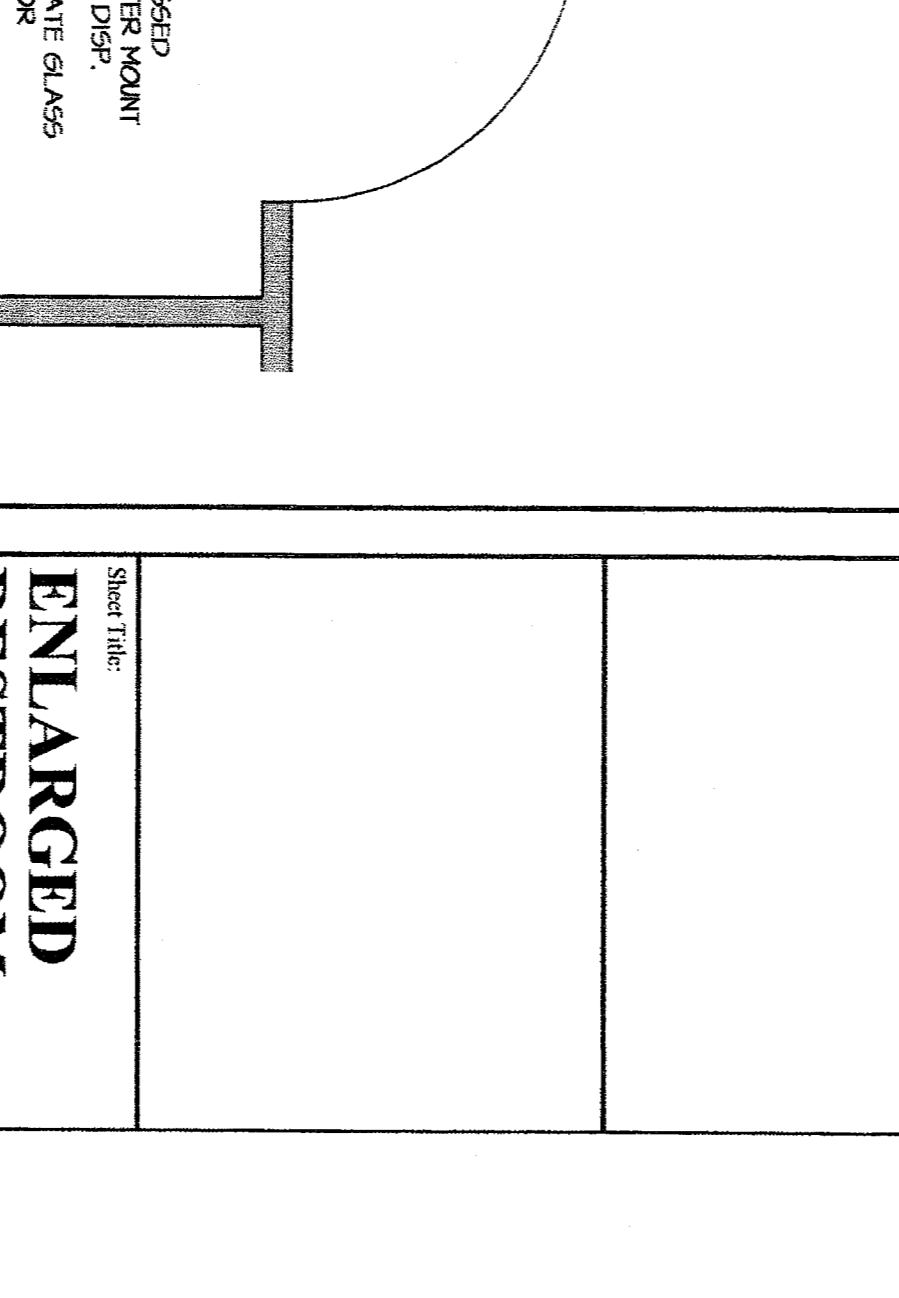


SECOND FLOOR MEN'S RESTROOM
 SCALE: 1/2" = 1'-0"

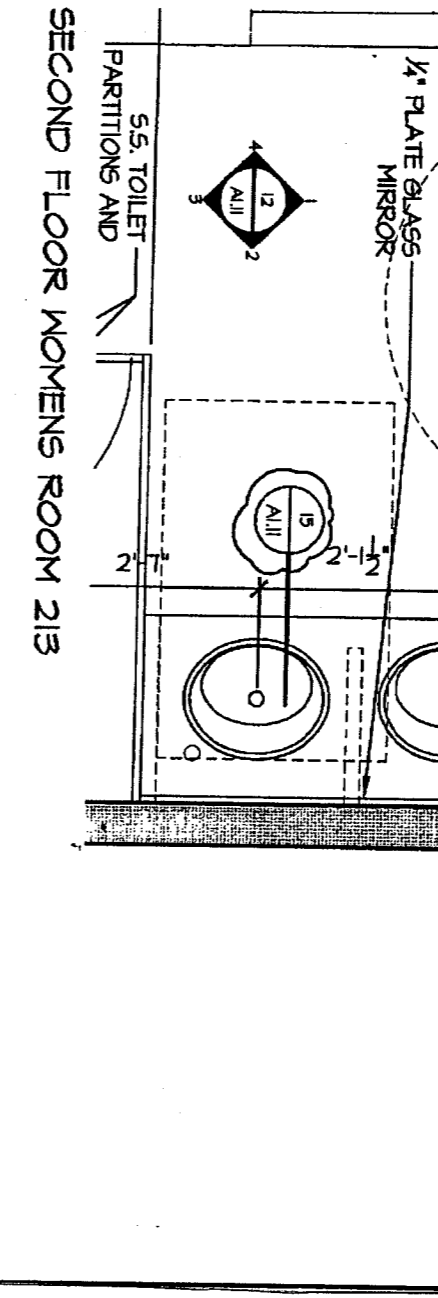

SECT. @ MARBLE COUNTER 11
 SCALE: 1/2" = 1'-0"

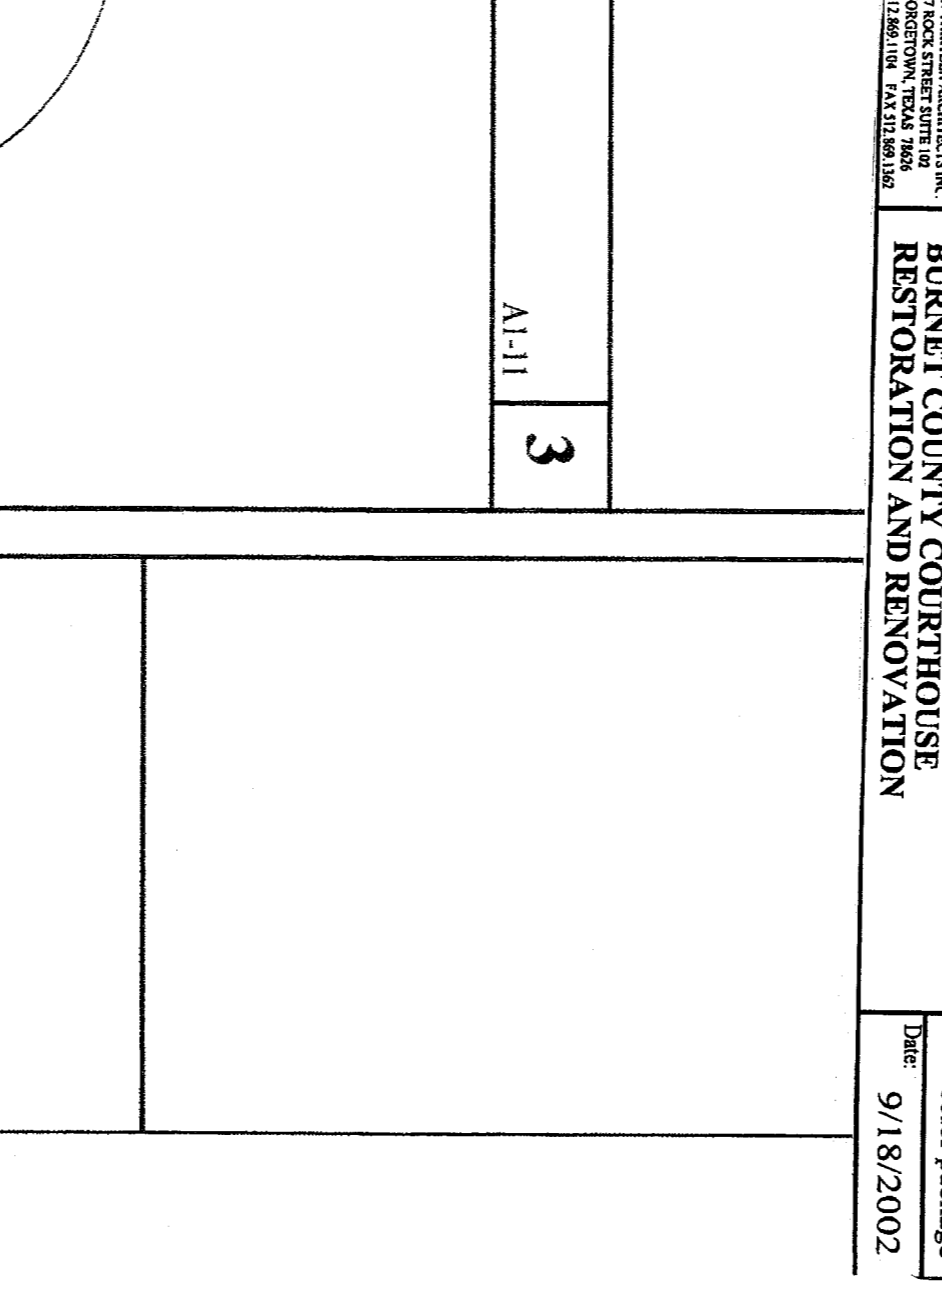

SECT. @ MARBLE COUNTER 11
 SCALE: 1/2" = 1'-0"

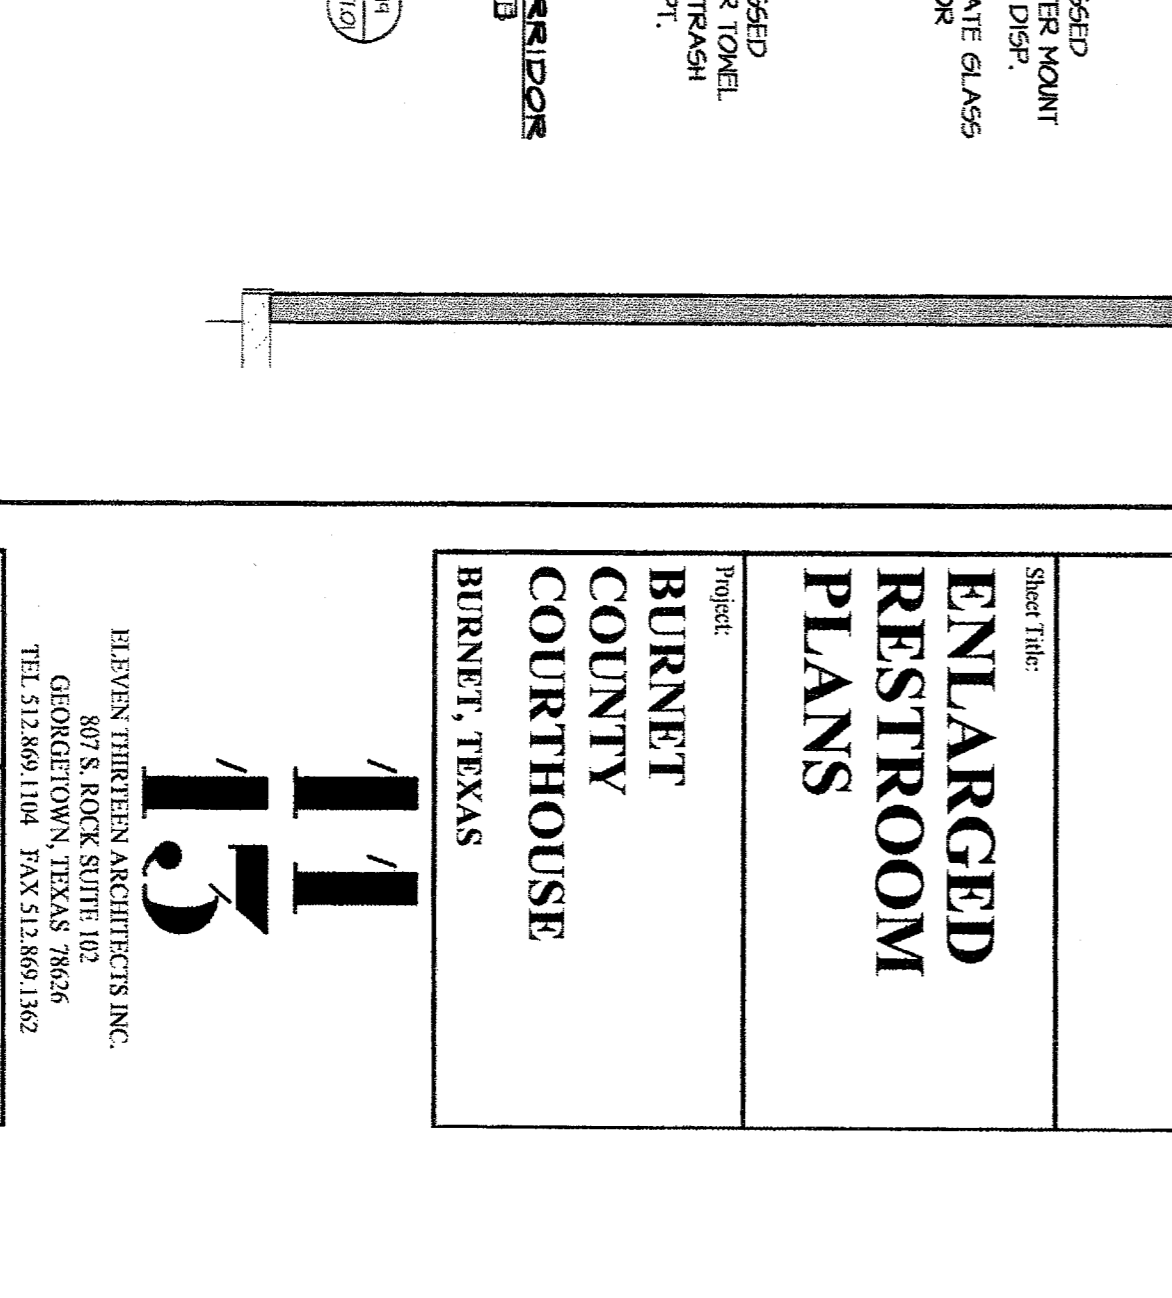

SECOND FLOOR MEN'S RESTROOM
 SCALE: 1/2" = 1'-0"

Sheet Title: **ENLARGED RESTROOM PLANS**


Project: **BURNET COUNTY COURTHOUSE**
 BURNET, TEXAS

Sheet # **11**


Client: **ELVEN THIRTEEN ARCHITECTS INC.**
 807 S. ROCK SUITE 102
 GEORGETOWN, TEXAS 78636
 TEL: 512.369.1104 FAX: 512.369.1142

Date: 03/18/2002
 Drawn by: LCB
 Issued for: BDD


Scale: **A1.11**

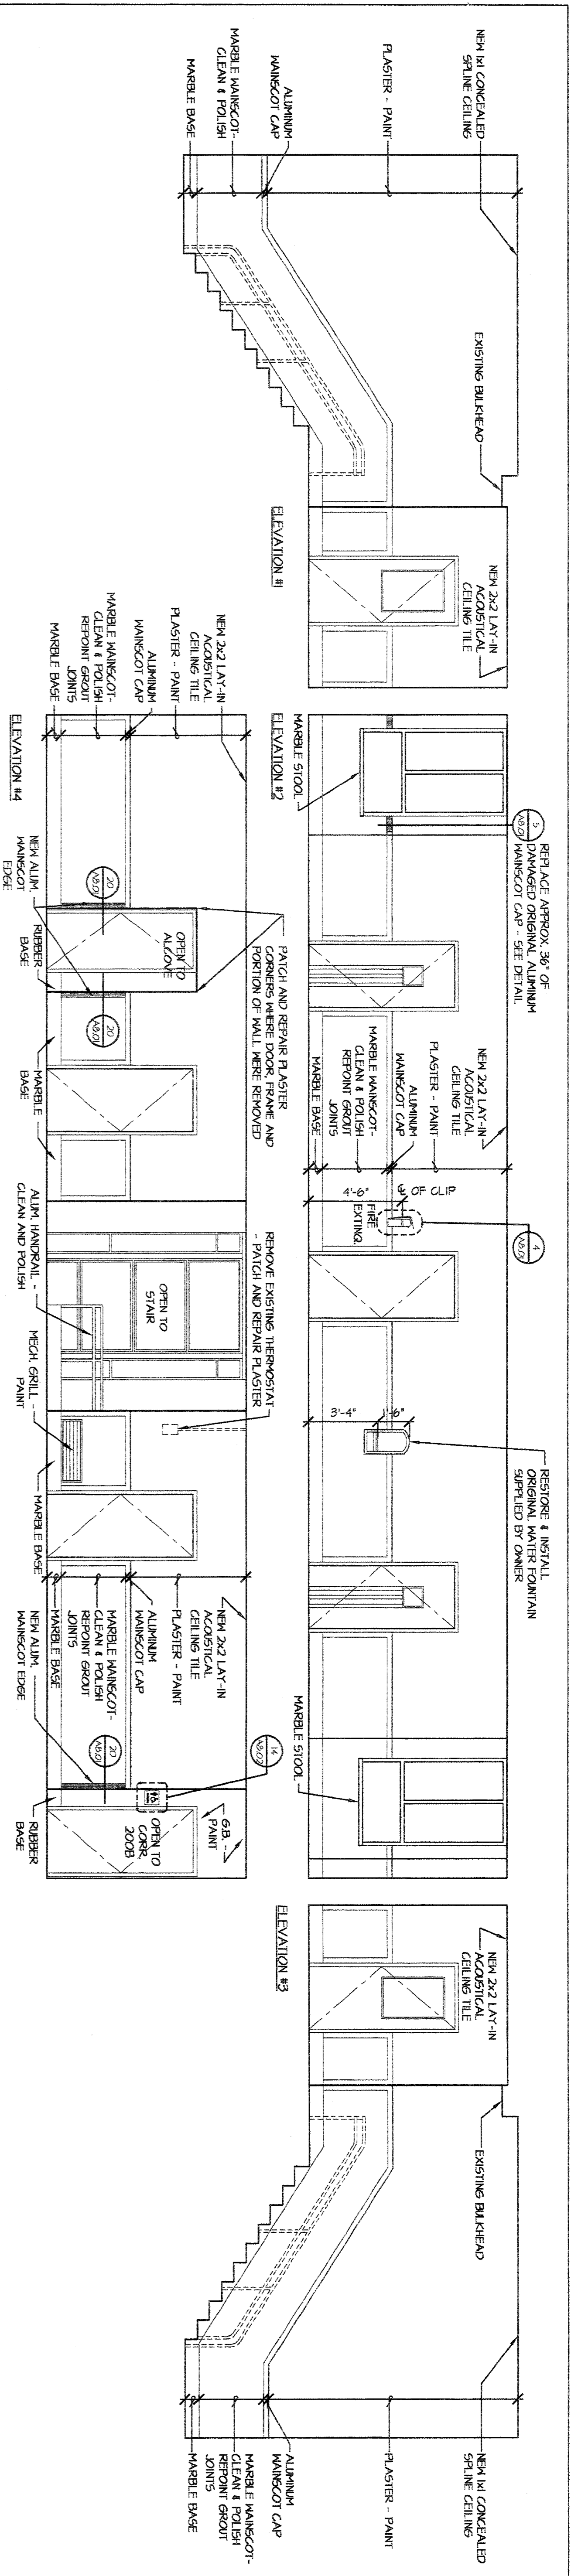


INTERIOR ELEVATION - CORRIDOR 200A
SCALE: 1/4" = 1'-0"

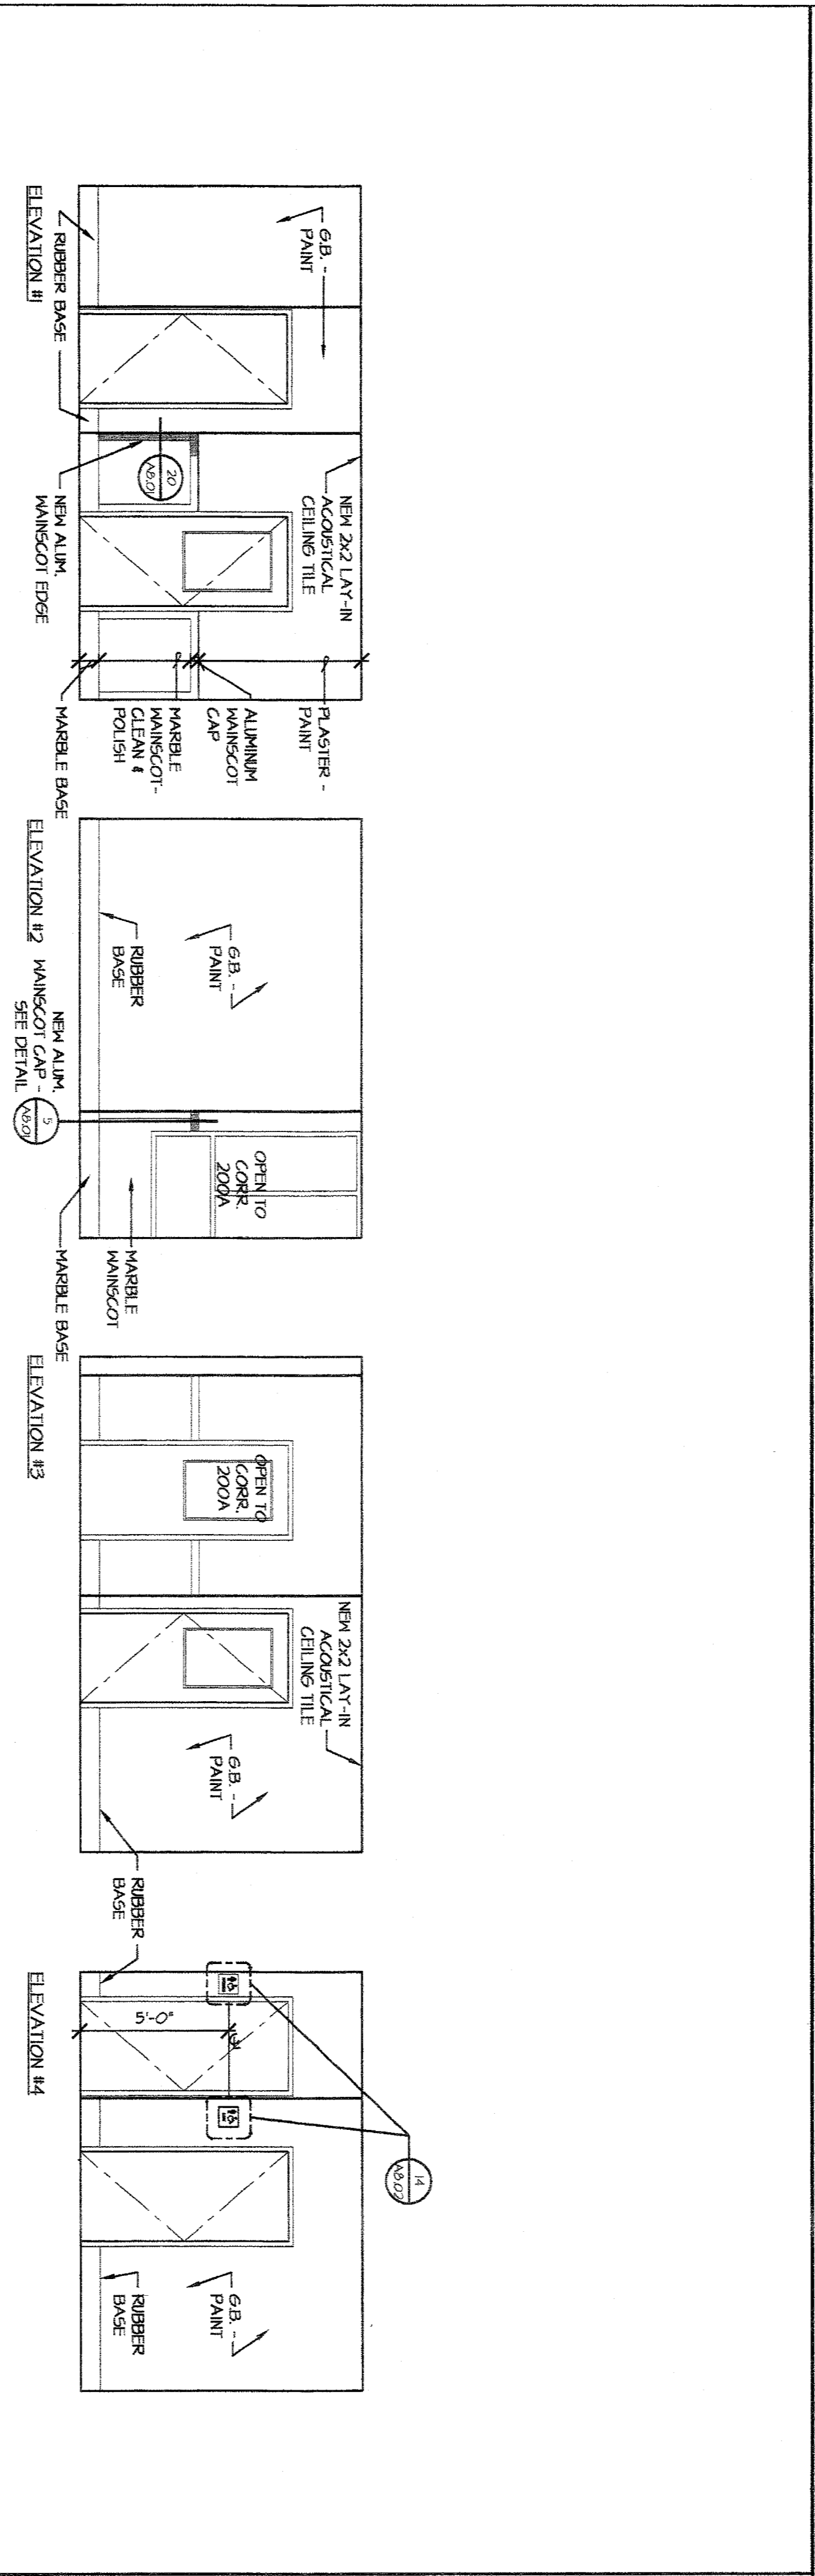


INTERIOR ELEVATION - CORRIDOR 200B
SCALE: 1/4" = 1'-0"

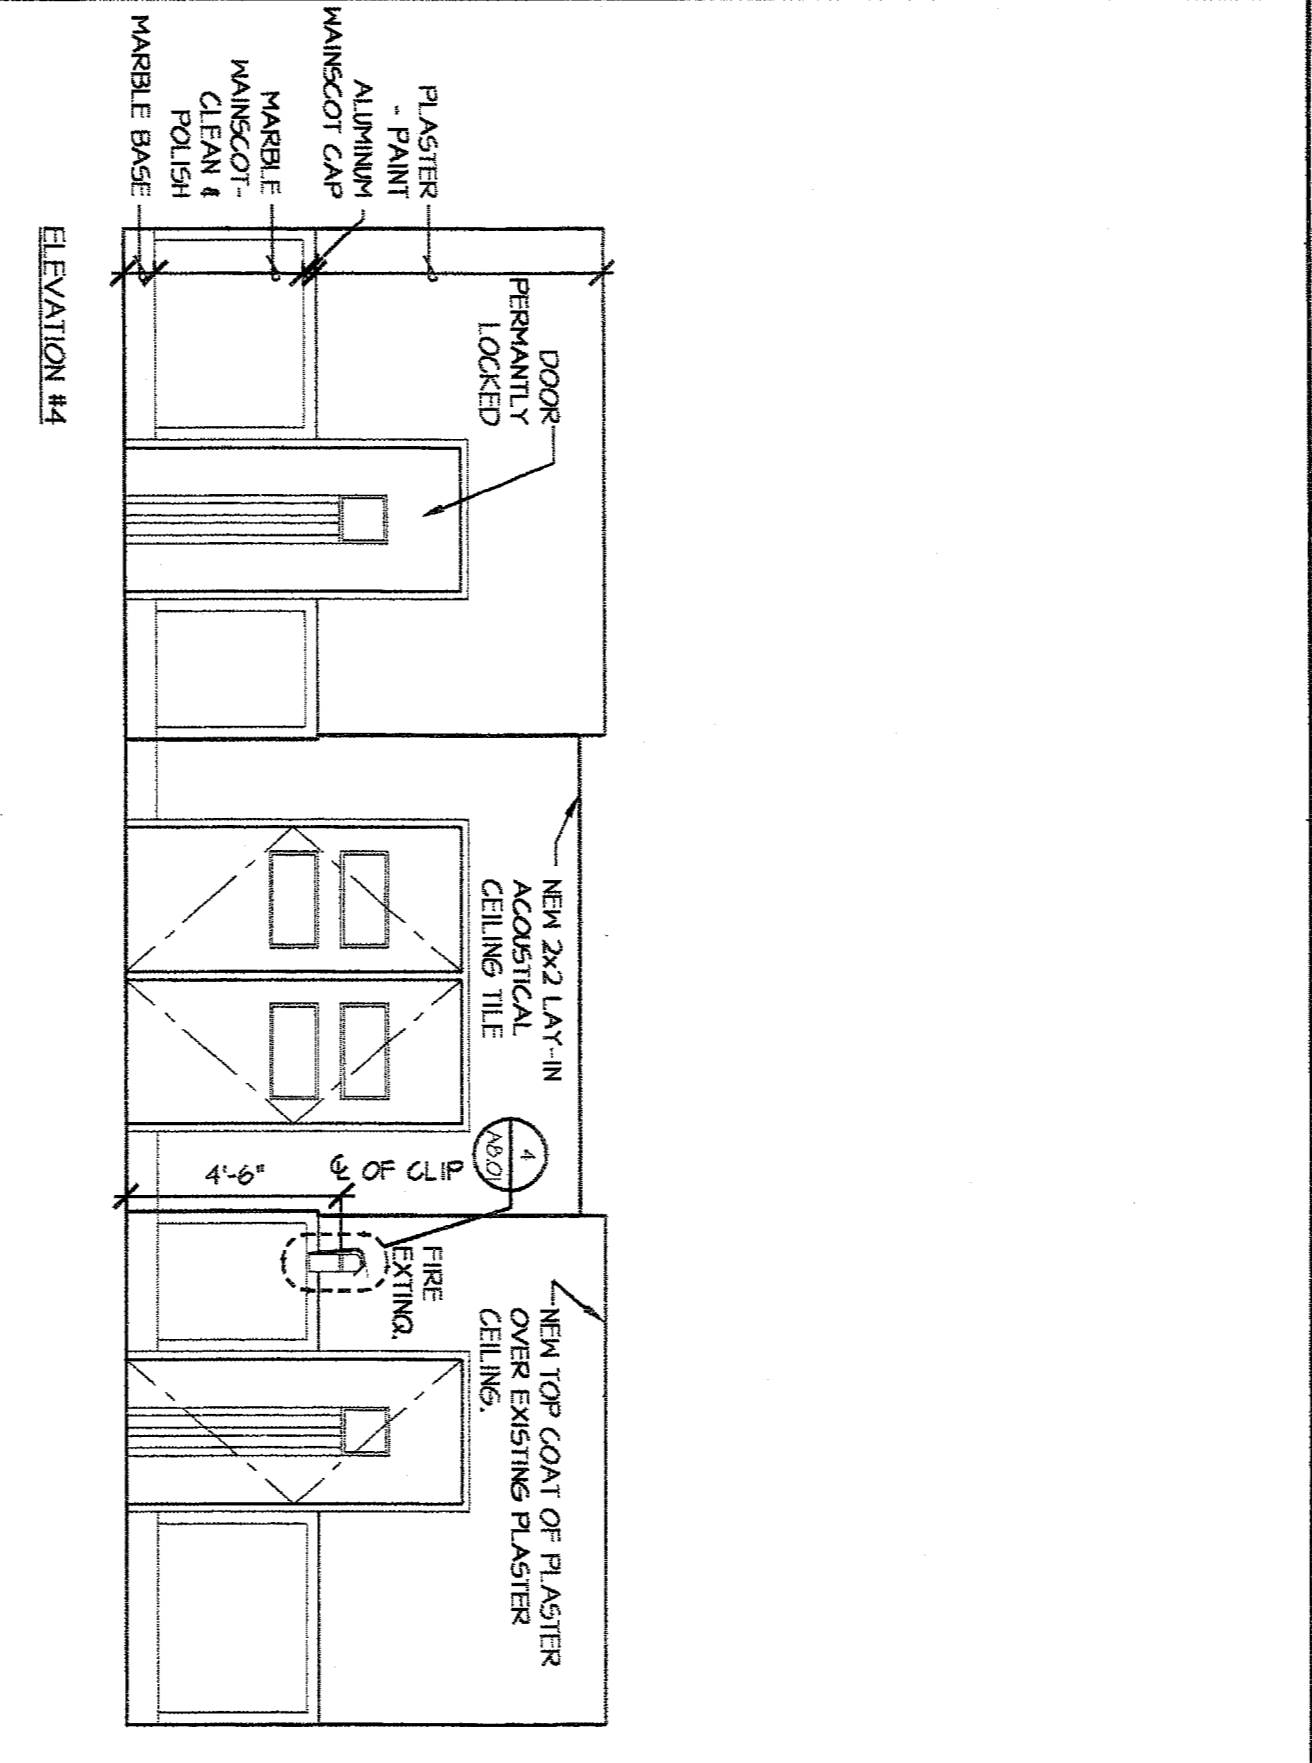


INTERIOR ELEVATION - LOBBY - 200 CONT.
SCALE: 1/4" = 1'-0"

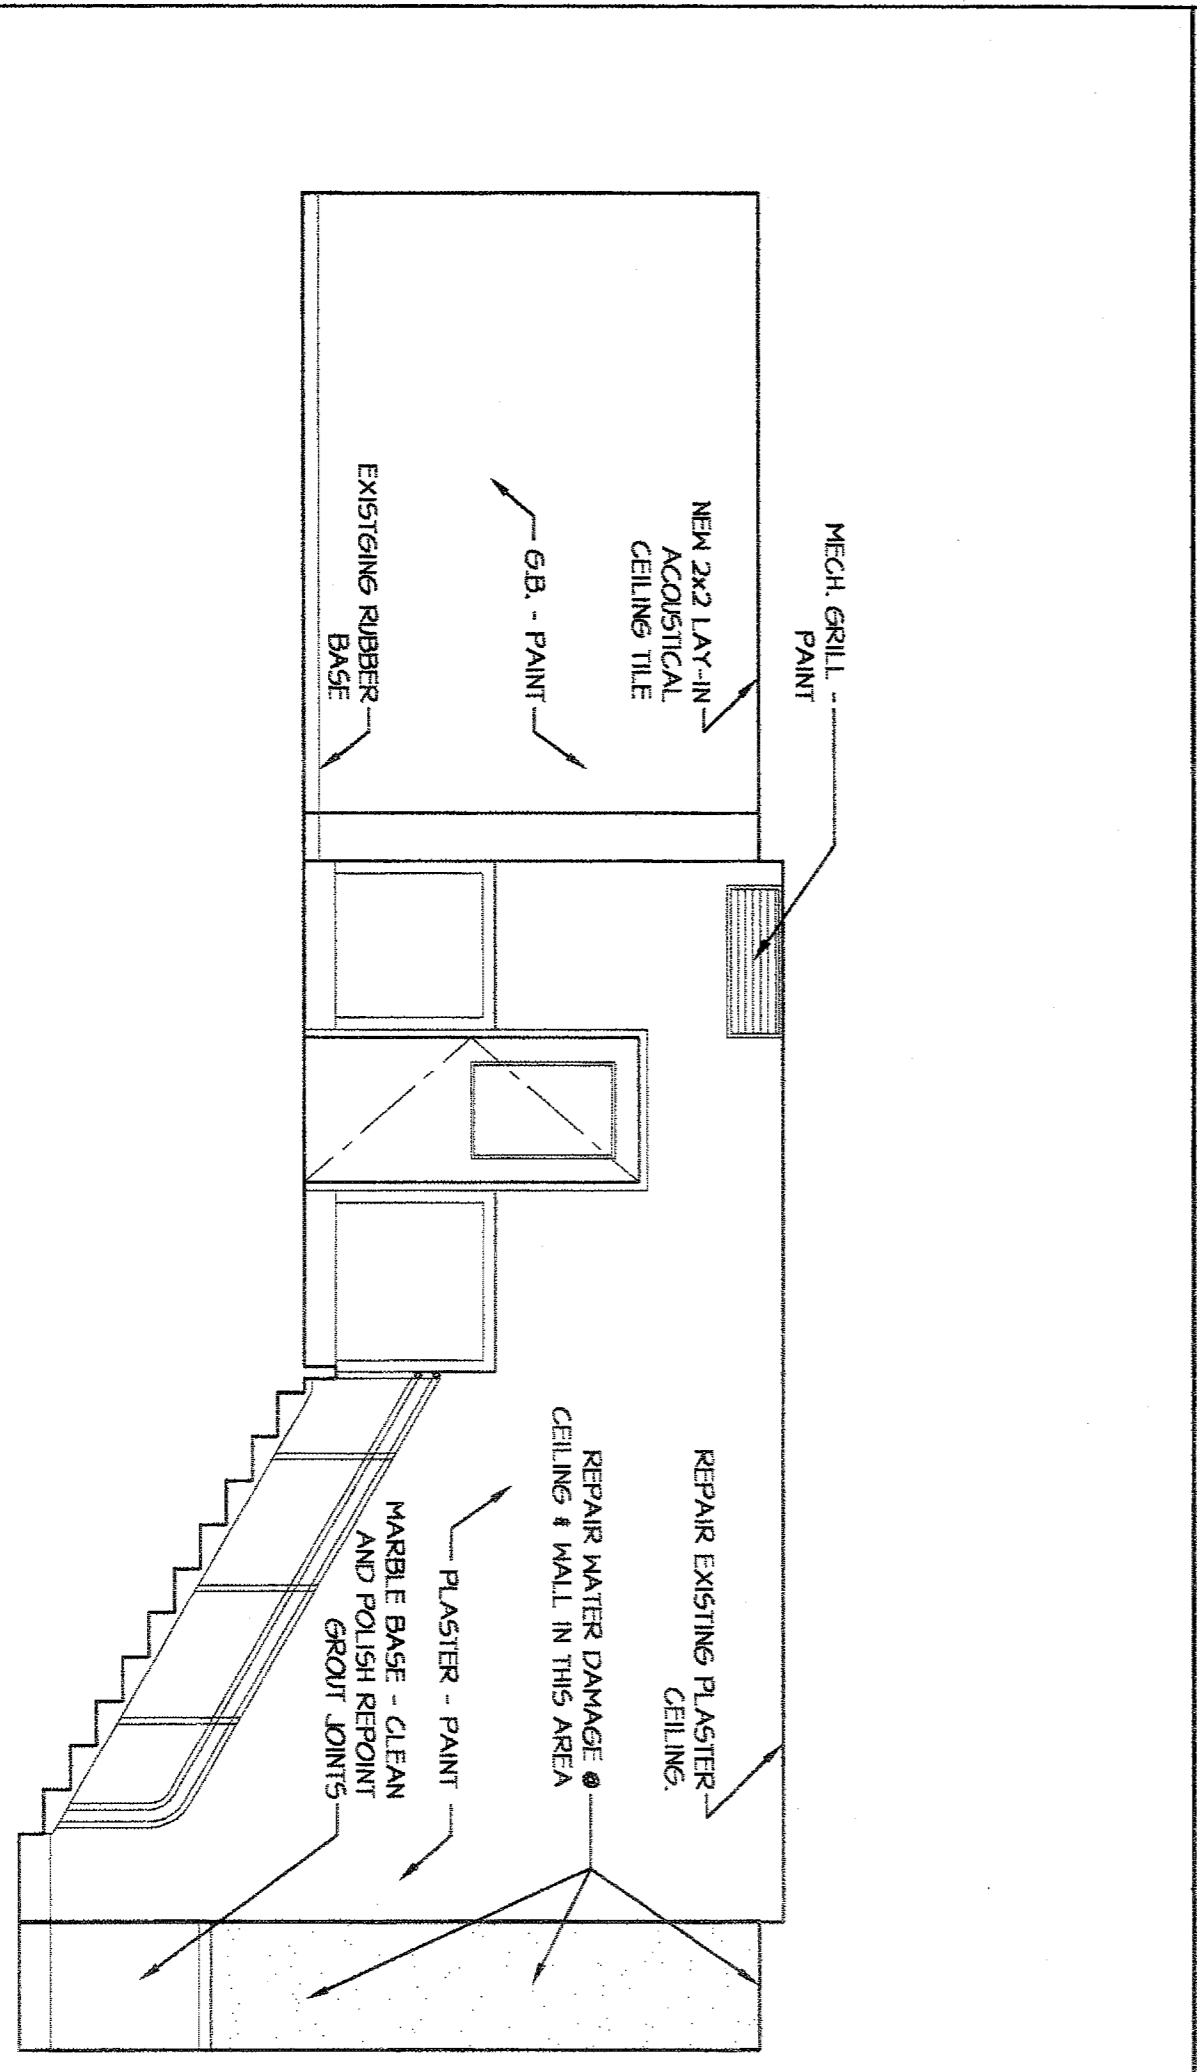

INTERIOR ELEVATION - LOBBY 200
SCALE: 1/4" = 1'-0"

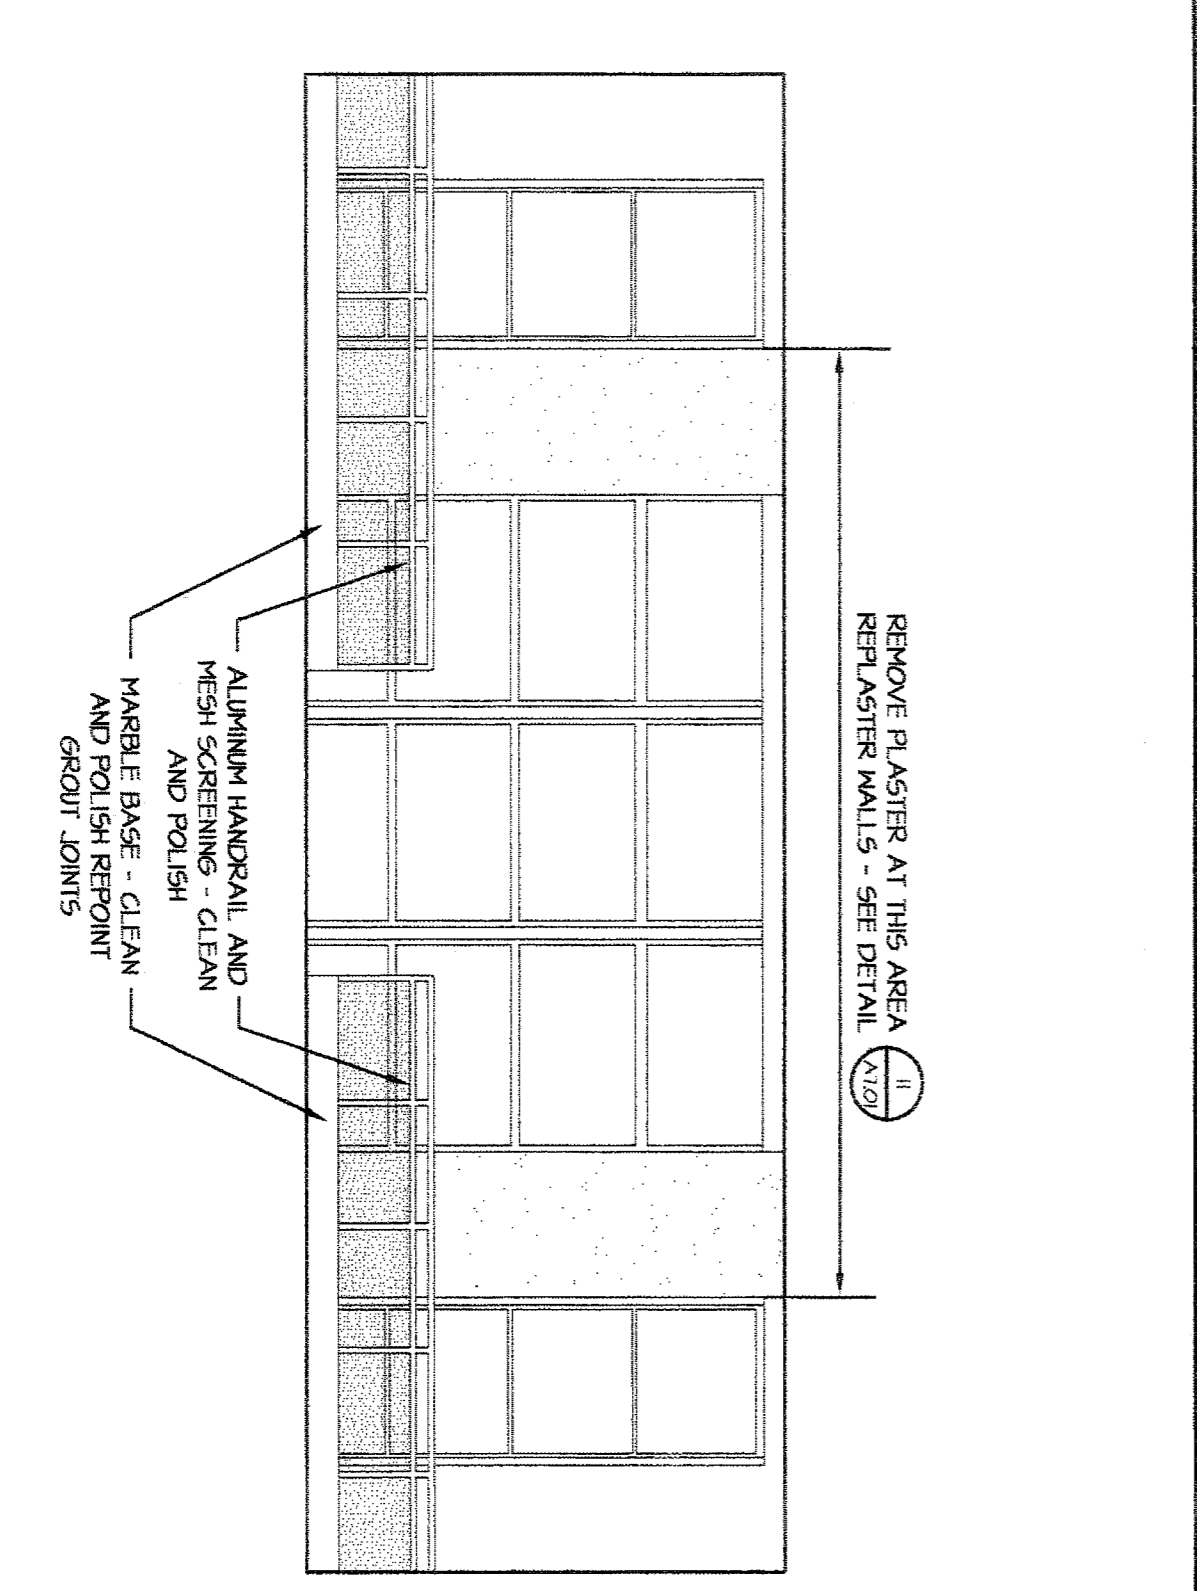

ELEVATION #2

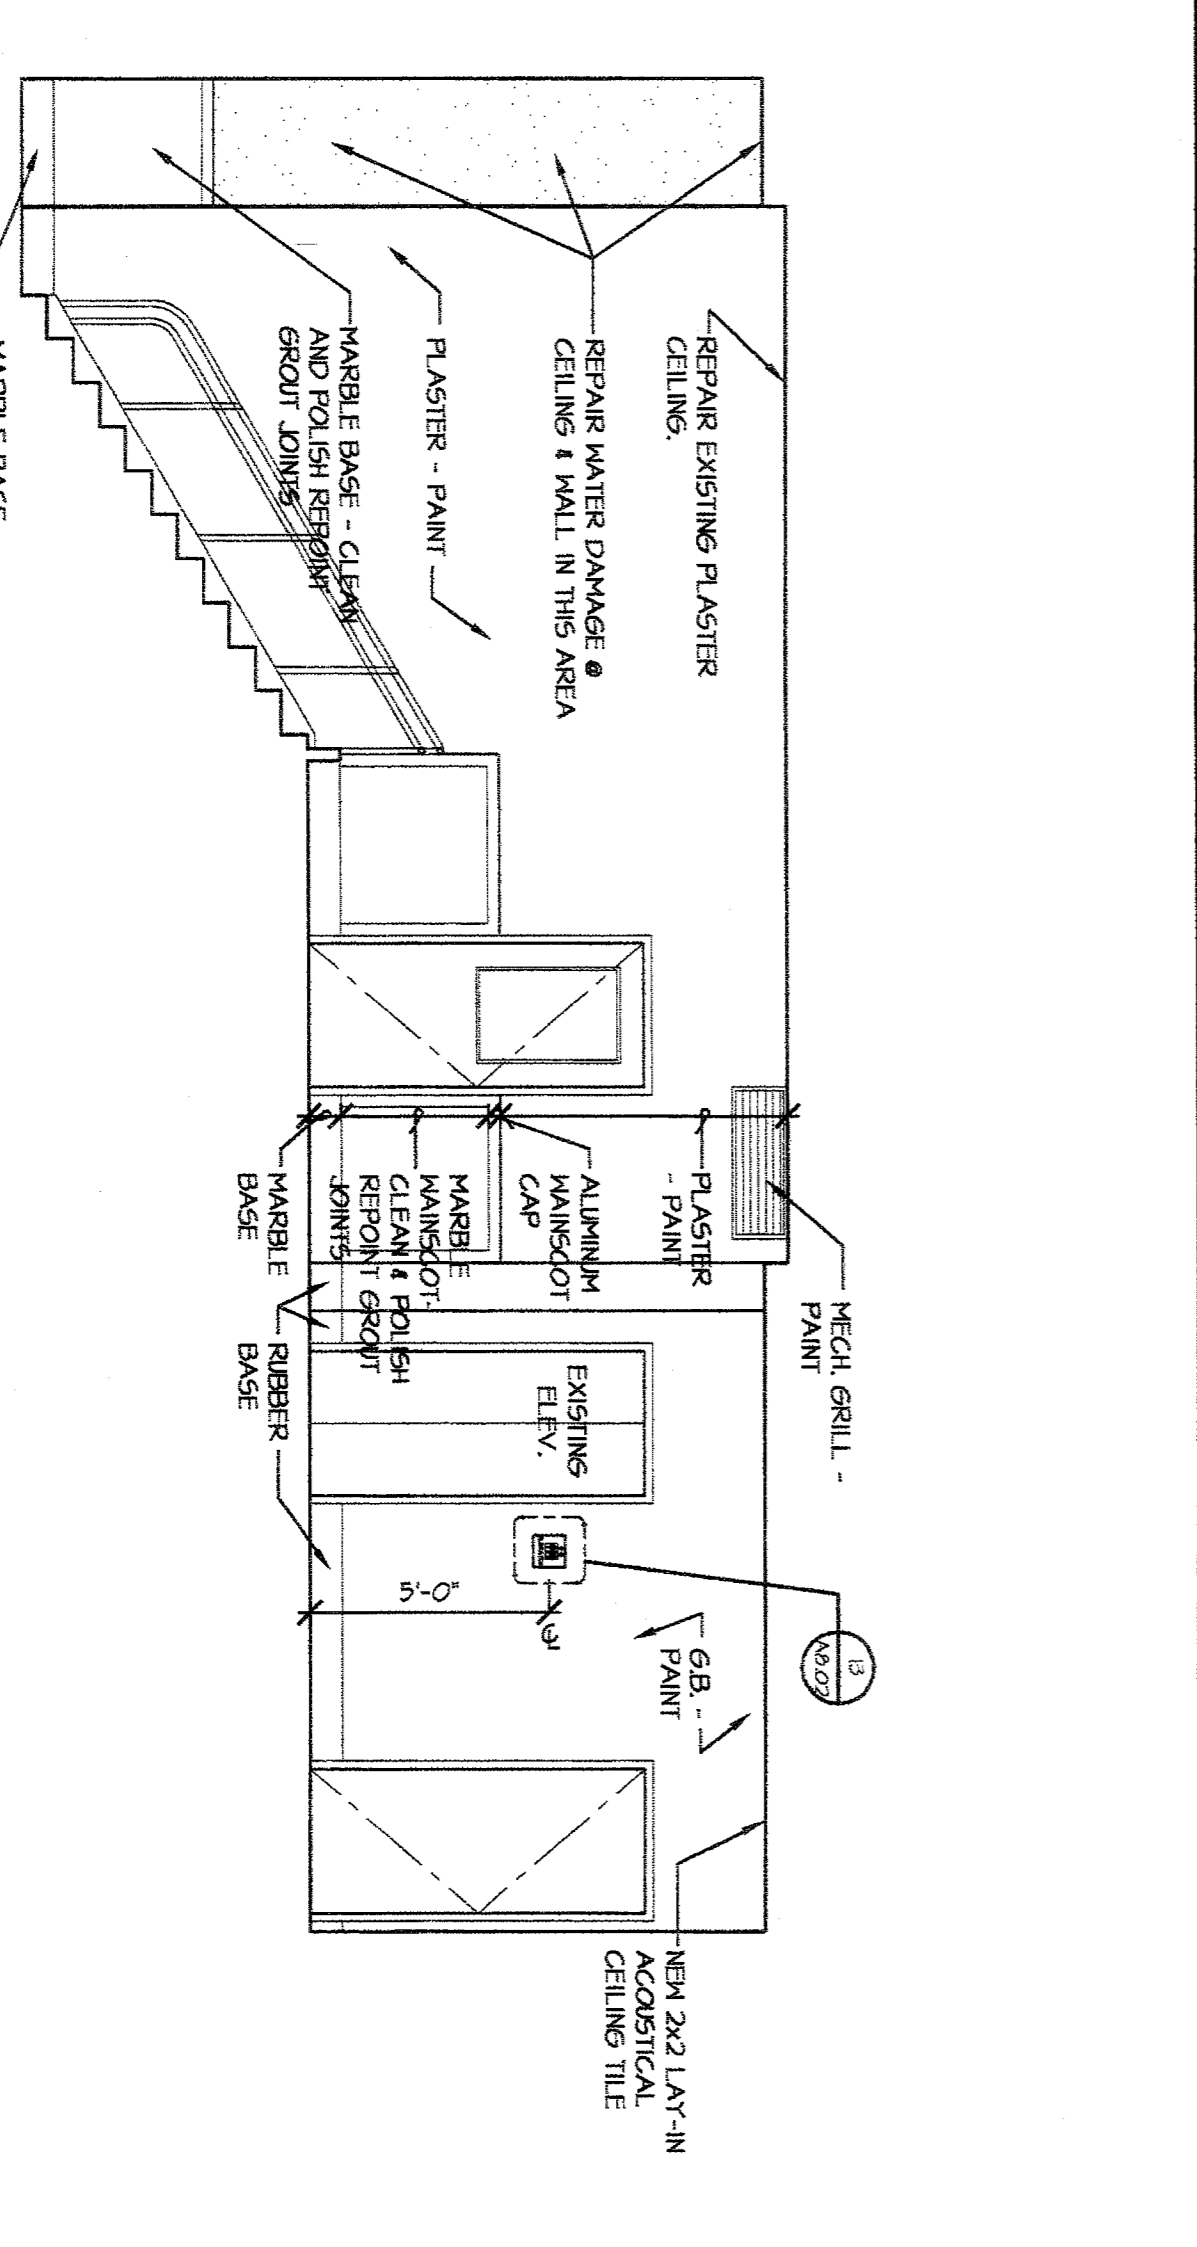

ELEVATION #3

REVISIONS

Sheet Title:
**CORRIDOR
INTERIOR
ELEVATIONS**


Project:
**BURNET
COUNTY
COURTHOUSE
BURNET, TEXAS**

11
15

HELVEN THIRTHEN ARCHITECTS INC.
807 S. ROCK STREET, 102
GROESBECK, TEXAS 78642
TEL: 512.909.1199 FAX: 512.909.1182

Date: 3/18/2002
Proj. #
Drawn by: ICB
Issued for: BID


A1.13

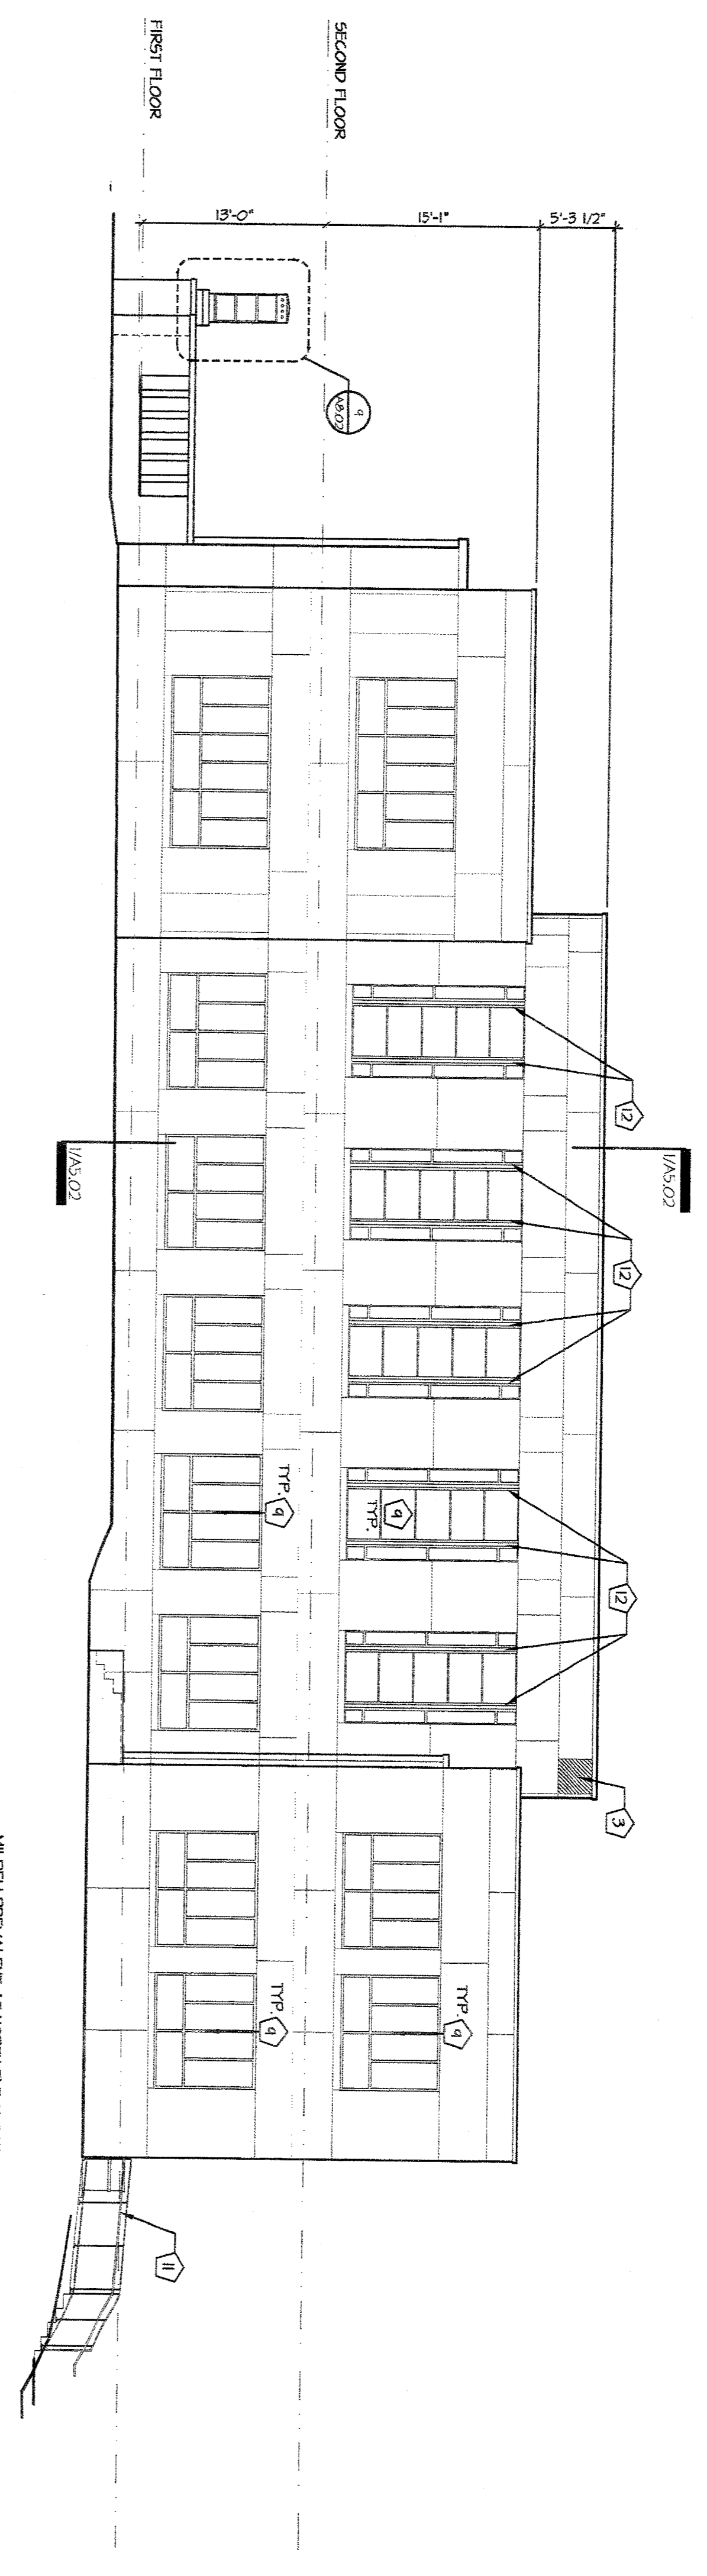

NORTH ELEVATION

SCALE: 1/8" = 1'-0"


A4.01 **3**

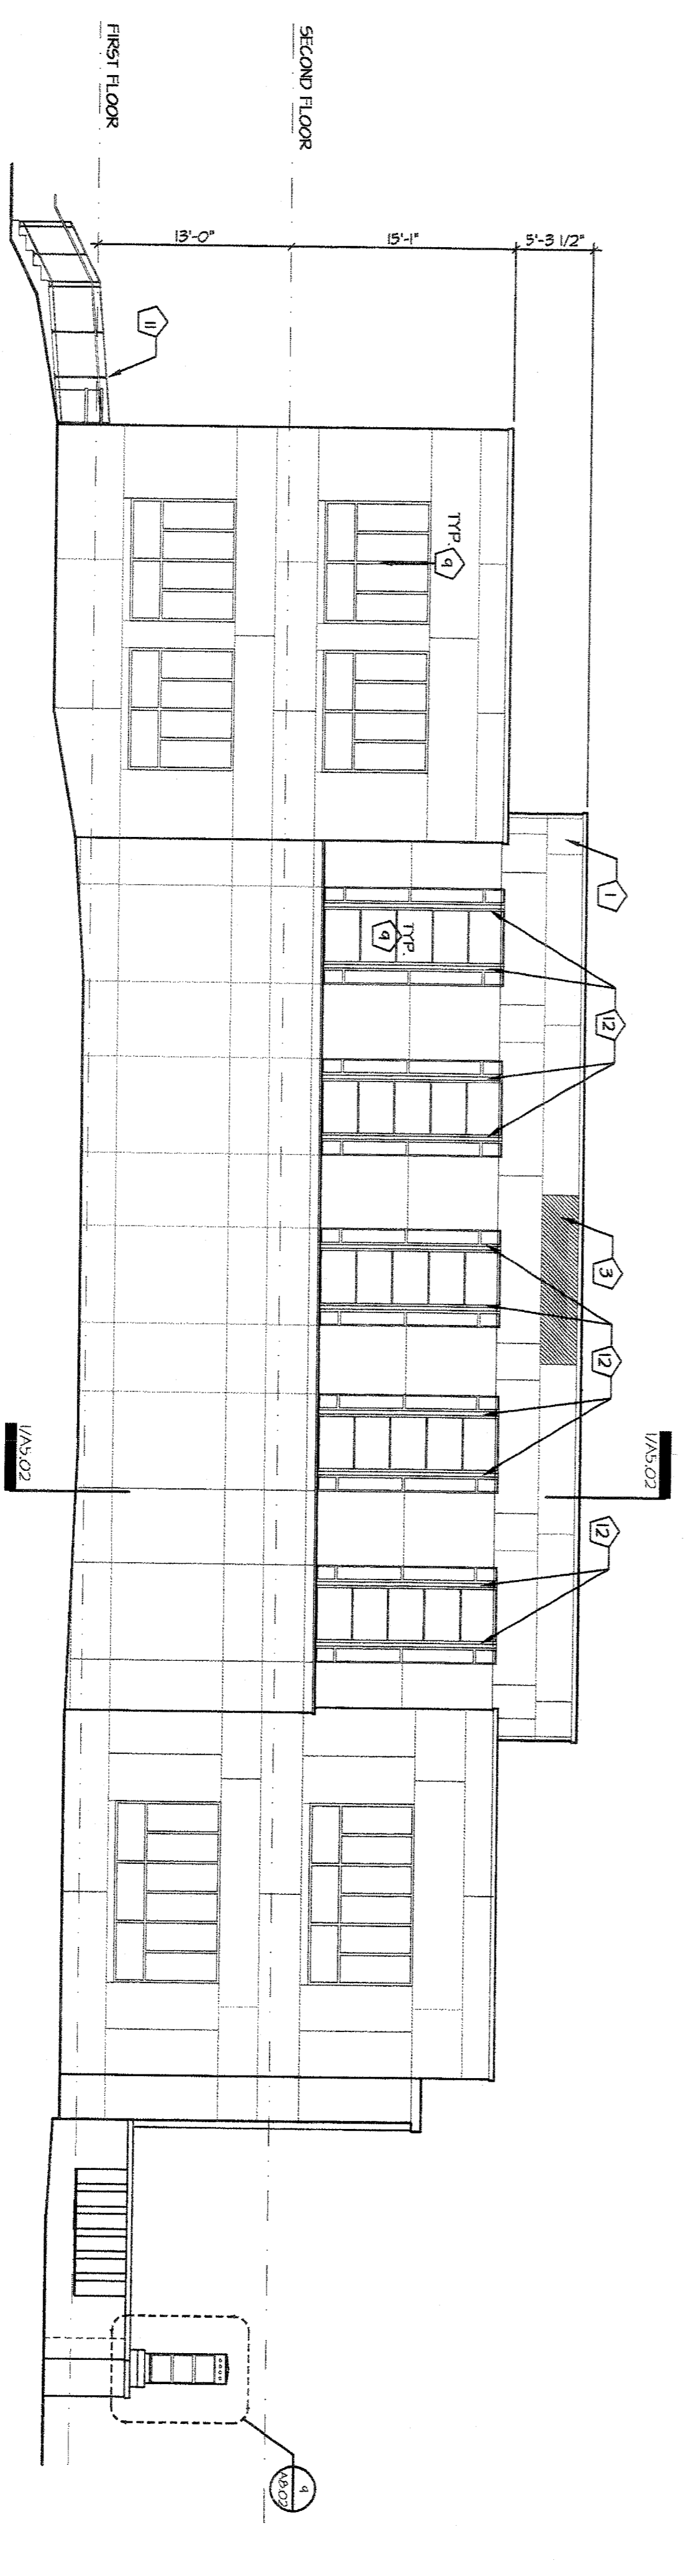

SOUTH ELEVATION

SCALE: 1/8" = 1'-0"

A4.01 **2**

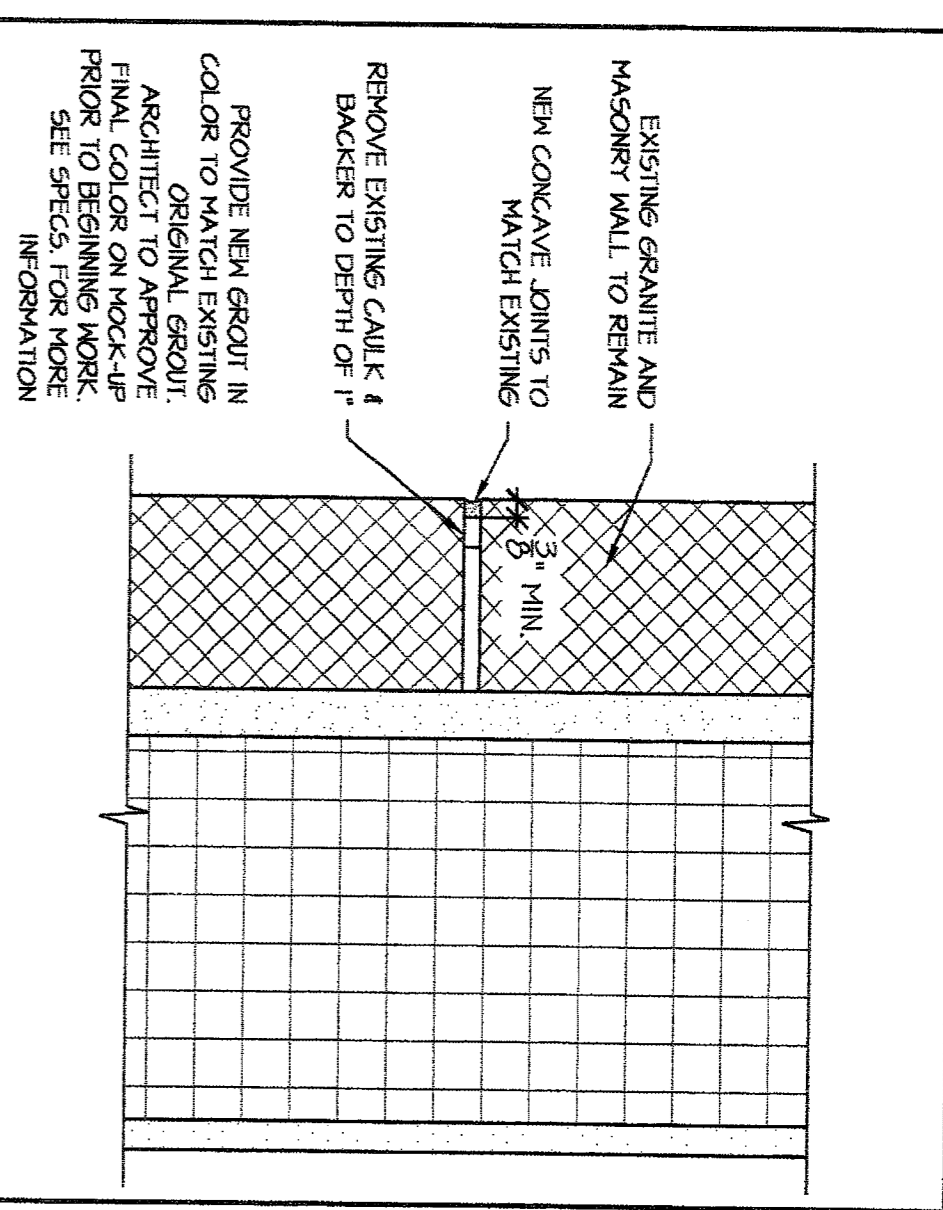

TUCK POINTING DETAIL

SCALE: 3/4" = 1'-0"

04A1001 **1**

- 1) NETIL CRACKED SECTION OF GRANITE PANEL WITH MORTAR. MORTAR COLOR AS SELECTED BY ARCHITECT.
- 2) NOT USED.
- 3) CLEAN GRANITE PANEL OF REST.
- 4) CLEAN GRANITE OF EFFLORESCENCE.
- 5) CLEAN GRANITE RELIEF PANEL.
- 6) NOT USED.
- 7) REMOVE MORTAR AT THE BASE OF THE BUILDING WHERE IT MEETS THE CONCRETE. REPLACE WITH NEW MORTAR AS SPECIFIED.
- 8) REMOVE SPALLED MORTAR AT THE BASE OF THE CONCRETE STEPS OR RAMP. REPLACE WITH NEW MORTAR AS SPECIFIED.
- 9) EXISTING STEEL WINDOWS TO BE REPAIRED AND REFINISHED AS REQUIRED - SEE WINDOW SCHEDULES ON SHEETS D410 AND D411. PAINT ALL STEEL LINTELS ABOVE WINDOWS.
- 10) NEW DOORS - SEE DOOR SCHEDULE ON SHEET A110.
- 11) NEW ALUMINUM HANDRAIL - SEE O1A/B.01.
- 12) CLEAN ALUMINUM HALF-ROUND MULLIONS WITH A NON-ABRASIVE CLEANER AND SOFT BRISTLE BRUSH. CAULK THE TOPS & SIDES. REMOVE AT NORTH ELEVATION. CLEAN INSIDE AND OUT AND REINSTALL.
- 13) CLEAN AND PAINT EXISTING HANDRAIL.


KEYNOTES - ACTION ITEMS

ELEV KEYS

GENERAL NOTES:

1. CLEAN ALL GRANITE ON BUILDING OF DIRT AND MILDEN USING WATER, MILD DETERGENT AND A BRISTLE BRUSH. SEE SPECIFICATIONS FOR ADDITIONAL CLEANING INFORMATION.

2. REMOVE CAULKING AT ALL GRANITE JOINTS AND BACKER MATERIAL TO 1" BELOW THE SURFACE. CLEAN WITH A NON-ABRASIVE CLEANER. REPLACE ALL JOINTS WITH MORTAR MIX AS SPECIFIED. RE: 04A101.

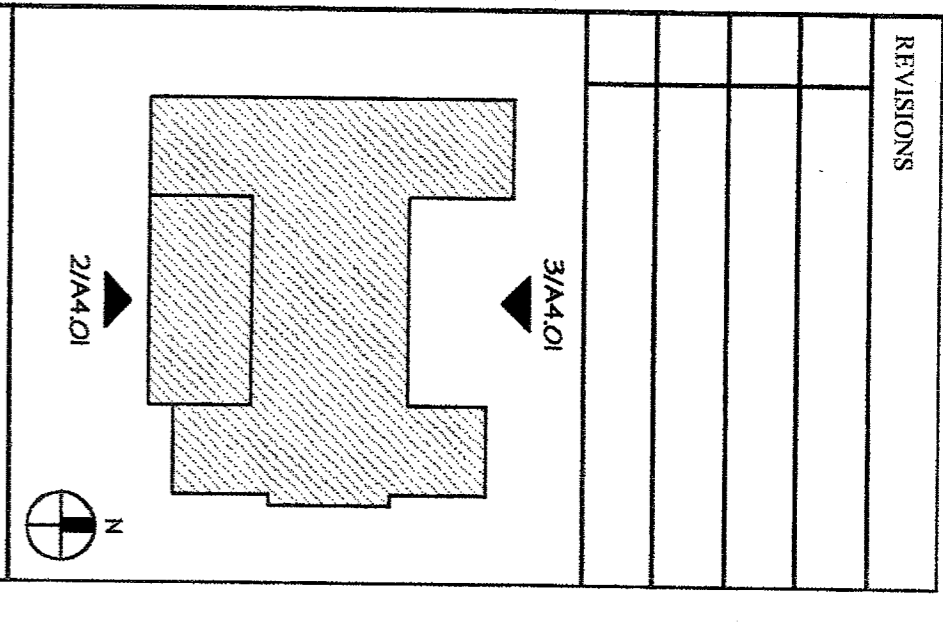

KEY PLAN

Sheet Title:
NORTH AND SOUTH ELEVATIONS


Project:
BURNET COUNTY COURTHOUSE
BURNET, TEXAS

11

BEVON THURBER ARCHITECTS INC.
107 W. WASHINGTON
GEORGETOWN, TEXAS 78636
TEL 512.869.1104 FAX 512.869.1362

Date: 03/18/2002
Drawn by: LCB
Issued for: BJD

A4.01

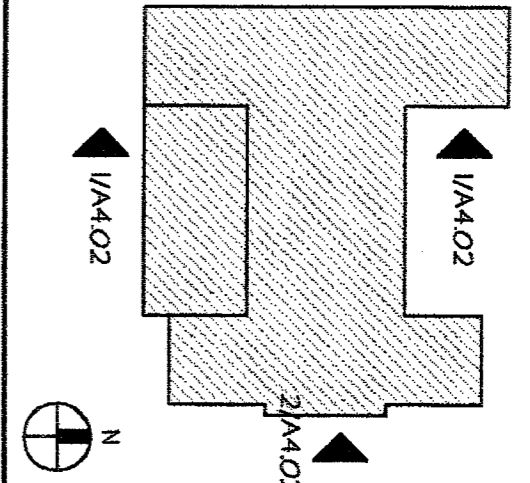

KEY PLAN

Sheet Title:
EAST ELEVATIONS

Project:
BURNET COUNTY COURTHOUSE
BURNET, TEXAS

11/13

BEVERN THURBERN ARCHITECTS INC.
807 S. ROCK, SUITE 102
GROESBECK, TEXAS 78656
TEL: 512.869.1104 FAX: 512.869.1182

Date: 03/18/2002
Drawn by: LCB
Issued for: BID


Sheet #
A4.02

EAST ELEVATION

SCALE: 1/8" = 1'-0"

AA-01

2

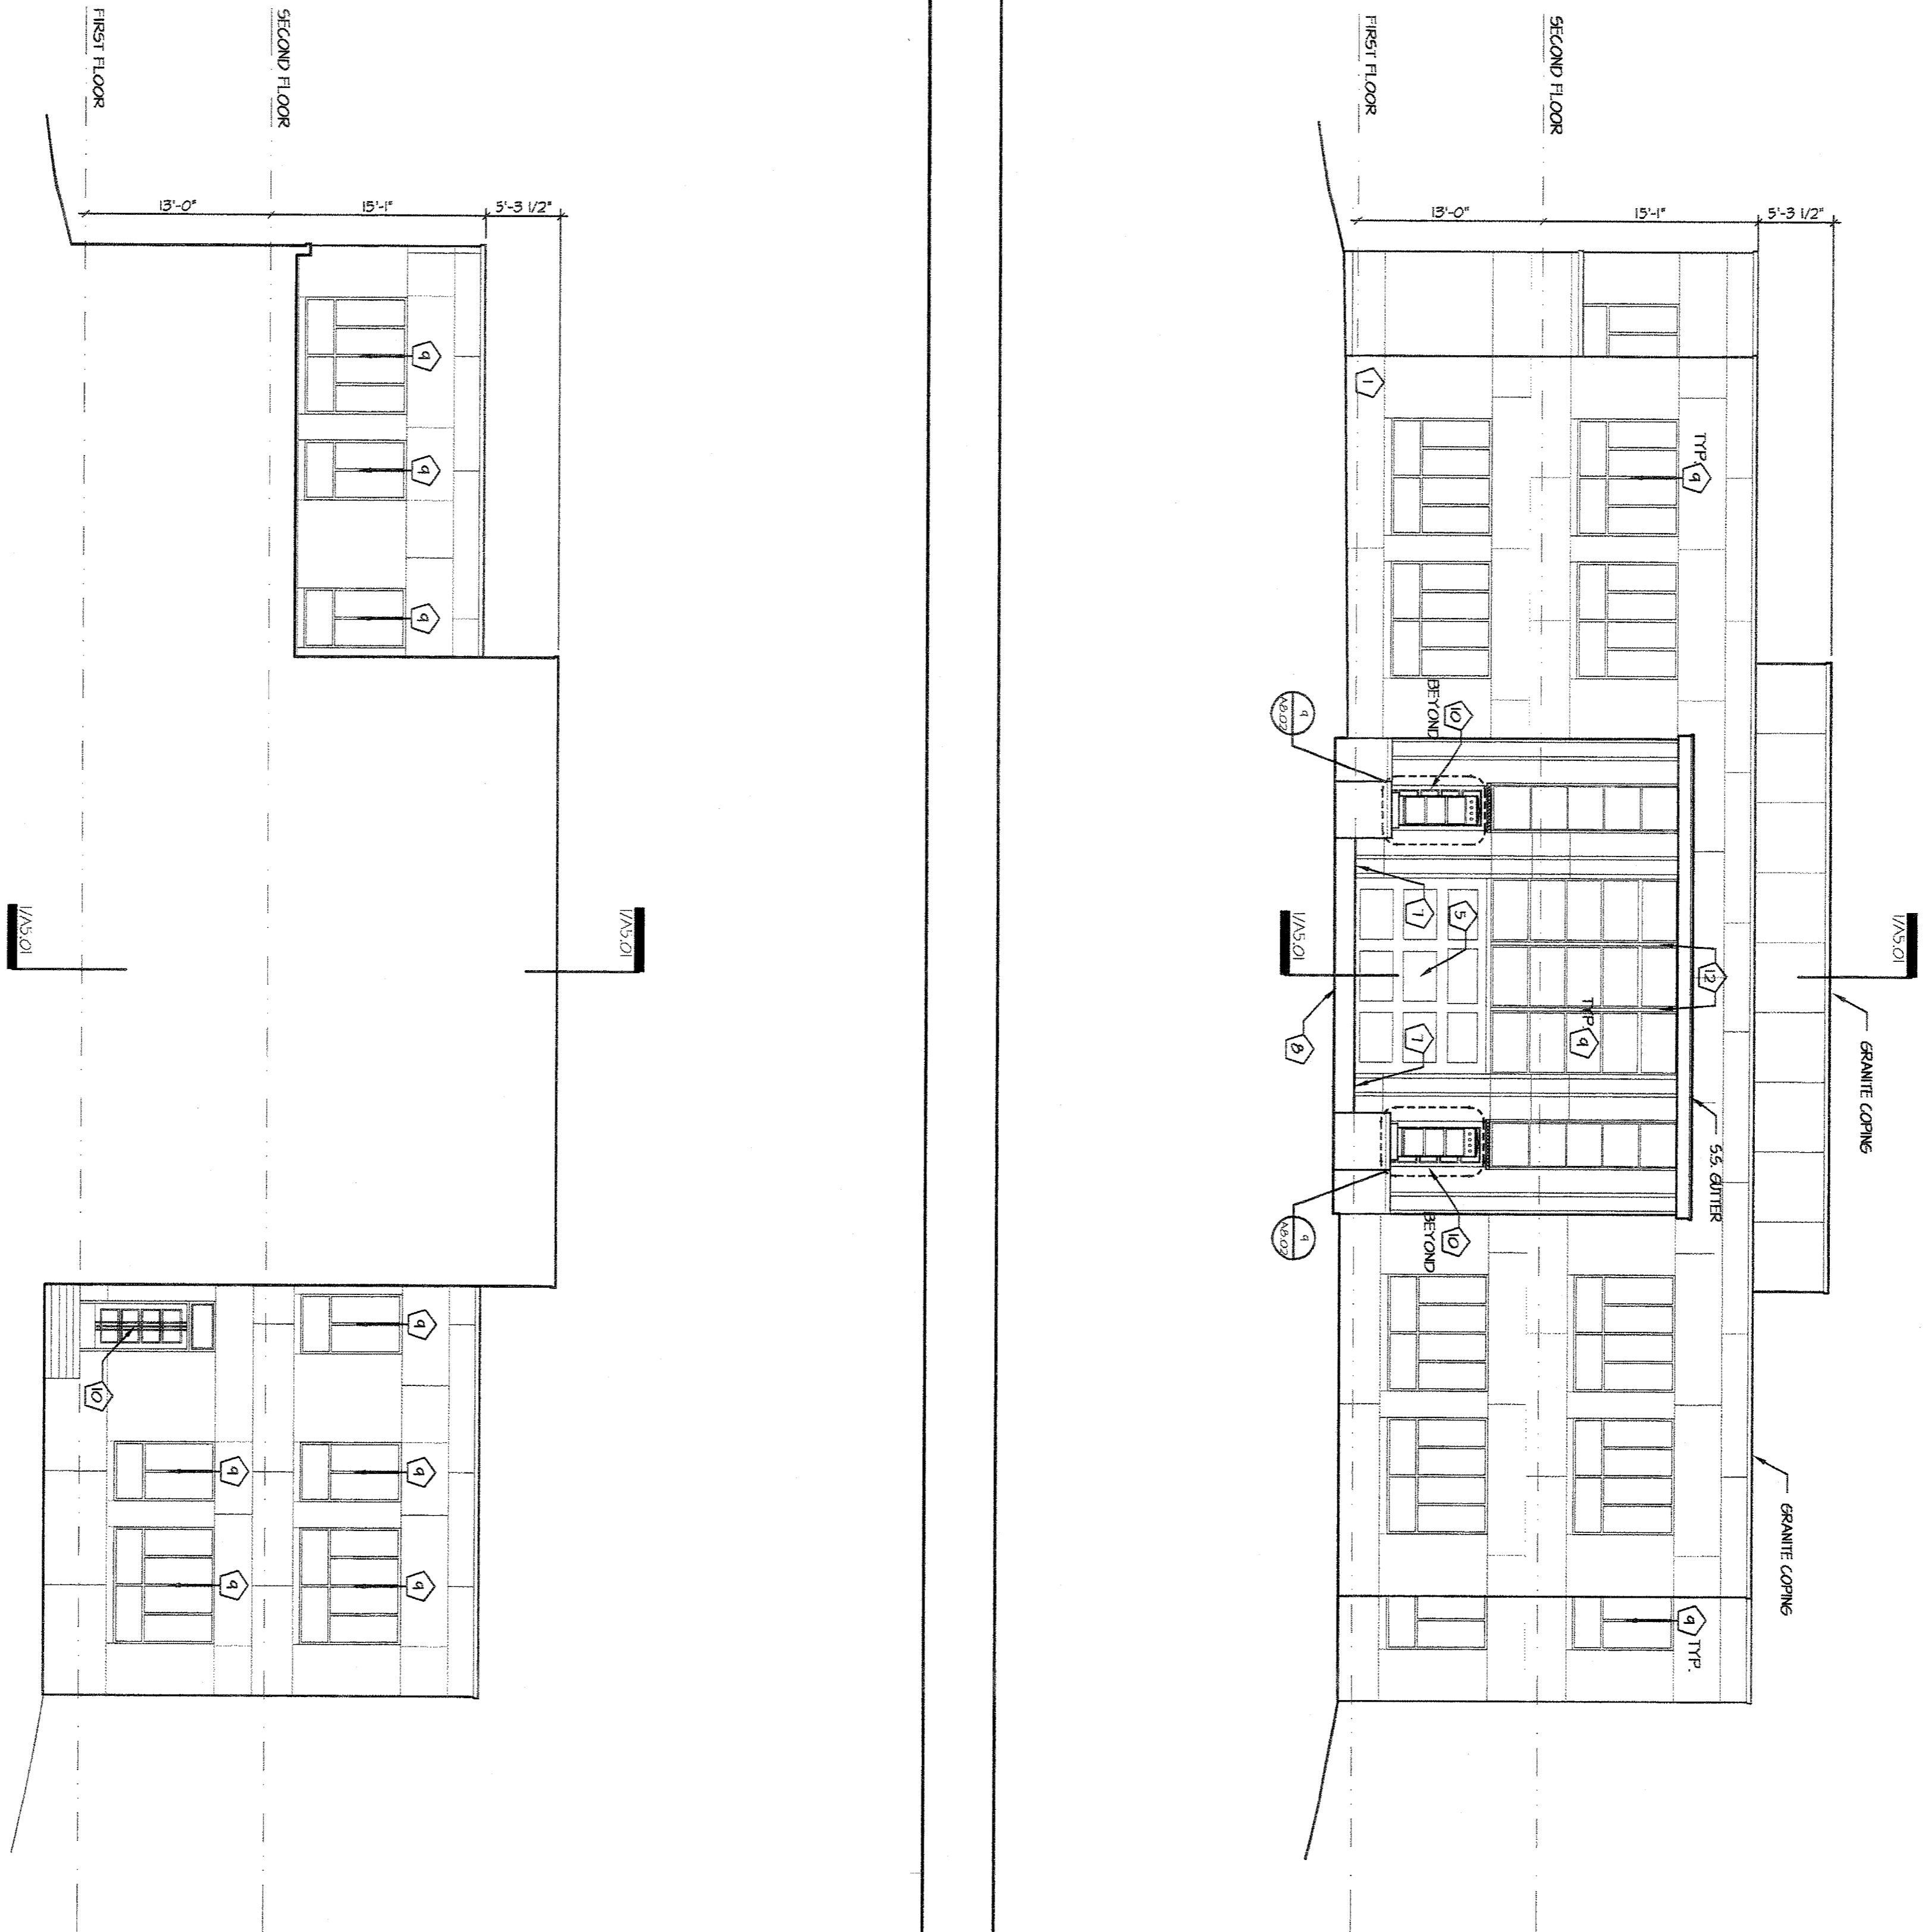

1) NETIL GRACKED SECTION OF GRANITE PANEL WITH MORTAR. MORTAR COLOR AS SELECTED BY ARCHITECT.

2) NOT USED

3) CLEAN GRANITE PANEL OF ROST.

4) CLEAN GRANITE OF EFFLORESCENCE.

5) CLEAN GRANITE RELIEF PANEL.

6) NOT USED.

7) REMOVE MORTAR AT THE BASE OF THE BUILDING WHERE IT MEETS THE CONCRETE. REPLACE WITH NEW MORTAR AS SPECIFIED.

8) REMOVE SPALLED MORTAR AT THE BASE OF THE CONCRETE STEPS OR RAMP. REPLACE WITH NEW SILICONE JOINT - COLOR TO BE APPROVED BY ARCHITECT.

9) EXISTING STEEL WINDOWS TO BE REPAIRED AND REFINISHED AS REQUIRED - SEE WINDOW SCHEDULES ON SHEETS DA10 AND DA11. PAINT ALL STEEL LINTELS ABOVE WINDOWS.

10) NEW DOORS - SEE DOOR SCHEDULE ON SHEET A110

11) NEW ALUMINUM HANDRAIL - SEE Q1A/B/C1

12) CLEAN ALUMINUM HALF-ROUND MULLIONS WITH A NON-ABRASIVE CLEANER AND CLEAN INSIDE AND OUT. REMOVE AT NORTH ELEVATION.

13) CLEAN AND PAINT EXISTING HANDRAIL.

GENERAL NOTES:

1. CLEAN ALL GRANITE ON BUILDING OF DIRT AND MILDEN USING WATER, MILD DETERGENT, AND A BRISTLE BRUSH. SEE SPECIFICATIONS FOR ADDITIONAL CLEANING INFORMATION.

2. REMOVE CALLINGS AT ALL GRANITE JOINTS AND BACKER MATERIAL TO 1" BELOW THE SURFACE. CLEAN JOINTS WITH A NON-ABRASIVE CLEANER. REPLACE ALL JOINTS WITH MORTAR MIX AS SPECIFIED. RE: I/A4.01

EAST ELEVATION


SCALE: 1/8" = 1'-0"

AA-01

1

KEYNOTES - ACTION ITEMS


ELEV KEYS

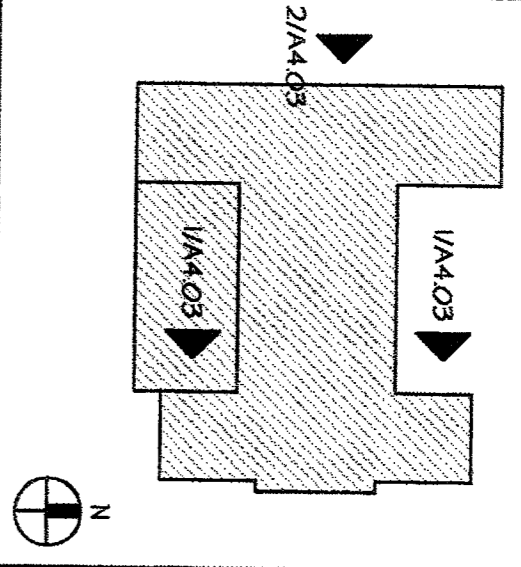

KEY PLAN

WEST ELEVATION

SCALE: 1/8" = 1'-0"

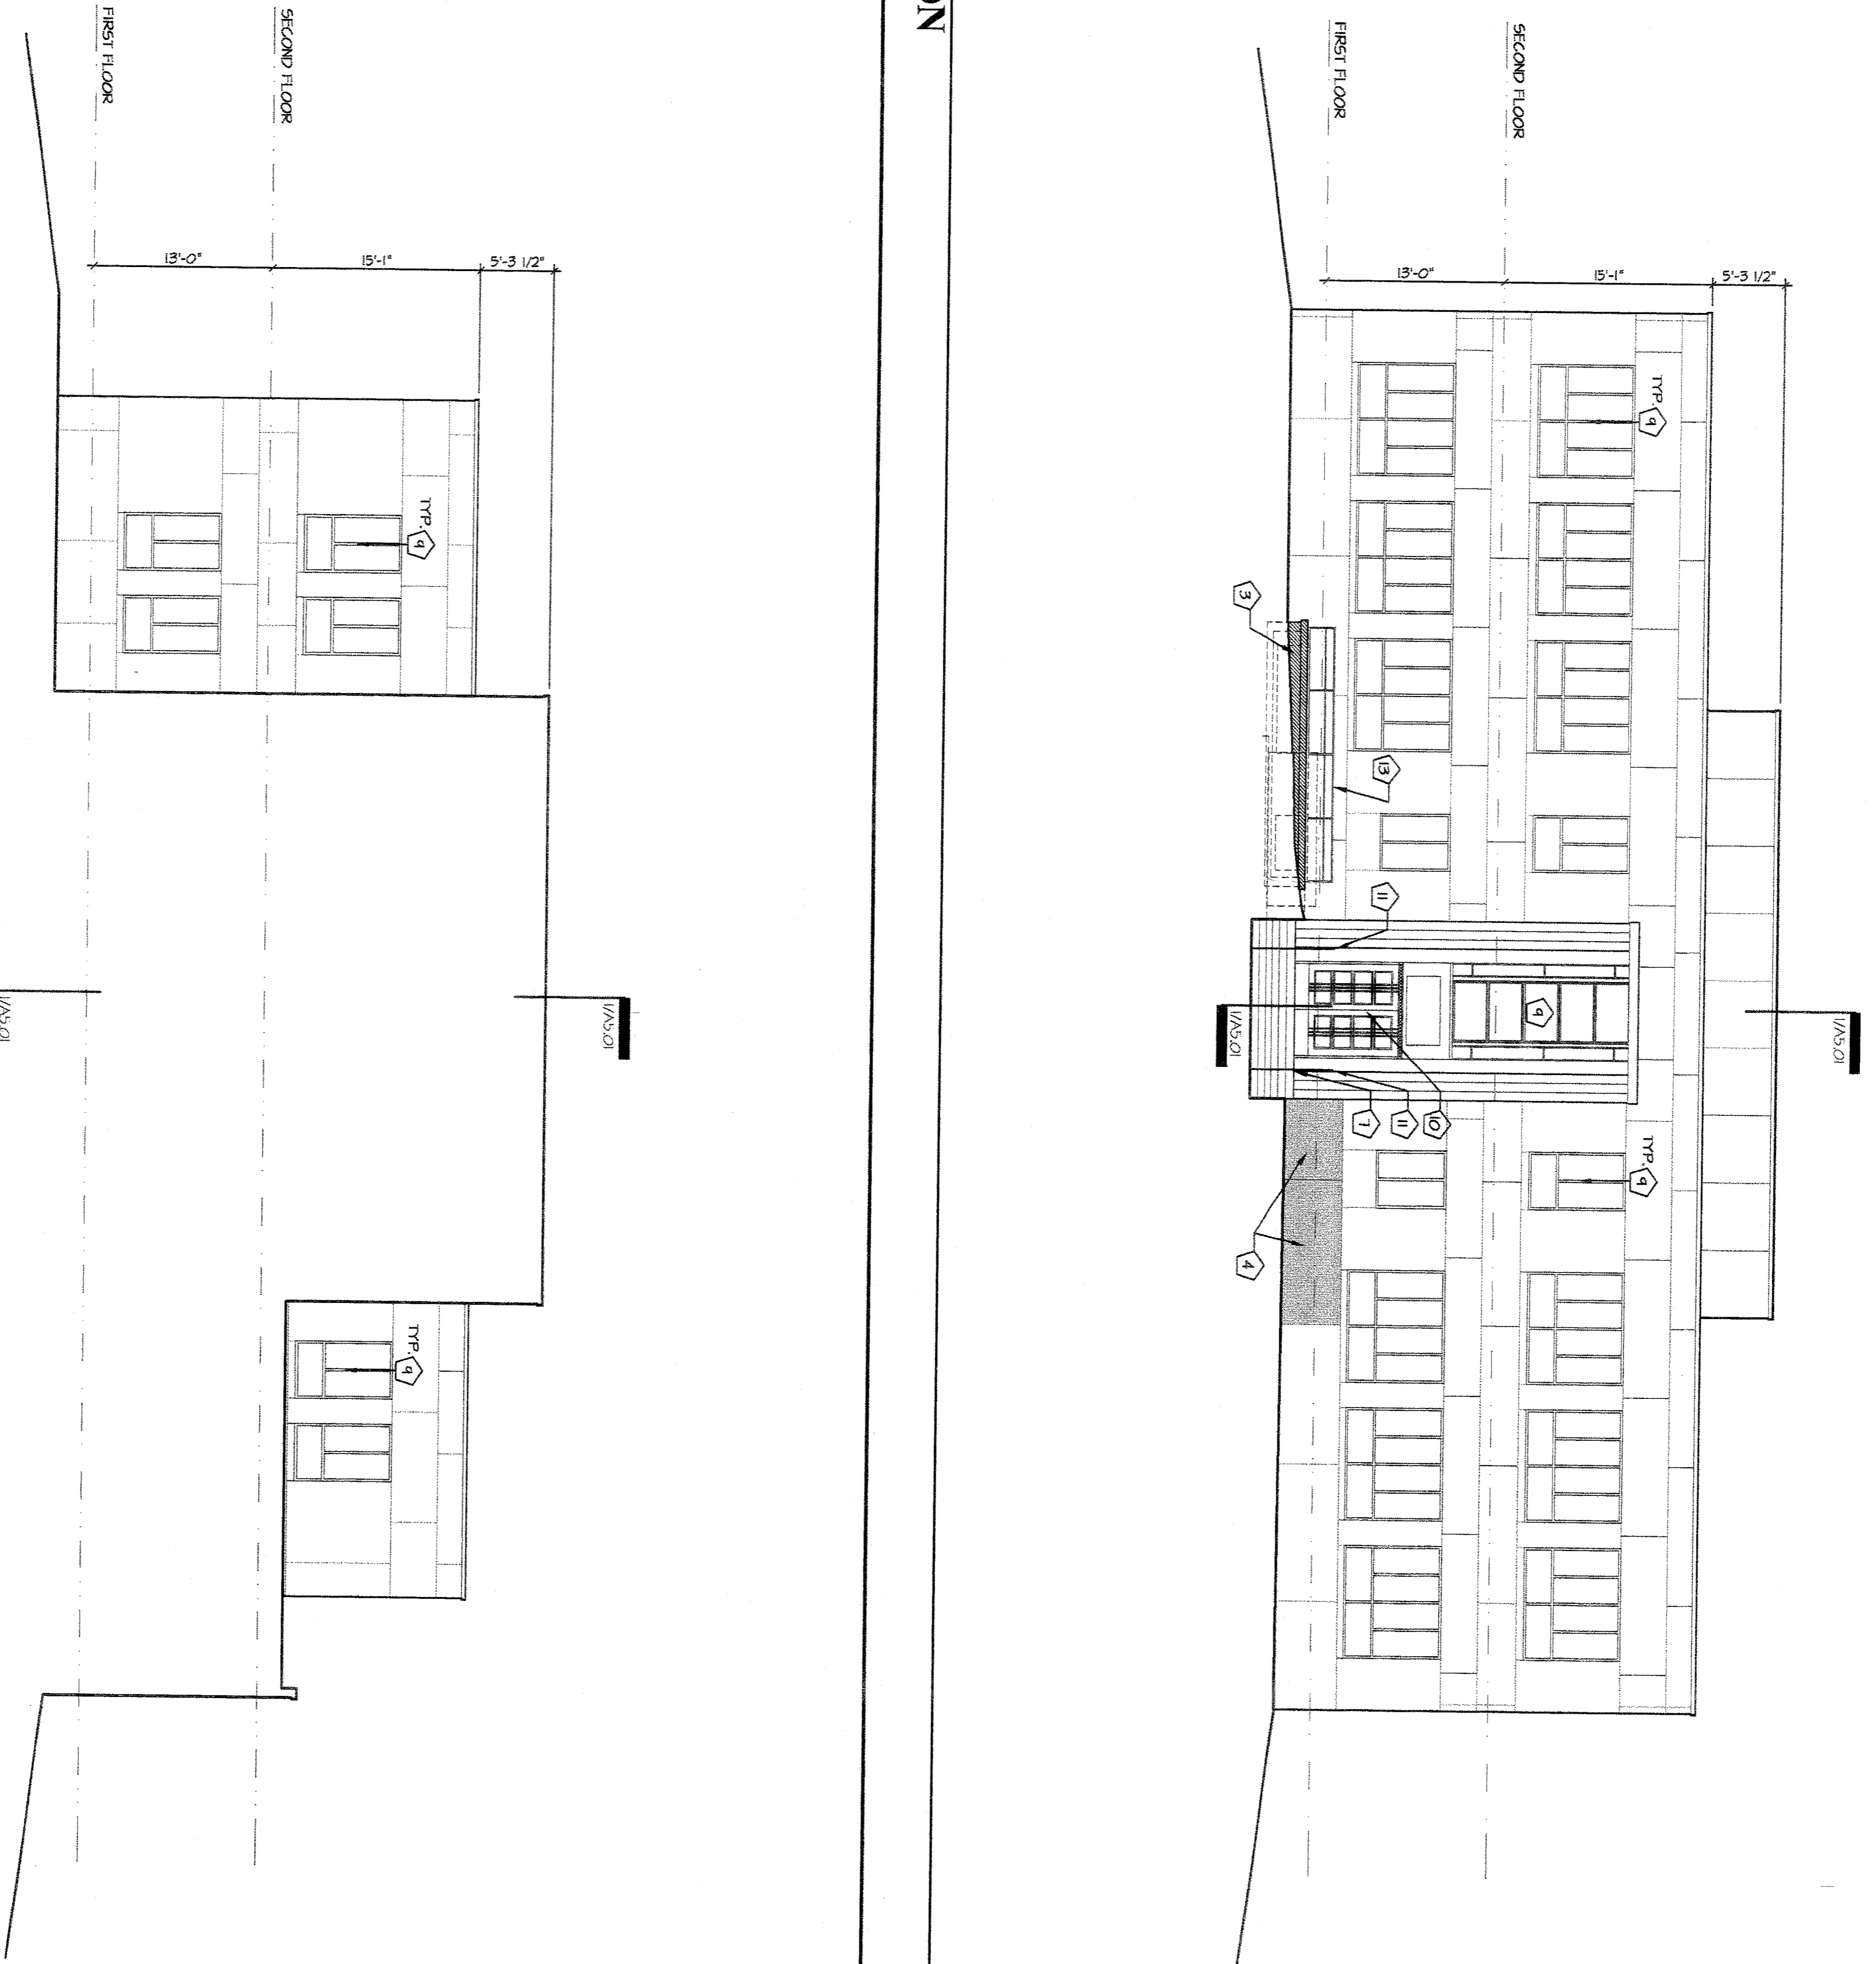

A4.01
2

- 1 INT'L GRACKED SECTION OF GRANITE PANEL WITH MORTAR. MORTAR COLOR AS SELECTED BY ARCHITECT.
- 2 NOT USED
- 3 CLEAN GRANITE PANEL OF FIRST.
- 4 CLEAN GRANITE OF EFFLORESCENCE.
- 5 CLEAN GRANITE RELIEF PANEL.
- 6 NOT USED.
- 7 REMOVE MORTAR AT THE BASE OF THE BUILDING WHERE IT MEETS THE CONCRETE. REPLACE WITH NEW MORTAR AS SPECIFIED.
- 8 REMOVE SPALLED MORTAR AT THE BASE OF THE CONCRETE STEPS OR RAMP. REPLACE WITH NEW SILICONE JOINT - COLOR TO BE APPROVED BY ARCHITECT.
- 9 EXISTING STEEL WINDOWS TO BE REPAIRED AND RETIRED AS REQUIRED - SEE WINDOW SCHEDULES ON SHEETS DA10 AND DA11. PAINT ALL STEEL LINTELS ABOVE NEW DOORS - SEE DOOR SCHEDULE ON SHEET A110
- 10 NEW DOORS - SEE DOOR SCHEDULE ON SHEET A110
- 11 NEW ALUMINUM HANDRAIL - SEE Q1/A301
- 12 CLEAN ALUMINUM HALF-ROUND MELLONS WITH A NON-ABRASIVE CLEANER AND CLEAN INSIDE AND OUT AND REFINISH.
- 13 CLEAN AND PAINT EXISTING HANDRAIL.


GENERAL NOTES:

1. CLEAN ALL GRANITE ON BUILDING OF DIRT AND MILDEN USING WATER, MILD DETERGENT, AND A BRISTLE BRUSH. SEE SPECIFICATIONS FOR ADDITIONAL CLEANING INFORMATION.

2. REMOVE CAULKING AT ALL GRANITE JOINTS AND BACKER MATERIAL TO 1" BELOW THE SURFACE. CLEAN JOINTS WITH A NON-ABRASIVE CLEANER. REFACE ALL JOINTS WITH MORTAR MIX AS SPECIFIED. RE: 1/4A401

WEST ELEVATION

SCALE: 1/8" = 1'-0"

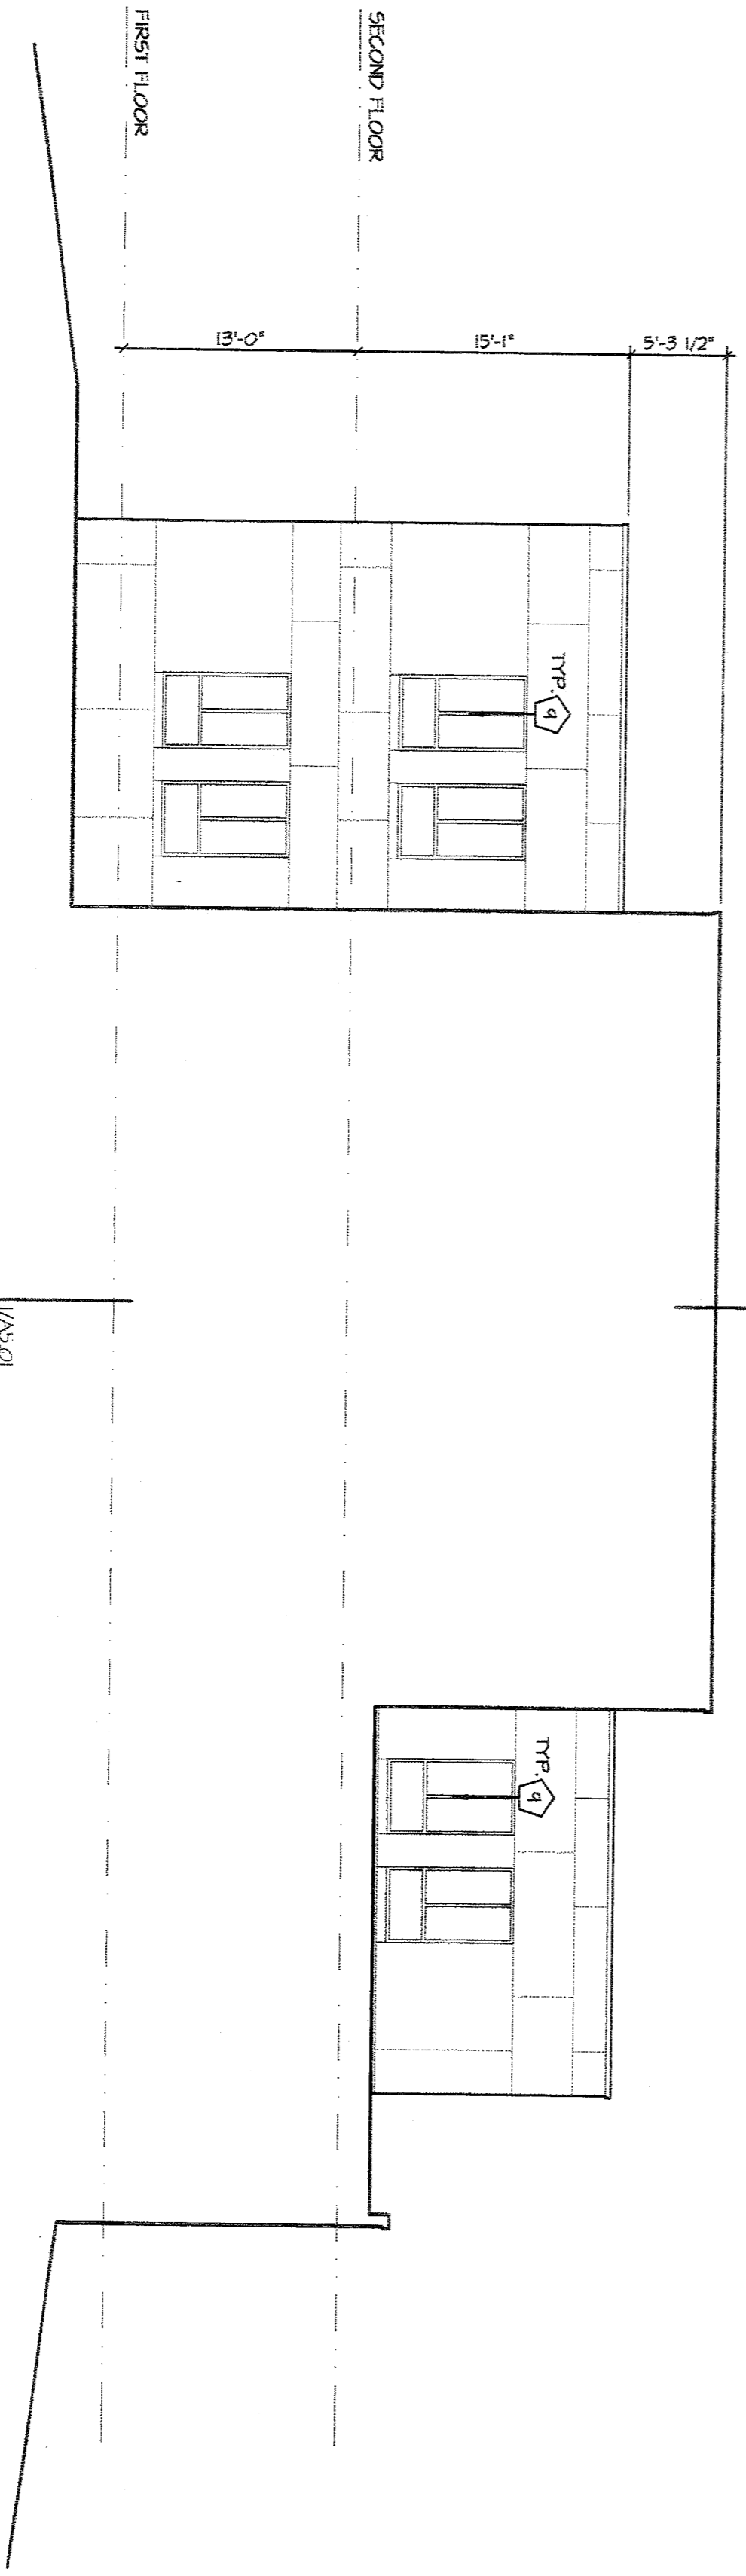

A4.01
1

KEYNOTES - ACTION ITEMS

ELEV KEYS

Sheet Title:
WEST ELEVATIONS

Project:
BURNET COUNTY COURTHOUSE
BURNET, TEXAS


11

BEYEN THOMPSON ARCHITECTS INC.
807 S. ROCK STREET 102
GEOURGETOWN, TEXAS 78626
TEL: 512.899.1104 FAX: 512.899.1182

Date: 03/18/2002
Page #: 1
Drawn by: LCB
Issued for: BID
A4.03

BUILDING NORTH-SOUTH CROSS SECTION

SCALE: 1/4" = 1'-0"

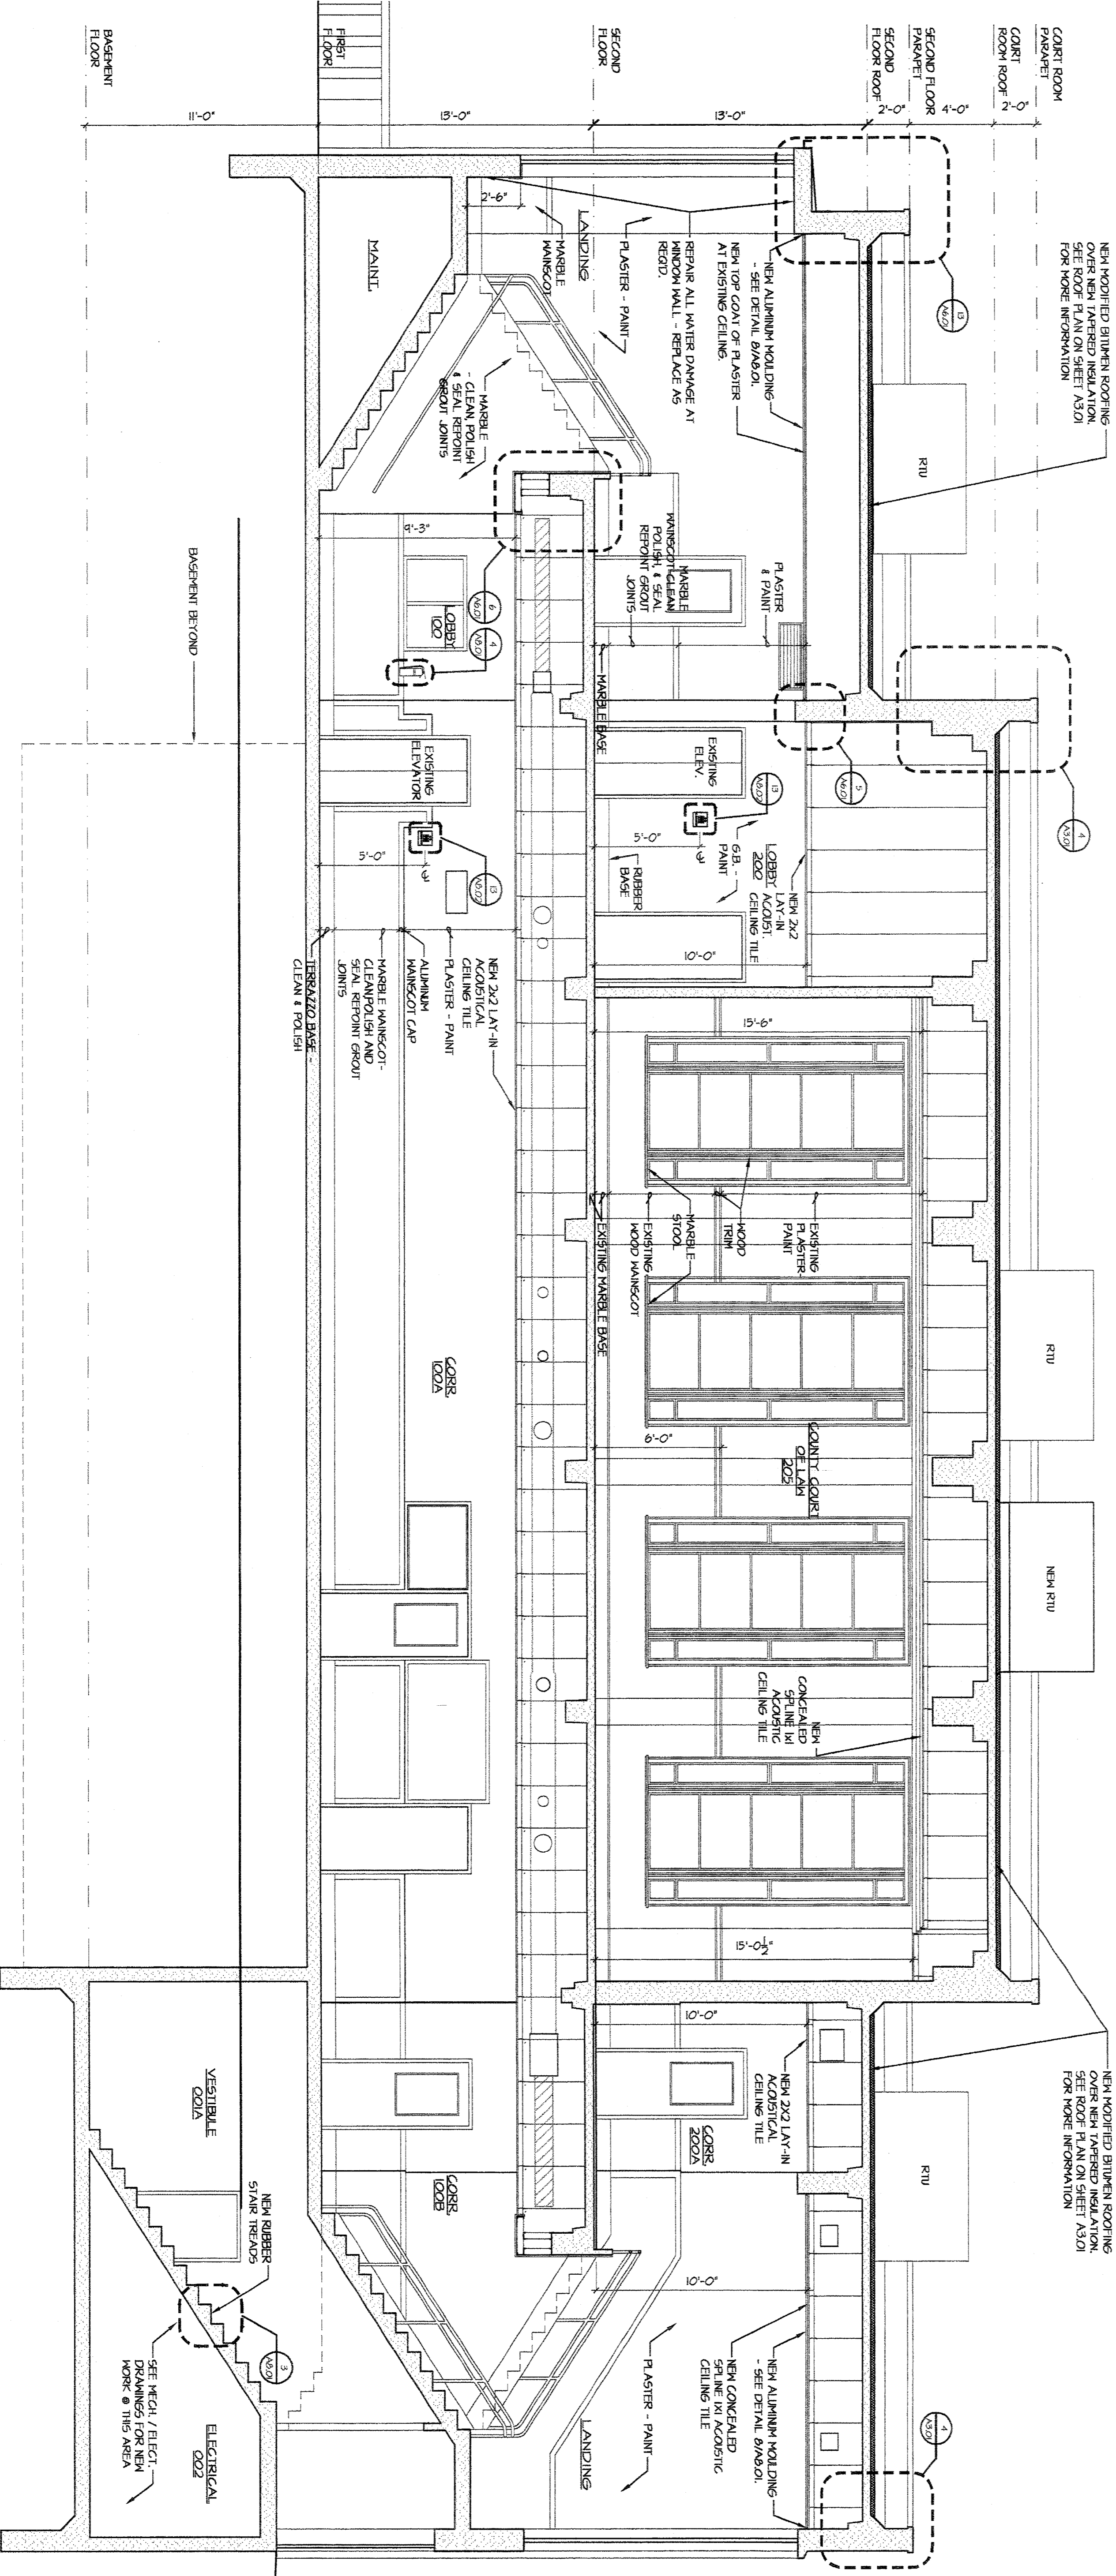


Project: **BURNETT COUNTY COURTHOUSE**
 BURNETT, TEXAS
 Date: 03/18/2002
 Drawn by: LCB
 Issued for: BID
A5.01

11
 ELEVEN THIRTEEN ARCHITECTS INC.
 807 S. ROKK STREET, 02
 GEORGETOWN, TEXAS 75228
 TEL: 512.369.1188 FAX: 512.369.1182

Sheet Title:
BUILDING CROSS SECTION
 Project:
BURNETT COUNTY COURTHOUSE
 BURNETT, TEXAS

1

REVISIONS

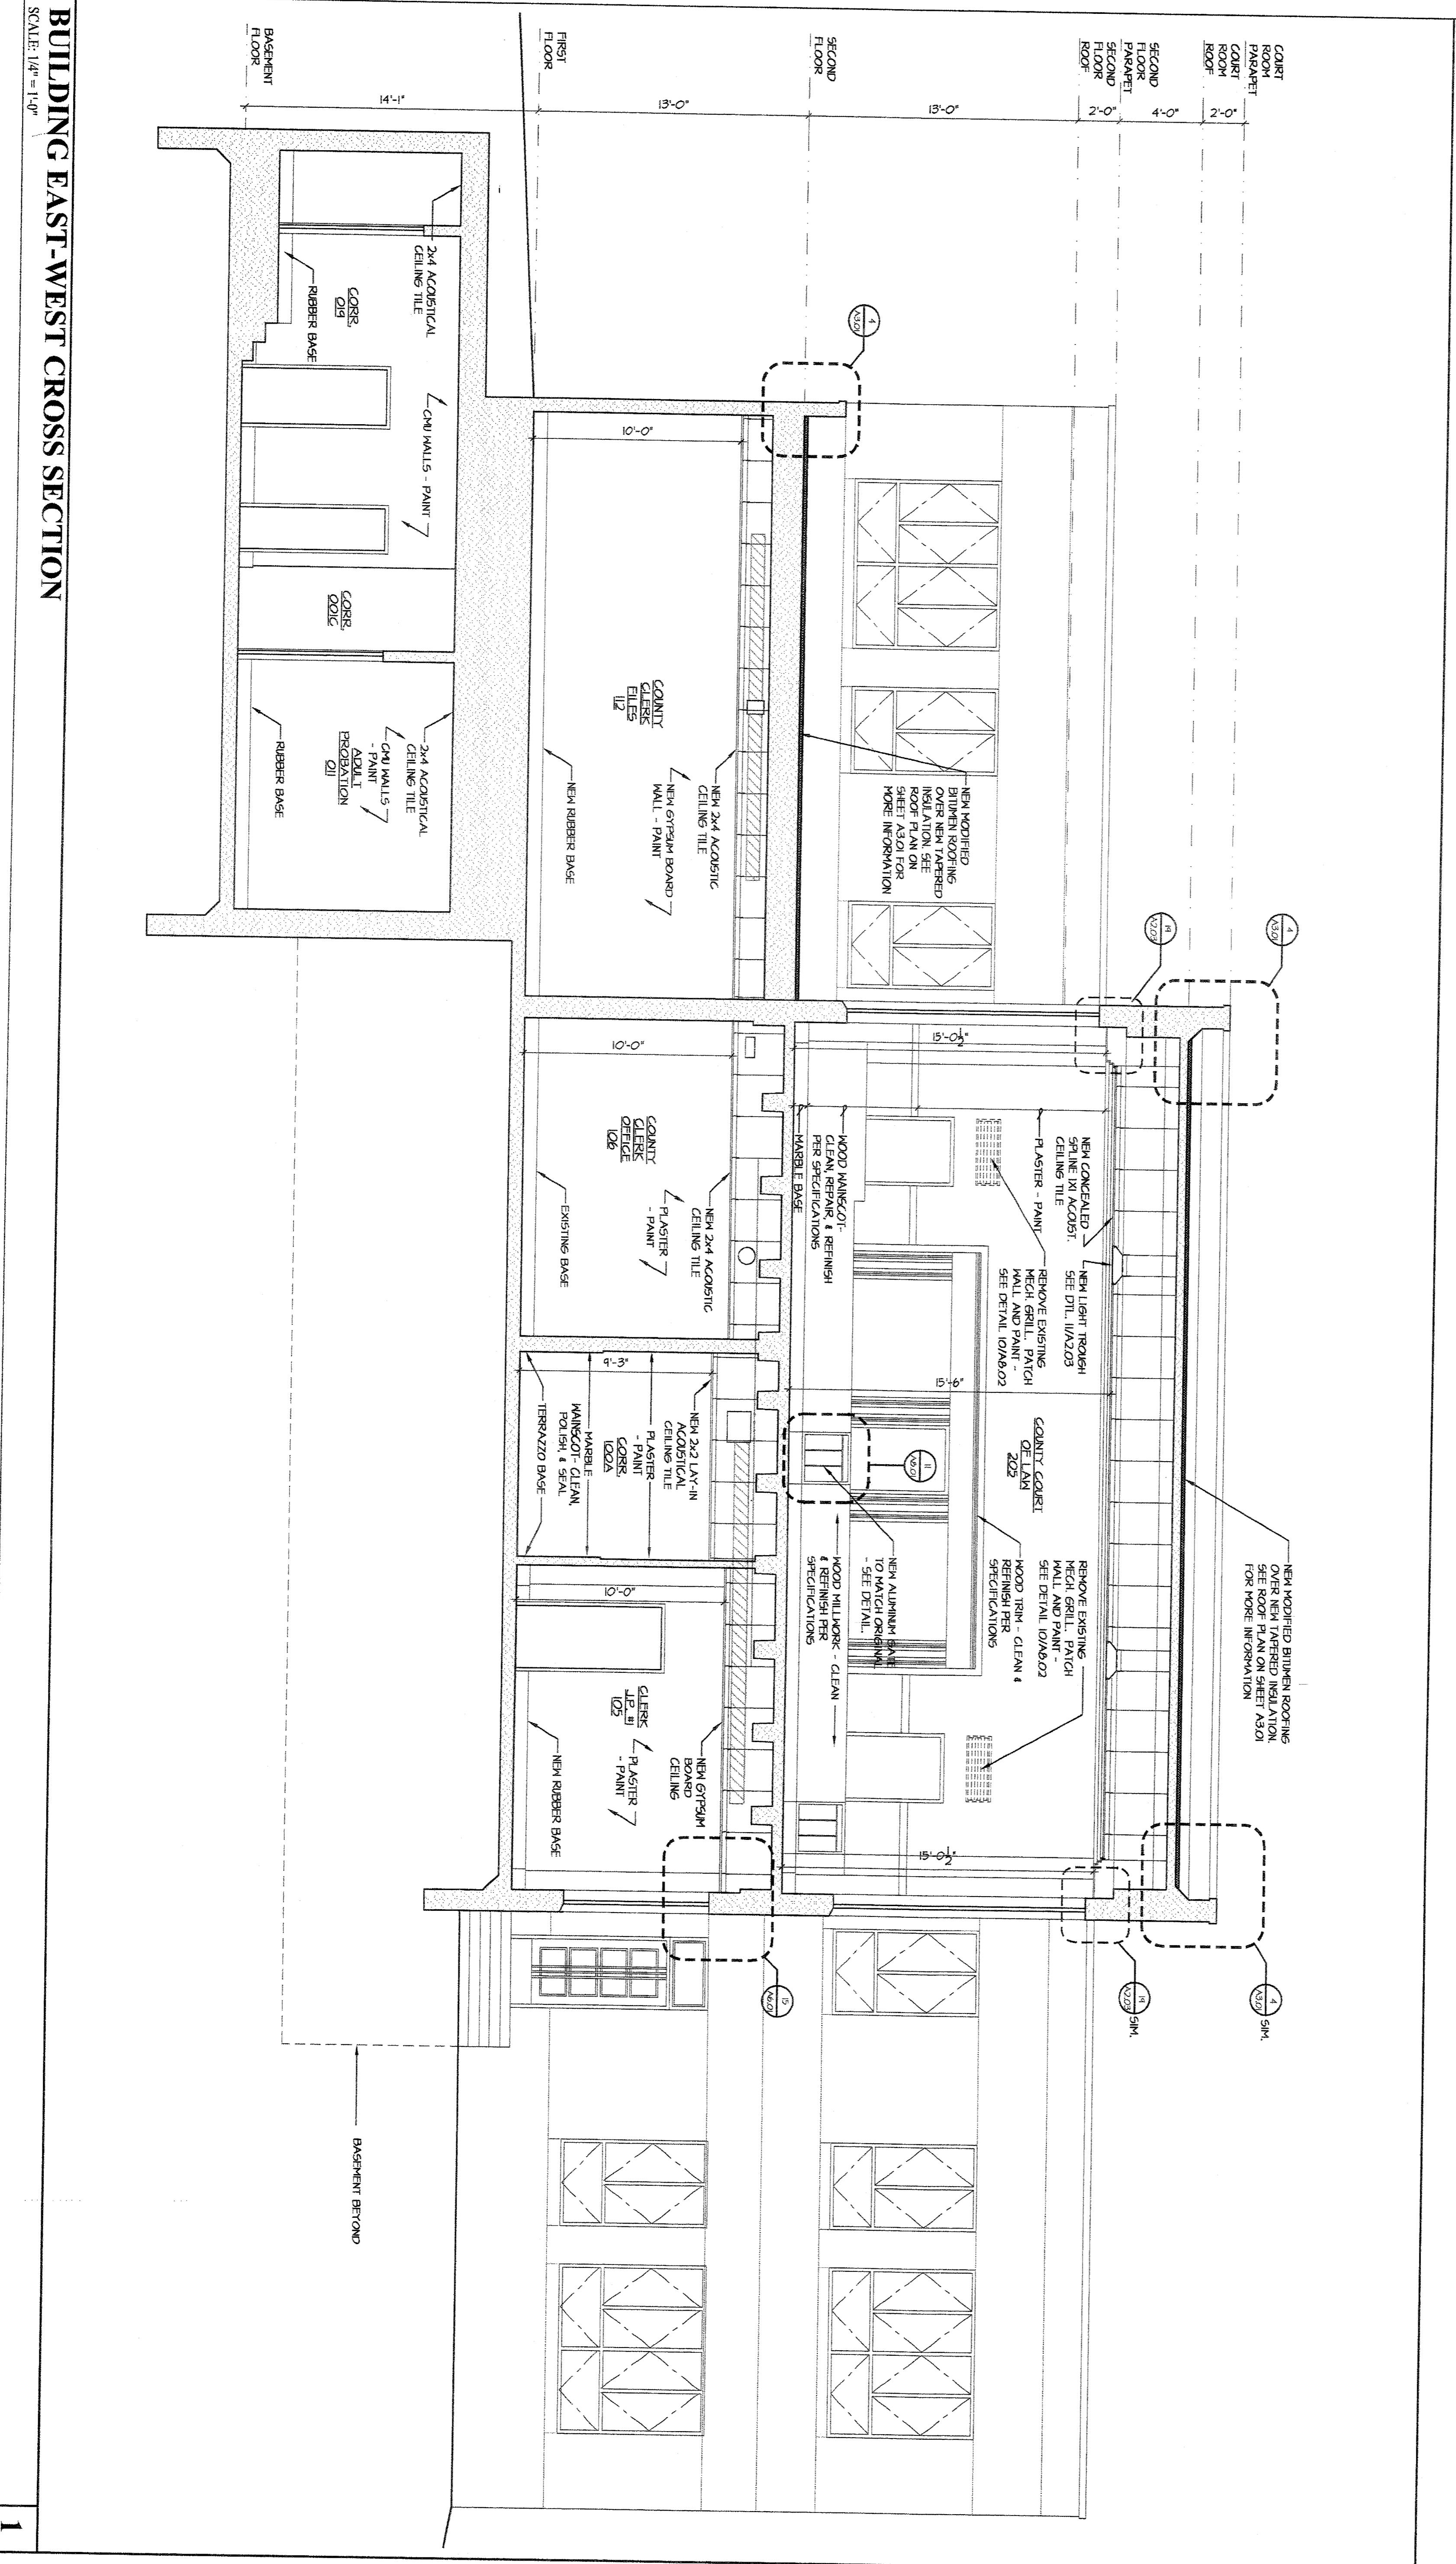

BUILDING EAST-WEST CROSS SECTION

SCALE: 1/4" = 1'-0"

Sheet Title:
BUILDING CROSS SECTION


Project:
BURNETT COUNTY COURTHOUSE
 BURNETT, TEXAS

Date: 03/18/2002
 Drawn by: LCB
 Issued by: RMD


11/15
 11/15
 11/15

HAVERN THIRTEEN ARCHITECTS, INC.
 807 S. KOOKS STREET, 102
 GEORGETOWN, TEXAS 78626
 TEL 512.869.1104 FAX 512.869.1182


AS.02

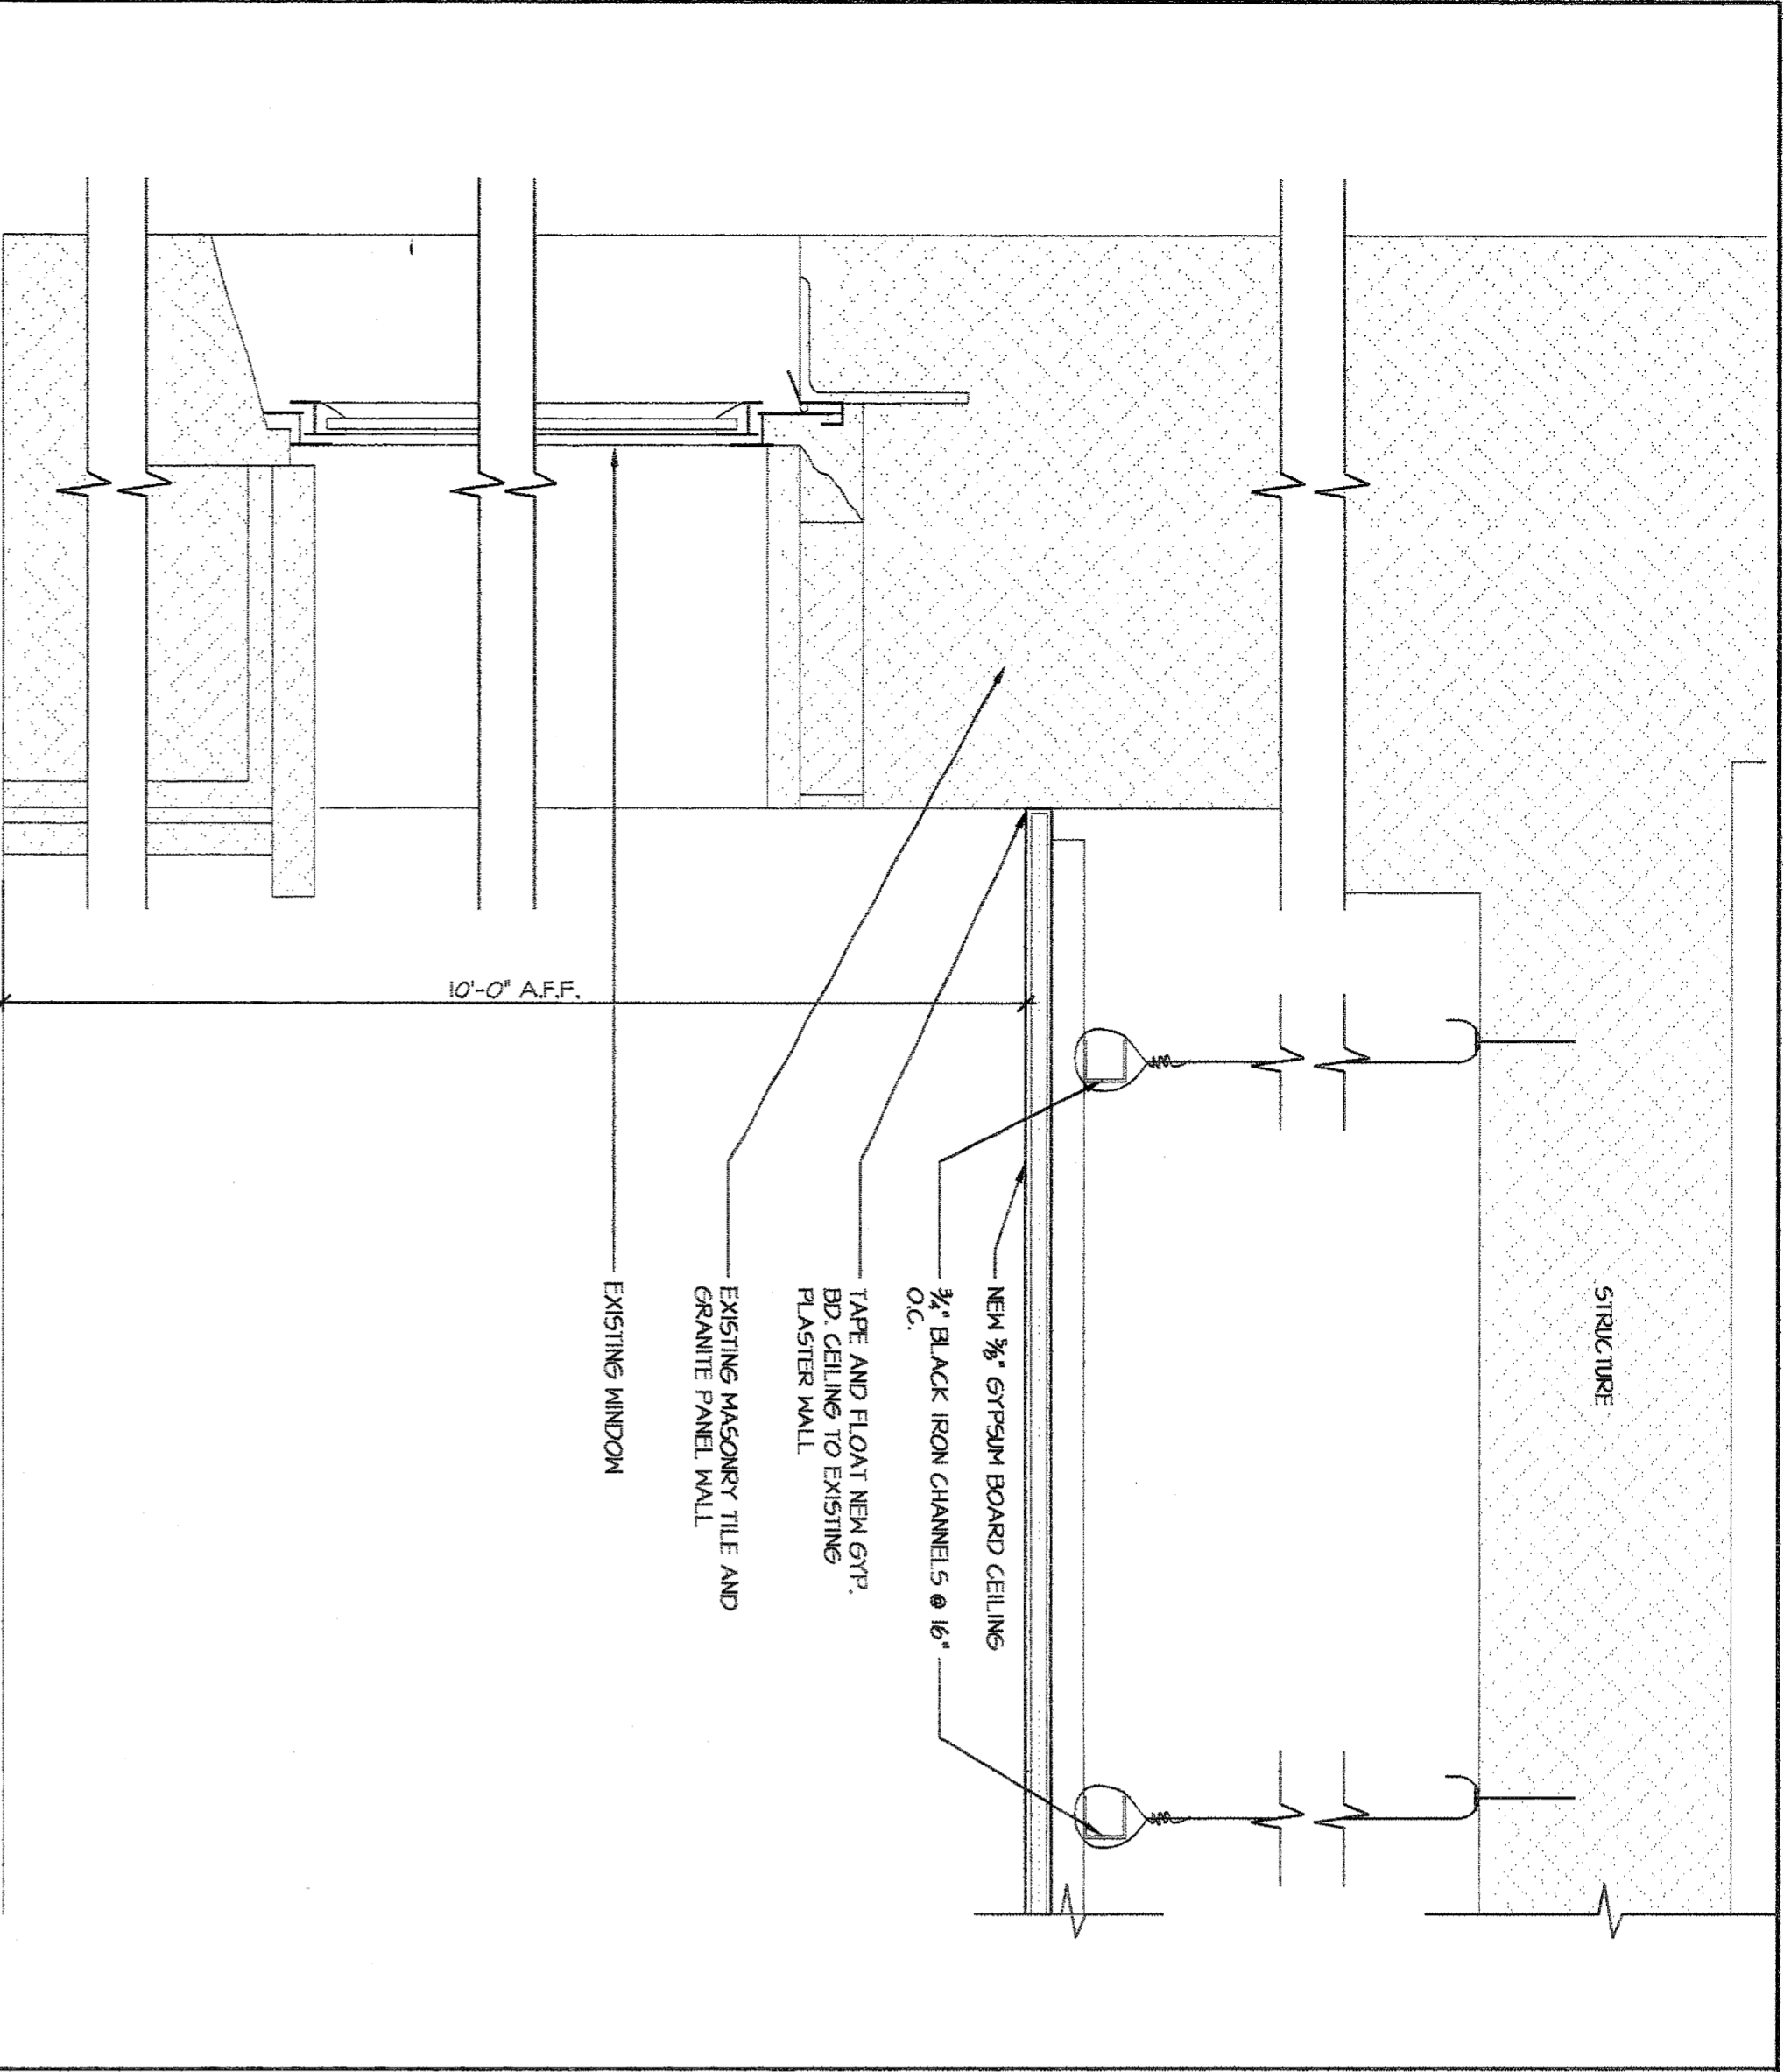


NEW SUSP. GYP. BD. CEILING @ EXISTING WINDOWS
 SCALE: 3" = 1'-0"
 09A006

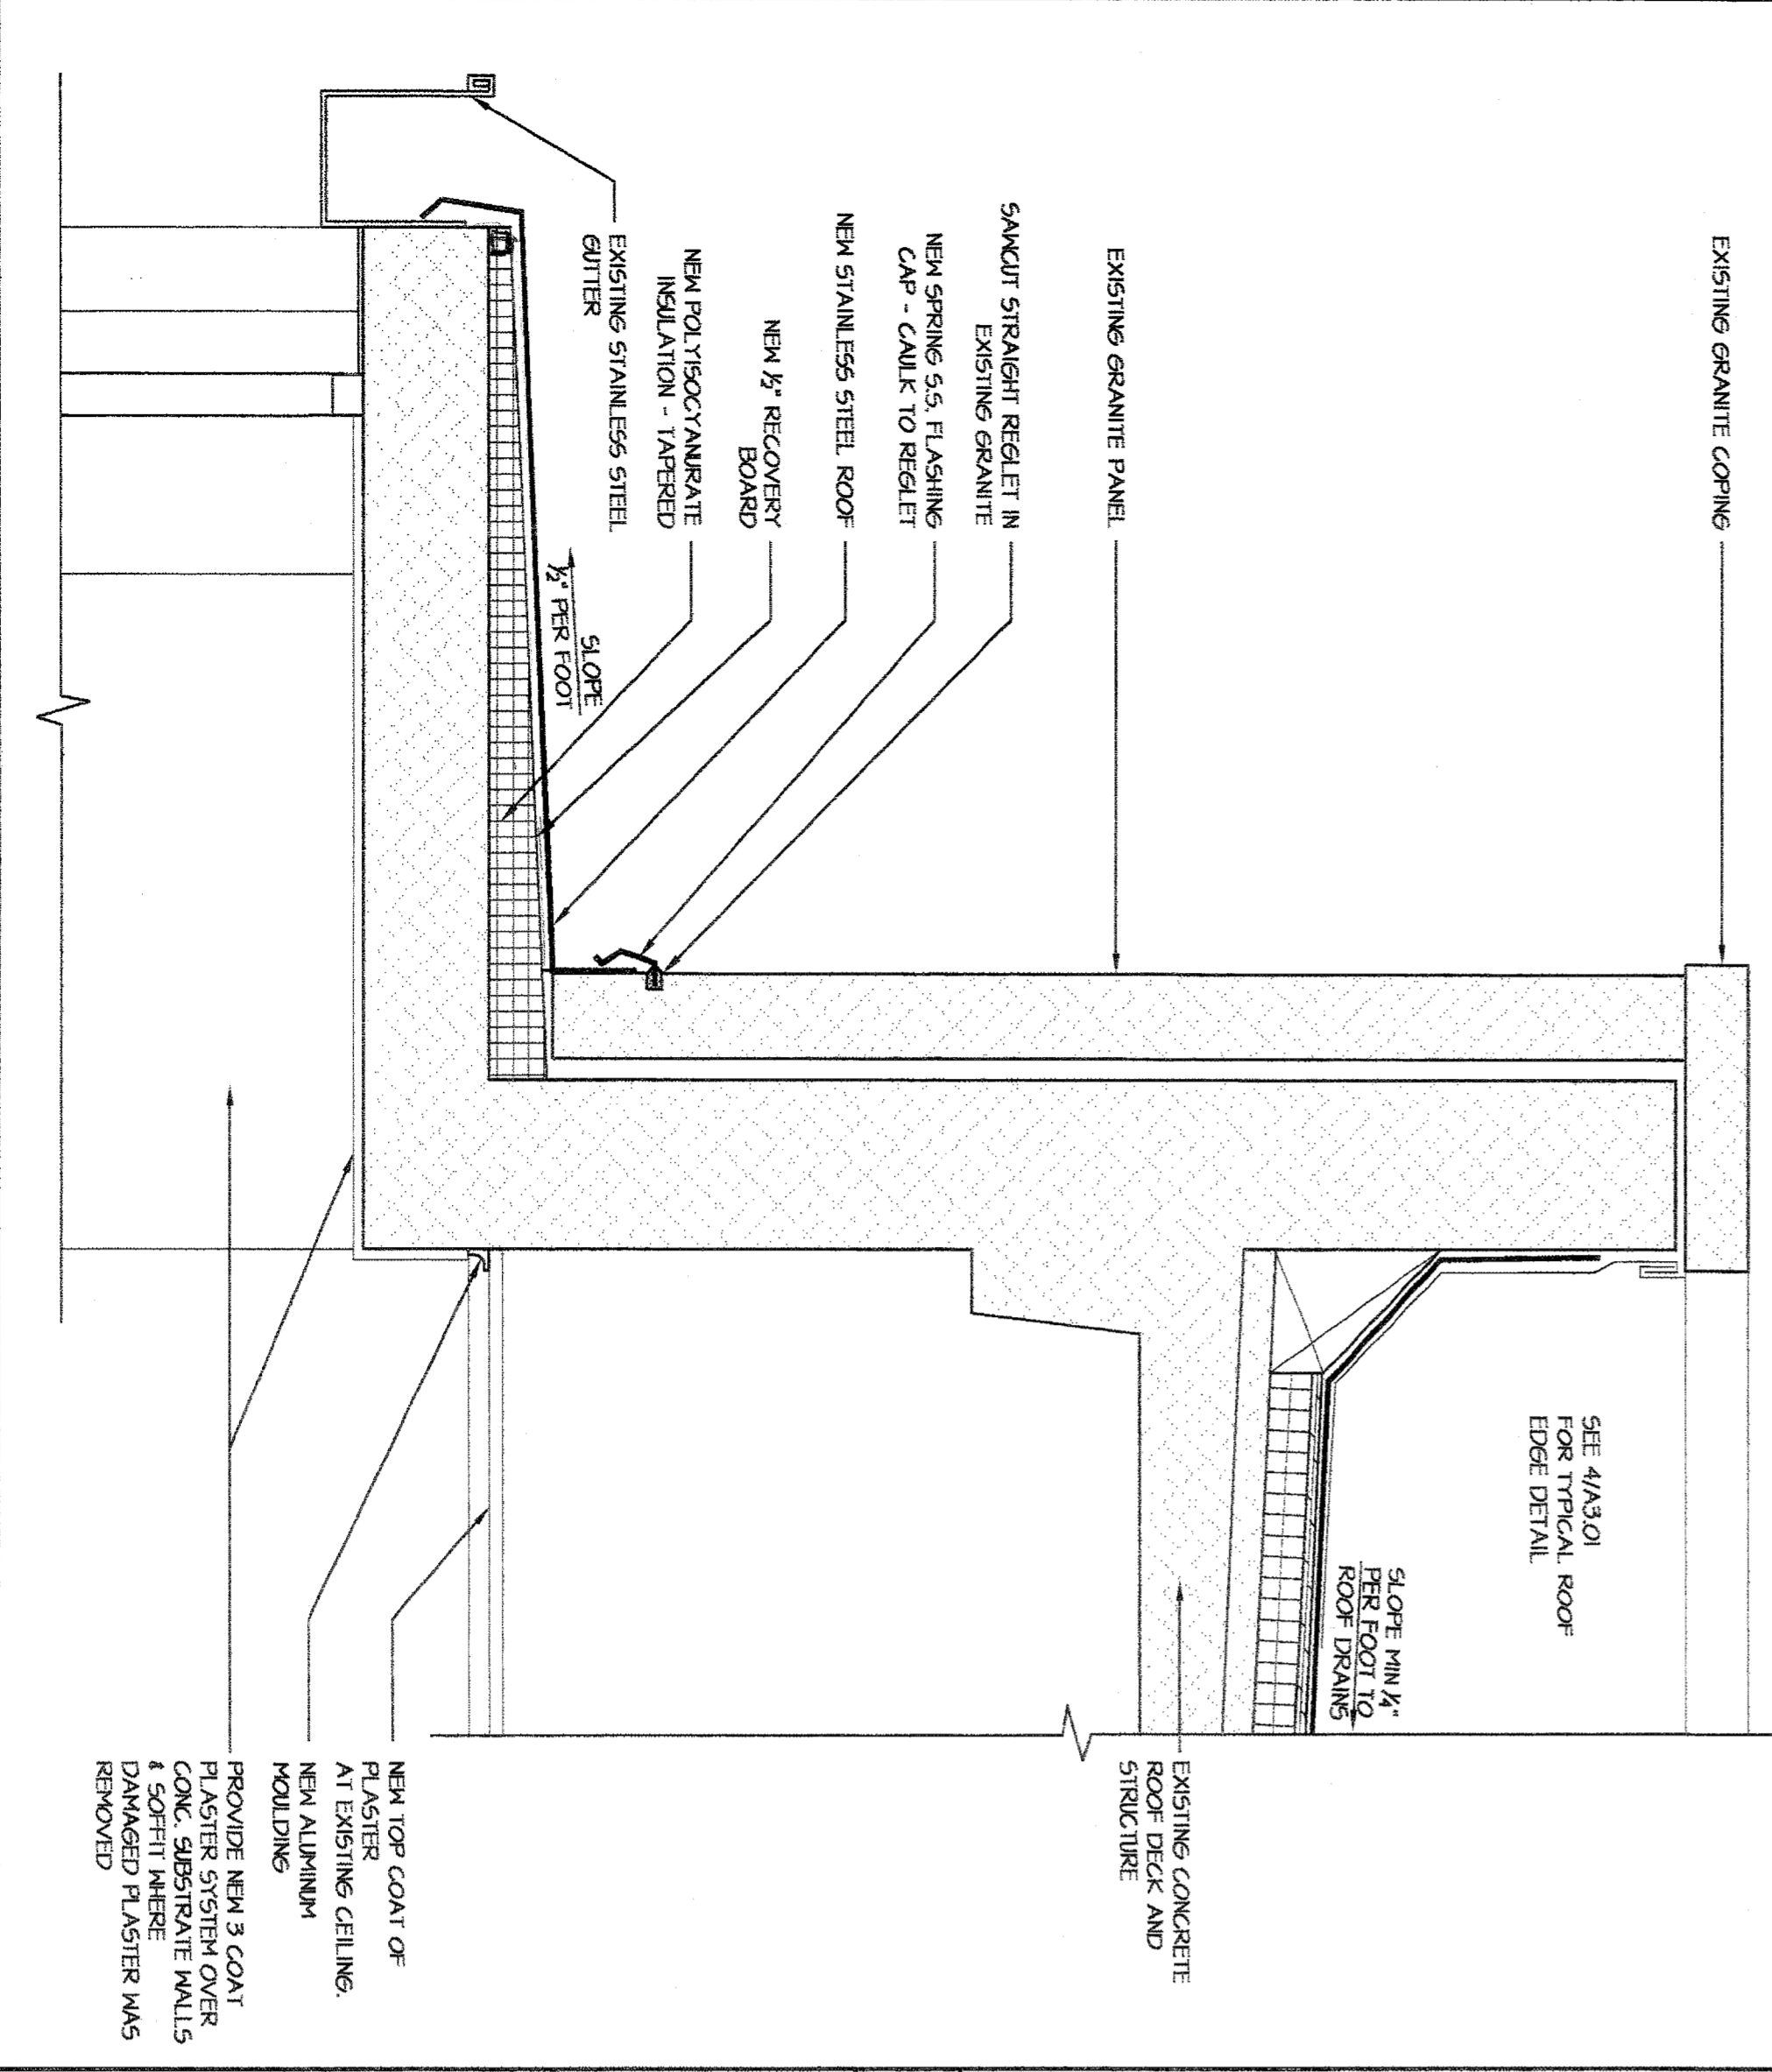


ROOFING DETAIL @ EAST ENTRANCE
 SCALE: 1/2" = 1'-0"
 07A002

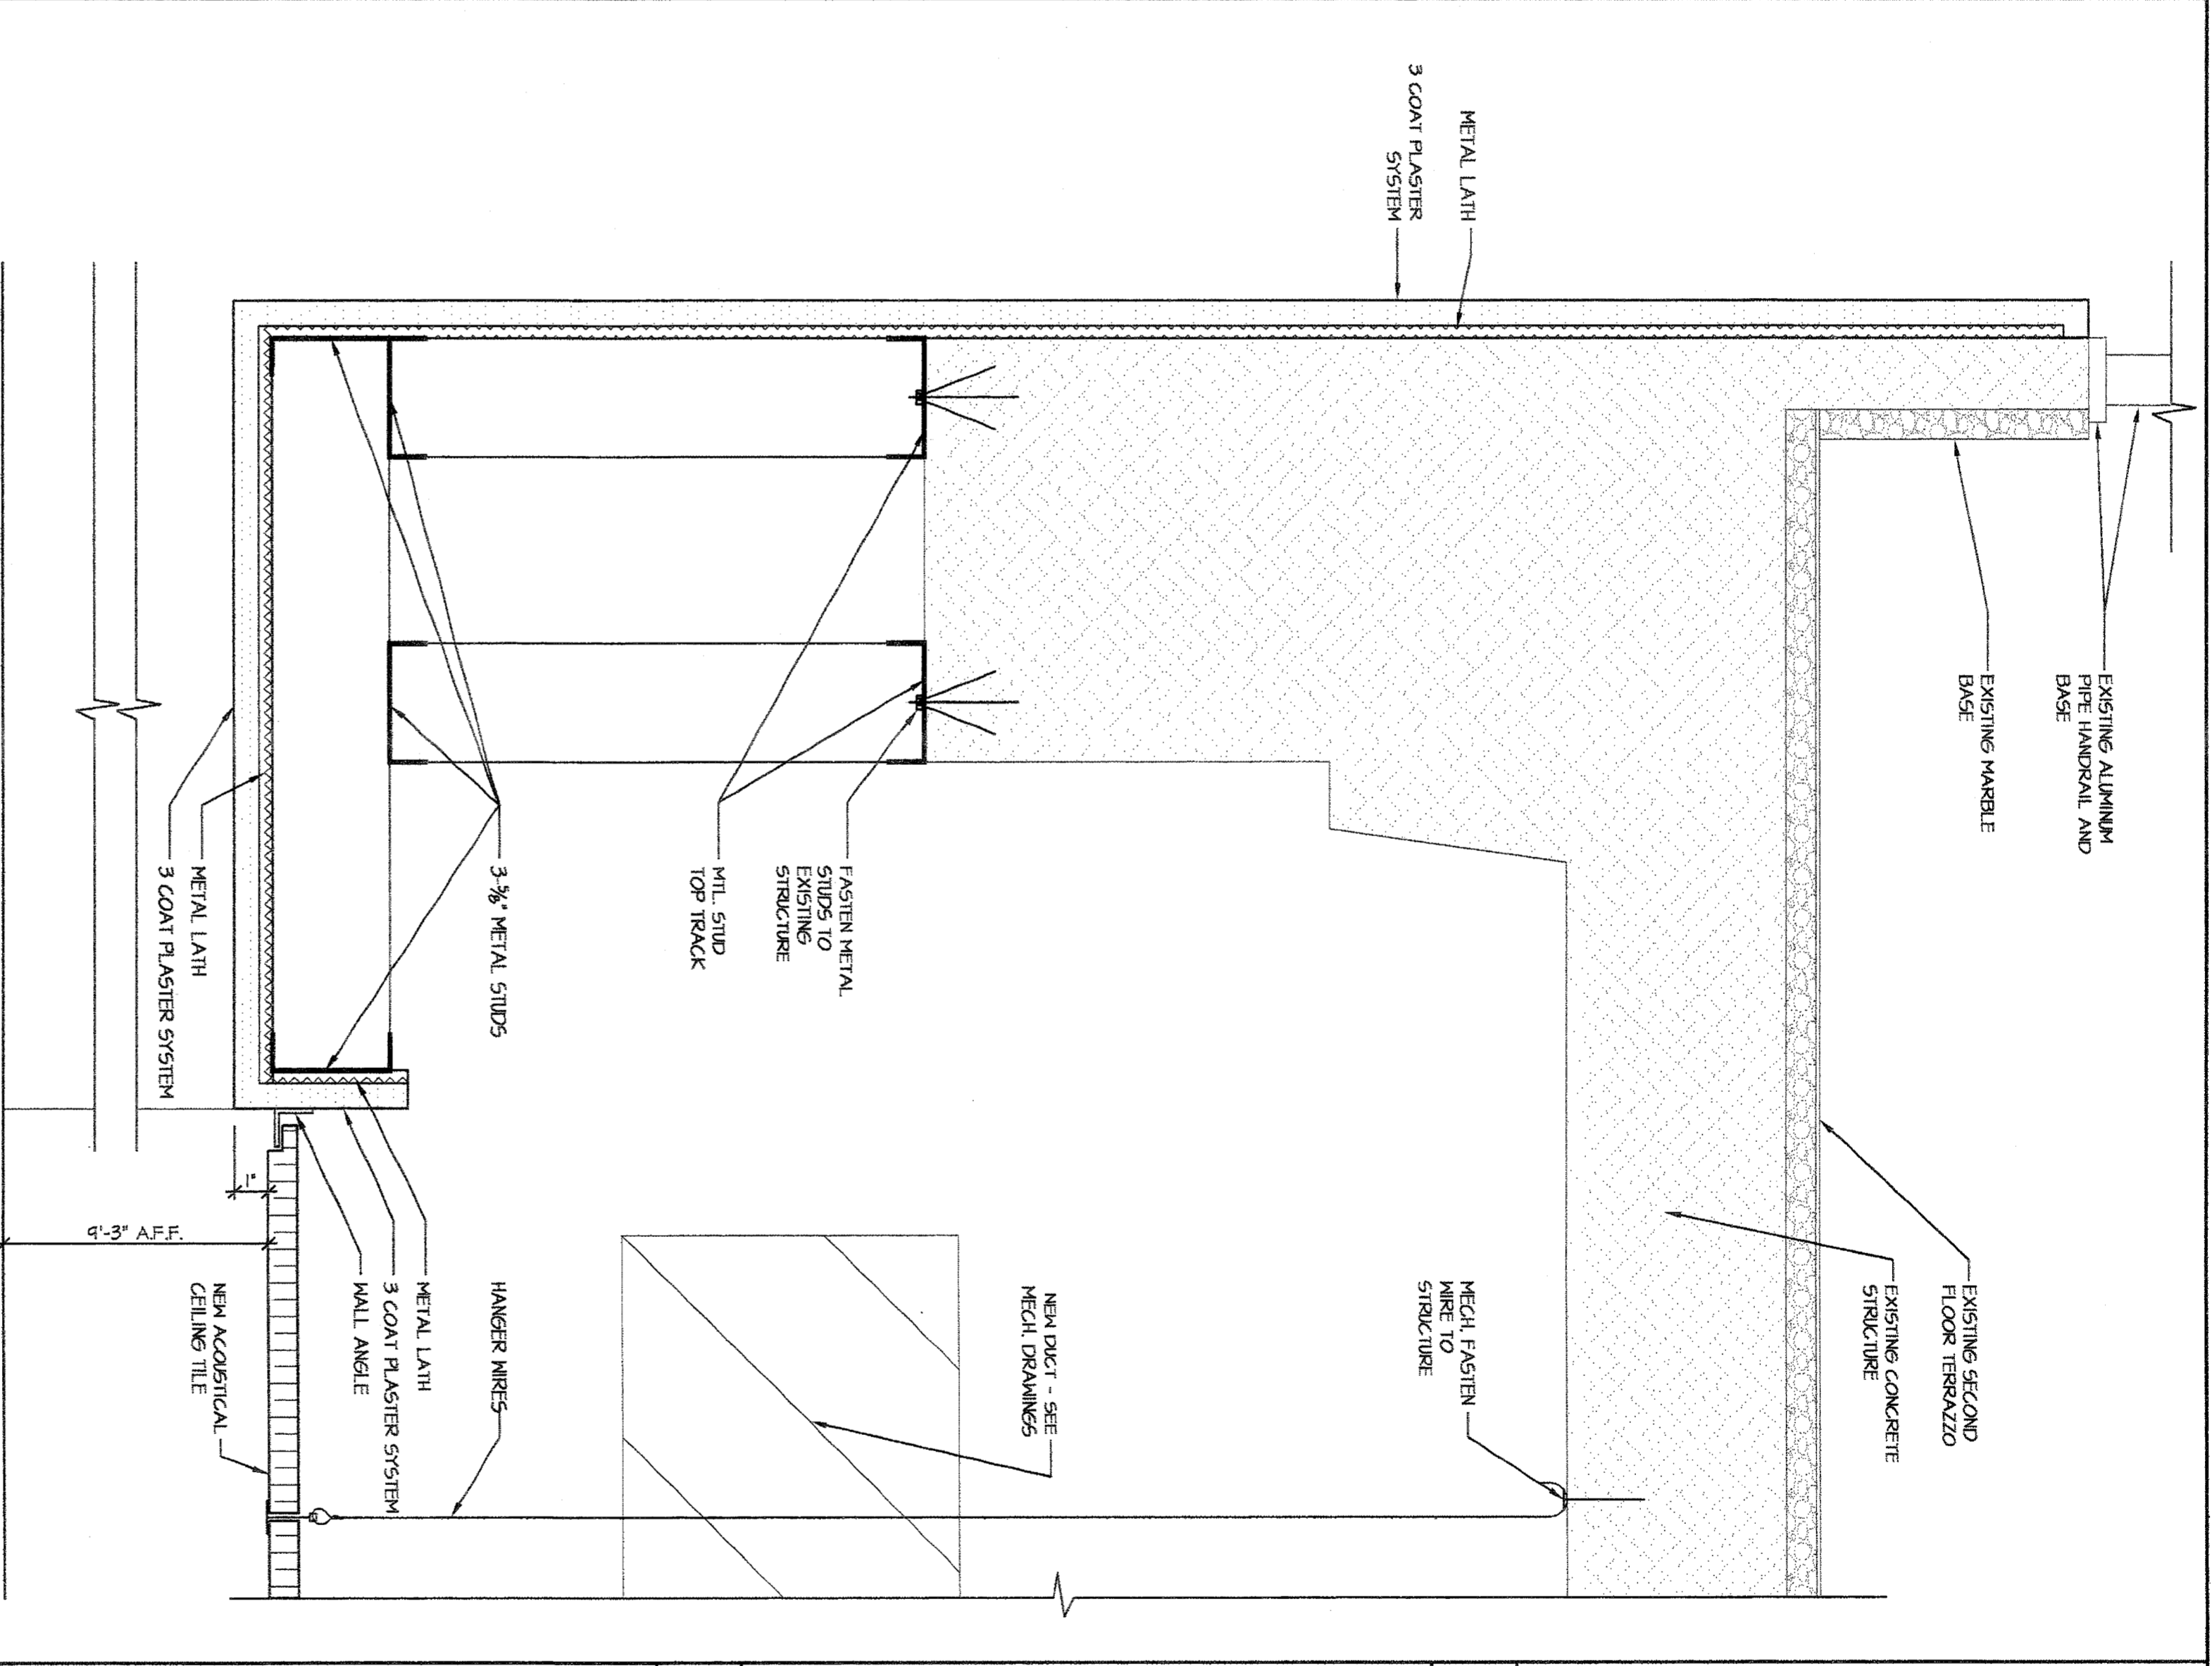


ACOUSTICAL CEILING TILE @ PLASTER BULKHEAD
 SCALE: 3" = 1'-0"
 09A009

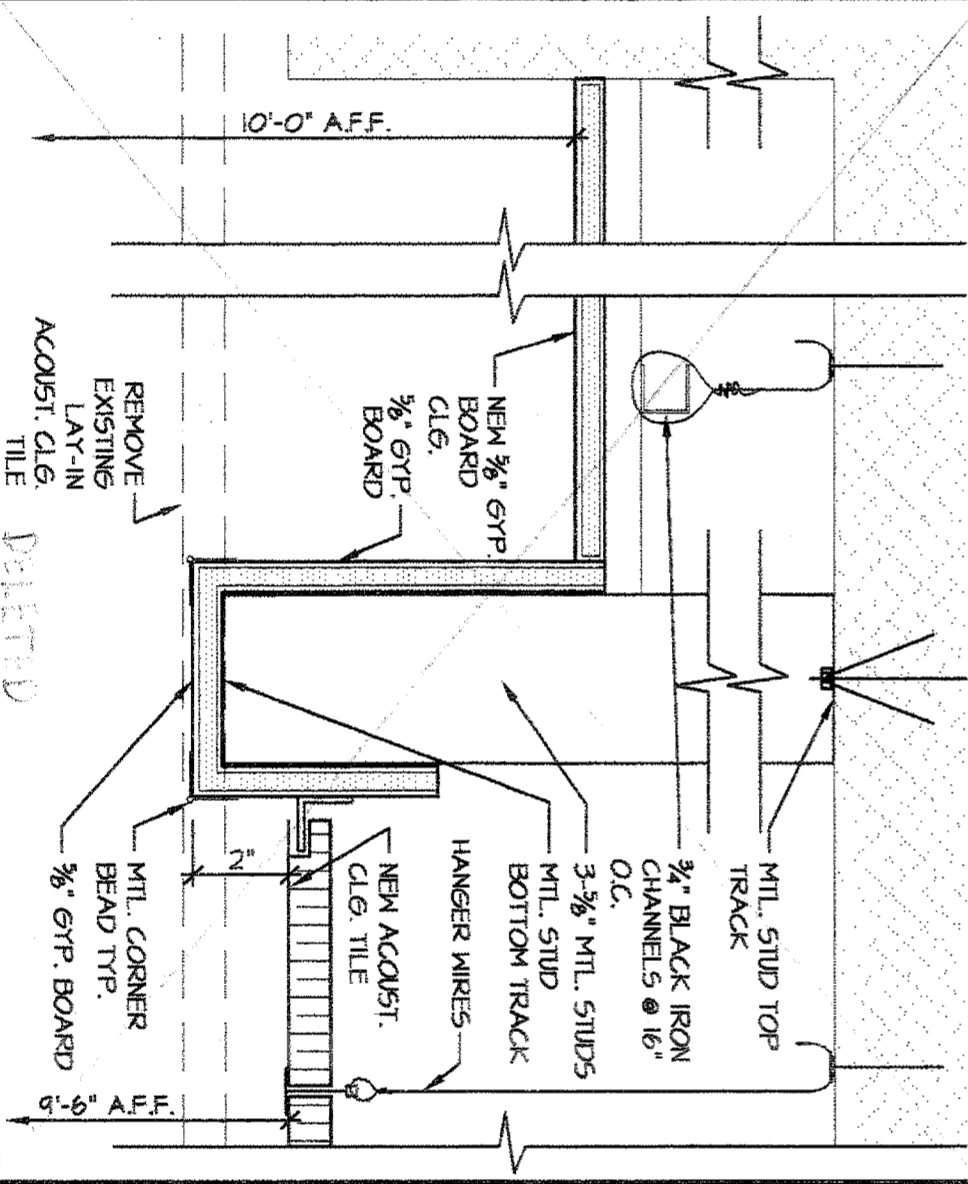


G.B. CLNG. & A.C.T. CLNG.
 SCALE: 3" = 1'-0"
 09A008

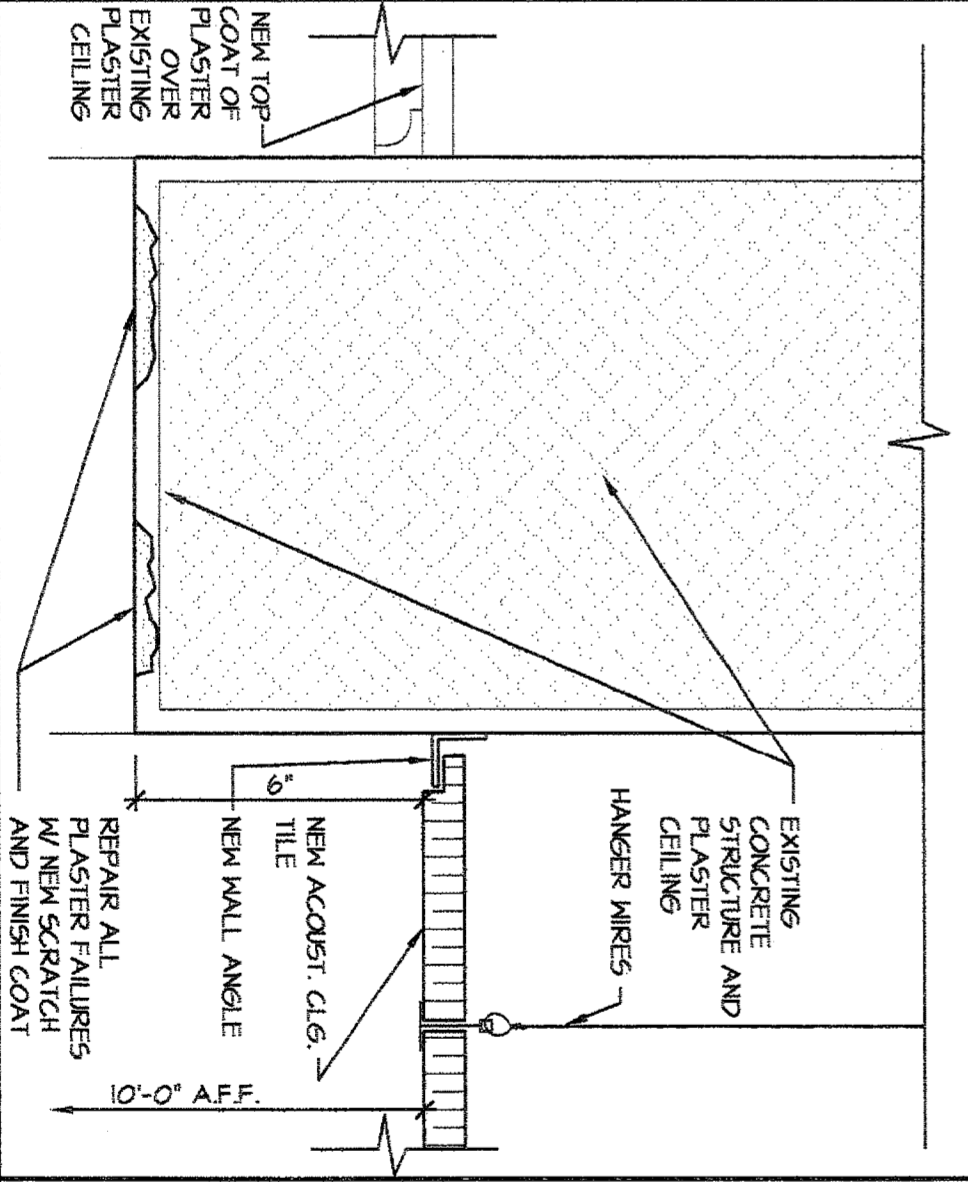


A.C.T. @ PLASTER CEILING
 SCALE: 3" = 1'-0"
 09A011

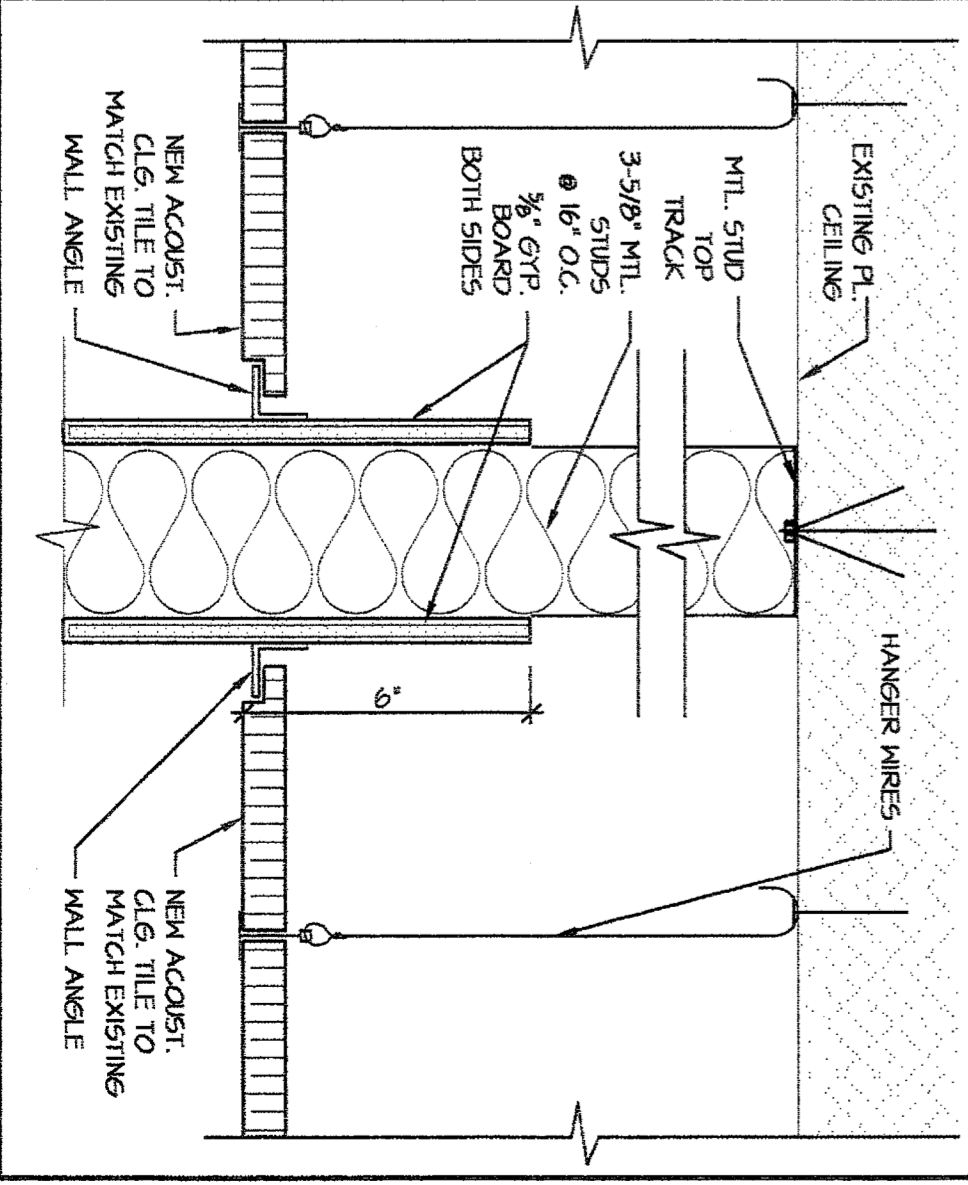

NEW WALL @ NEW CEILING
 SCALE: 3" = 1'-0"
 09A007

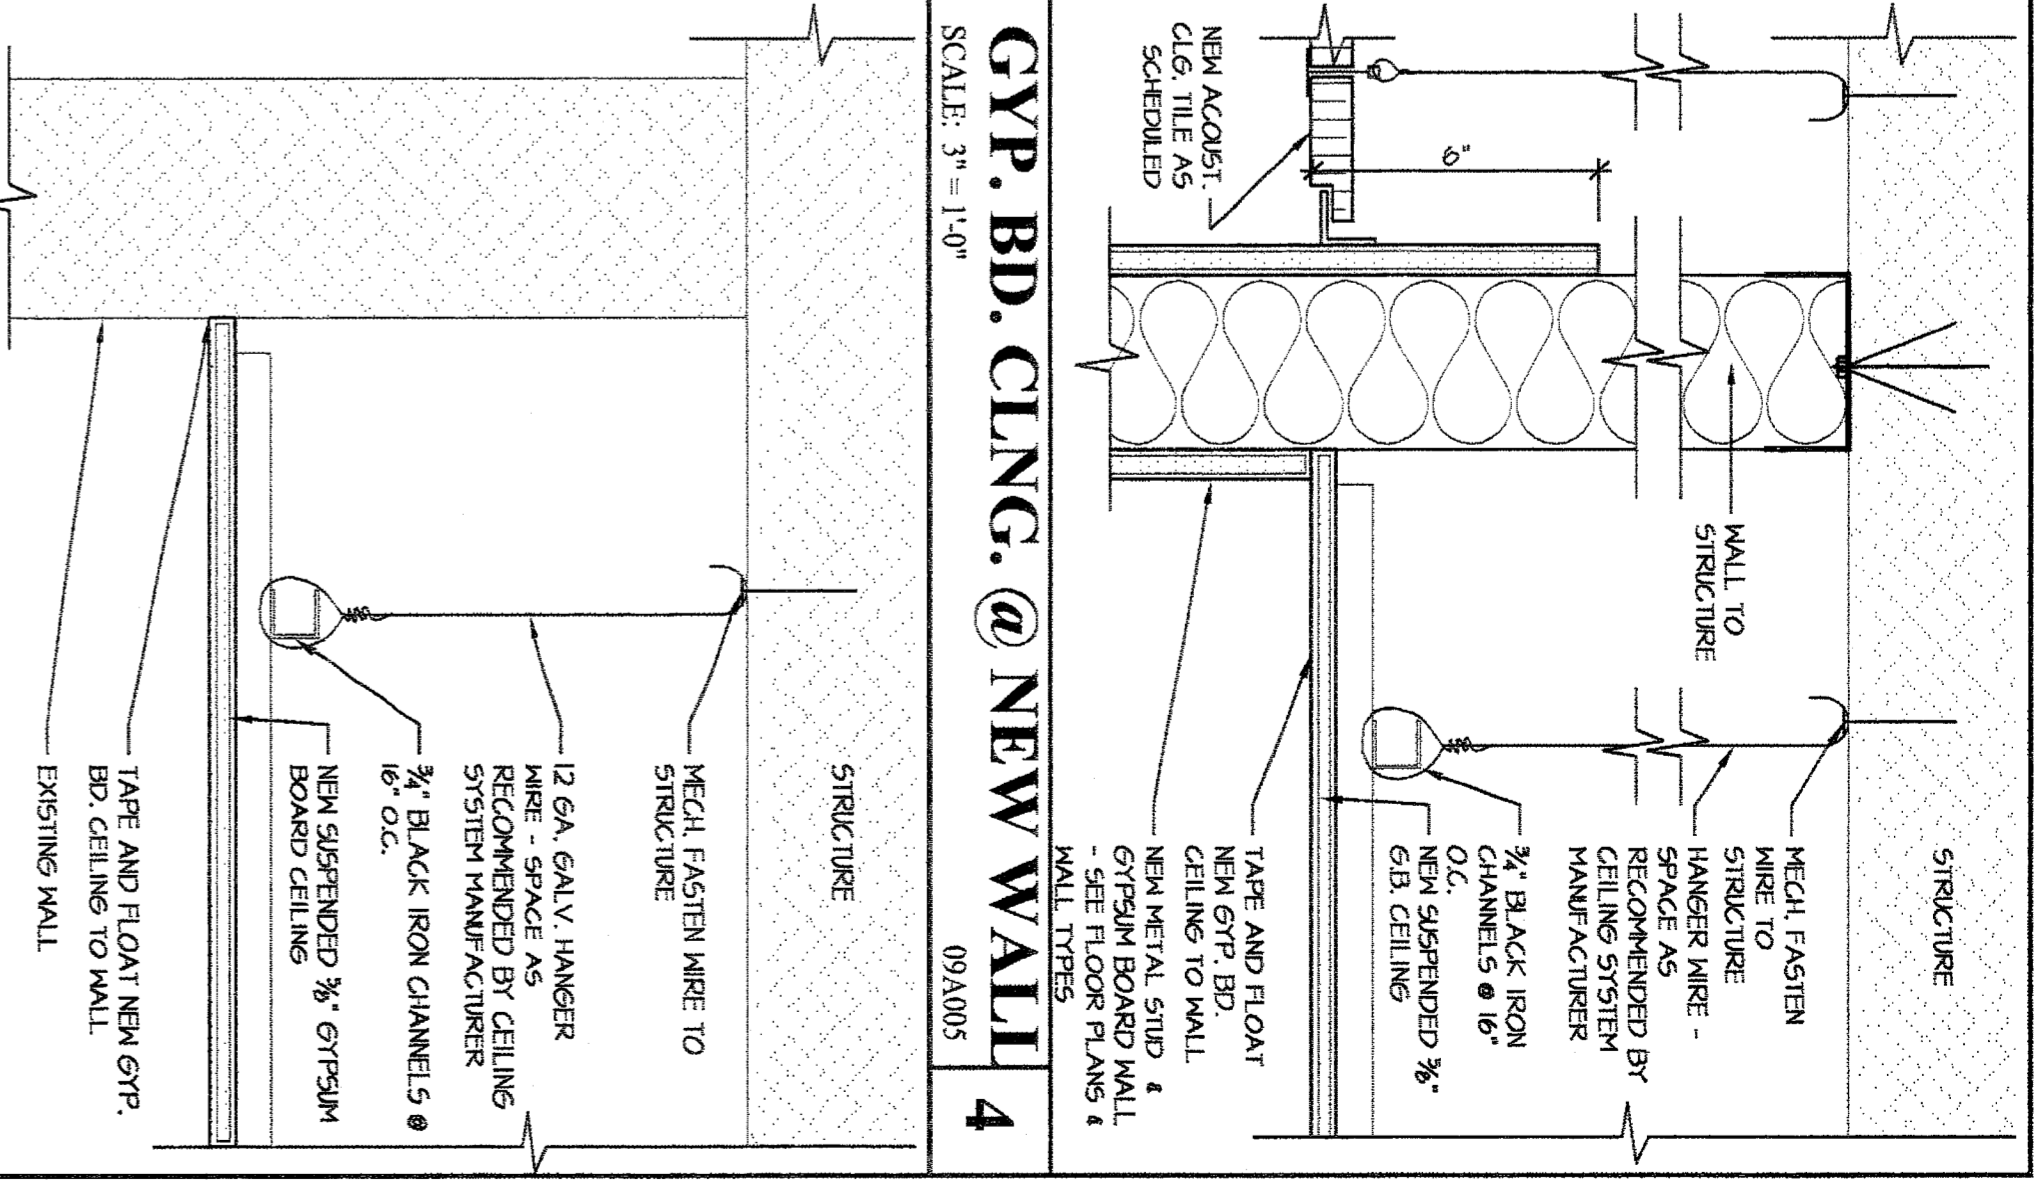

GYP. BD. CLNG. @ EXG. WALL
 SCALE: 3" = 1'-0"
 09A004

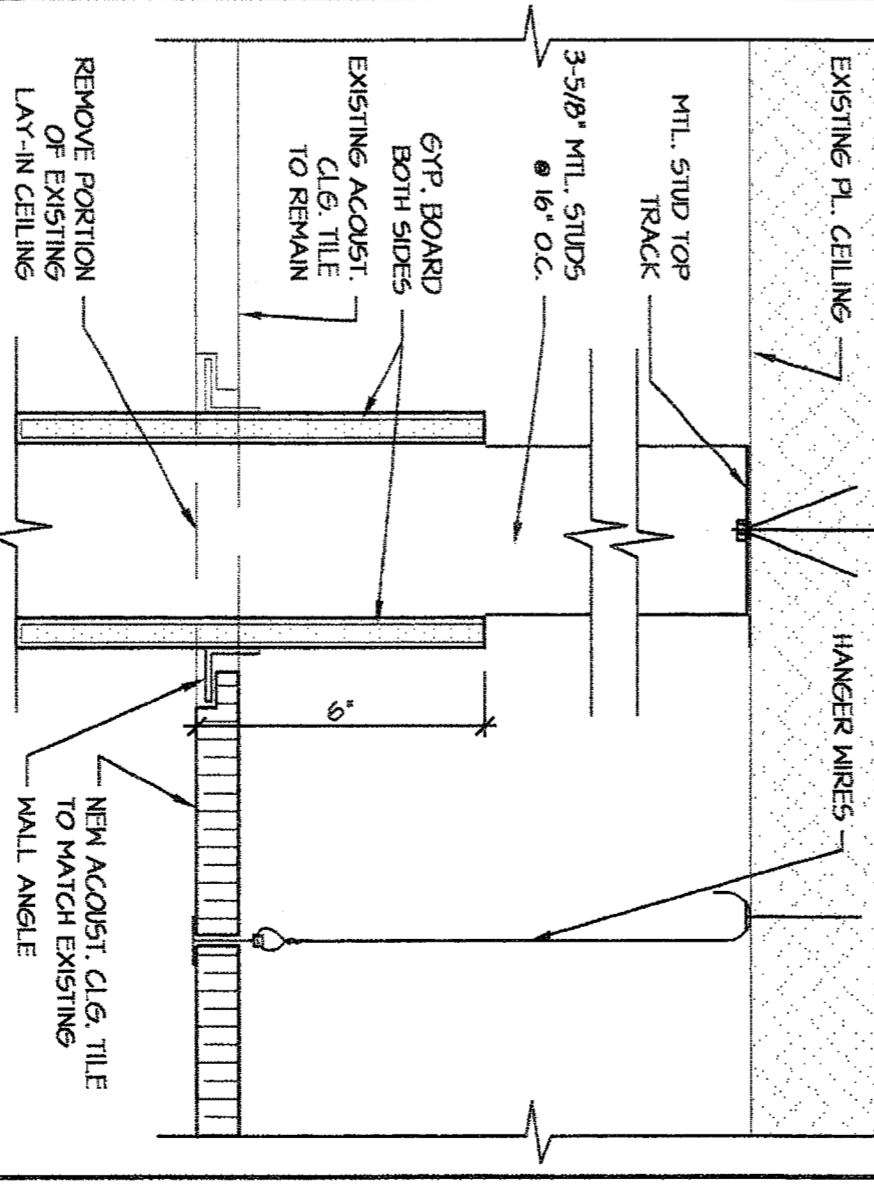

NEW WALL @ EXG. CEILING
 SCALE: 3" = 1'-0"
 09A003

NO.	REVISIONS

Sheet Title: **ROOF AND CEILING DETAILS**


Project: **BURNET COUNTY COURTHOUSE**
 BURNETT, TEXAS

11/13


ELDERBERRY ARCHITECTS INC.
 8075 ROCK SLOTT RD.
 GEORGETOWN, TEXAS 78636
 TEL 512.869.1104 FAX 512.869.1362

Date: 03/18/2002
 Drawn by: LCB
 Issued for: BID


Sheet: **A6.01**

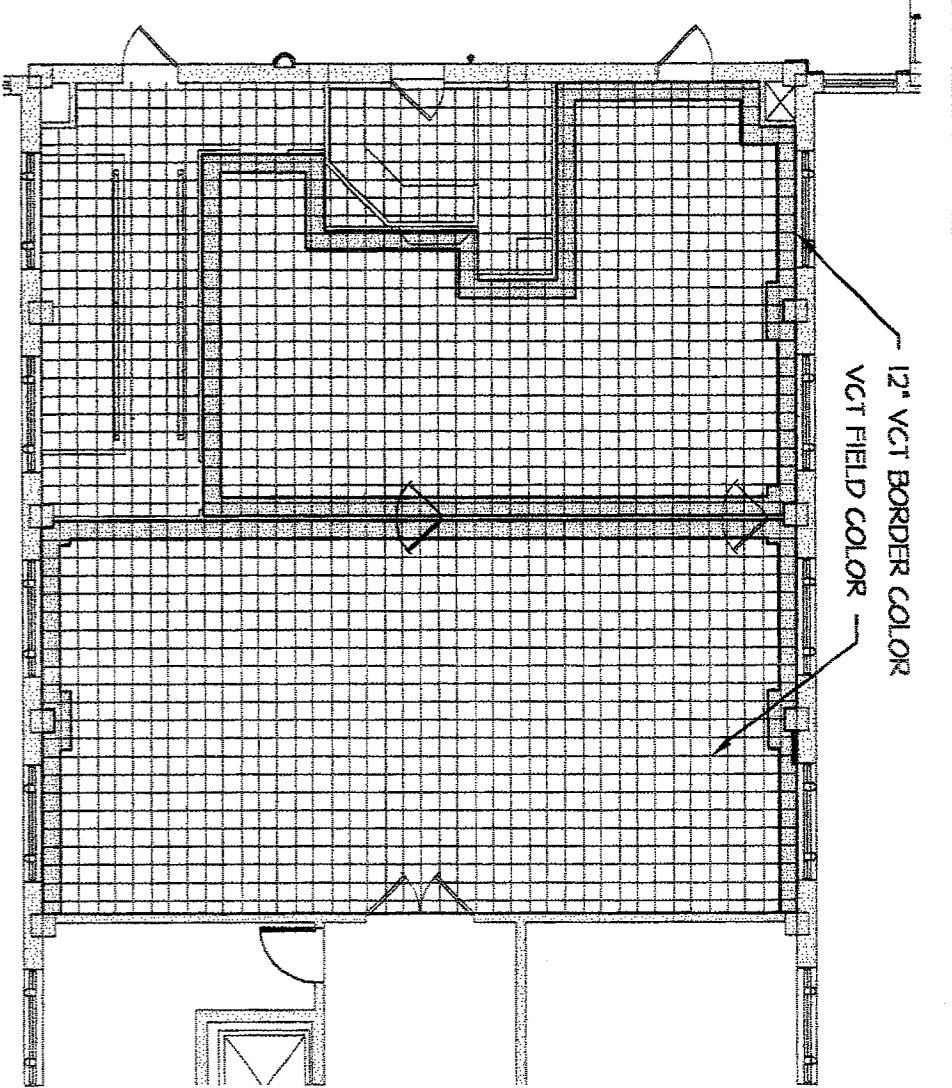


COURTROOM VCT PATTERN
09A032
SCALE: 3/32" = 1'-0"

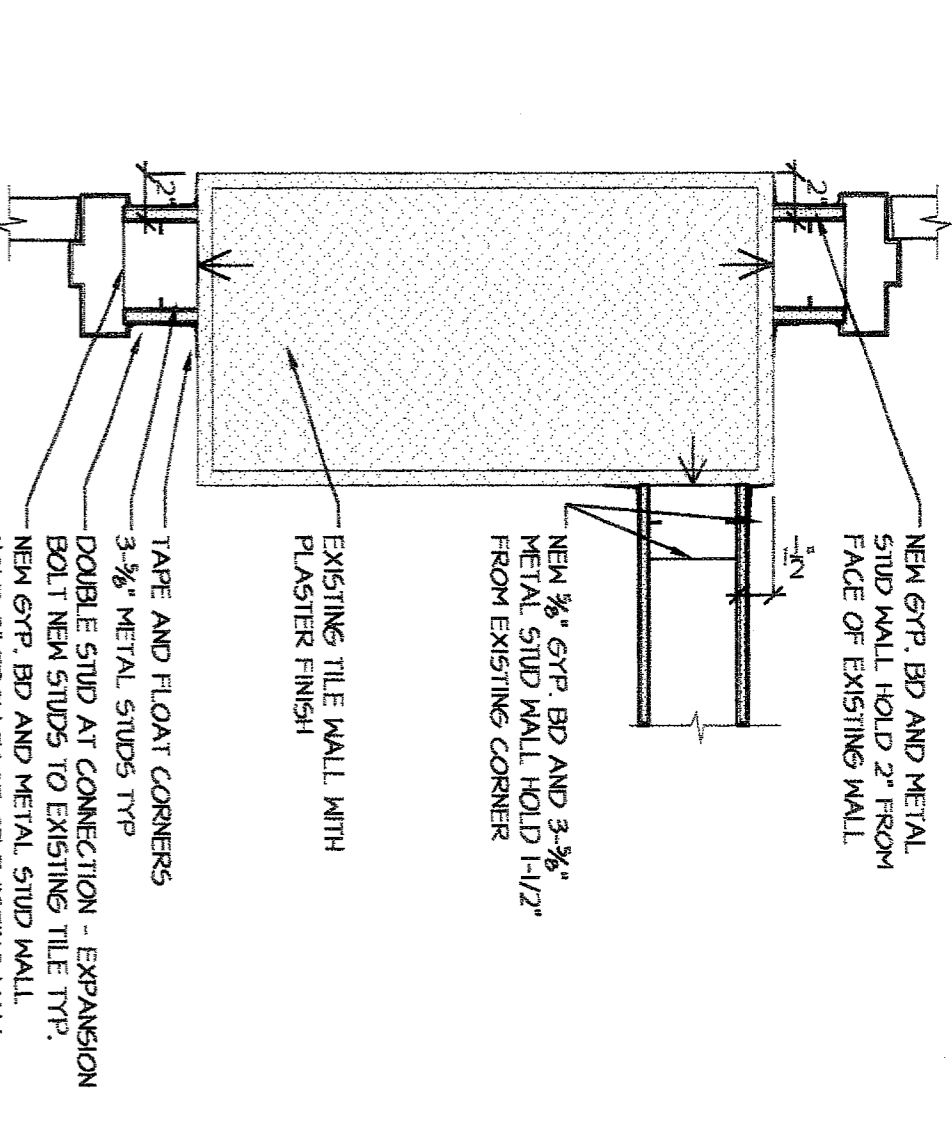


NEW WALL @ EXISTING WALL 16
08A021
SCALE: 1/12" = 1'-0"

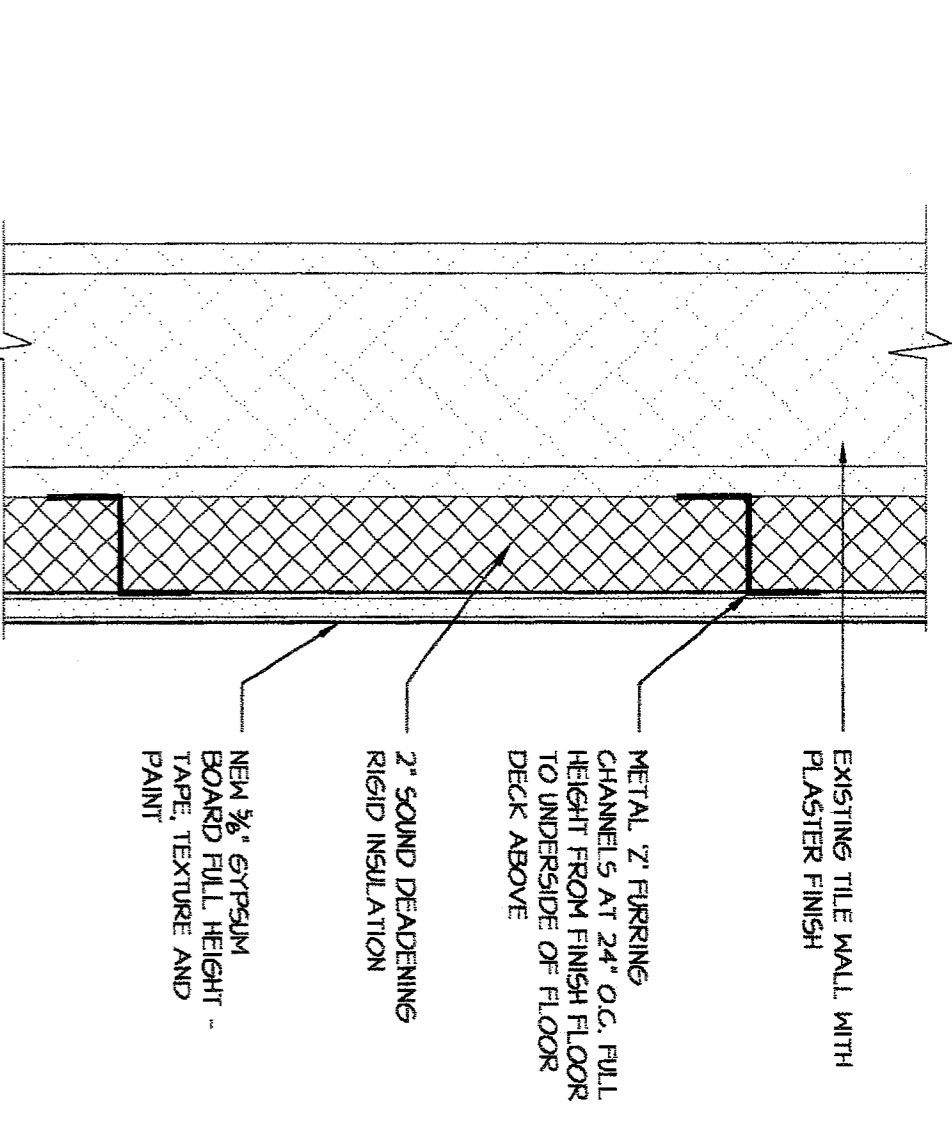


INSULATION @ EXIST. WALL 12
07A009
SCALE: 3/8" = 1'-0"

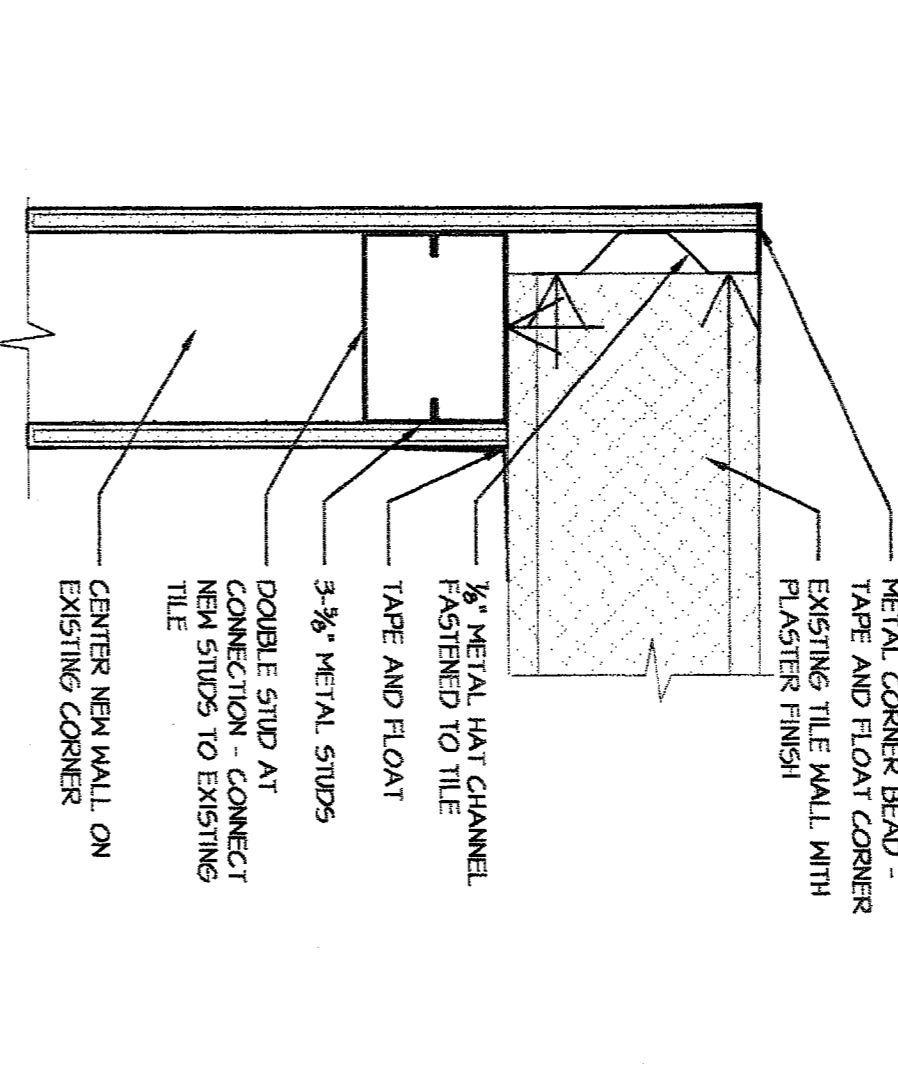


NEW WALL @ EXISTING
09A022
SCALE: 3/8" = 1'-0"

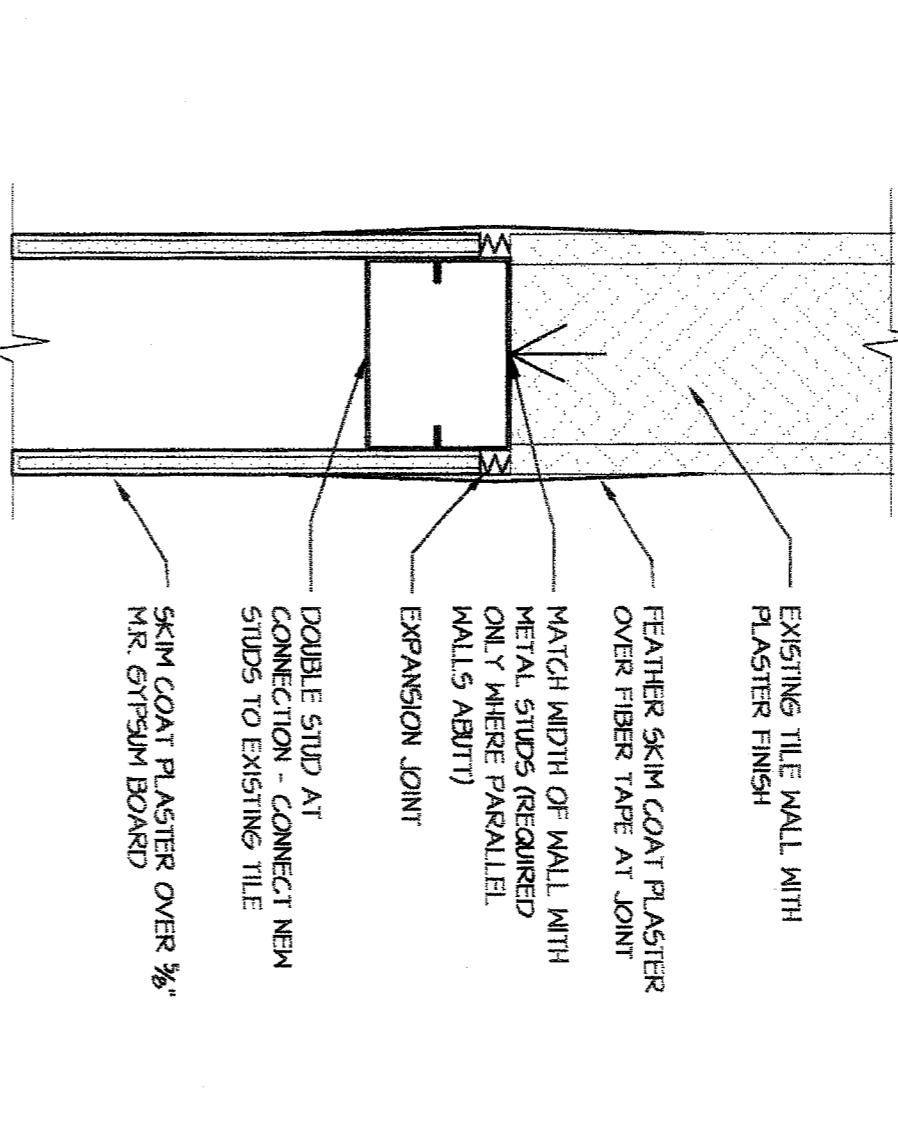


INFILL WALL @ EXISTING
09A019
SCALE: 3/8" = 1'-0"

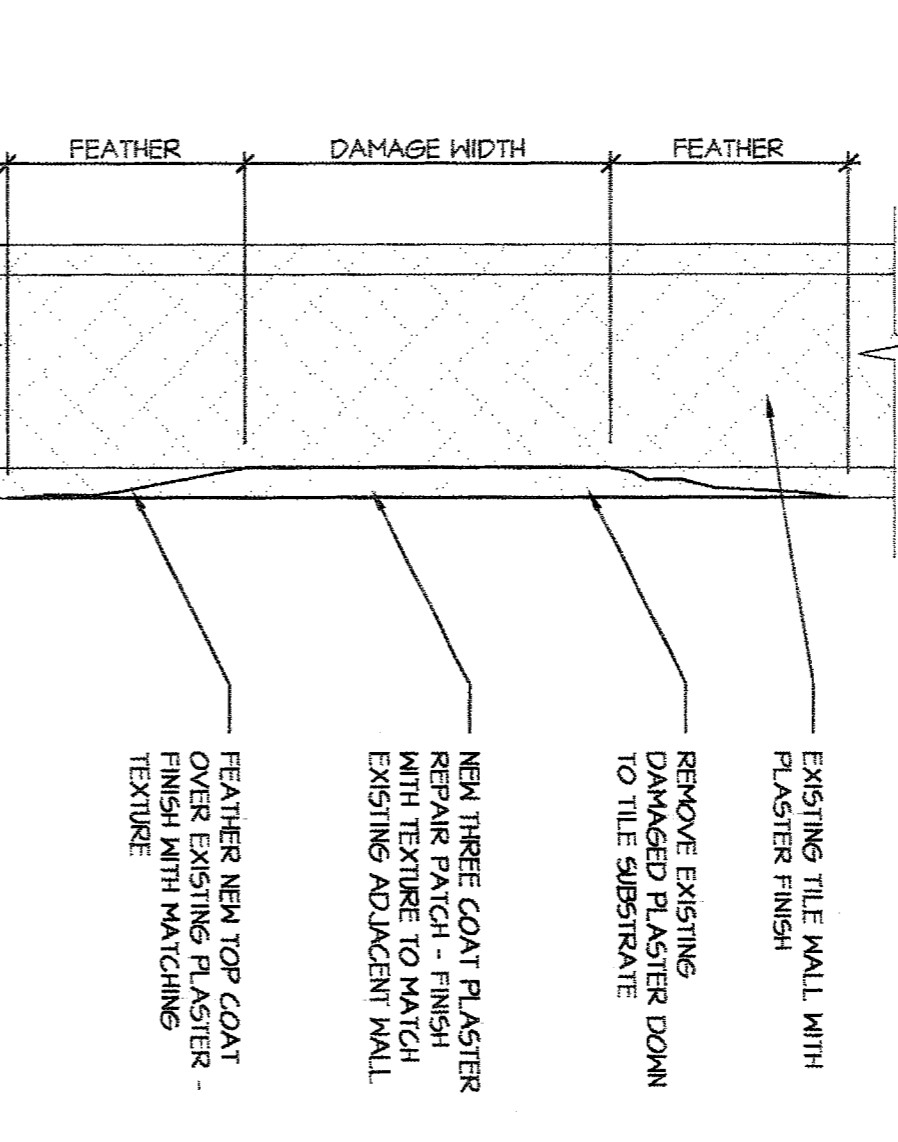


TYP. PLASTER WALL REPAIR 11
09A028
SCALE: 3/8" = 1'-0"

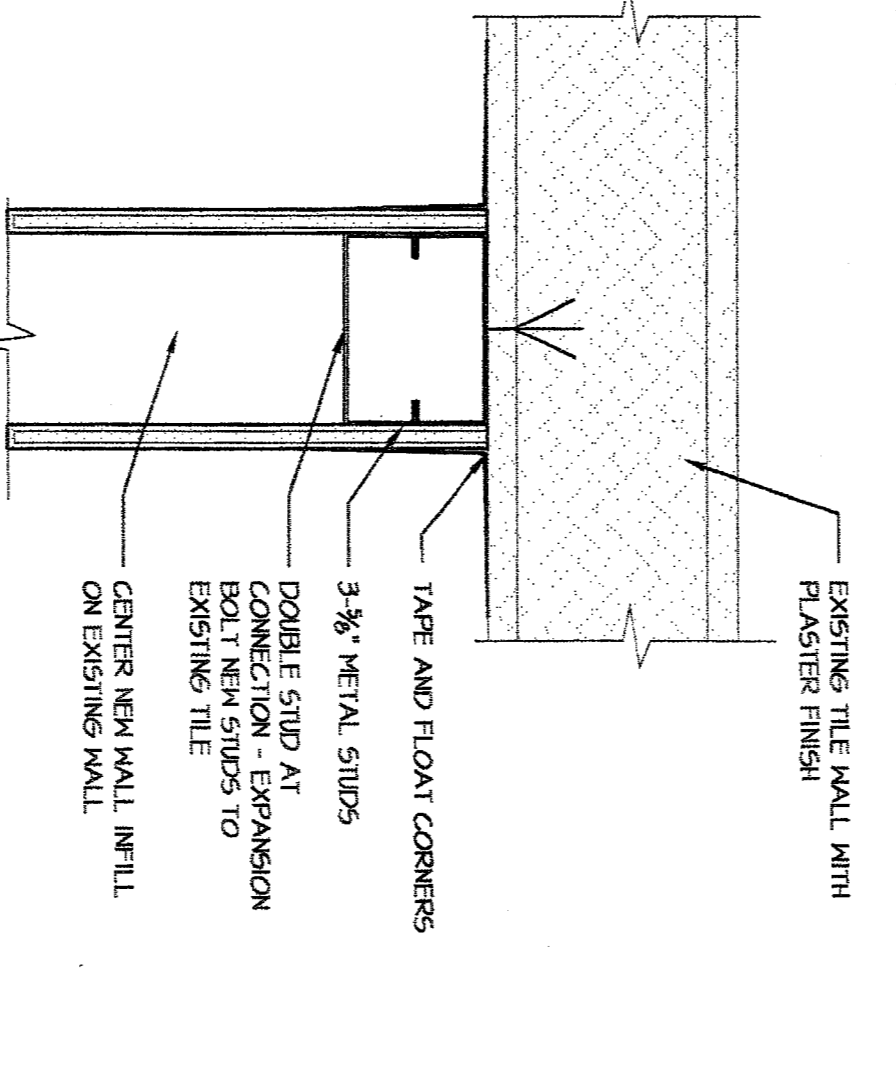


NEW WALL @ EXISTING WALL 18
09A021
SCALE: 3/8" = 1'-0"

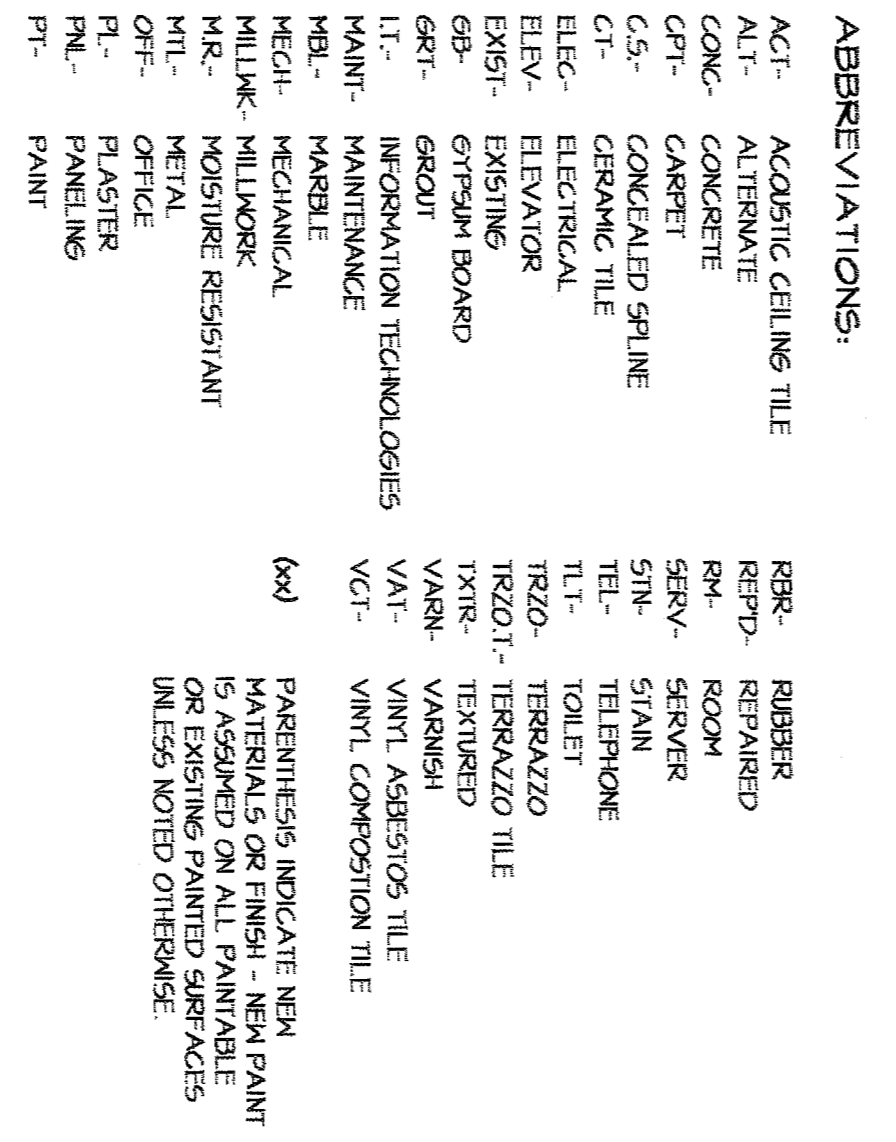


ABBREVIATION LEGEND

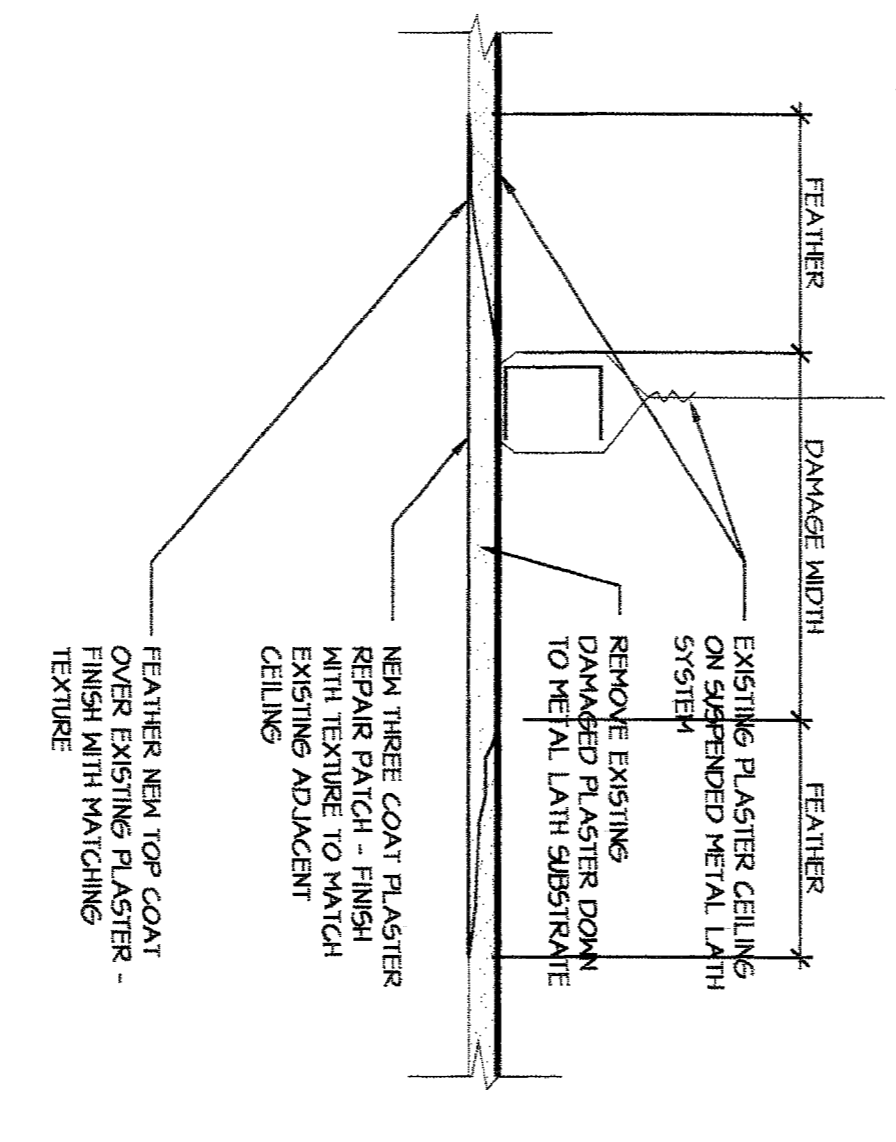

TYP. PLAST. CEILING REPAIR 10
09A029
SCALE: 3/8" = 1'-0"

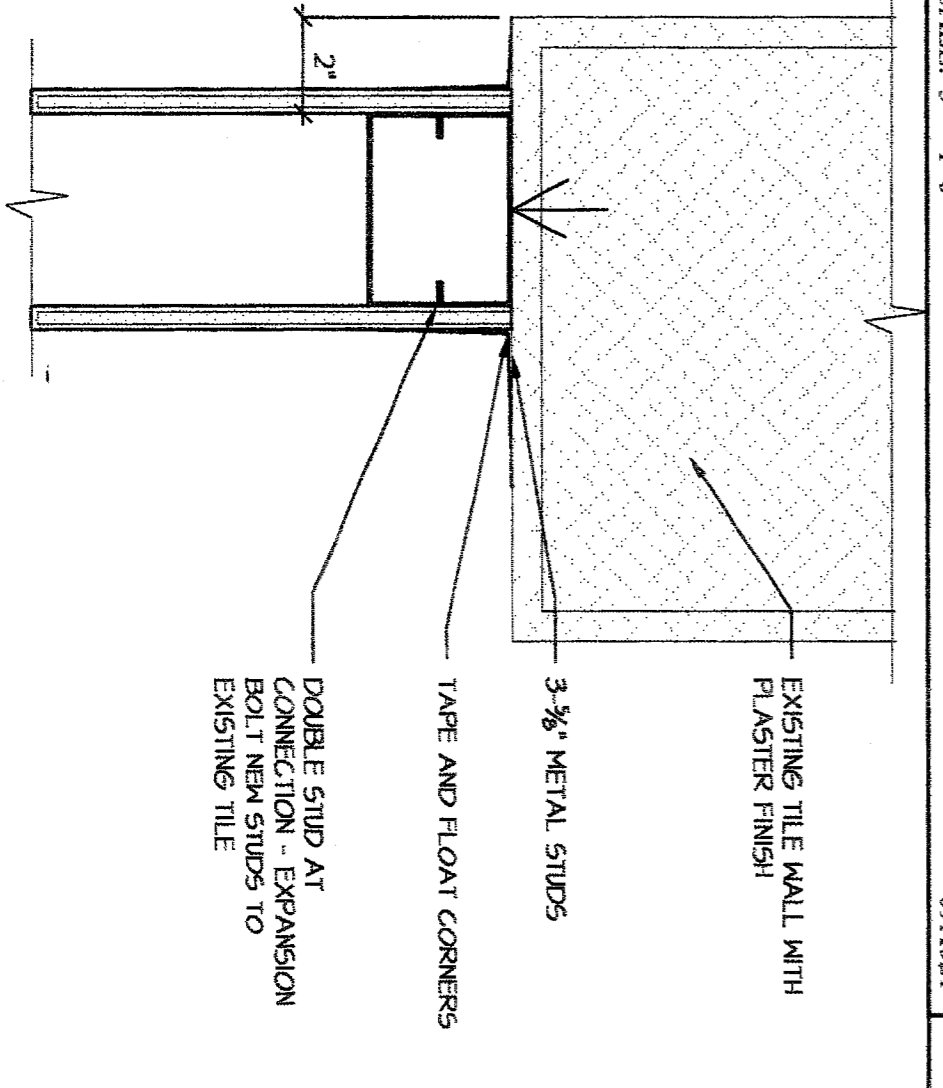

NEW WALL @ EXG. 12" WALL 17
09A020
SCALE: 3/8" = 1'-0"

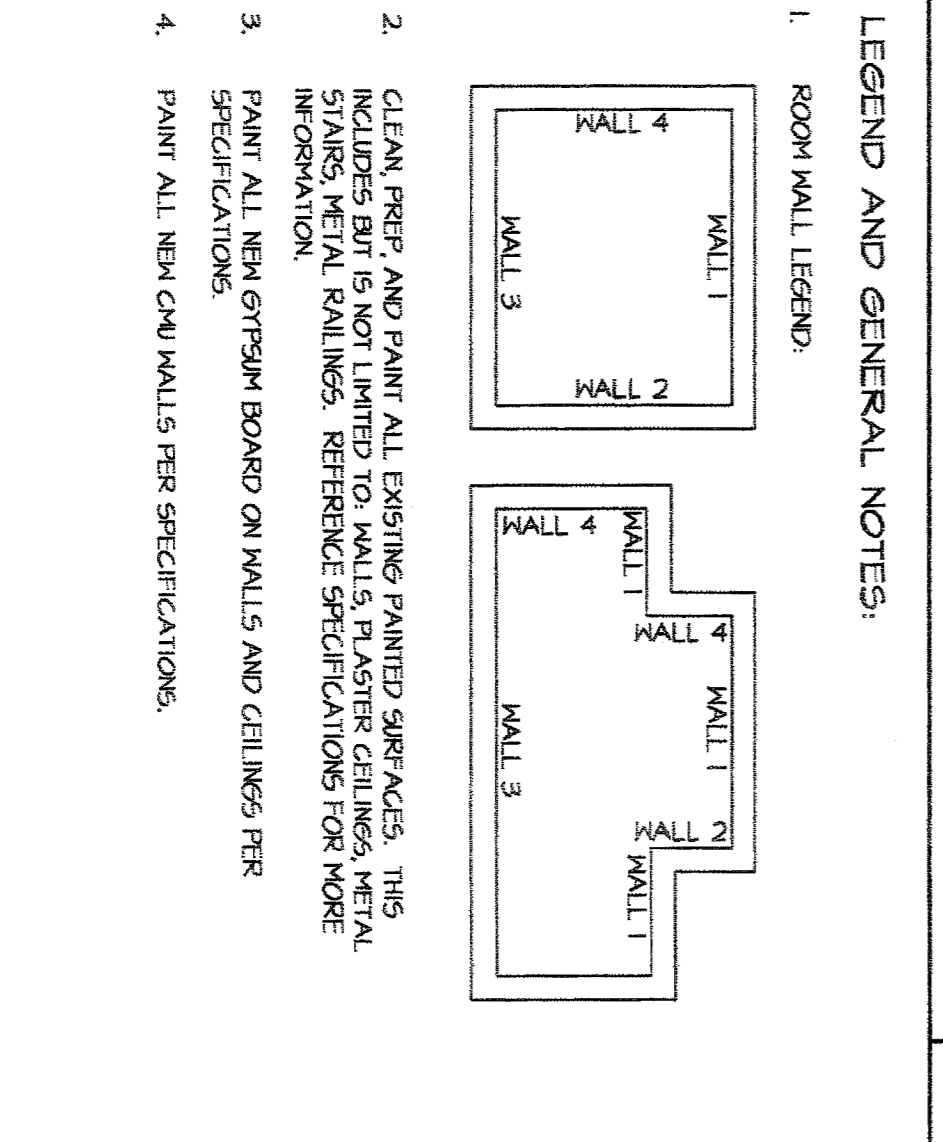

FINISH LEGEND AND NOTES

SCHEDULE NOTES:

- CLEAN, POLISH AND SEAL EXISTING MARBLE MANSCOT. INSTALL NEW GRANITE MANSCOT TO MATCH EXISTING.
- REMOVE MARBLE MANSCOT. CLEAN AND POLISH AS SPECIFIED.
- GRANITE TILE MANSCOT TO 3/4" AFF. - SEE INTERIOR TOILET ROOM ELEVATIONS ON SHEETS A102 & A103.
- REMOVE MARBLE MANSCOT. CLEAN AND POLISH AS SPECIFIED.
- CLEAN EXISTING MARBLE MANSCOT. REPAIR PLASTER WHERE IT MEETS THE ALUMINUM CAR AS SPECIFIED.
- REMOVE MARBLE MANSCOT AND MARBLE MANSCOT. CLEAN WITH A MILD DETERGENT. REPAIR PLASTER WHERE IT MEETS THE ALUMINUM CAR AS SPECIFIED.
- REMOVE MARBLE MANSCOT AND MARBLE MANSCOT. CLEAN WITH A MILD DETERGENT. REPAIR PLASTER WHERE IT MEETS THE ALUMINUM CAR AS SPECIFIED.
ROOM NAME	EXISTING FLOOR / (NEW FLOOR)	EXISTING BASE / (NEW BASE)	WALLS				TRIM	EXIST. CEILING / (NEW CEILING)	REMARKS
			1	2	3	4			
000 STAIR	GRIT (RBR / RBR)	NONE (RBR)	FI	FI	FI	FI	FI	CLEAN PLASTER WALL	
001 MECHANICAL ELECTRICAL	CONC	MTL (RBR)	FI	FI	FI	FI	FI	NOTE: II	
004 VISITABLE	CONC	MTL	FI	FI	FI	FI	FI	CLEAN PLASTER	
005 CORRIDOR	CONC	MTL	FI	FI	FI	FI	FI	NOTE: I	
006 CORRIDOR	CONC	RBR	CAU	CAU	CAU	CAU	CAU	NOTE: II	
007 JUNIOR	VCT	RBR	CAU	CAU	CAU	CAU	CAU	NOTE: III	
008 MECHANICAL ELECTRICAL	CONC	MTL (RBR)	FI	FI	FI	FI	FI	NOTE: IV	
009 ELECTRICAL	CONC	MTL	FI	FI	FI	FI	FI	NOTE: V	
010 STORAGE	CONC	MTL	FI	FI	FI	FI	FI	NOTE: VI	
011 CORRIDOR	CONC	MTL	FI	FI	FI	FI	FI	NOTE: VII	
012 STORAGE	CONC	MTL	FI	FI	FI	FI	FI	NOTE: VIII	
013 STORAGE	CONC	MTL	FI	FI	FI	FI	FI	NOTE: IX	
014 MECHANICAL	VCT	RBR	CAU	CAU	CAU	CAU	CAU	NOTE: X	
015 CORRIDOR	CONC	MTL	FI	FI	FI	FI	FI	NOTE: XI	
016 MECHANICAL	VCT	RBR	CAU	CAU	CAU	CAU	CAU	NOTE: XII	
017 OFFICE	VCT	RBR	CAU	CAU	CAU	CAU	CAU	NOTE: XIII	
018 STORAGE	VCT	RBR	CAU	CAU	CAU	CAU	CAU	NOTE: XIV	
019 TITEL ROOM	VCT	RBR	CAU	CAU	CAU	CAU	CAU	NOTE: XV	
020 CORRIDOR	CONC	RBR	CAU	CAU	CAU	CAU	CAU	NOTE: XVI	
021 STAIR	CONC	RBR	CAU	CAU	CAU	CAU	CAU	NOTE: XVII	
022 CORRIDOR	CONC	RBR	CAU	CAU	CAU	CAU	CAU	NOTE: XVIII	
023 CORRIDOR	CONC	RBR	CAU	CAU	CAU	CAU	CAU	NOTE: XIX	
024 STORAGE	CONC	RBR	CAU	CAU	CAU	CAU	CAU	NOTE: XX	
025 STORAGE	CONC	RBR	CAU	CAU	CAU	CAU	CAU	NOTE: XXI	
026 STORAGE	CONC	RBR	CAU	CAU	CAU	CAU	CAU	NOTE: XXII	
027 MECHANICAL	CONC	RBR	CAU	CAU	CAU	CAU	CAU	NOTE: XXIII	
028 MECHANICAL	CONC	RBR	CAU	CAU	CAU	CAU	CAU	NOTE: XXIV	
029 MECHANICAL	CONC	RBR	CAU	CAU	CAU	CAU	CAU	NOTE: XXV	
030 MECHANICAL	CONC	RBR	CAU	CAU	CAU	CAU	CAU	NOTE: XXVI	
031 MECHANICAL	CONC	RBR	CAU	CAU	CAU	CAU	CAU	NOTE: XXVII	
032 MECHANICAL	CONC	RBR	CAU	CAU	CAU	CAU	CAU	NOTE: XXVIII	
033 MECHANICAL	CONC	RBR	CAU	CAU	CAU	CAU	CAU	NOTE: XXIX	
034 MECHANICAL	CONC	RBR	CAU	CAU	CAU	CAU	CAU	NOTE: XXX	

FINISH SCHEDULE
11
 BURNET COUNTY COURTHOUSE
 BURNET, TEXAS
 SCALE: 3/8" = 1'-0"

ROOM FINISH SCHEDULE & PLAN DETAILS
 Project:
BURNET COUNTY COURTHOUSE
 BURNET, TEXAS
 Date: 03/18/2012
 Drawn by: LCB
 Checked by: BID


REVISIONS

NO.	DESCRIPTION

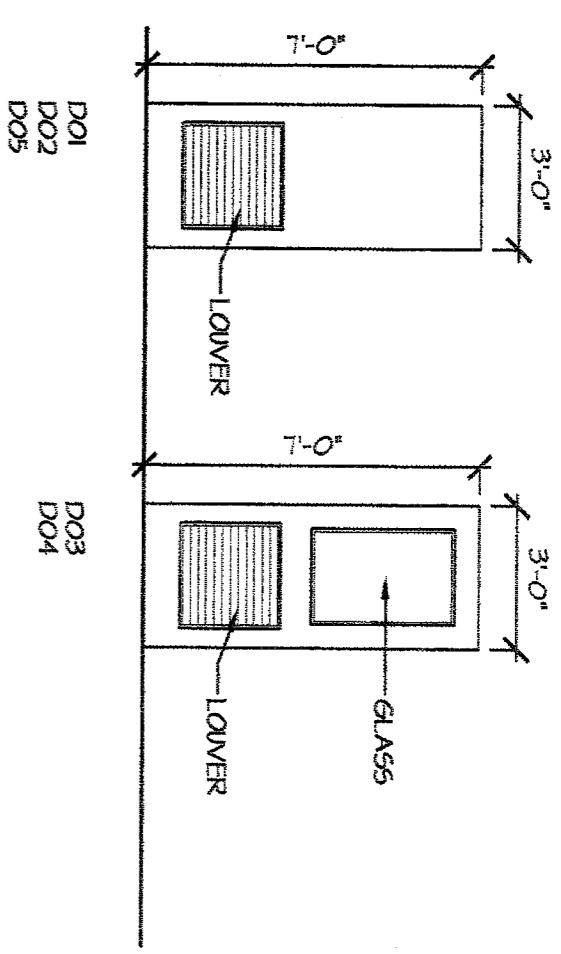


REMOVED SALVAGED DOOR TYPES

SCALE: 1/4" = 1'-0"

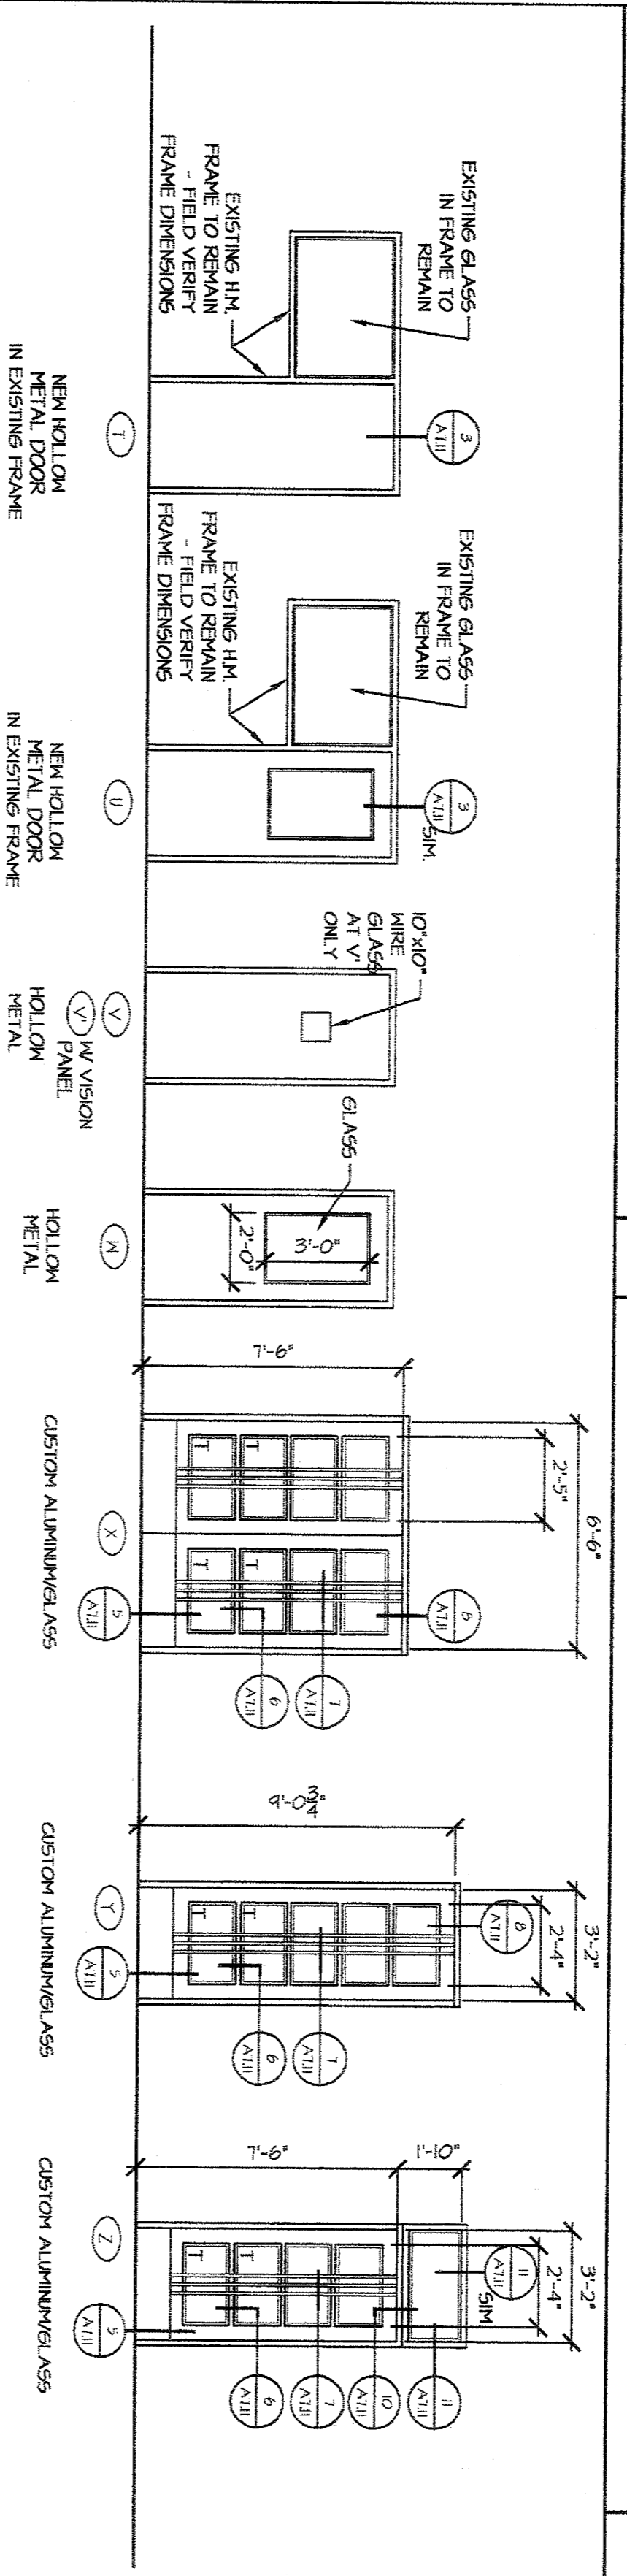

NEW DOOR TYPES

SCALE: 1/4" = 1'-0"

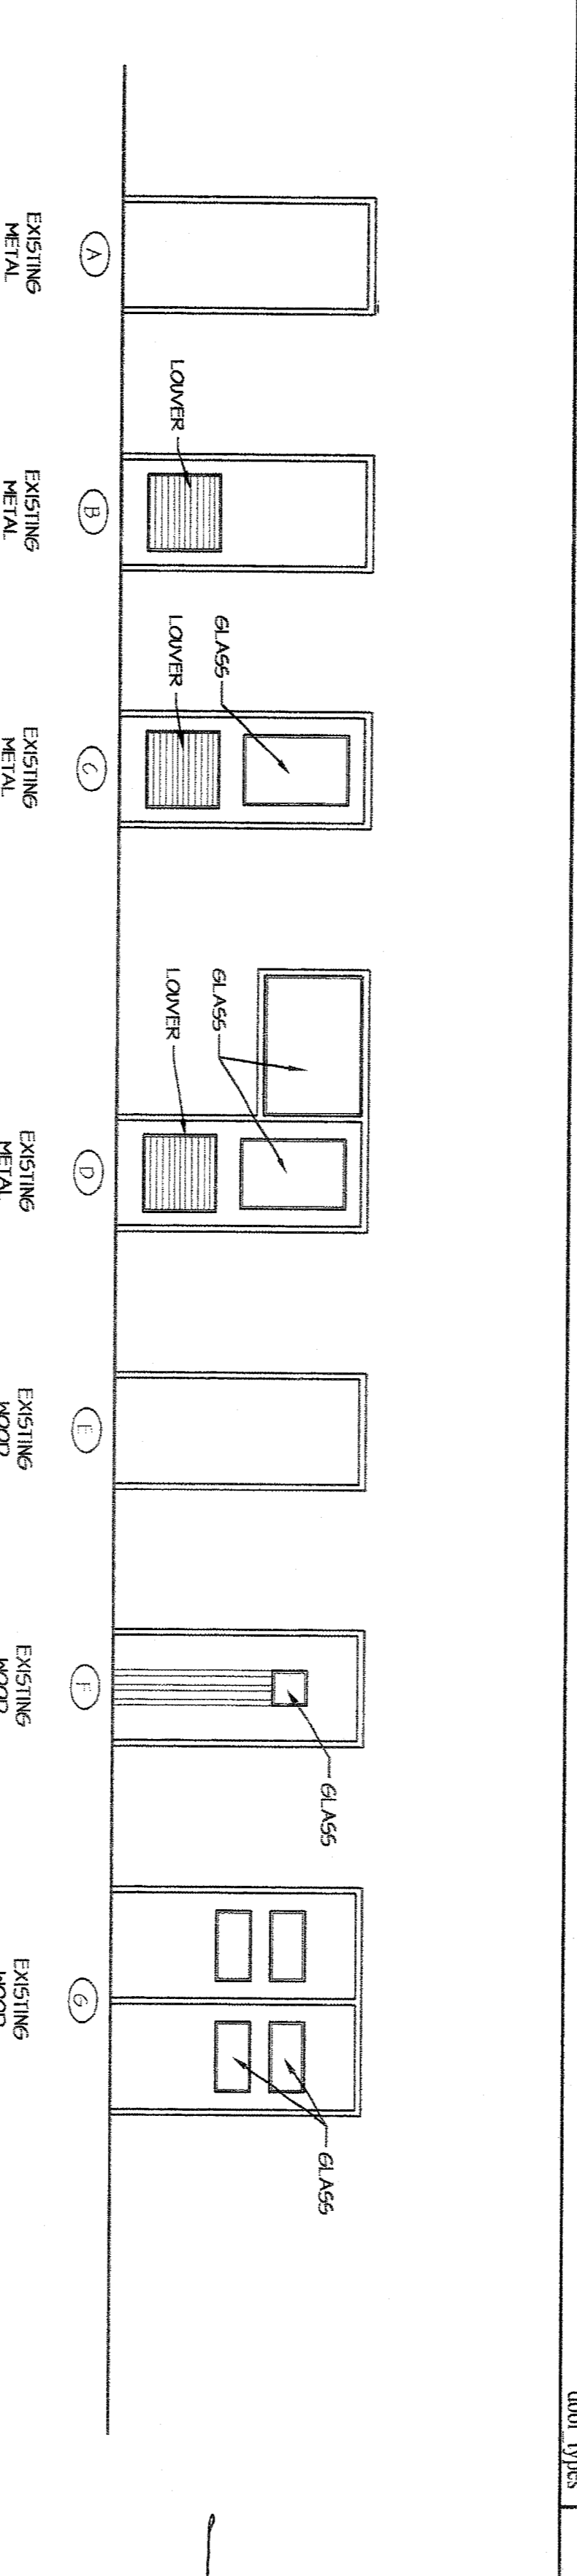

EXISTING REMAINING DOOR TYPES

SCALE: 1/4" = 1'-0"

- FINISH LEGEND**
- 1 PAINT EXISTING DOOR ALL SIDES AND EDGES PER SPECIFICATIONS
 - 2 PAINT NEW DOOR ALL SIDES AND EDGES PER SPECIFICATIONS
 - 3 EXISTING GLOSS COAT TO BE REMOVED - CLEAN DOOR SAND AND APPLY FILLER AS REQUIRED, AND APPLY NEW CLEAR COAT PER SPECIFICATIONS
 - 4 PAINT EXISTING SALVAGED DOOR ALL SIDES AND EDGES PER SPECIFICATIONS

- GENERAL NOTES**
- 1 REFERENCE SPECIFICATION FOR HARDWARE SCHEDULE
 - 2 ALL EXISTING DOORS THAT ARE BEING REMOVED AND ARE NOT SCHEDULED FOR RELOCATION ARE TO BE PROTECTED DURING REMOVAL, SALVAGE AND STORE PER COUNT DIRECTION
 - 3 DO NOT PAINT OVER REQUIRED UL AND FIRE RATING LABELS ON DOORS.
 - 4 EXISTING FRAME TO REMAIN.
 - 5 ALL DOORS SHALL REQUIRE A FORCE OF 5psi OR LESS TO OPEN PER ADA 413.11.
 - 6 ALL NEW AND EXISTING CLOSERS ON DOORS SHALL BE ADJUSTED TO TAKE MIN 3 SECONDS TO GO FROM 90° TO 3° FROM LATCH PER ADA 413.12.
 - 7 DOORS SHALL BE PROVIDED WITH LEVER HANDLES, SEE SPECIFICATIONS.

- HARDWARE NOTES**
- A REMOVE EXISTING HARDWARE FROM EXISTING DOOR. CLEAN & POLISH PER THE SPECIFICATIONS AND INSTALL IN NEW DOOR.
- B CLEAN & POLISH HARDWARE IN EXISTING DOOR PER THE SPECIFICATIONS AND RENEWAL.
- C REMOVE EXISTING HARDWARE. CLEAN & POLISH PER THE SPECIFICATIONS AND INSTALL IN EXISTING DOOR RELOCATED.
- D NEW HARDWARE. INSTALL IN NEW DOOR. REFERENCE HARDWARE SCHEDULE IN SPECIFICATION.

DOOR SALVAGE SCHEDULE

DOOR MARK	SIZE	TRANSOM	FINISH	HWR	REMARKS
D01	3'-0"X1'-0"X1'-3/4"	-	4		
D02	3'-0"X1'-0"X1'-3/4"	-	4		
D03	NOT USED	-	4		
D04	3'-0"X1'-0"X1'-3/4"	-	4		
D05	3'-0"X1'-0"X1'-3/4"	-	4		

DOOR MARK	EXISTING DOOR RELOCATED	EXISTING DOOR RELOCATED	SIZE	DOOR TYPE	TRANSOM	DETAIL	HEAD	JAMB	SILL	RATING	FINISH	HARDWARE	REMARKS	
D01	✓		PR 3'-0"X1'-0"X1'-3/4"	V			1/4"X11"	1/4"X11"		20 MIN.	2	H1	D	
D02	✓		3'-0"X1'-0"X1'-3/4"	V			1/4"X11"	1/4"X11"		20 MIN.	2	H2	D	
D03	✓			V			1/4"X11"	1/4"X11"		20 MIN.	2	H3	D	
D04	✓		3'-0"X1'-0"X1'-3/4"	V			1/4"X11"	1/4"X11"		20 MIN.	2	H4	D	
D05	✓		3'-0"X1'-0"X1'-3/4"	V			1/4"X11"	1/4"X11"		20 MIN.	2	H5	D	

DOOR SCHEDULE

DOORSCHED

REVISIONS

DATE: 3/18/2022

DRAWN BY: LCB


PROJECT: BURNETT COUNTY COURTHOUSE, BURNETT, TEXAS

11


15

A7.10


HEAVEN THIERMANN ARCHITECTS INC. 8075 ROCK SLOTT 102, GEORGETOWN, TEXAS 78656, TEL: 512.869.1104, FAX: 512.869.1862

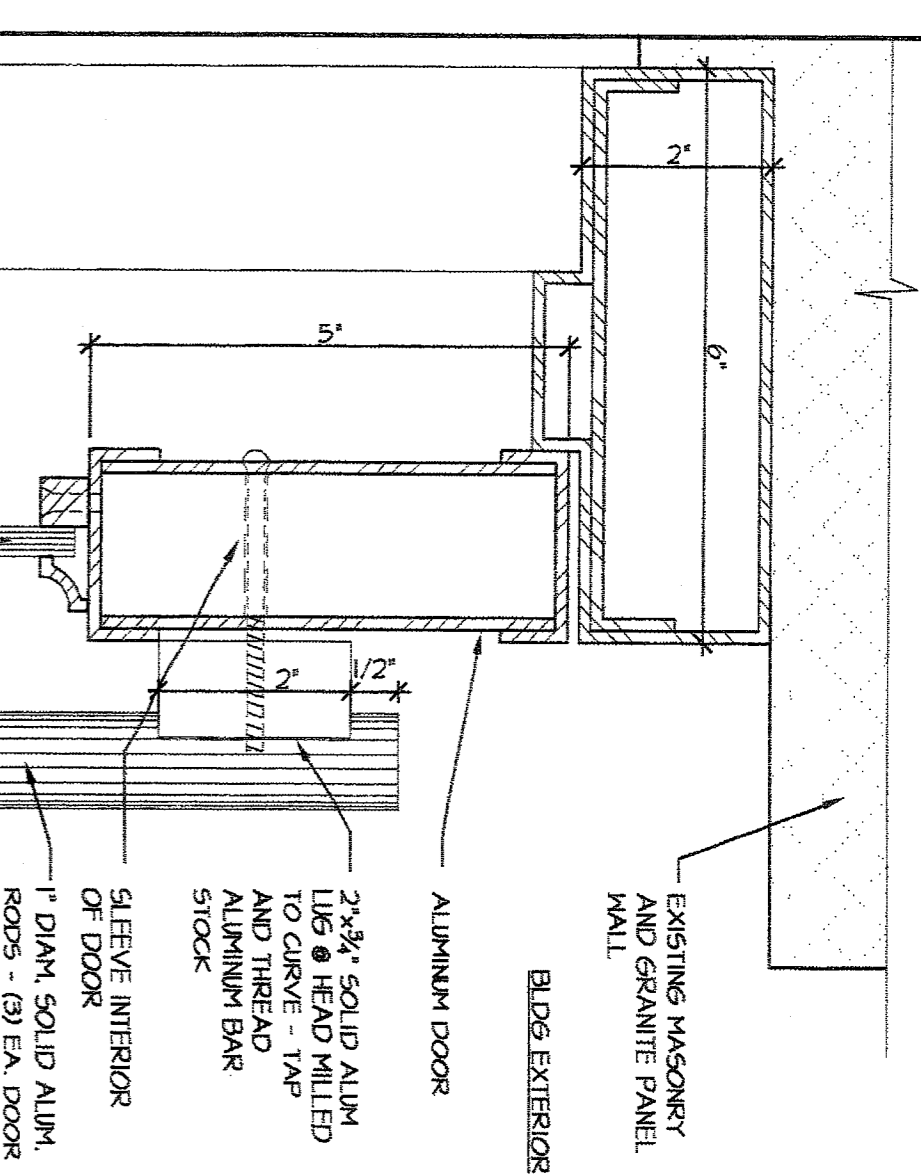


8 ALUM. DOOR HEAD/JAMB
SCALE: 6"=1'-0"
08A014

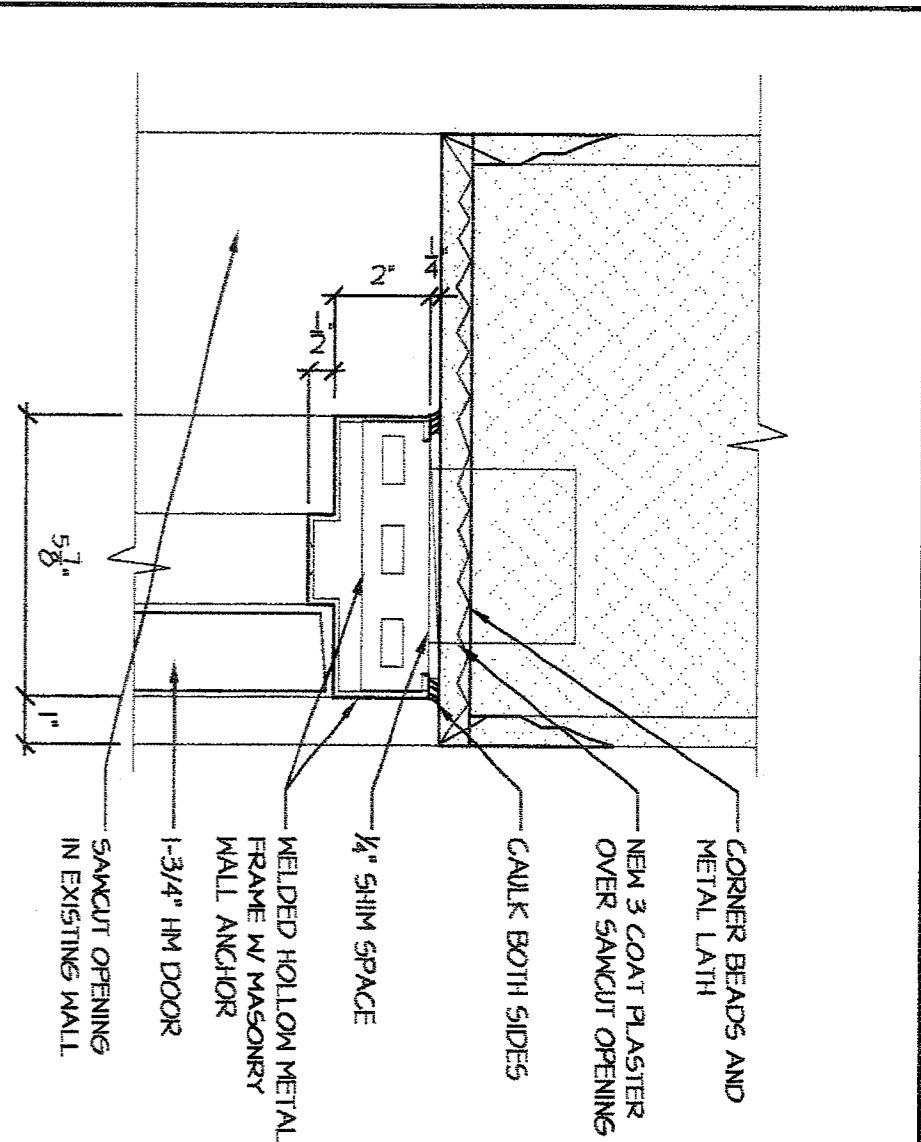


4 DOOR JAMB - HEAD SIM.
SCALE: 3"=1'-0"
08A012

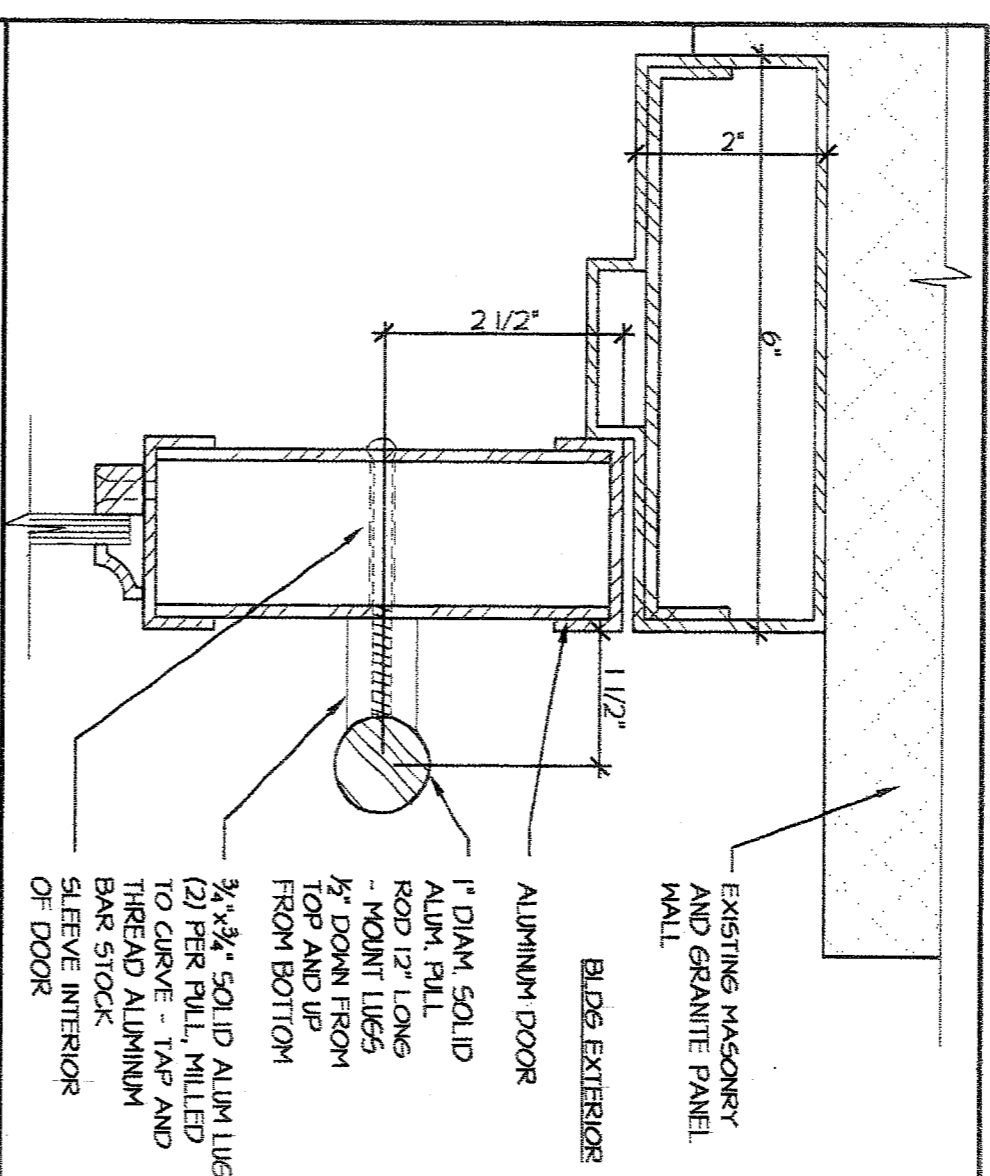


11 ALUMINUM DOOR PULL
SCALE: 6"=1'-0"
08A020

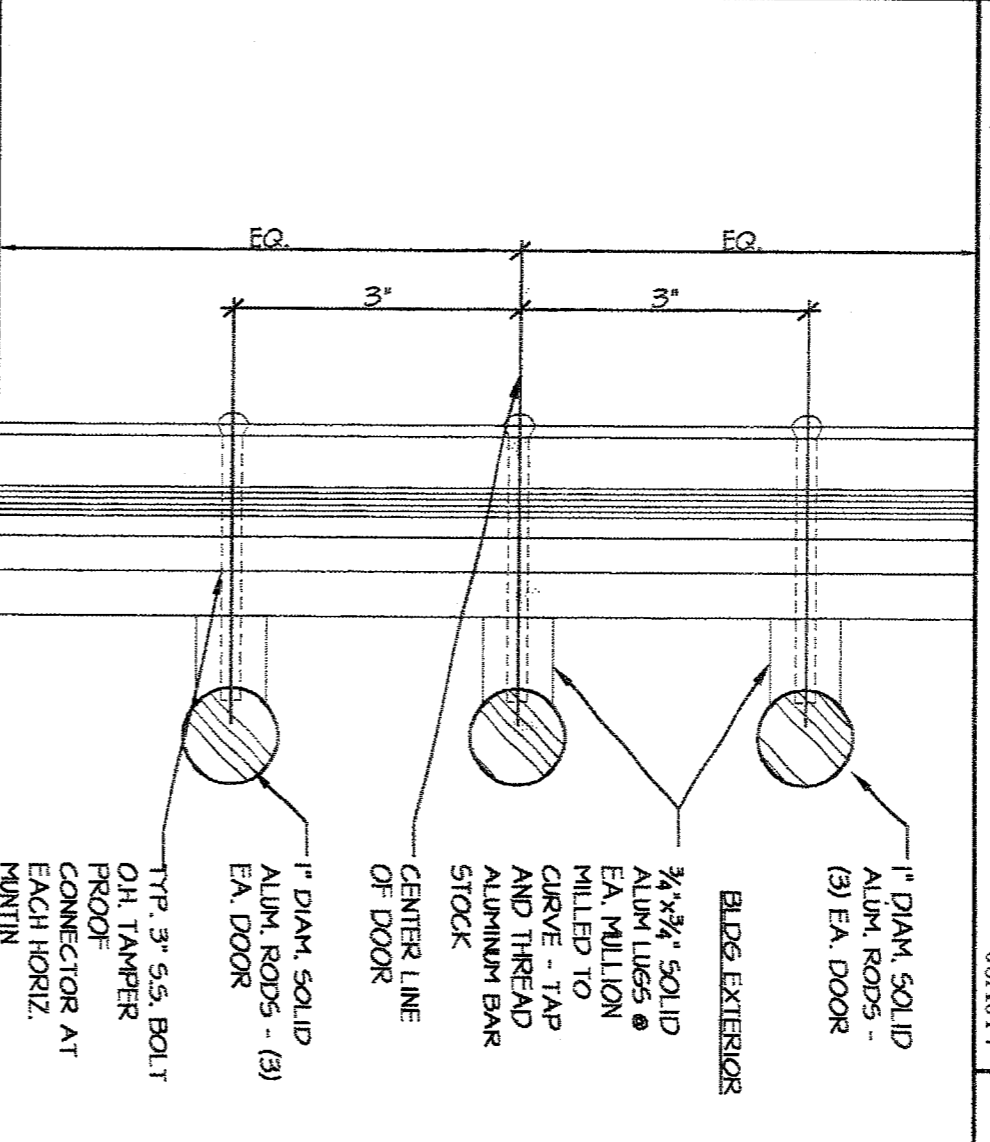


7 ALUMINUM TRIM SECTION
SCALE: 6"=1'-0"
08A014

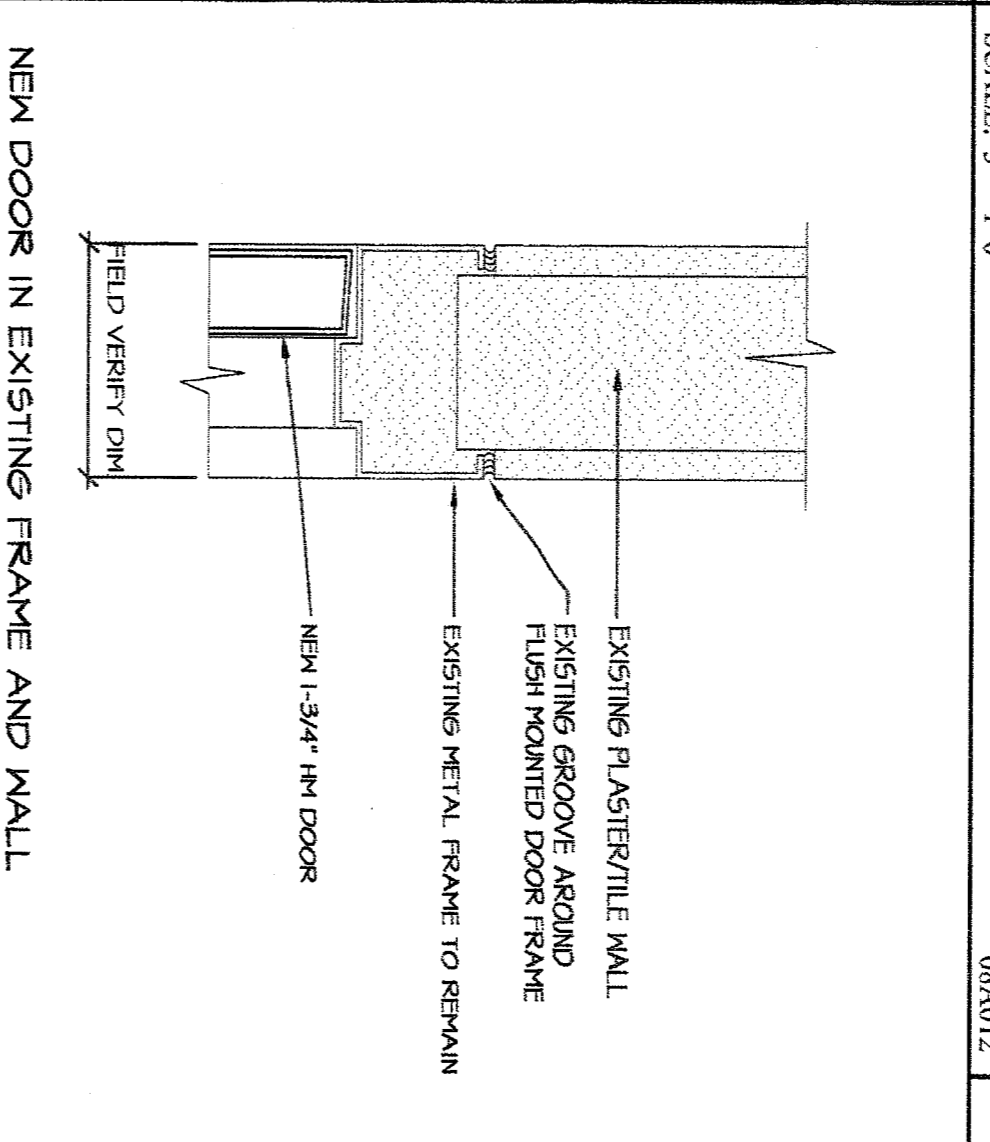


3 INT. H.M. DOOR HEAD/JAMB
SCALE: 3"=1'-0"
08A011

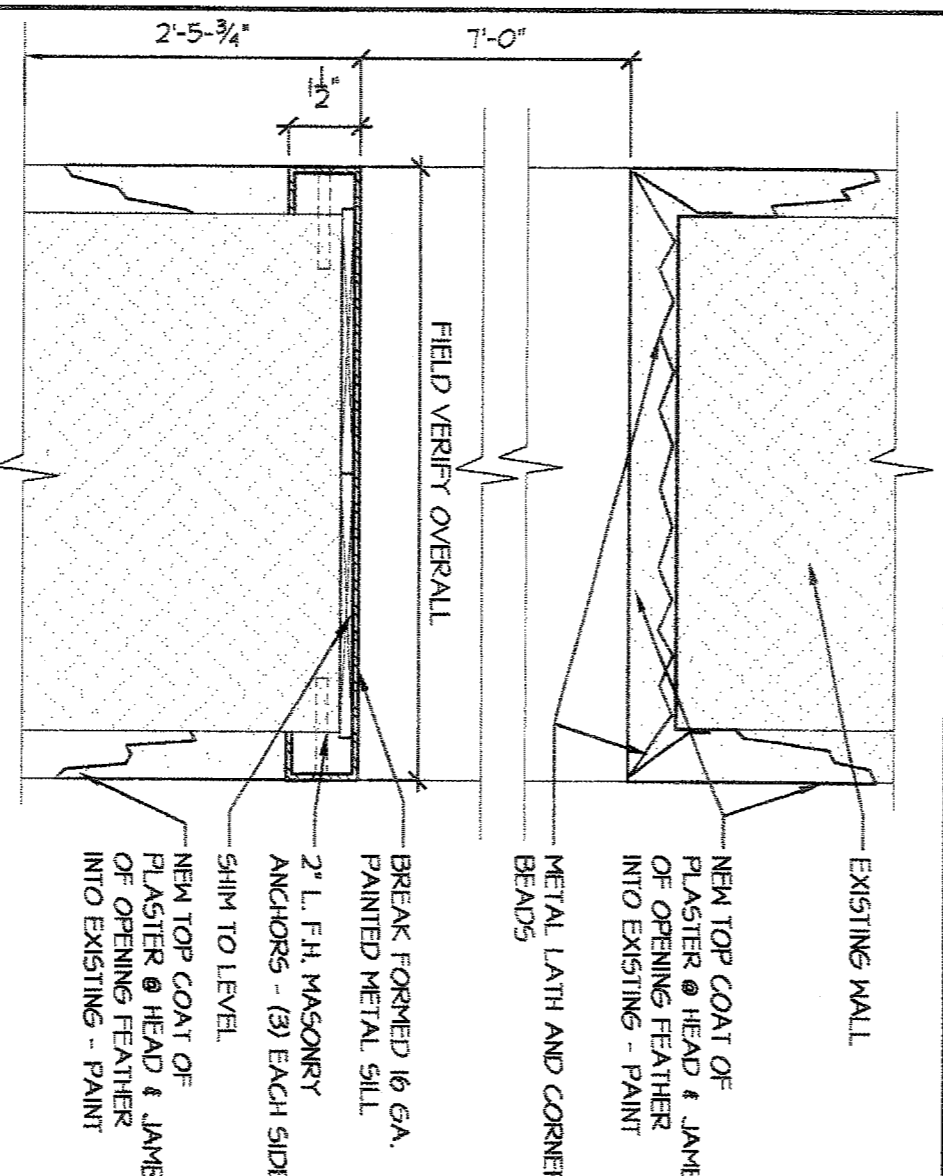


14 METAL SILL @ NEW OPENING
SCALE: 3"=1'-0"
08A019

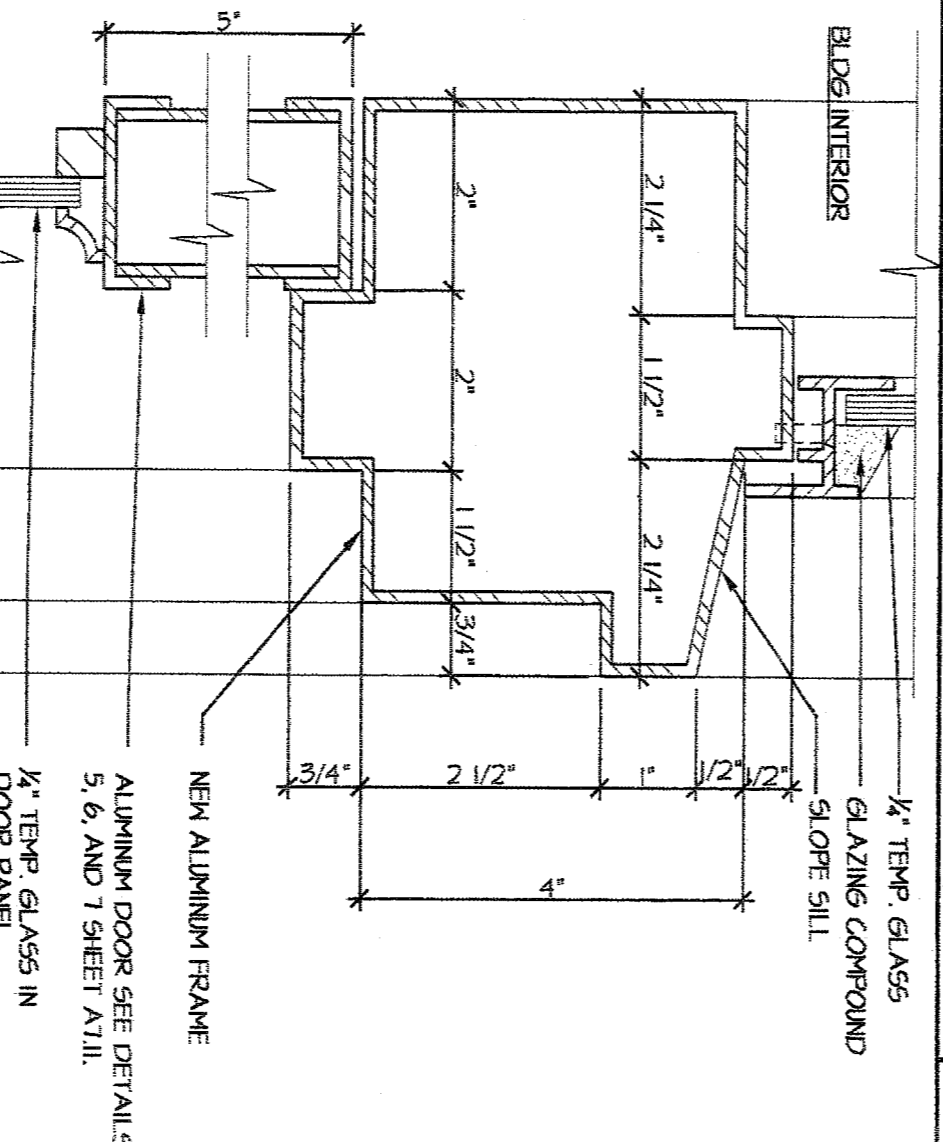


10 ALUM. DOOR TRANSOM
SCALE: 3"=1'-0"
08A014

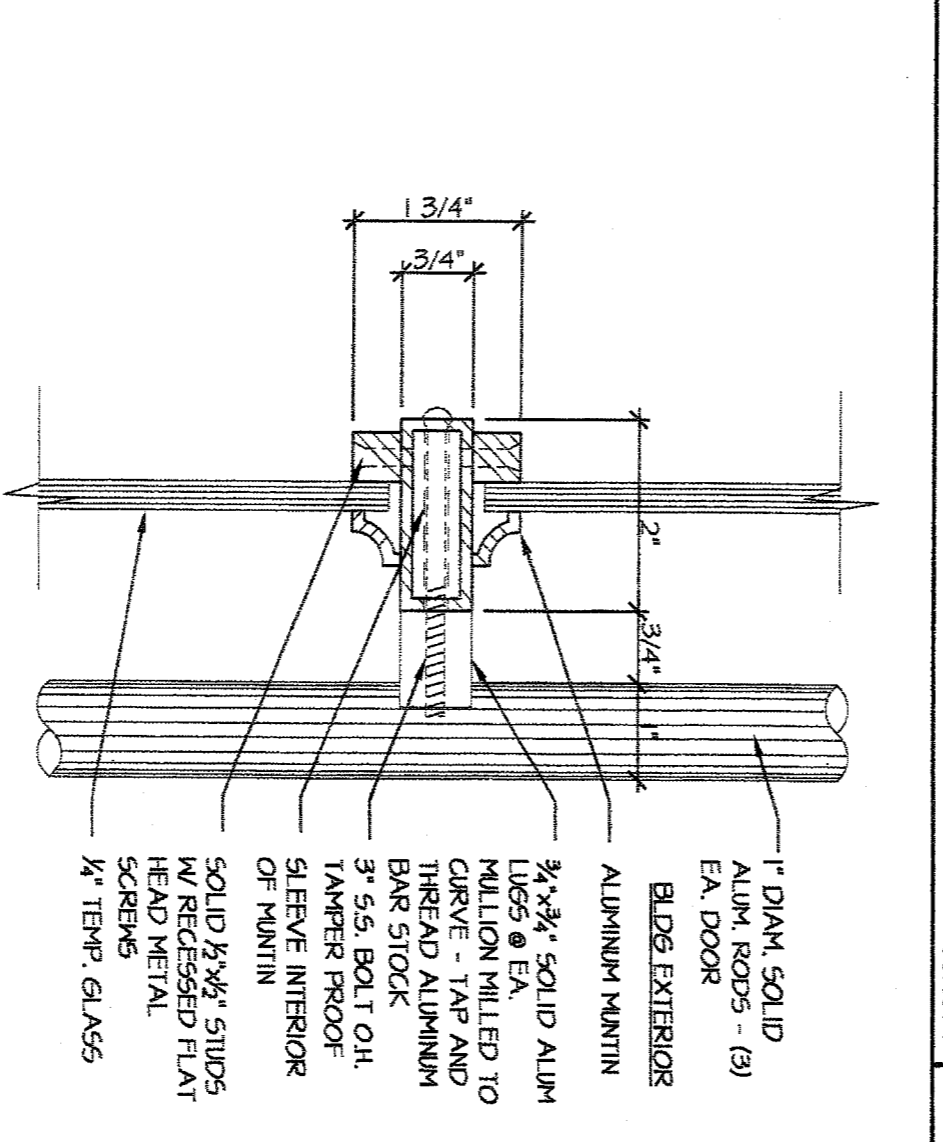


6 HORIZONTAL MUNTIN
SCALE: 6"=1'-0"
08A014

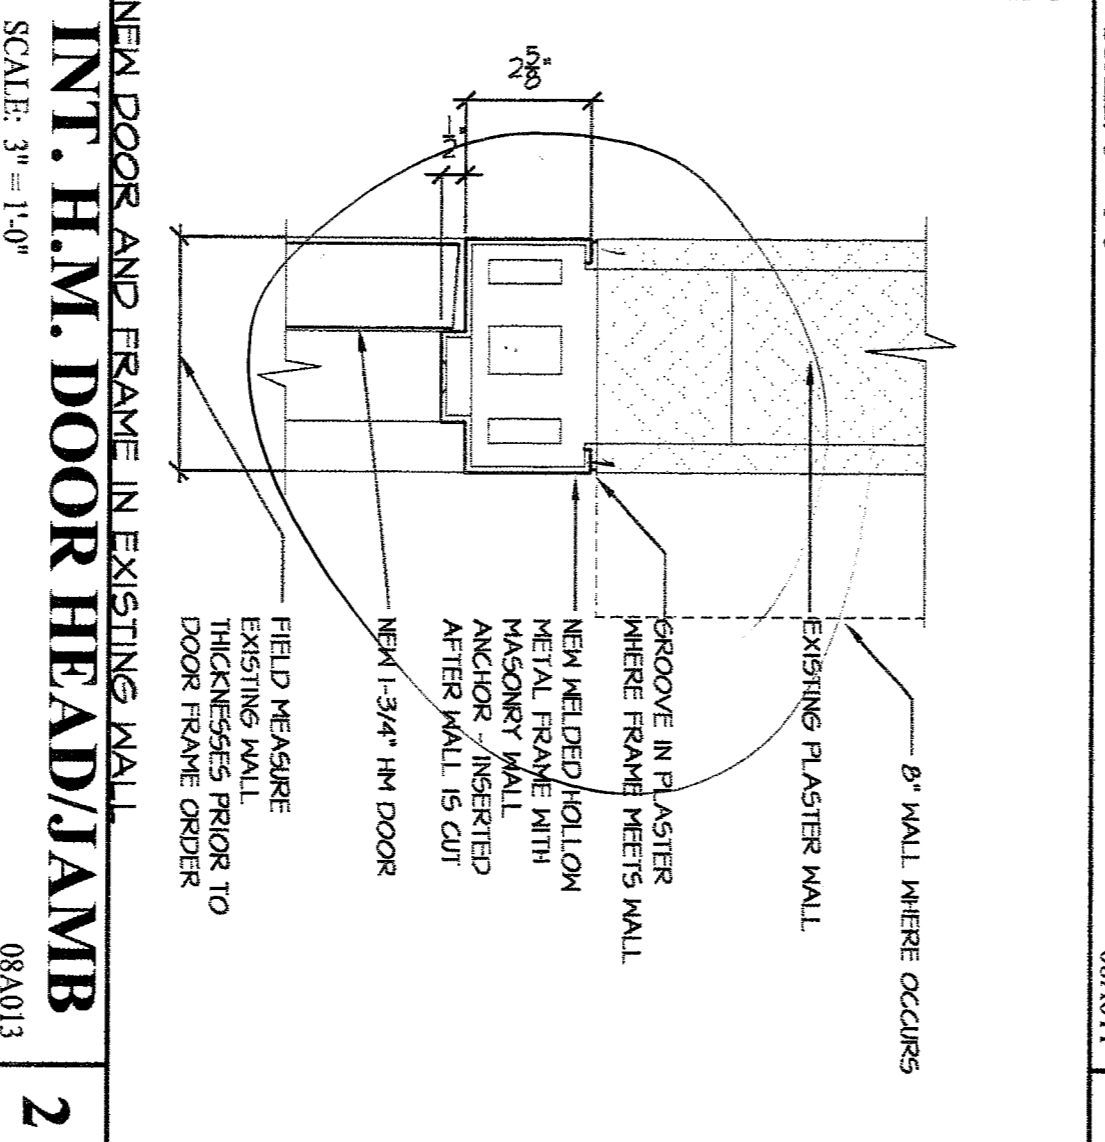


2 INT. H.M. DOOR HEAD/JAMB
SCALE: 3"=1'-0"
08A013

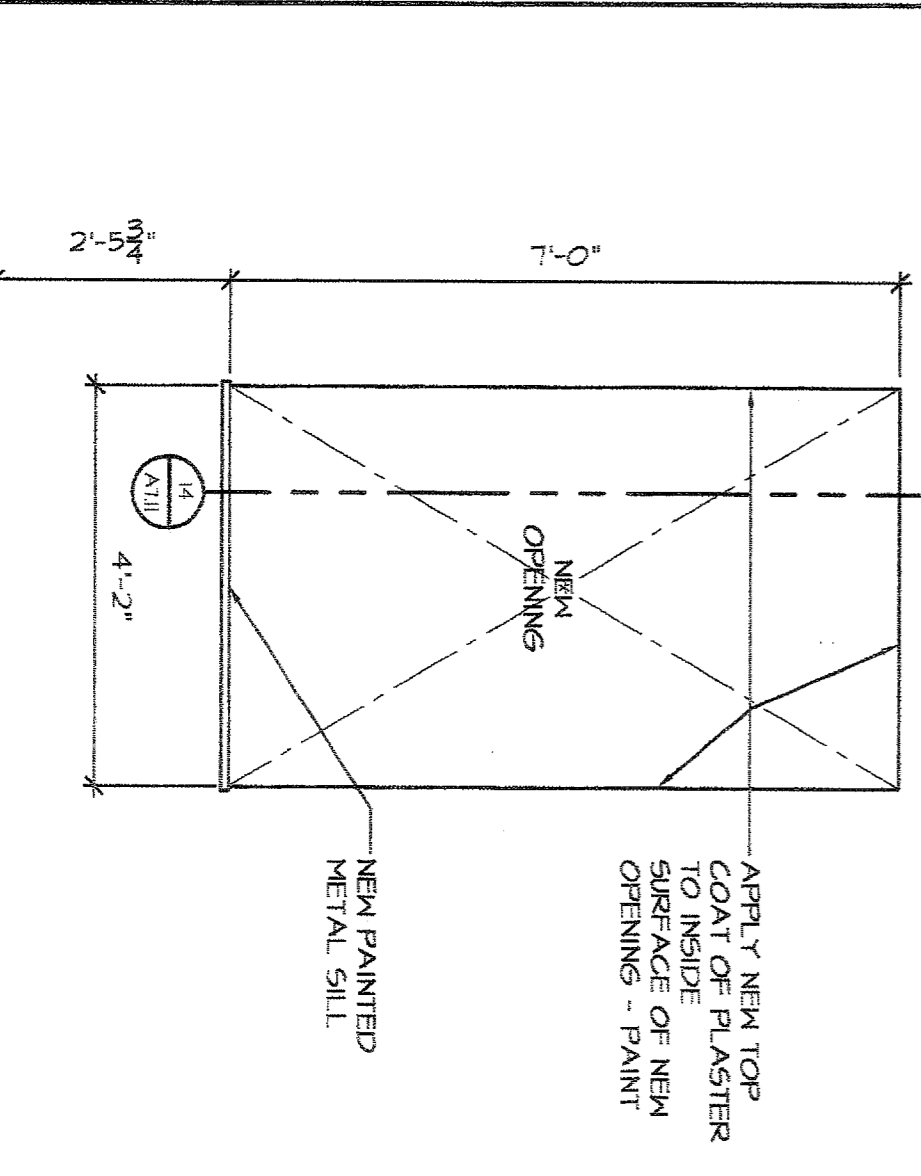


13 ELEVATION @ NEW OPENING
SCALE: 1/2"=1'-0"
08A018

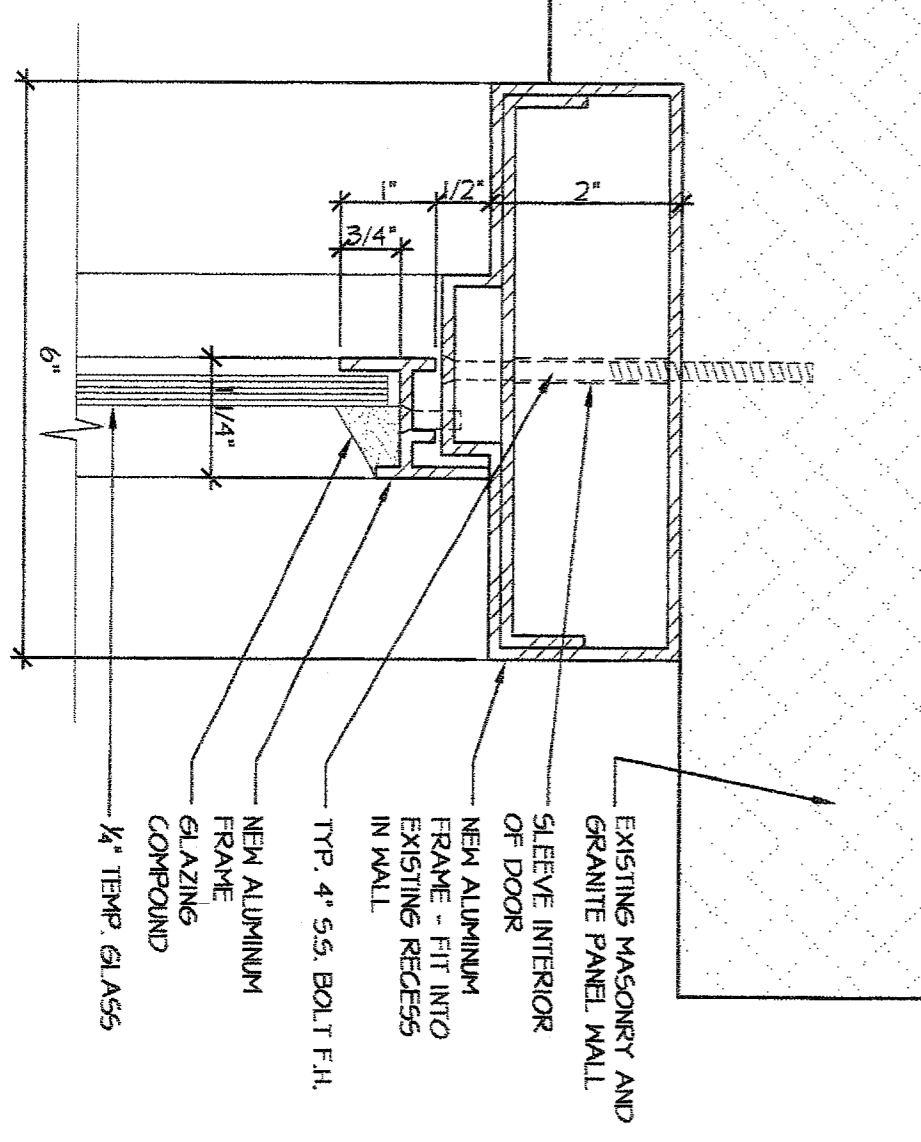

9 JAMB @ TRANSOM-HEAD SIM.
SCALE: 3"=1'-0"
08A014

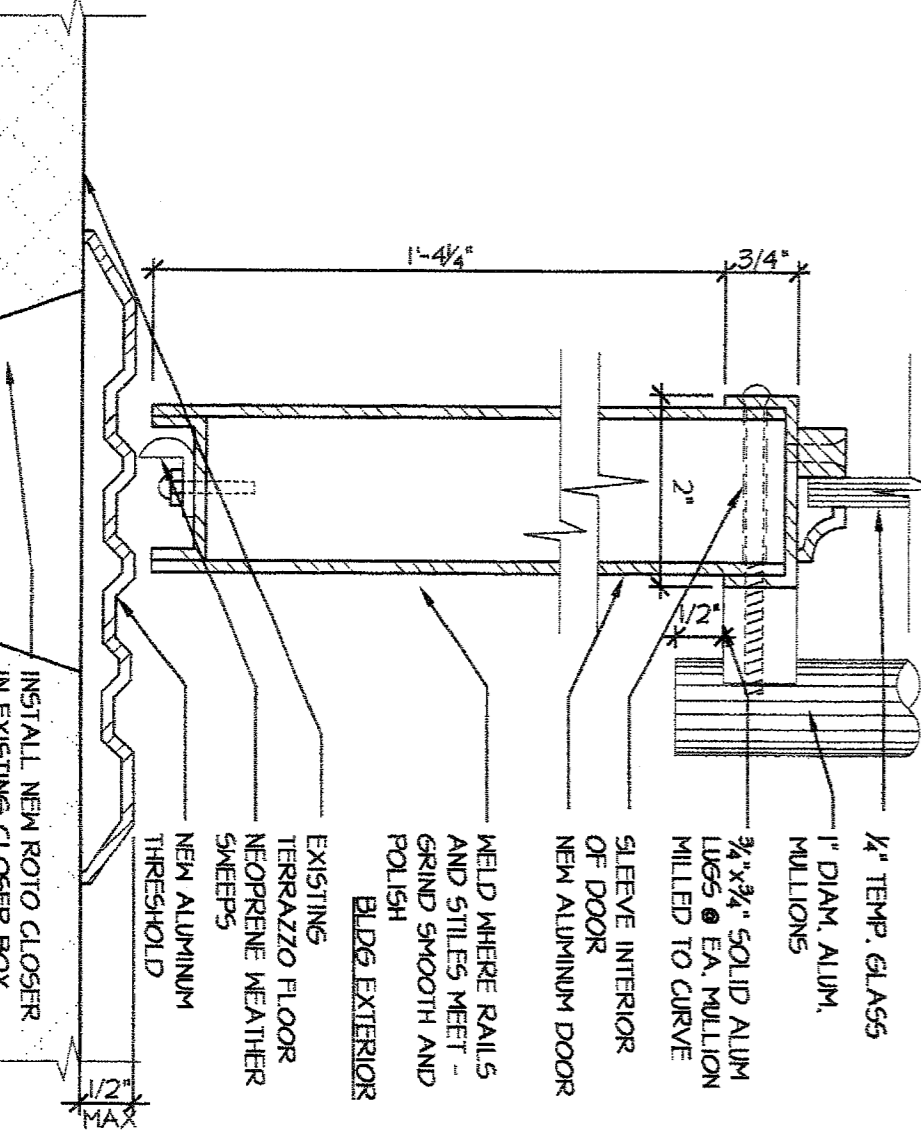

5 ALUM. DOOR THRESHOLD
SCALE: 6"=1'-0"
08A014

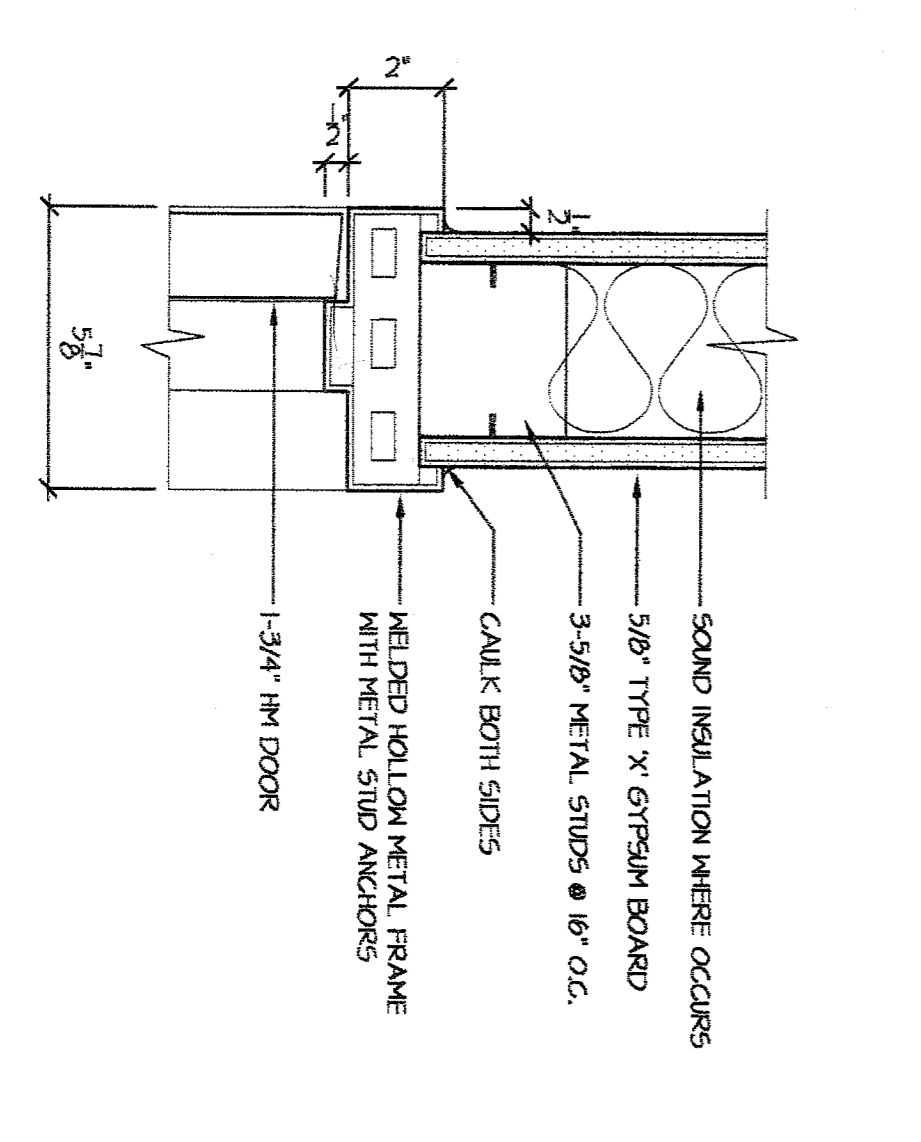

1 INT. H.M. DOOR HEAD/JAMB
SCALE: 3"=1'-0"
08A007


Sheet Title:
DOOR AND WINDOW DETAILS

Project:
BURNET COUNTY COURTHOUSE
BURNET, TEXAS




HELVON THRENTON ARCHITECTS INC.
807 S. ROCK STREET, 102
GROESBECK, TEXAS 78656
TEL 512.869.1104 FAX 512.869.1382


Date: 03/18/2002
Proj. #: **A7.11**
Drawn by: LCB
Issued for: BID

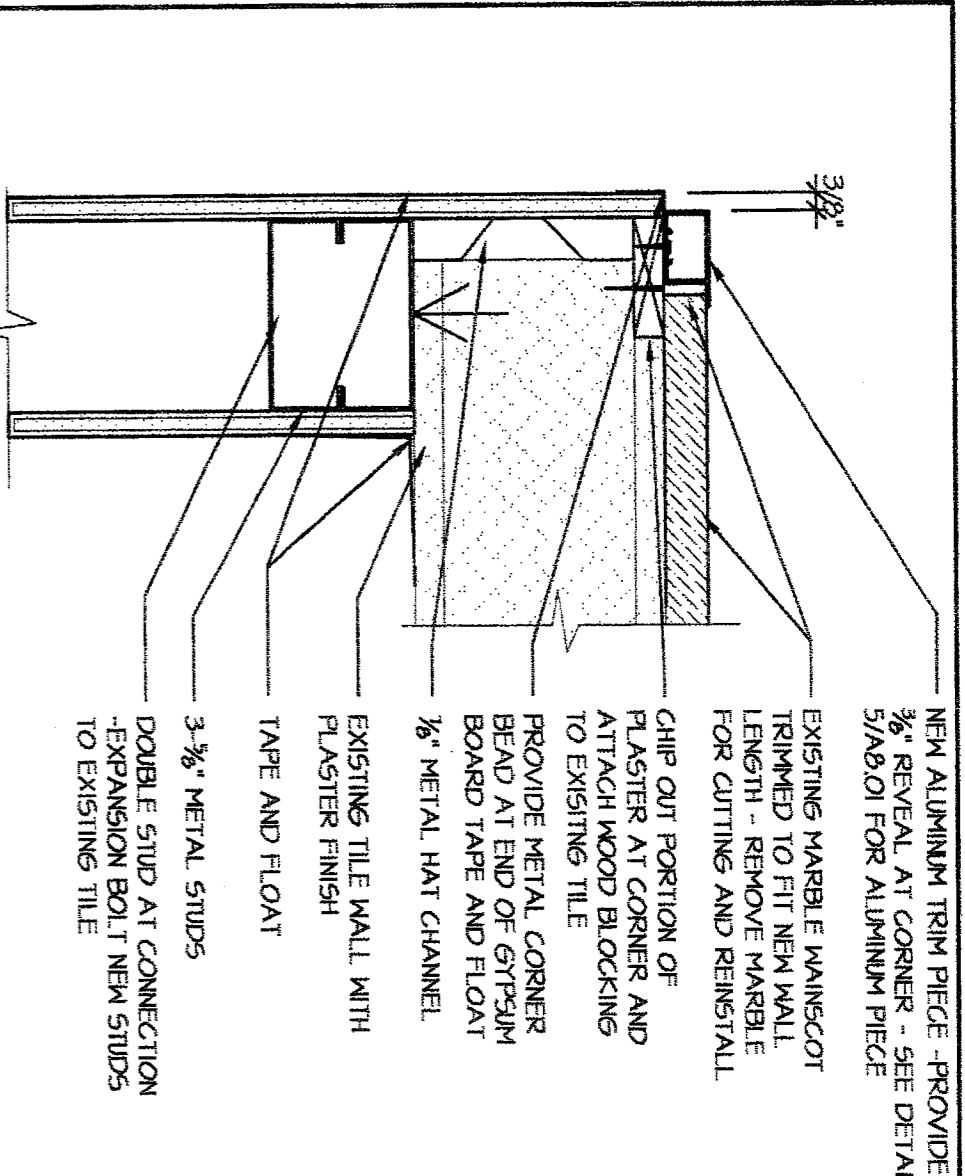


NEW WALL @ EXISTING WALL 20
SCALE: 3" = 1'-0"
09A007

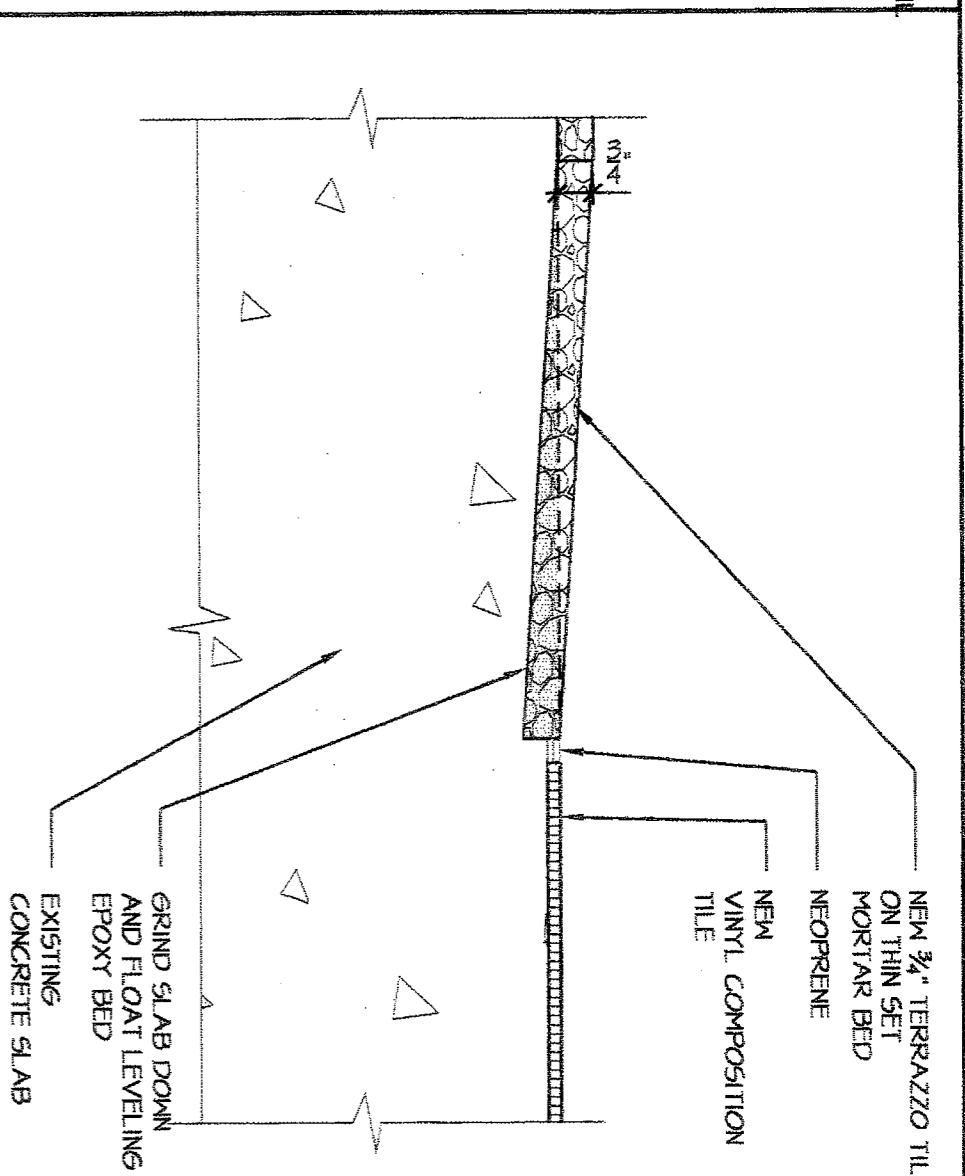


TERRAZZO TILE/VCT TRANS. 16
SCALE: 3" = 1'-0"
09A002

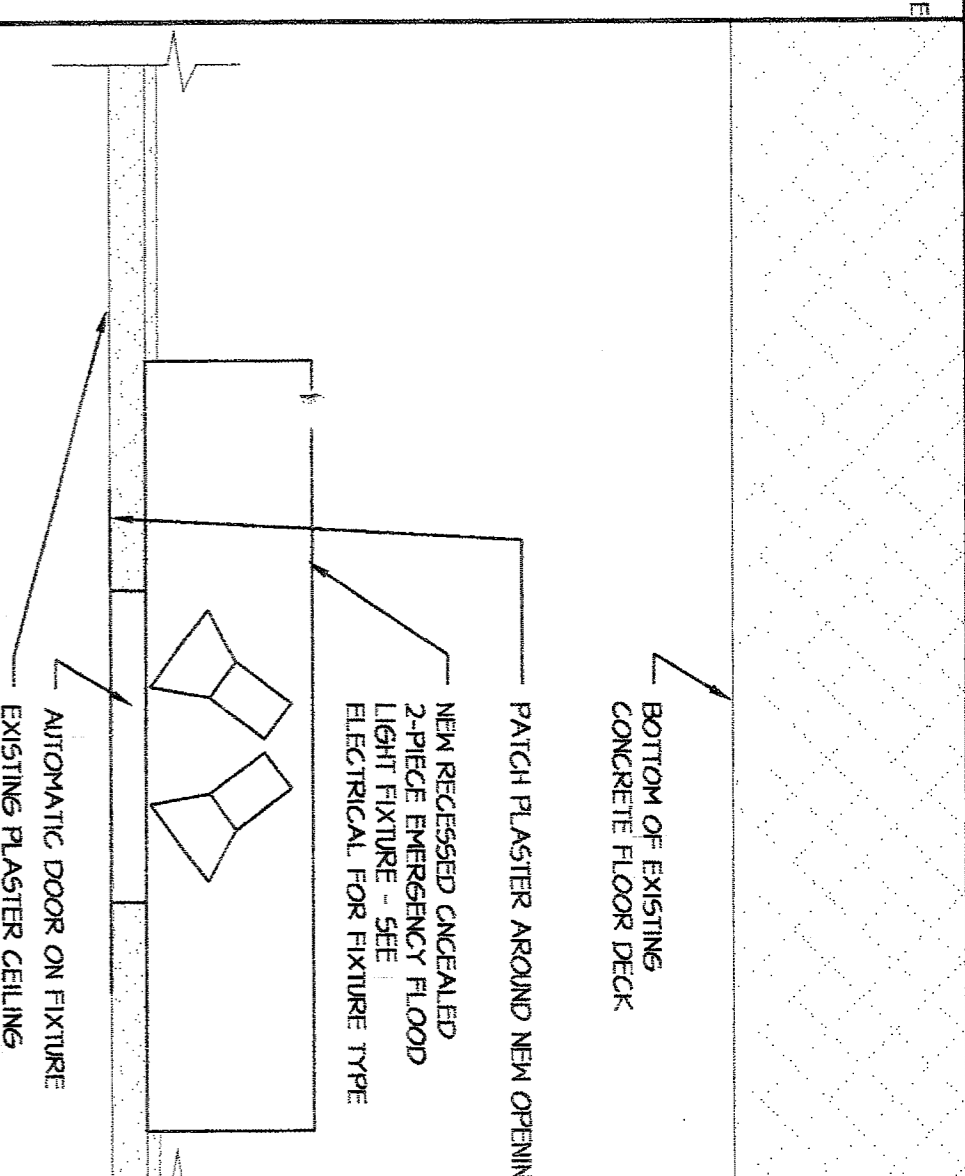


CONCEALED EMER. FIXTURE 12
SCALE: 3" = 1'-0"
09A013

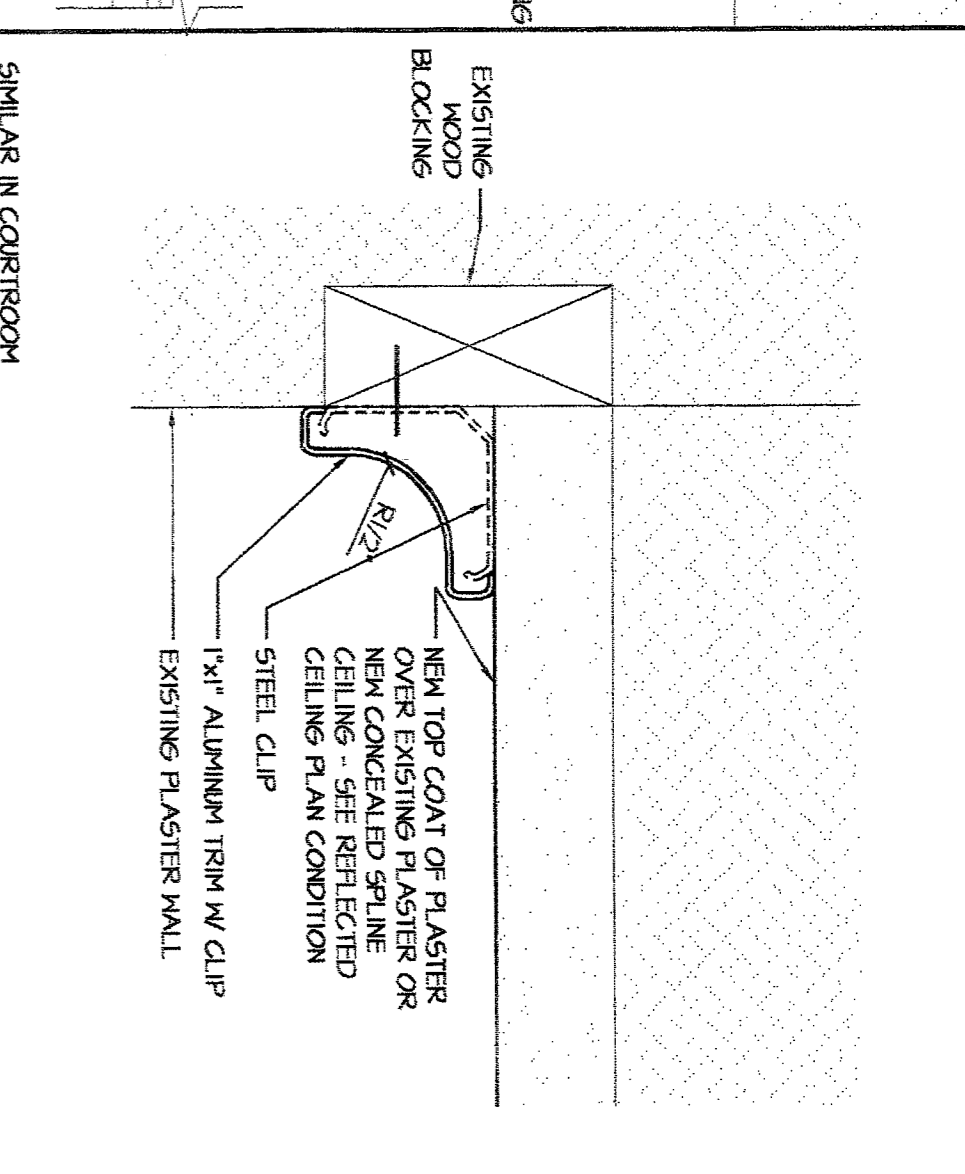


NEW ALUMINUM MOULDING 8
SCALE: FULL SCALE
05A006

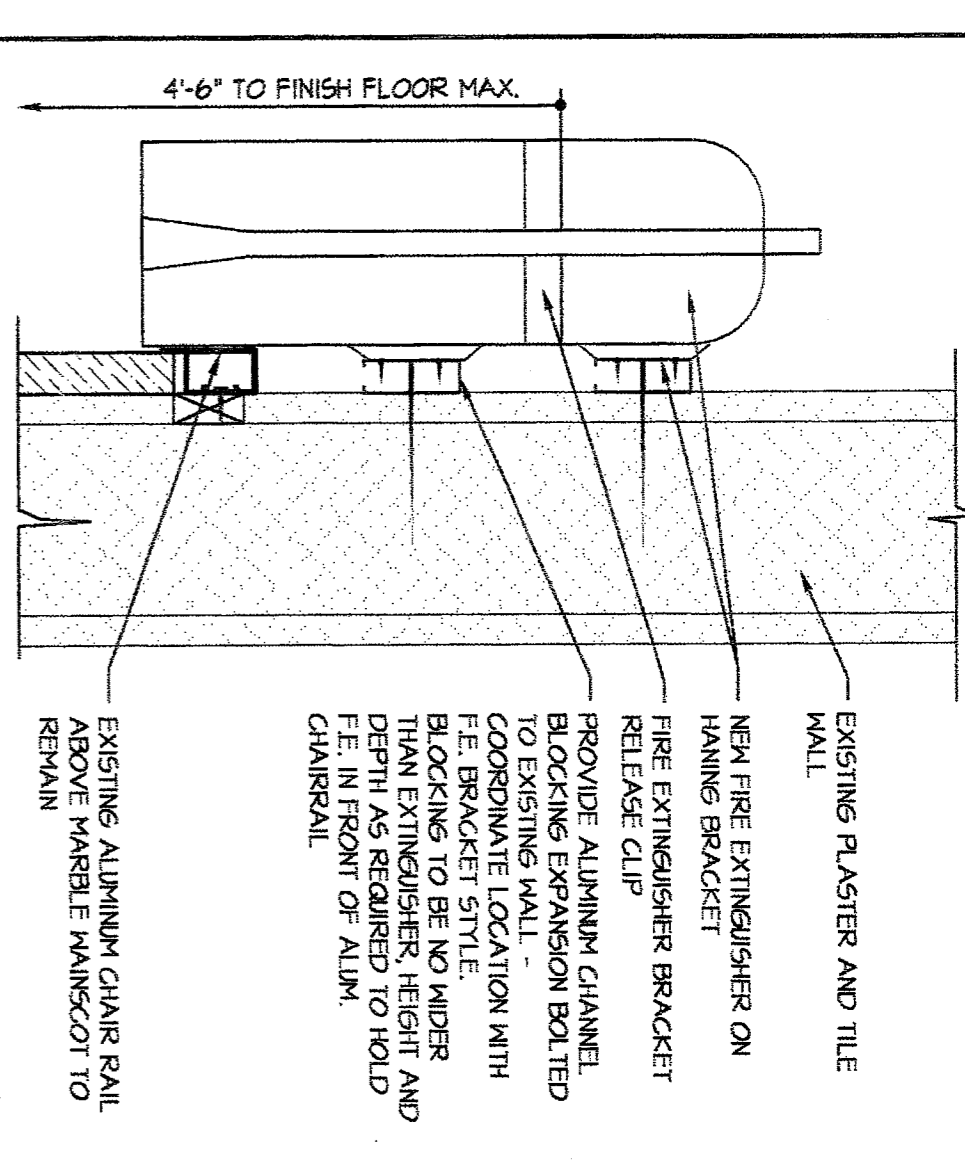


FIRE EXTING. BRACKET 4
SCALE: 3" = 1'-0"
10A006

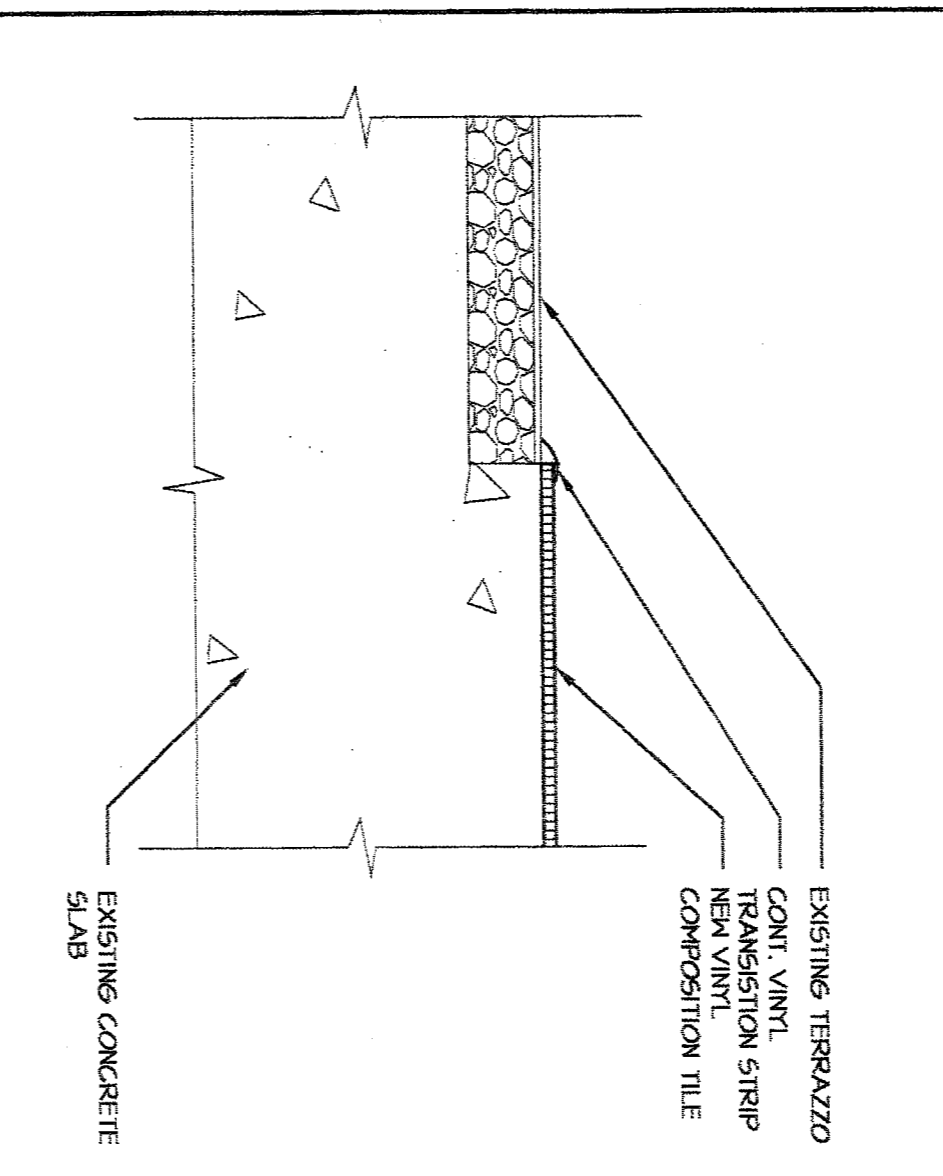


EXG. TERRAZZO/VCT TRANS 19
SCALE: 3" = 1'-0"
09A014

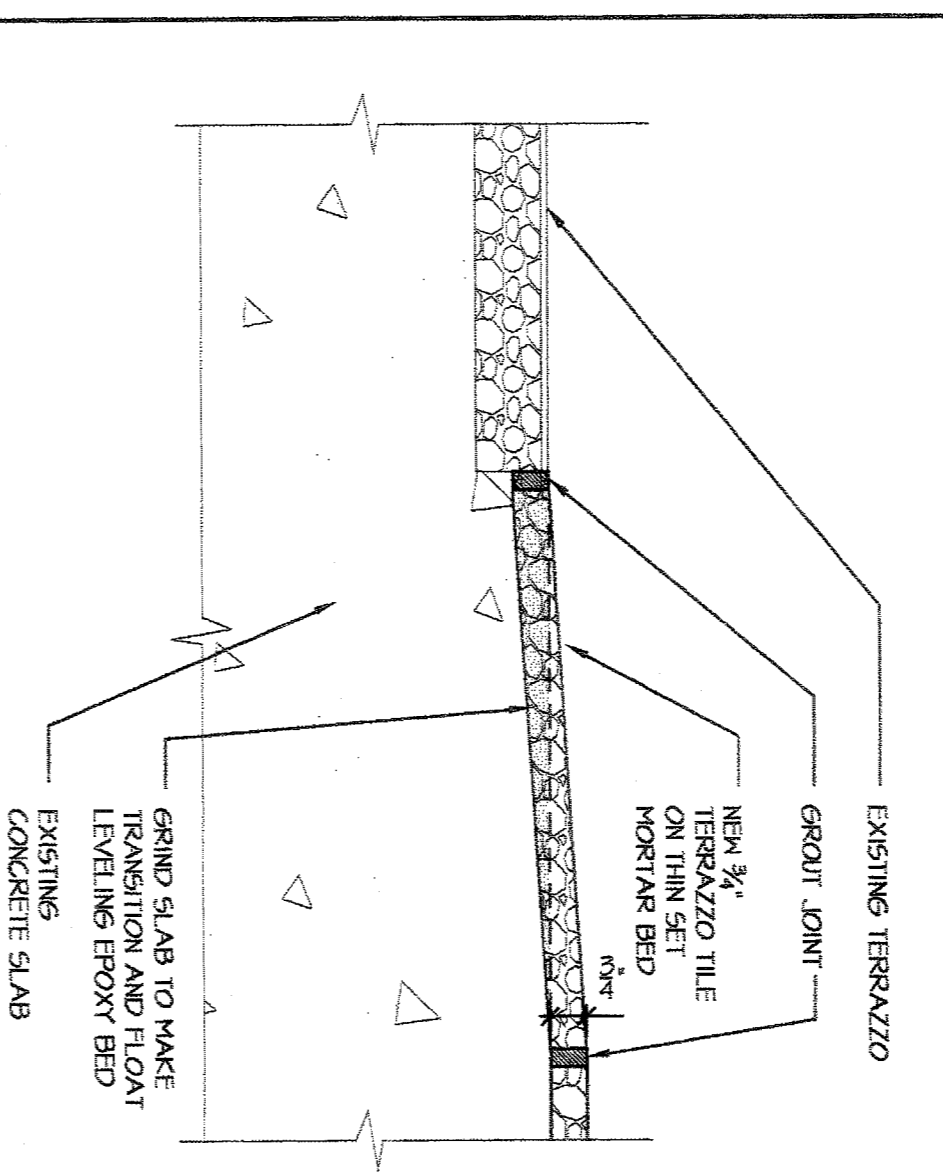


TERRAZZO TILE TRANS. 15
SCALE: 3" = 1'-0"
09A001

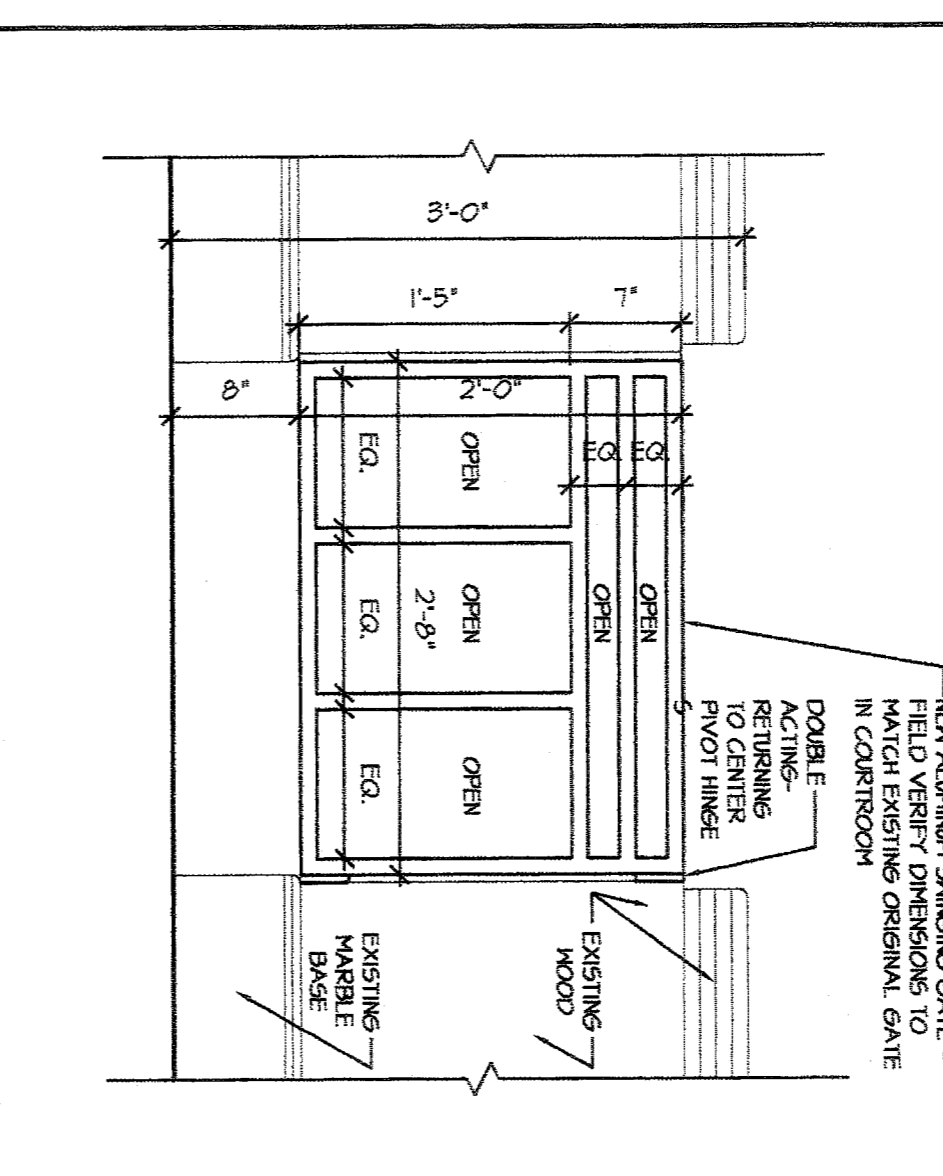


ALUM. GATE @ COURTROOM 11
SCALE: 1" = 1'-0"
05A004

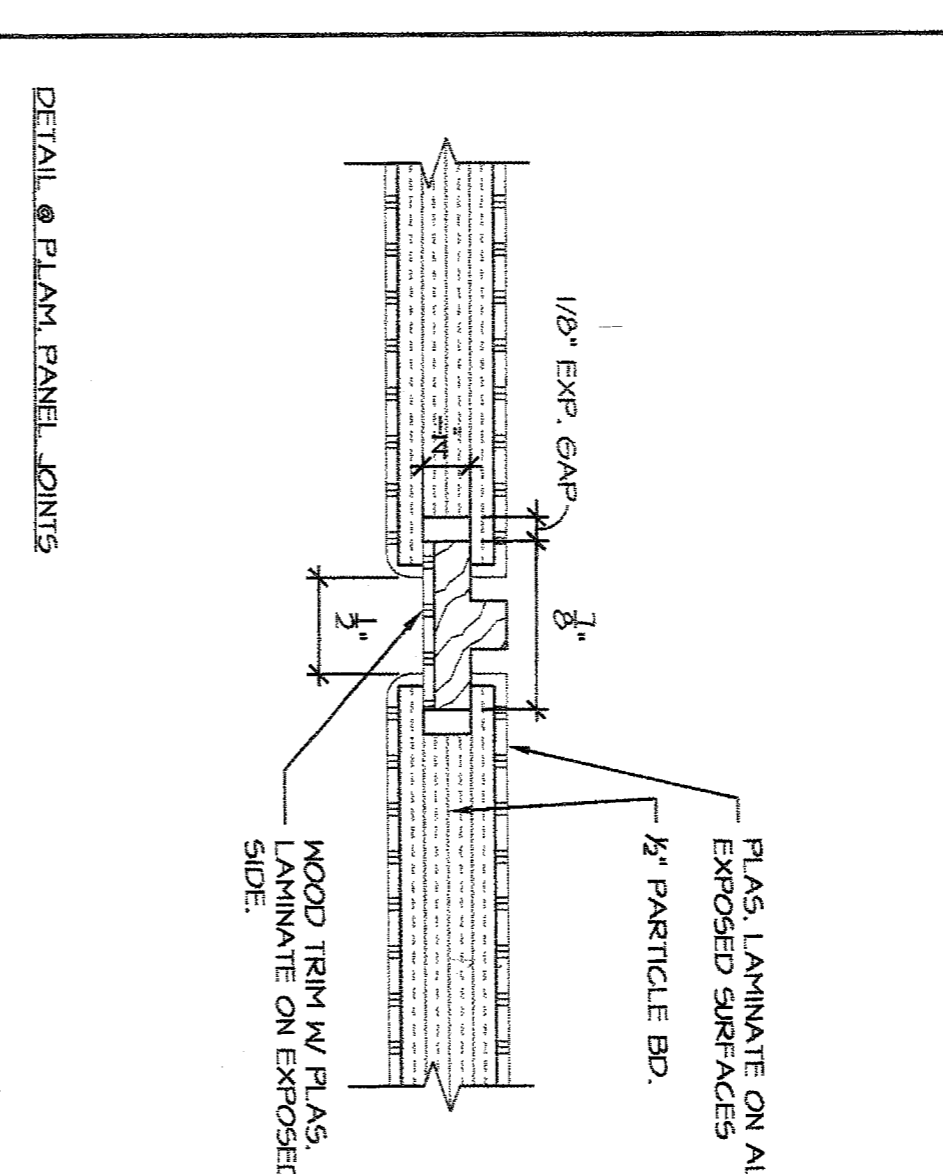


COUNTER @ COUNTY CLERK 7
FULL SCALE
06A019

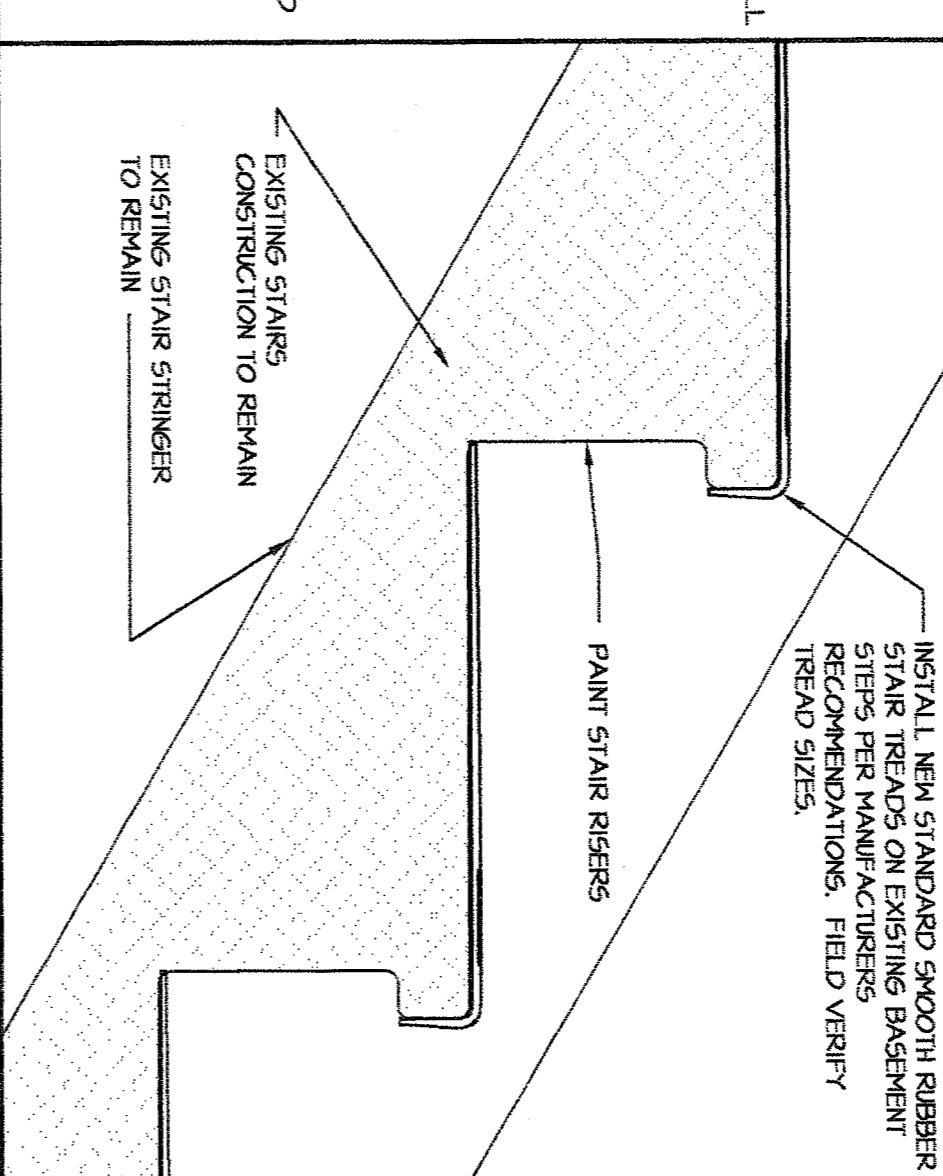


STAIR DETAIL 3
SCALE: 3" = 1'-0"
06A018

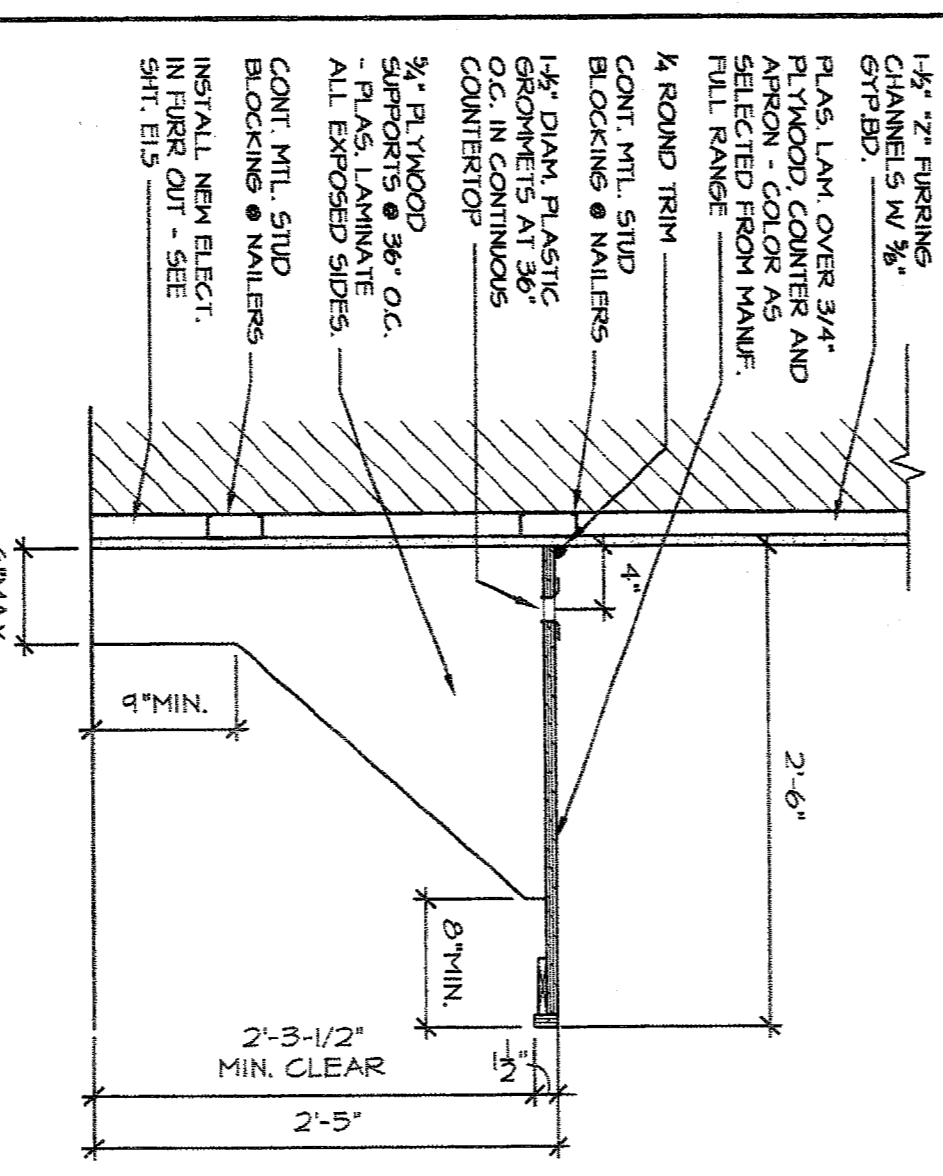


COUNTER @ CONF. - 110A 18
SCALE: 1" = 1'-0"
06A012

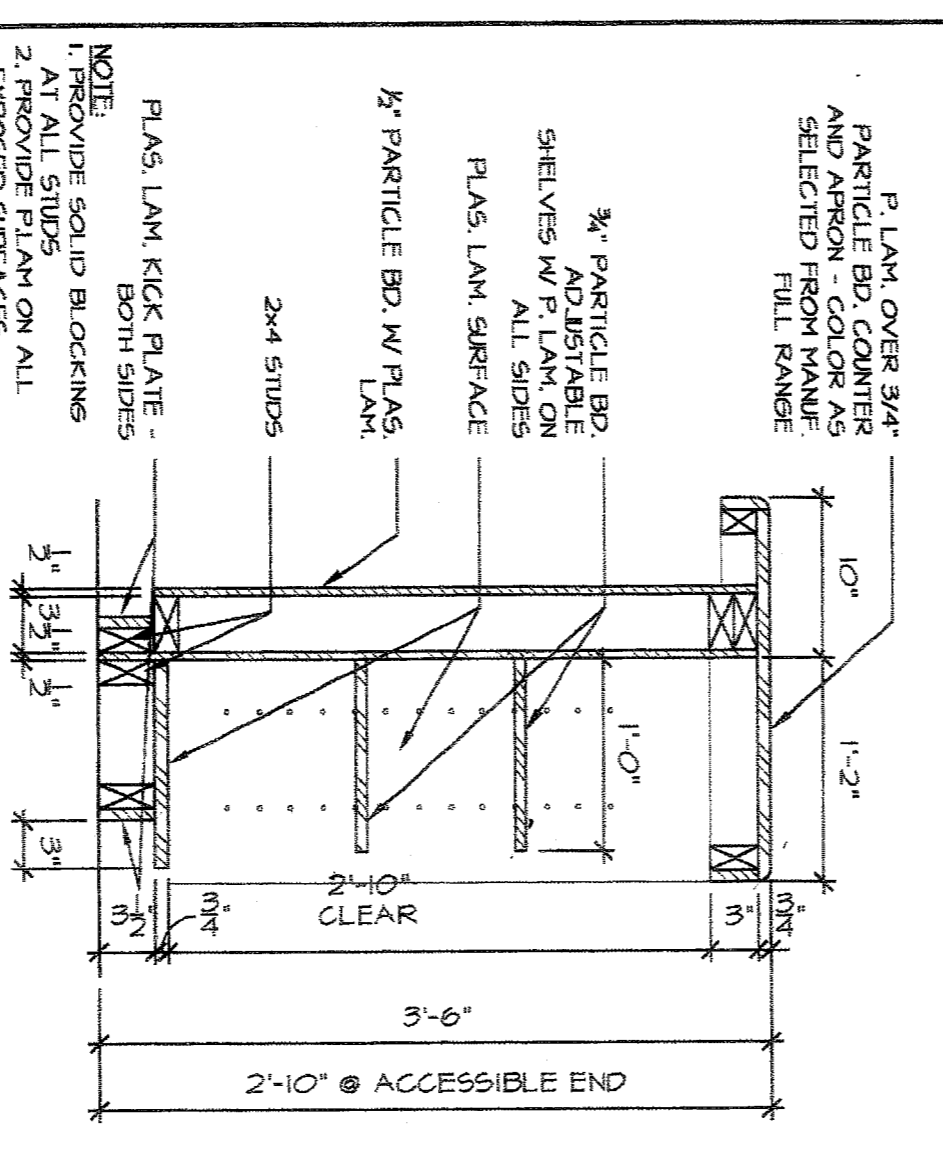


COUNTER @ COUNTY CLERK 14
SCALE: 1" = 1'-0"
06A011

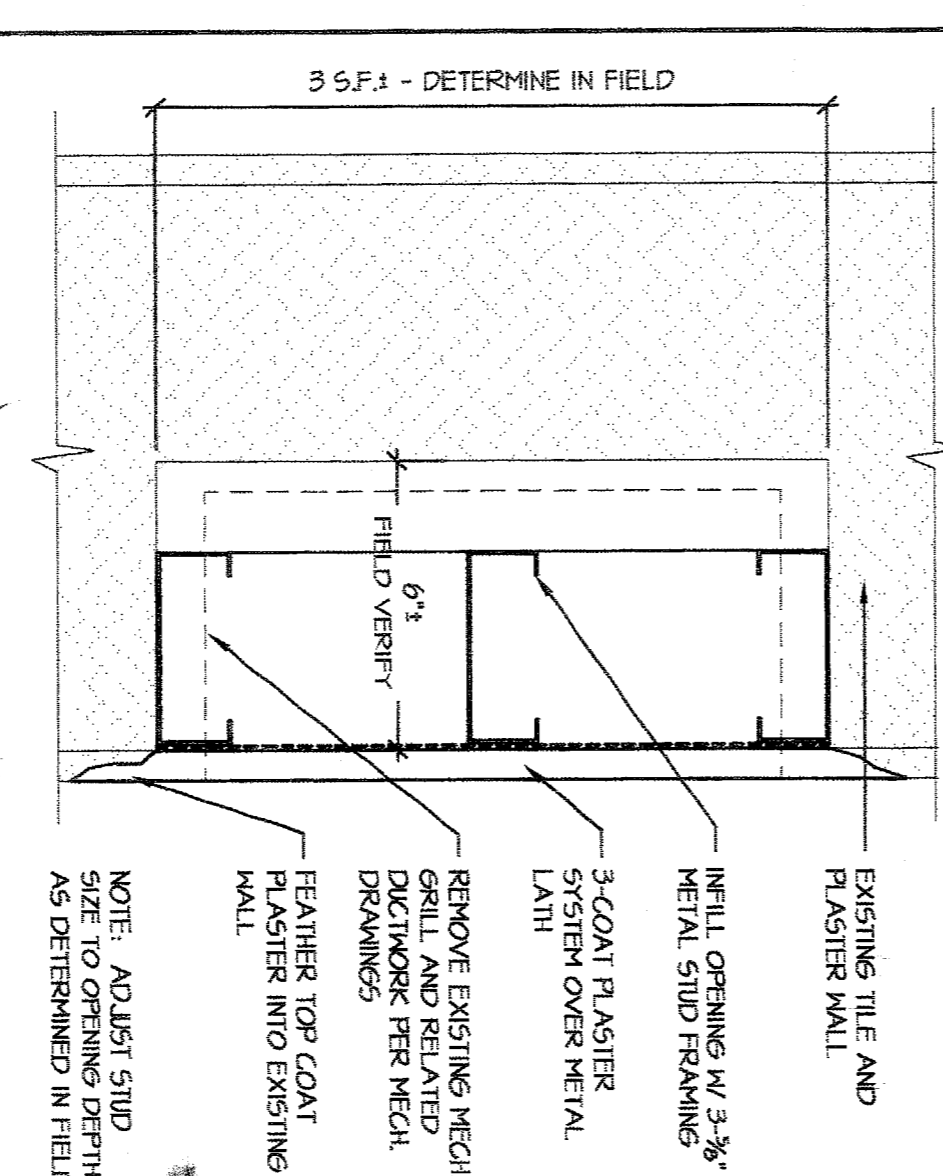


INFILL OF GRILL OPENING 10
SCALE: 3" = 1'-0"
09A030

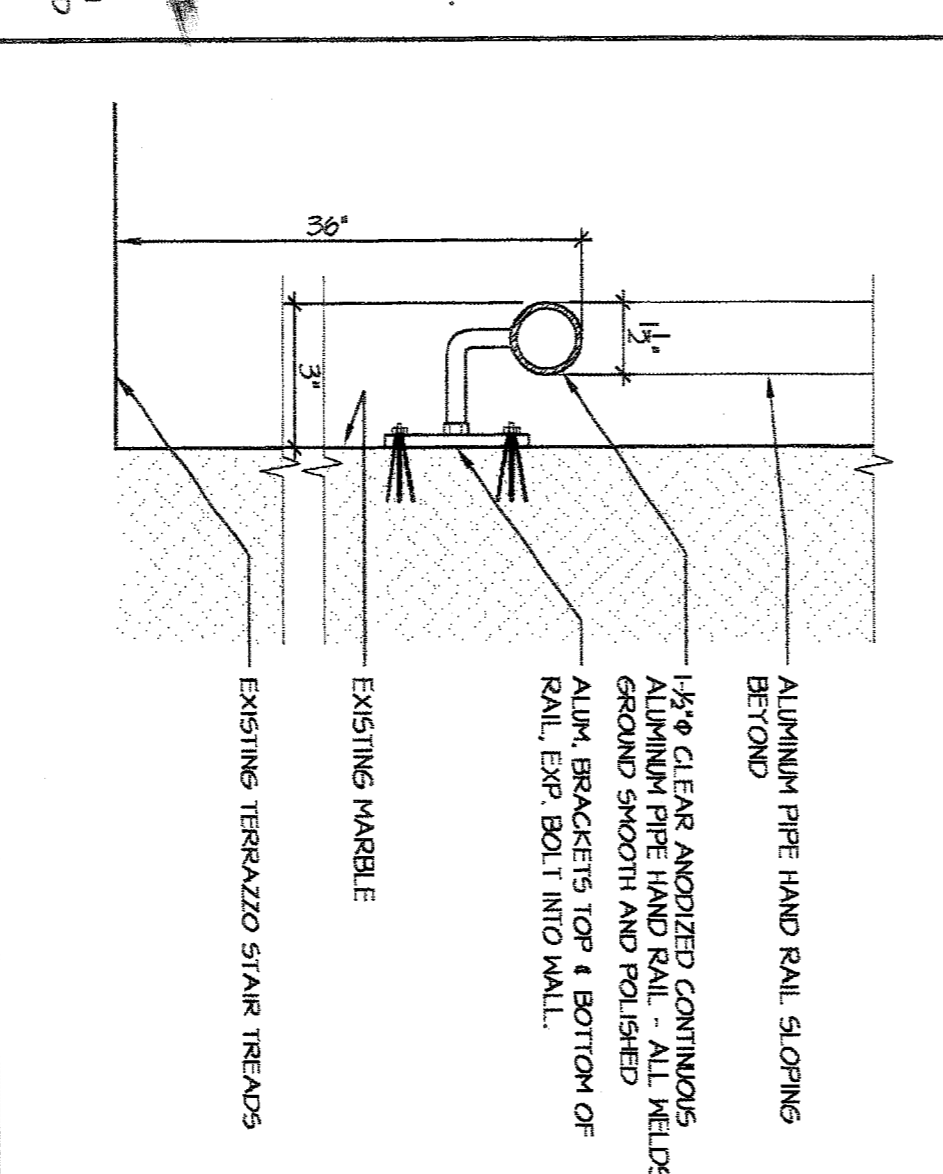


INT. ALUM. HANDRAIL DTL. 6
SCALE: 3" = 1'-0"
05A002

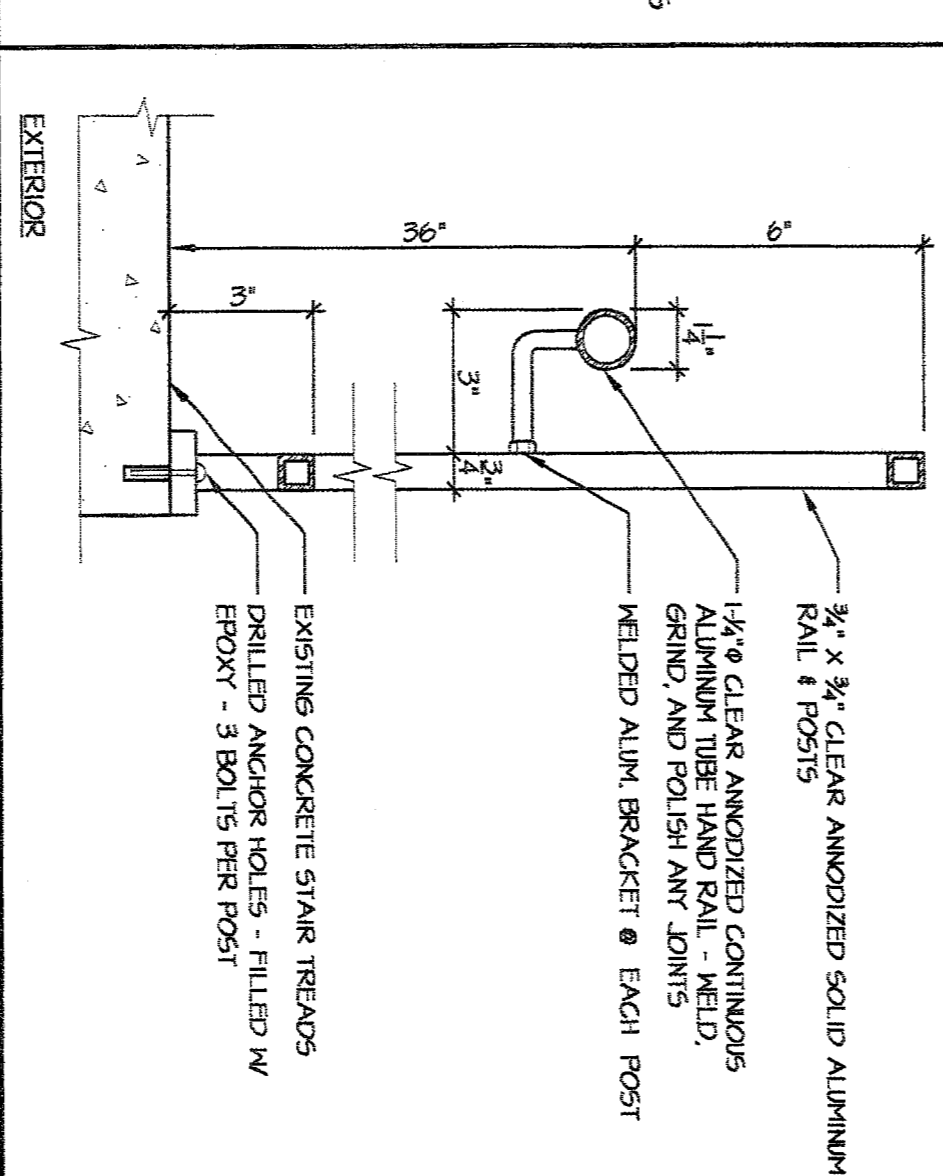


ALUM. HANDRAIL SECTION 2
SCALE: 3" = 1'-0"
05A005

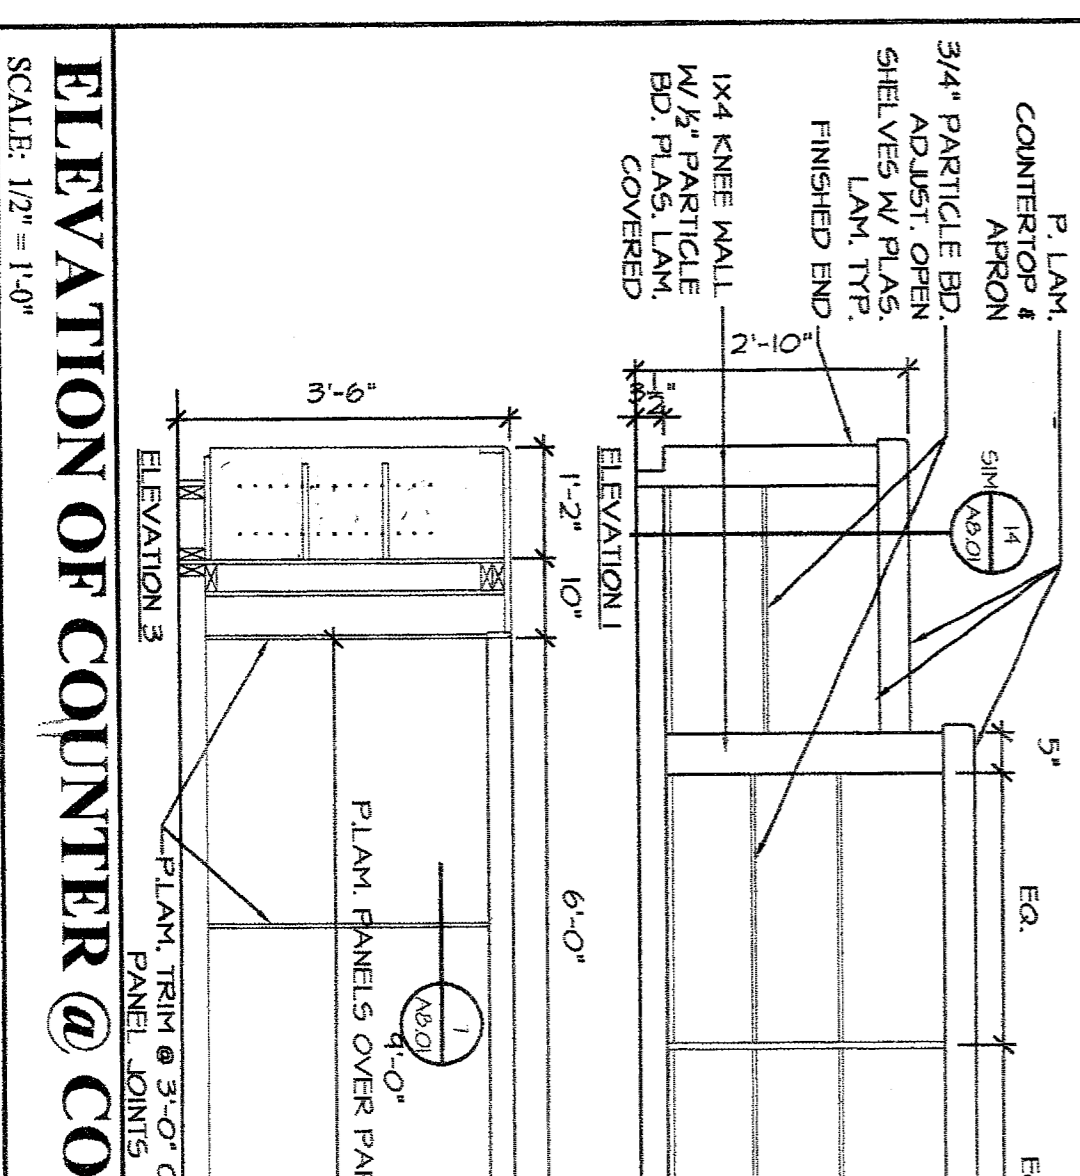


ELEVATION OF COUNTER @ COUNTY CLERK 9
SCALE: 1/2" = 1'-0"
06A014

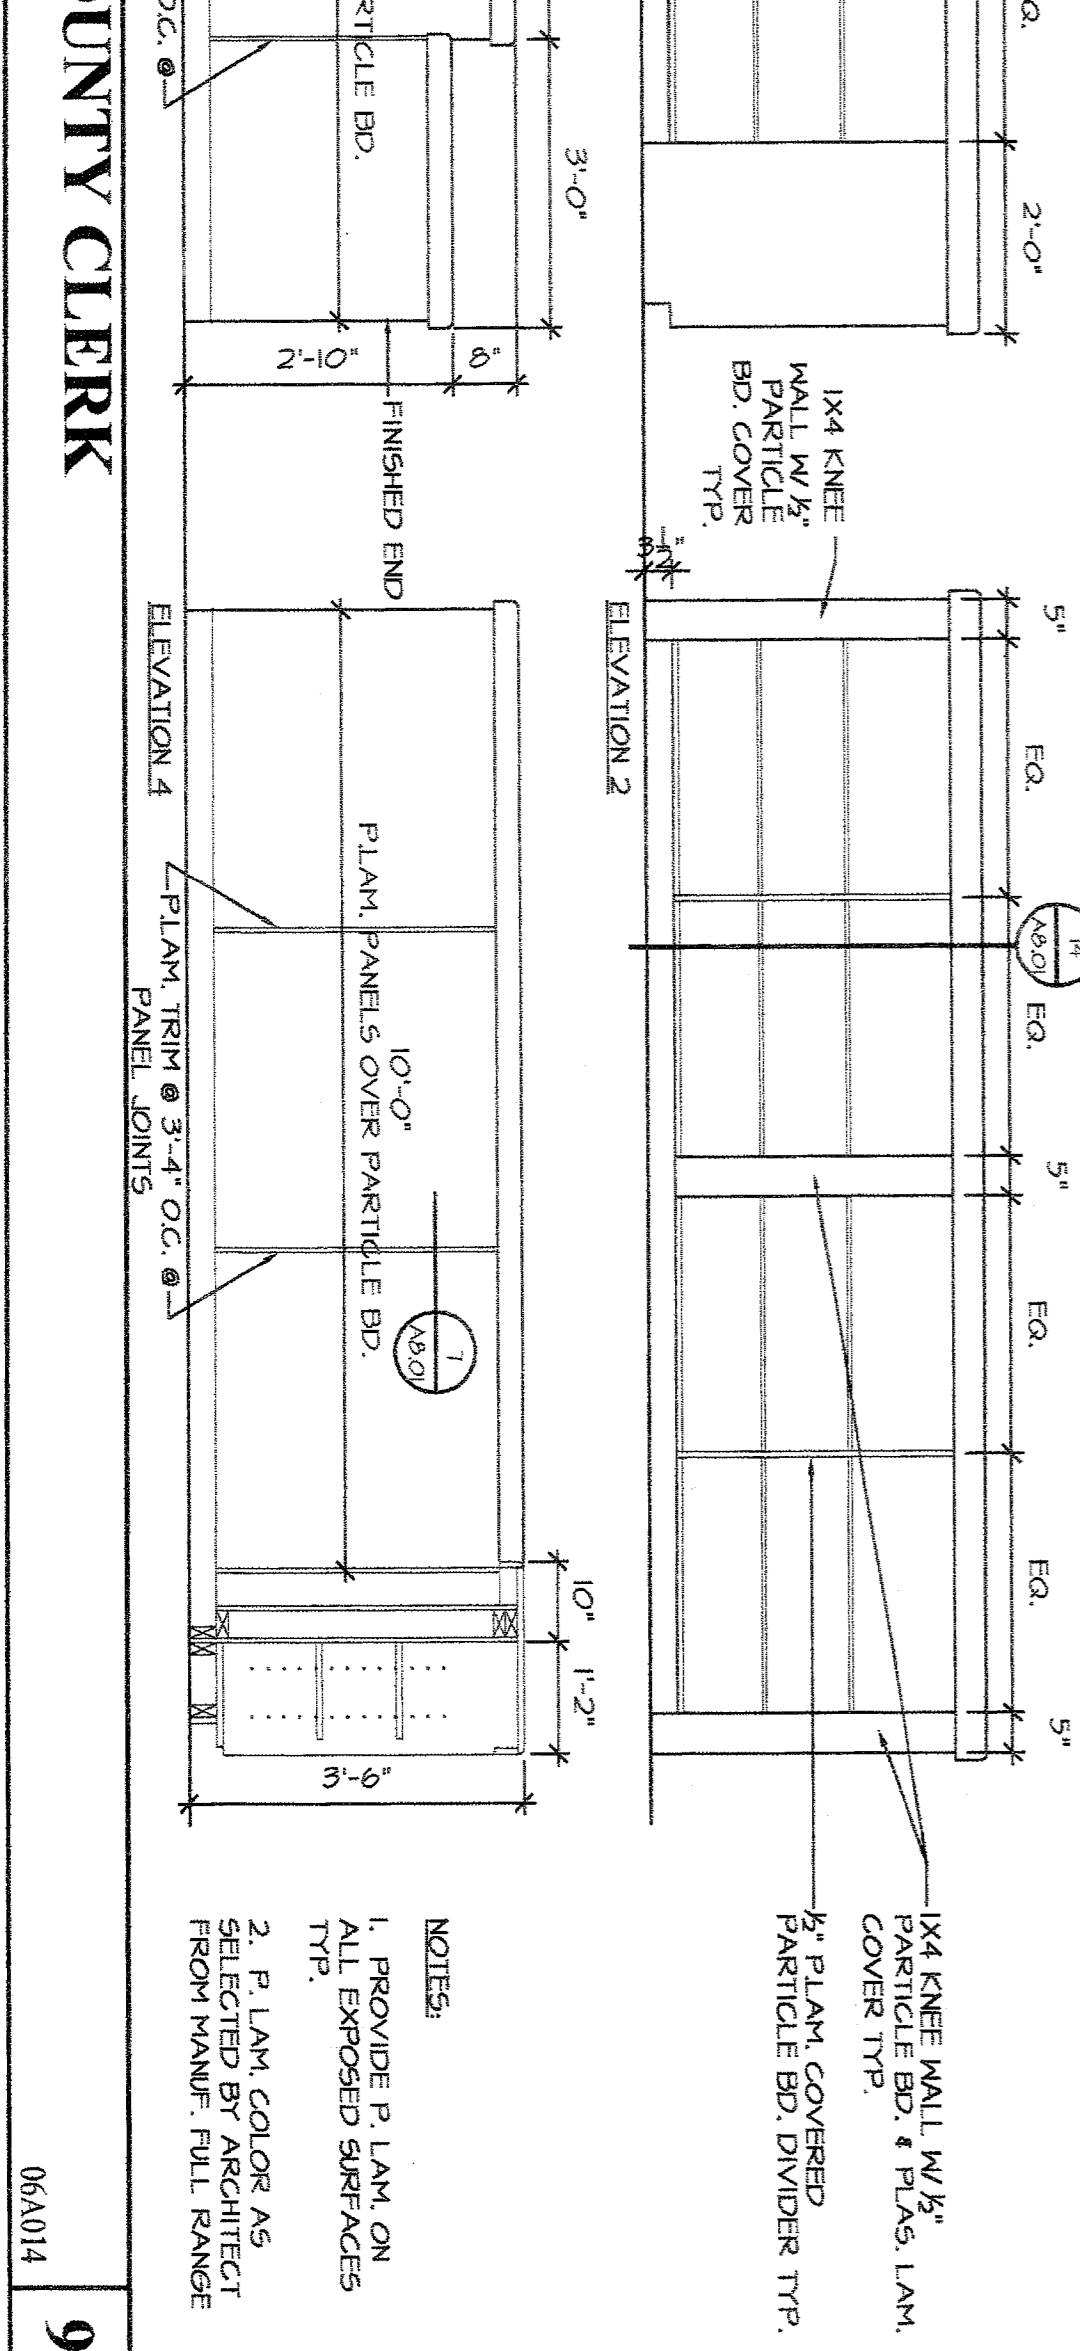

ELEVATION OF COUNTER @ COUNTY CLERK 9
SCALE: 1/2" = 1'-0"
06A014

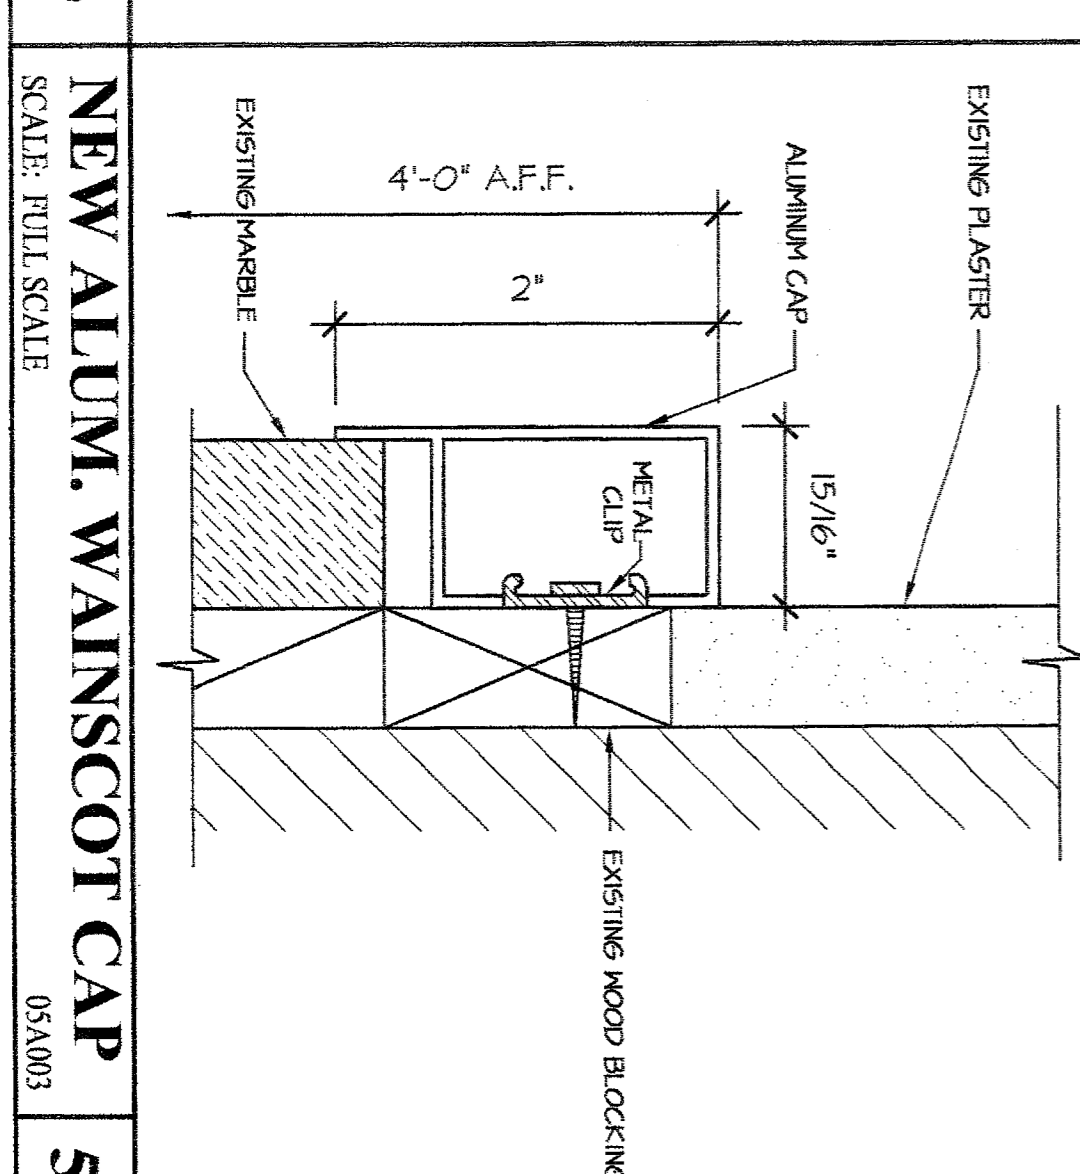

NEW ALUM. WAINSCOT CAP 5
SCALE: FULL SCALE
05A003

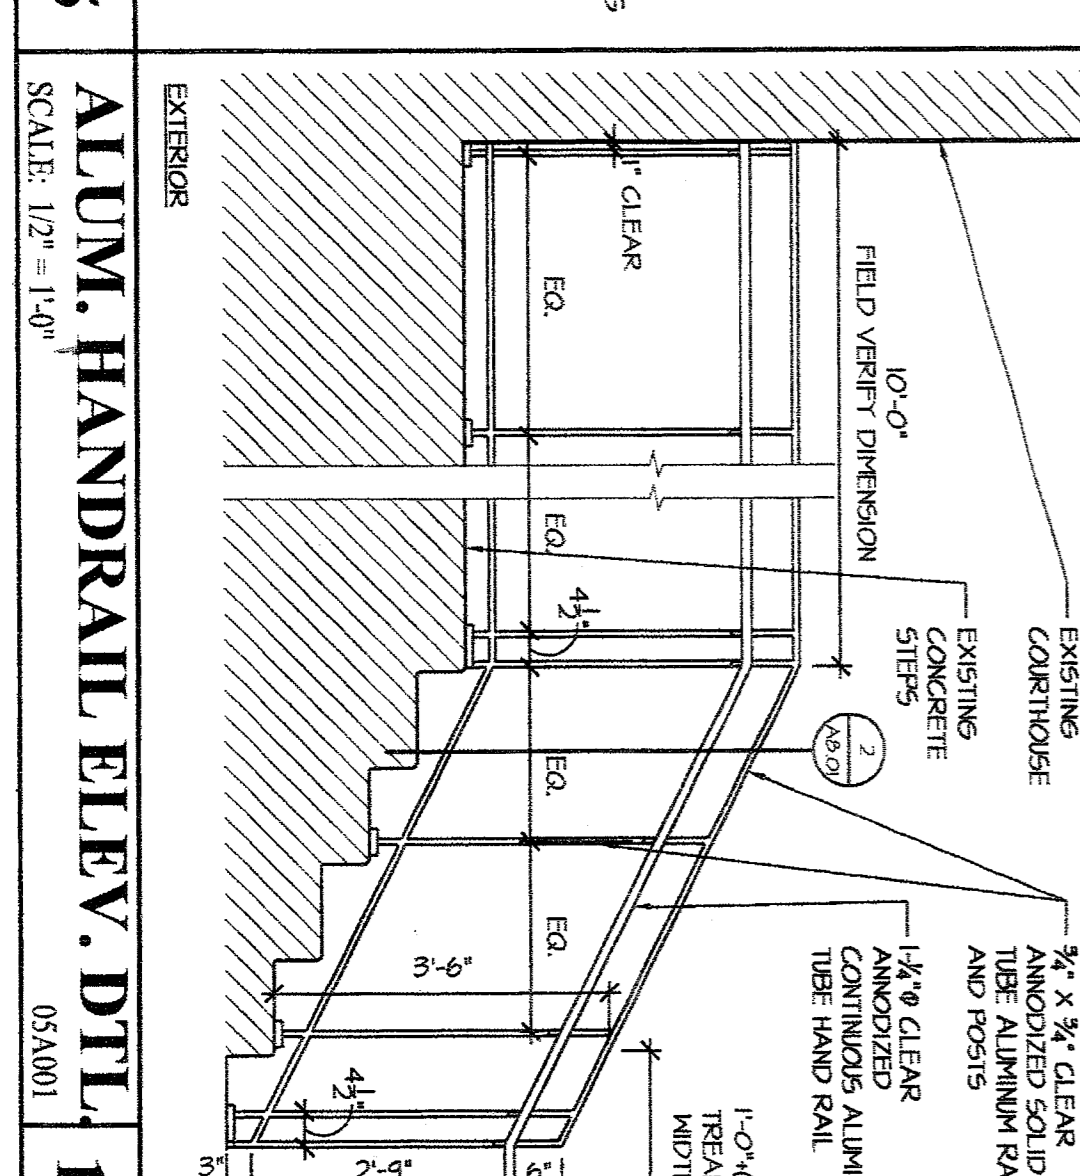

ALUM. HANDRAIL ELEV. DTL. 1
SCALE: 1/2" = 1'-0"
05A001

Project:
BURNETT COUNTY COURTHOUSE
BURNETT, TEXAS

Sheet Title:
MISC. DETAILS

Drawn by:
LCB

Checked by:
BBD

Date:
07/18/2002

Fig. #

Sheet
A8.01

ELVEN THRETER ARCHITECTS, INC.
807 S. ROCK, SUITE 102
GROESBECK, TEXAS 78656
TEL 512.869.1104 FAX 512.869.1862

11/17


GENERAL NOTES

1. CONTRACTOR SHALL OBTAIN PERMISSION FROM OWNER PRIOR TO DISPOSAL OF REMOVED FIXTURES.

KEYED NOTES


THESE NOTES APPLY TO THIS SHEET ONLY.

1. REMOVE EXISTING PLUMBING FIXTURES AND ASSOCIATED WASTEWATER, VENT AND COLD WATER SUPPLY PIPING. CAP OR PLUG ALL EXISTING PIPING TO REMAIN. COORDINATE DEMOLITION WORK WITH NEW PLUMBING WORK TO DETERMINE PLUMBING TO REMAIN TO SERVE NEW FIXTURES. REFER TO SHEET P1.2 FOR NEW EQUIPMENT INSTRUCTIONS.
2. REMOVE EXISTING DRINKING FOUNTAIN. CAP EXISTING WASTEWATER, VENT AND COLD WATER SUPPLY PIPING FOR RE-USE. REFER TO SHEET P1.2 FOR NEW EQUIPMENT INSTRUCTIONS.

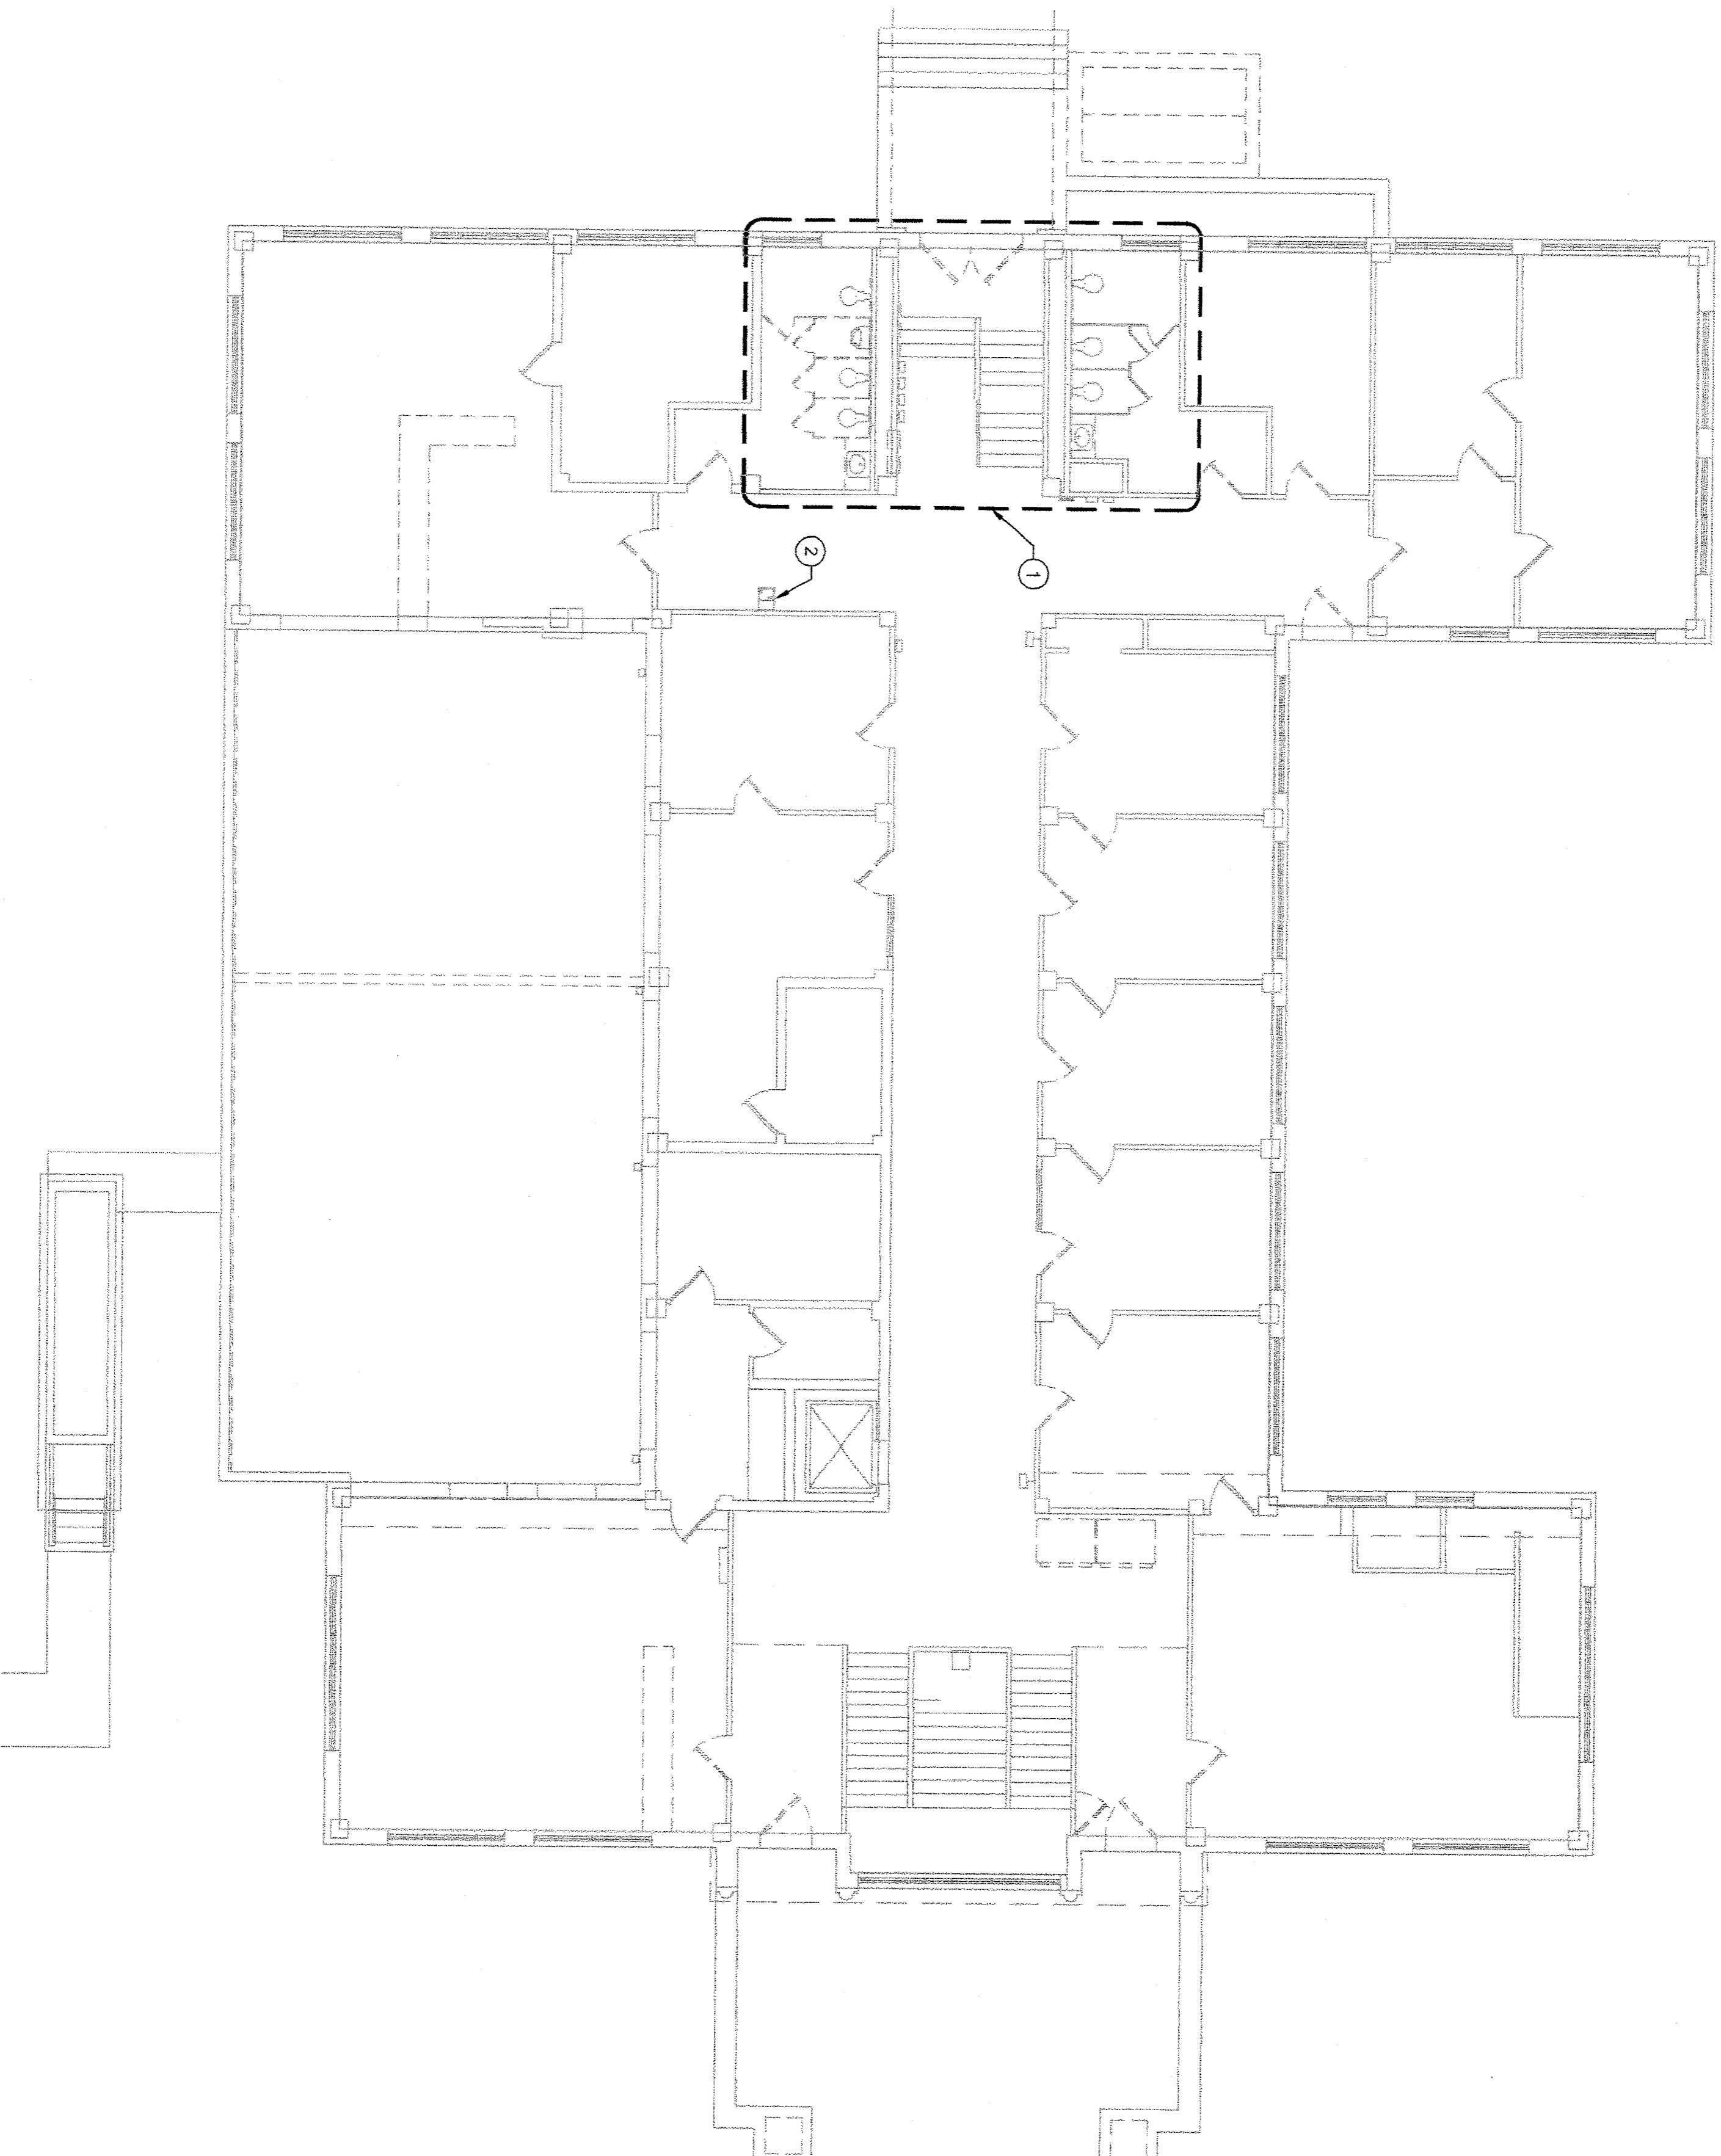

01 FIRST FLOOR DEMOLITION PLAN - PLUMBING
SCALE: 1/8" = 1'-0"

REVISIONS

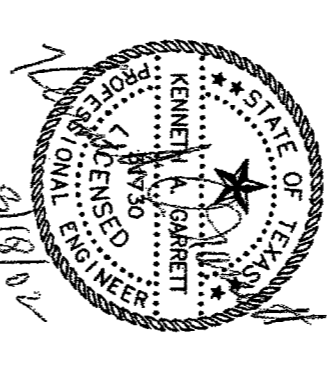

MYERS & ASSOCIATES

This document, the ideas and designs incorporated herein, are the property of Myers & Associates. These documents are not to be used for any other project or purpose without the original intended use, nor are they to be assigned to any third party without the written consent of Myers & Associates.

M & A Job no.: 01-003

Sheet Title:
FIRST FLOOR DEMOLITION PLUMBING

Project:
BURNET COUNTY COURTHOUSE

11

ELVERN THIRTEEN ARCHITECTS INC.
807 S. ROCK SUIITE 102
GEORGETOWN, TEXAS 78626
TEL: 512.869.1104 FAX: 512.869.1162

PD1.2

Date: 03/18/2002
Proj. #:
Drawn by: MA
Issued for: BID



GENERAL NOTES

1. CONTRACTOR SHALL OBTAIN PERMISSION FROM OWNER PRIOR TO DISPOSAL OF REMOVED FIXTURES.

KEYED NOTES

THESE NOTES APPLY TO THIS SHEET ONLY

1. REMOVE EXISTING PLUMBING FIXTURES AND ASSOCIATED WASTEWATER, VENT AND COLD WATER SUPPLY PIPING. CAP OR PLUG ALL EXISTING PIPING TO REMAIN. COORDINATE DEMOLITION WORK WITH NEW PLUMBING WORK TO DETERMINE PLUMBING TO REMAIN TO SERVE NEW FIXTURES. REFER TO SHEET P1.3 FOR NEW EQUIPMENT INSTRUCTIONS.
2. REMOVE EXISTING PRINKING FOUNTAIN, CAP EXISTING WASTEWATER, VENT AND COLD WATER SUPPLY PIPING FOR RE-USE. REFER TO SHEET P1.3 FOR NEW EQUIPMENT INSTRUCTIONS.
3. EXISTING FLOOR DRAIN TO REMAIN. PROTECT DURING DEMOLITION WORK TO AVOID CLOGGING WITH DEBRIS.

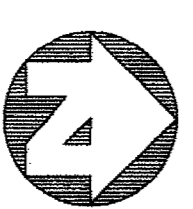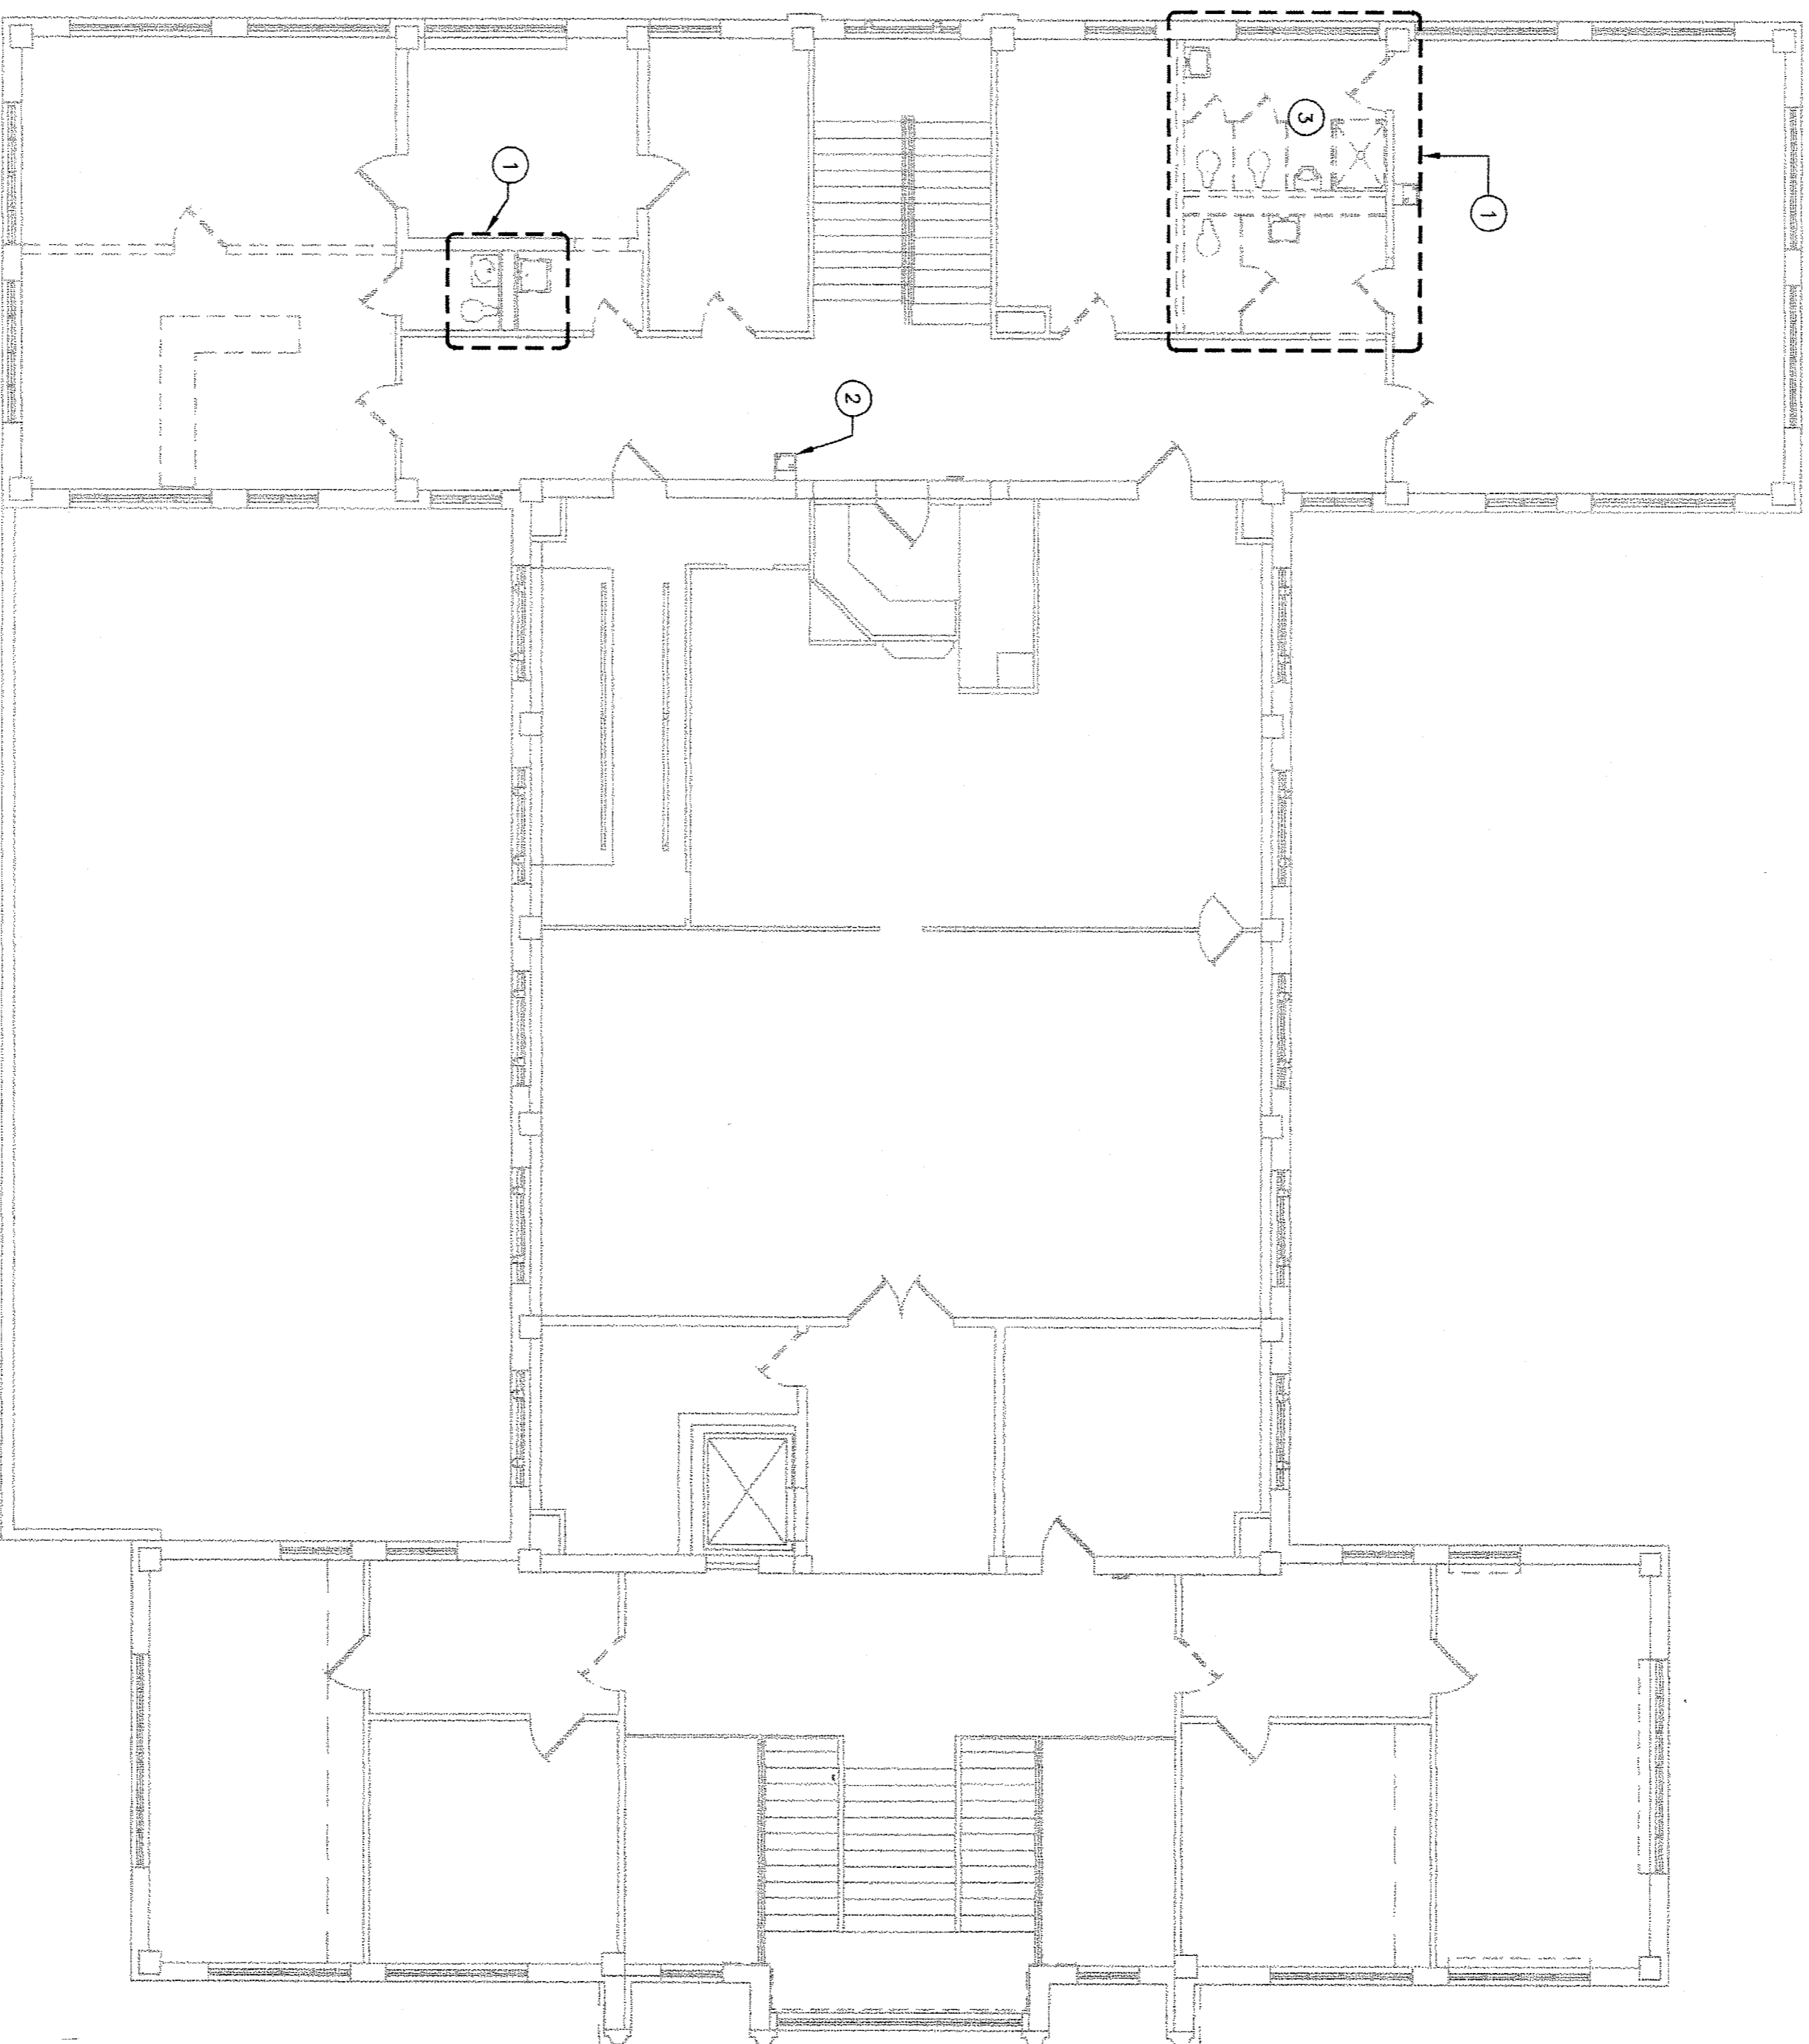


01 SECOND FLOOR DEMOLITION PLAN - PLUMBING

SCALE: 1/8" = 1'-0"

REVISIONS

NO.	DATE	DESCRIPTION

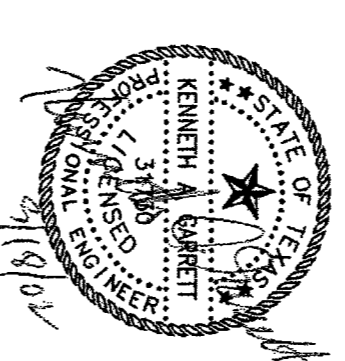

MYERS & ASSOCIATES

This document, the ideas contained herein, and all other contents hereof are the property of Myers & Associates. These documents are not to be reproduced, copied, or altered, in whole or in part, for other than the original intended use, nor may they be used for any other purpose without the written permission from Myers & Associates.
M & A Job no.: 01-003

Sheet Title:
**SECOND FLOOR
DEMOLITION
PLUMBING**

Project:
**BURNETT
COUNTY
COURTHOUSE**

11

ELEVYN THURTELL ARCHITECTS INC.
2000 W. 11TH STREET
GROESBECK, TEXAS 78656
TEL: 512.869.1104 FAX: 512.869.1382

Date: 03/18/2002
Pkg. #
Drawn by: MA
Issued for: BID
Sheet#
PD1.3

REVISIONS

REVISION - ASI#2 - 07/29/02
 REVISION - RFP #5 - 08/09/02


GENERAL NOTES

1. REFER TO PUMP CONNECTION SCHEDULE SHEET P1.4 FOR MINIMUM PIPE SIZES TO EACH FIXTURE.
2. ALL PLUMBING FIXTURES IN BASEMENT ARE EXISTING EXCEPT FOR INSTANTANEOUS WATER HEATERS.

KEYED NOTES

THESE NOTES APPLY TO THIS SHEET ONLY

- ① EXISTING PLUMBING FIXTURES ON THIS LEVEL TO REMAIN. THOROUGHLY CLEAN ALL EXISTING PIPING. REPLACE INTERIOR WATER CLOSET COMPONENTS. REPAIR OR REPLACE ANY LEAKING TRAYS OR VALVES.
- ② EXISTING POTABLE WATER. RE-ROUTE AS REQUIRED FOR HHW AND CHW SYSTEM TAKE-UP. COORDINATE PIPE SIZES AND ROUTING WITH MECHANICAL CONTRACTOR. REFER TO SHEETS M1.6 AND M2.1 FOR MORE INFORMATION.
- ③ NEW BOILER. RE-ROUTE EXISTING NATURAL GAS PIPING TO NEW BOILER.
- ④ EXISTING LIFT STATION TO REMAIN.
- ⑤ INSTALL NEW WATER HEATER (WH-3) BELOW LAVATOR/SINK. CONNECT TO COLD WATER SUPPLY AND ROUTE HOT WATER TO FAUCET. INSULATE HOT WATER PIPING. ADJUST THERMOSTAT TO 109 DEG. F. REFER TO DETAIL 05, SHEET P1.3.

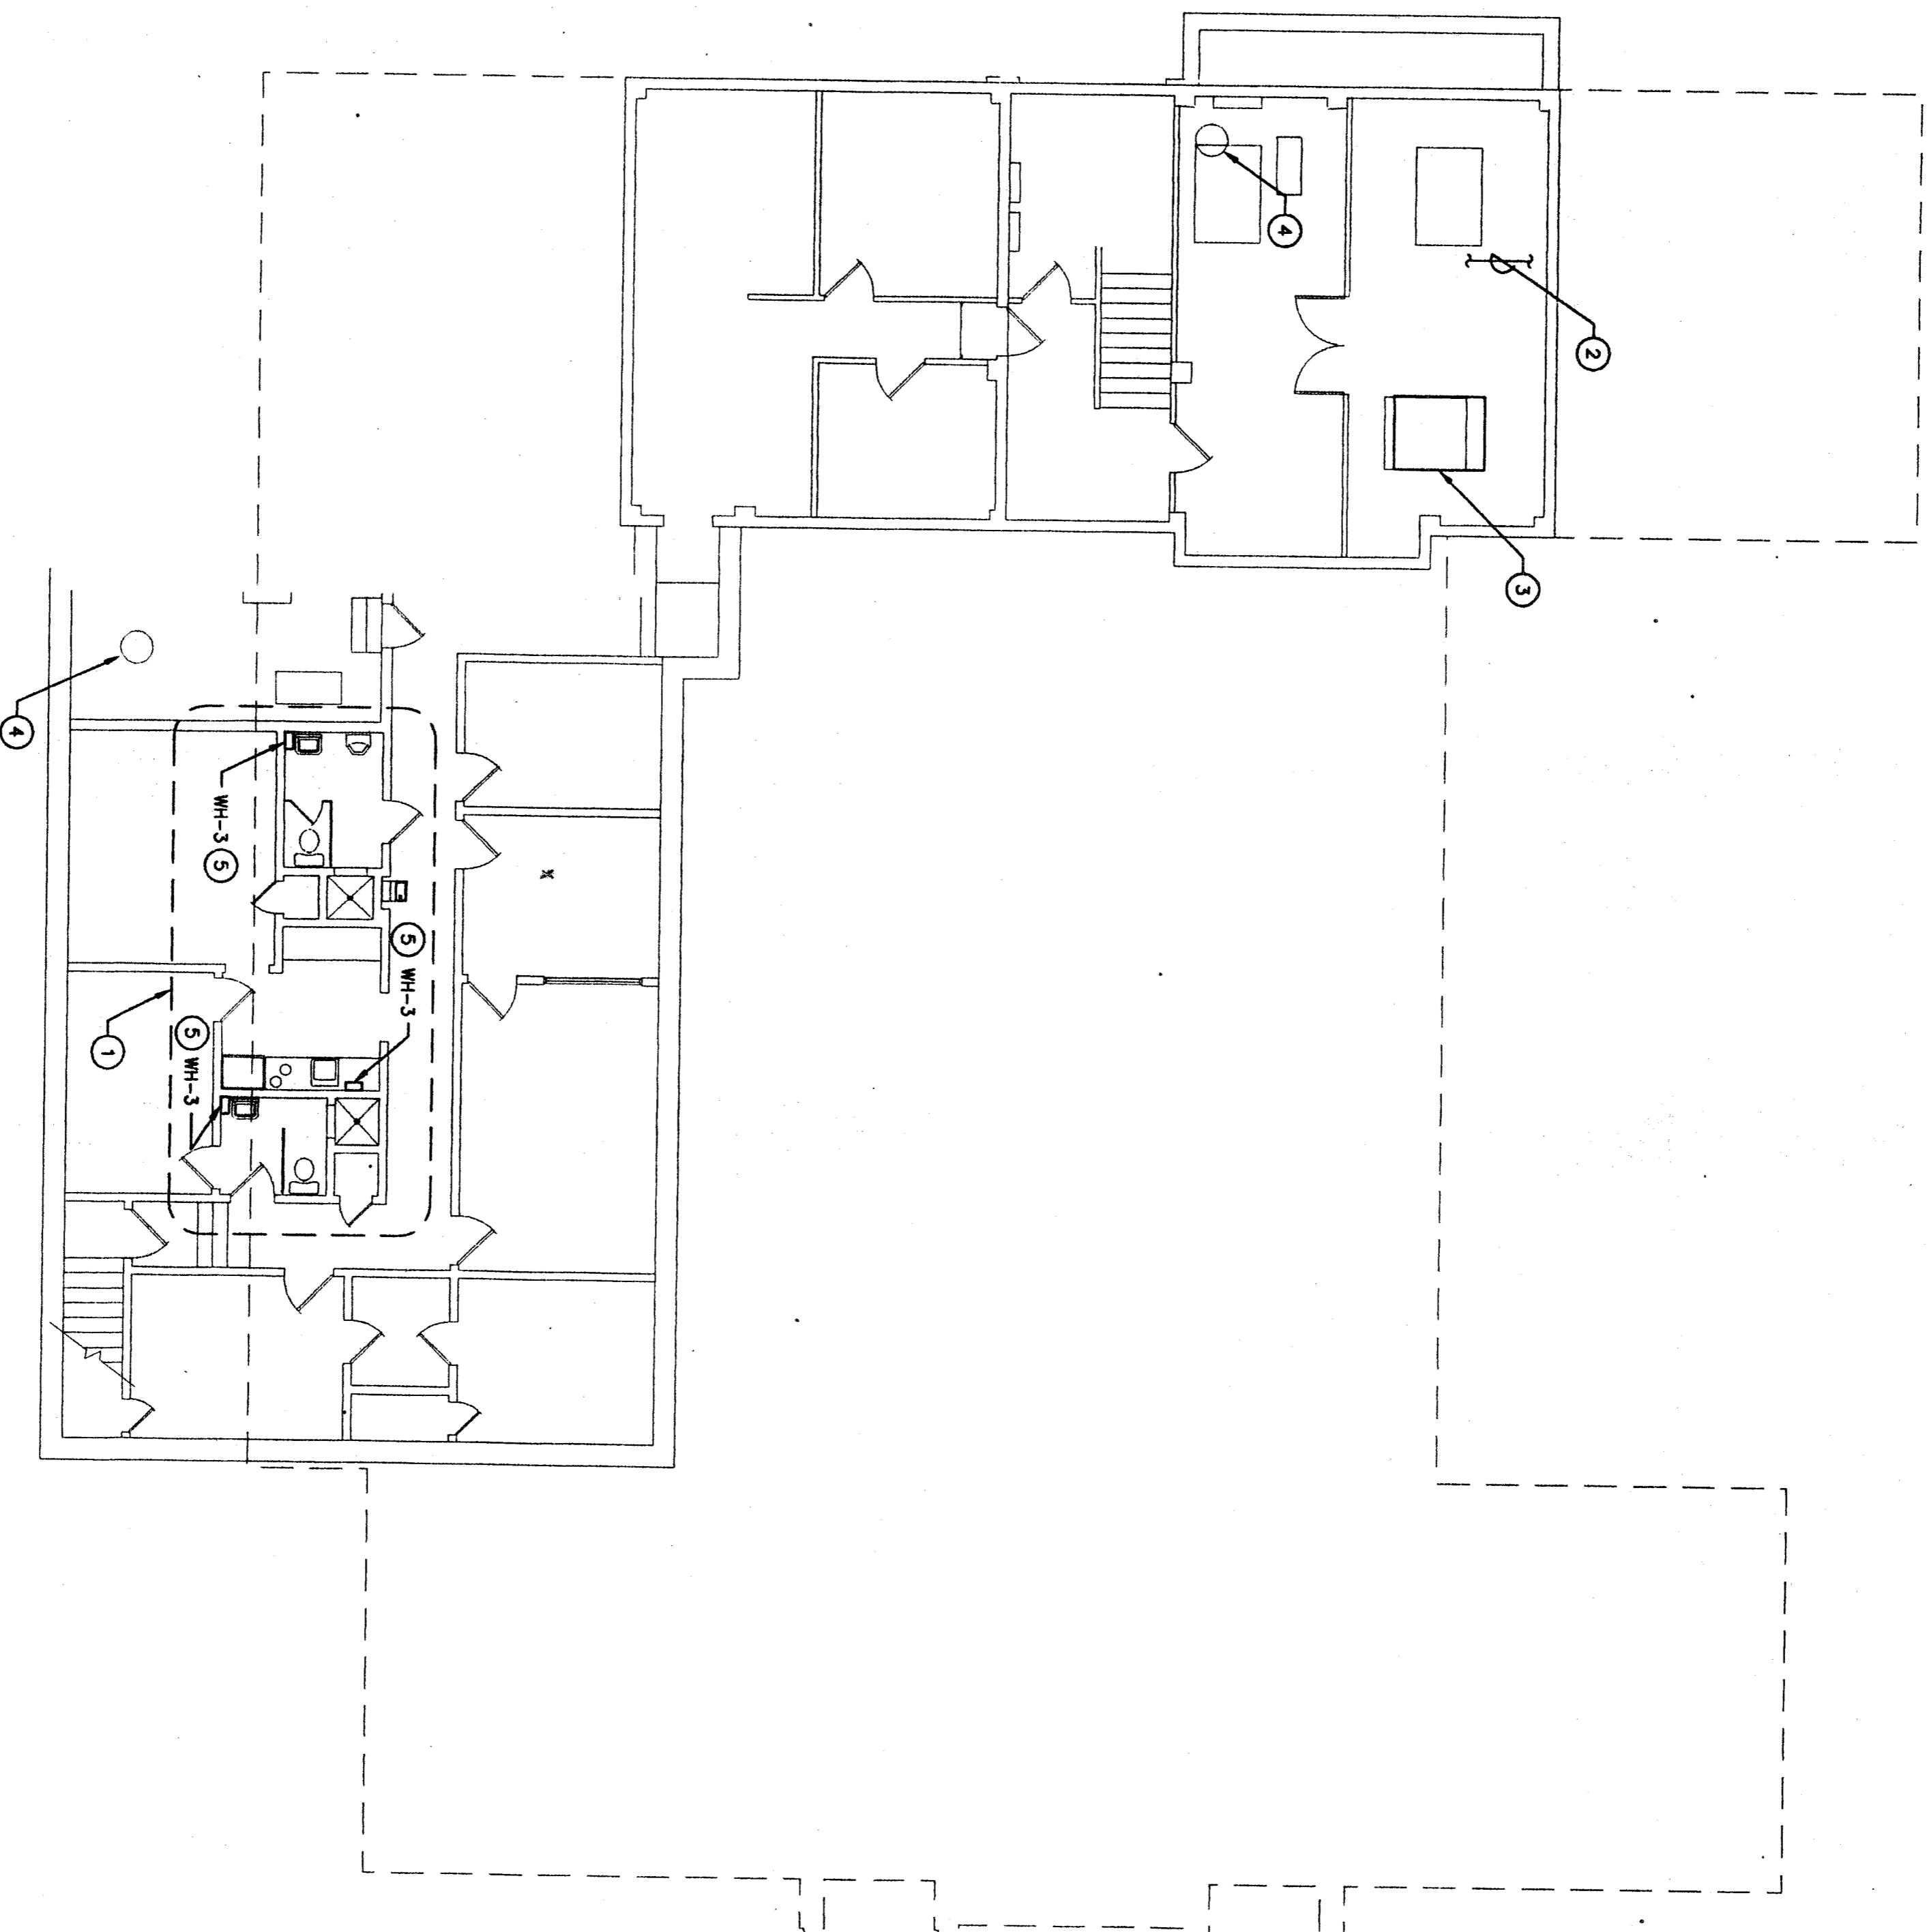

01 BASEMENT FLOOR PLAN - PLUMBING

SCALE: 1/8" = 1'-0"

TD
 13850 Dillard Drive
 Dallas, TX 75244-9060
 (972) 888-5300

AS BUILT
 10/21/02

M
 MYERS &
 ASSOCIATES

This document, the ideas herein and all incorporated herein are the property of Myers & Associates. These documents are not to be used or altered in any way without the original intended use, nor are they to be assigned to any other party without the written permission from Myers & Associates.

M & A Job no. 01-003

Sheet Title:
BASEMENT FLOOR PLAN PLUMBING

Project:
BURNET COUNTY COURTHOUSE
 BURNET, TEXAS

11
13

ELEVEN THIRTEEN ARCHITECTS INC.
 807 S. ROCK STREET, 102
 DALLAS, TEXAS 75204
 TEL: 512.831.1100 FAX: 512.831.1182

Date:	06/10/2002	Sheet:	
Proj. #			
Drawn by:	MA		
Issued for:	BID		
			P1.1

REVISIONS

REVISION - ASI #2 - 07/29/02
REVISION - RFP #3 - 08/09/02



GENERAL NOTES

1 REFER TO FEATURE CONNECTION SCHEDULE SHEET P1.4 FOR MINIMUM PIPE SIZES TO EACH FEATURE.

KEYED NOTES

1 THESE NOTES APPLY TO THIS SHEET ONLY

- 1 INSTALL NEW FIXTURES PER ADA AND TAS REQUIREMENTS. REFER TO ENLARGED VIEW 02, SHEET P1.2. MODIFY EXISTING DRAIN, VENT AND WATER PIPING FOR NEW ARRANGEMENT. SEE FEATURE SCHEDULE FOR NEW FIXTURES.
- 2 INSTALL DRINKING FOUNTAIN SUPPLIED BY THE OWNER. RE-USE EXISTING WATER, WASTE AND VENT PIPING. INSTALL NEW PIPING AS REQUIRED. THROUGHOUT CLEAN DRINKING FOUNTAIN PRIOR TO INSTALLATION.
- 3 INSTALL DRINKING FOUNTAIN SUPPLIED BY THE OWNER. CONTRACTOR SHALL VERIFY THAT SUPPLY, WASTE AND VENT PIPING EXIST AND/OR INSTALL NEW AS REQUIRED. THROUGHOUT CLEAN DRINKING FOUNTAIN PRIOR TO INSTALLATION.
- 4 PROVIDE AND INSTALL REMOTE COOLING UNIT FOR DRINKING FOUNTAIN ABOVE CEILING. ELECTRICAL REQUIREMENTS WITH ELECTRICAL CONTRACTOR.
- 5 INSTALL INSTANTANEOUS WATER HEATER (WH-2) BELOW COUNTER. MAINTAIN CLEARANCES OF, SHALL MEET ALL REQUIREMENTS. INSULATE ALL HOT WATER PIPING. REFER TO DETAIL 06, SHEET P1.5.
- 6 EXTEND NEW WATER PIPING TO EXISTING WATERLINE SERVING RESTROOM FIXTURES. VERIFY EXACT LOCATION OF CONNECTION POINT IN FIELD.
- 7 CONNECT NEW WASTEWATER PIPING TO EXISTING WASTEWATER DRAIN SERVING RESTROOM FIXTURES. VERIFY EXACT LOCATION OF CONNECTION POINT IN FIELD.
- 8 PROVIDE ALTERNATE BID TO DEDUCT FLOOR DRAINS, TRAP PRIMERS, AND ASSOCIATED PIPING IN FIRST FLOOR RESTROOMS.
- 9 CONNECT NEW VENT PIPING TO EXISTING VENT THROUGH ROOF. OFFSET ABOVE CEILING AS REQUIRED.

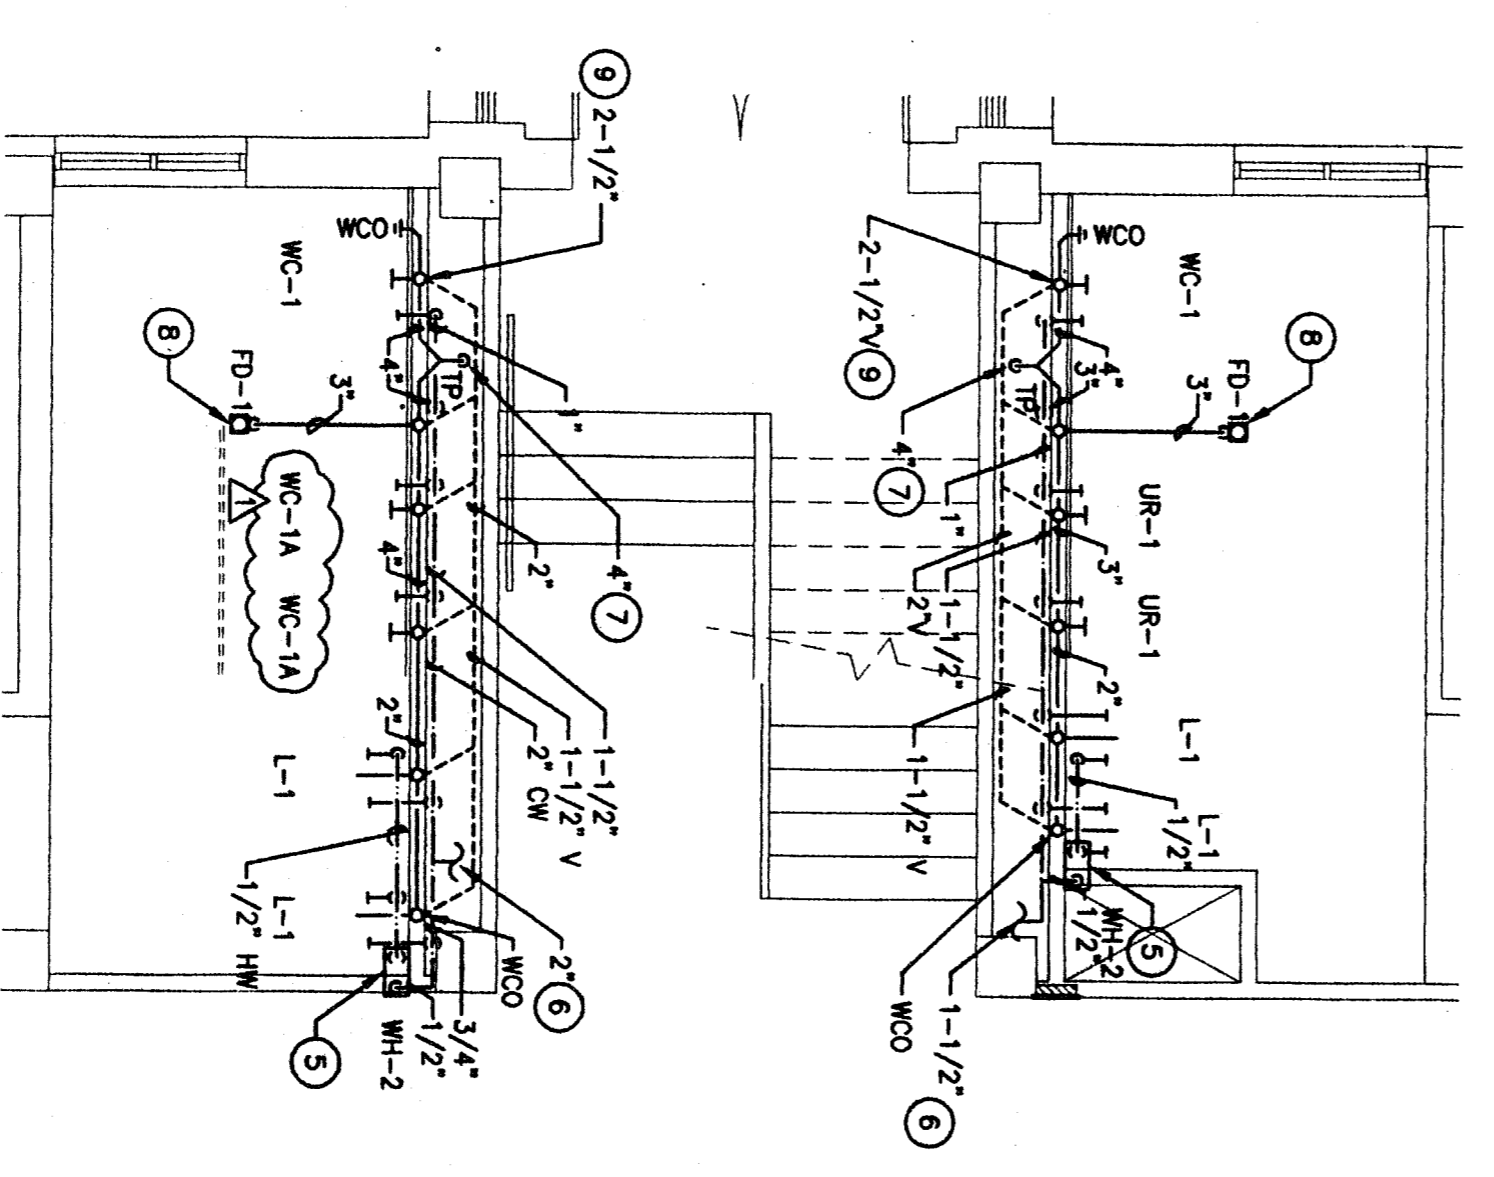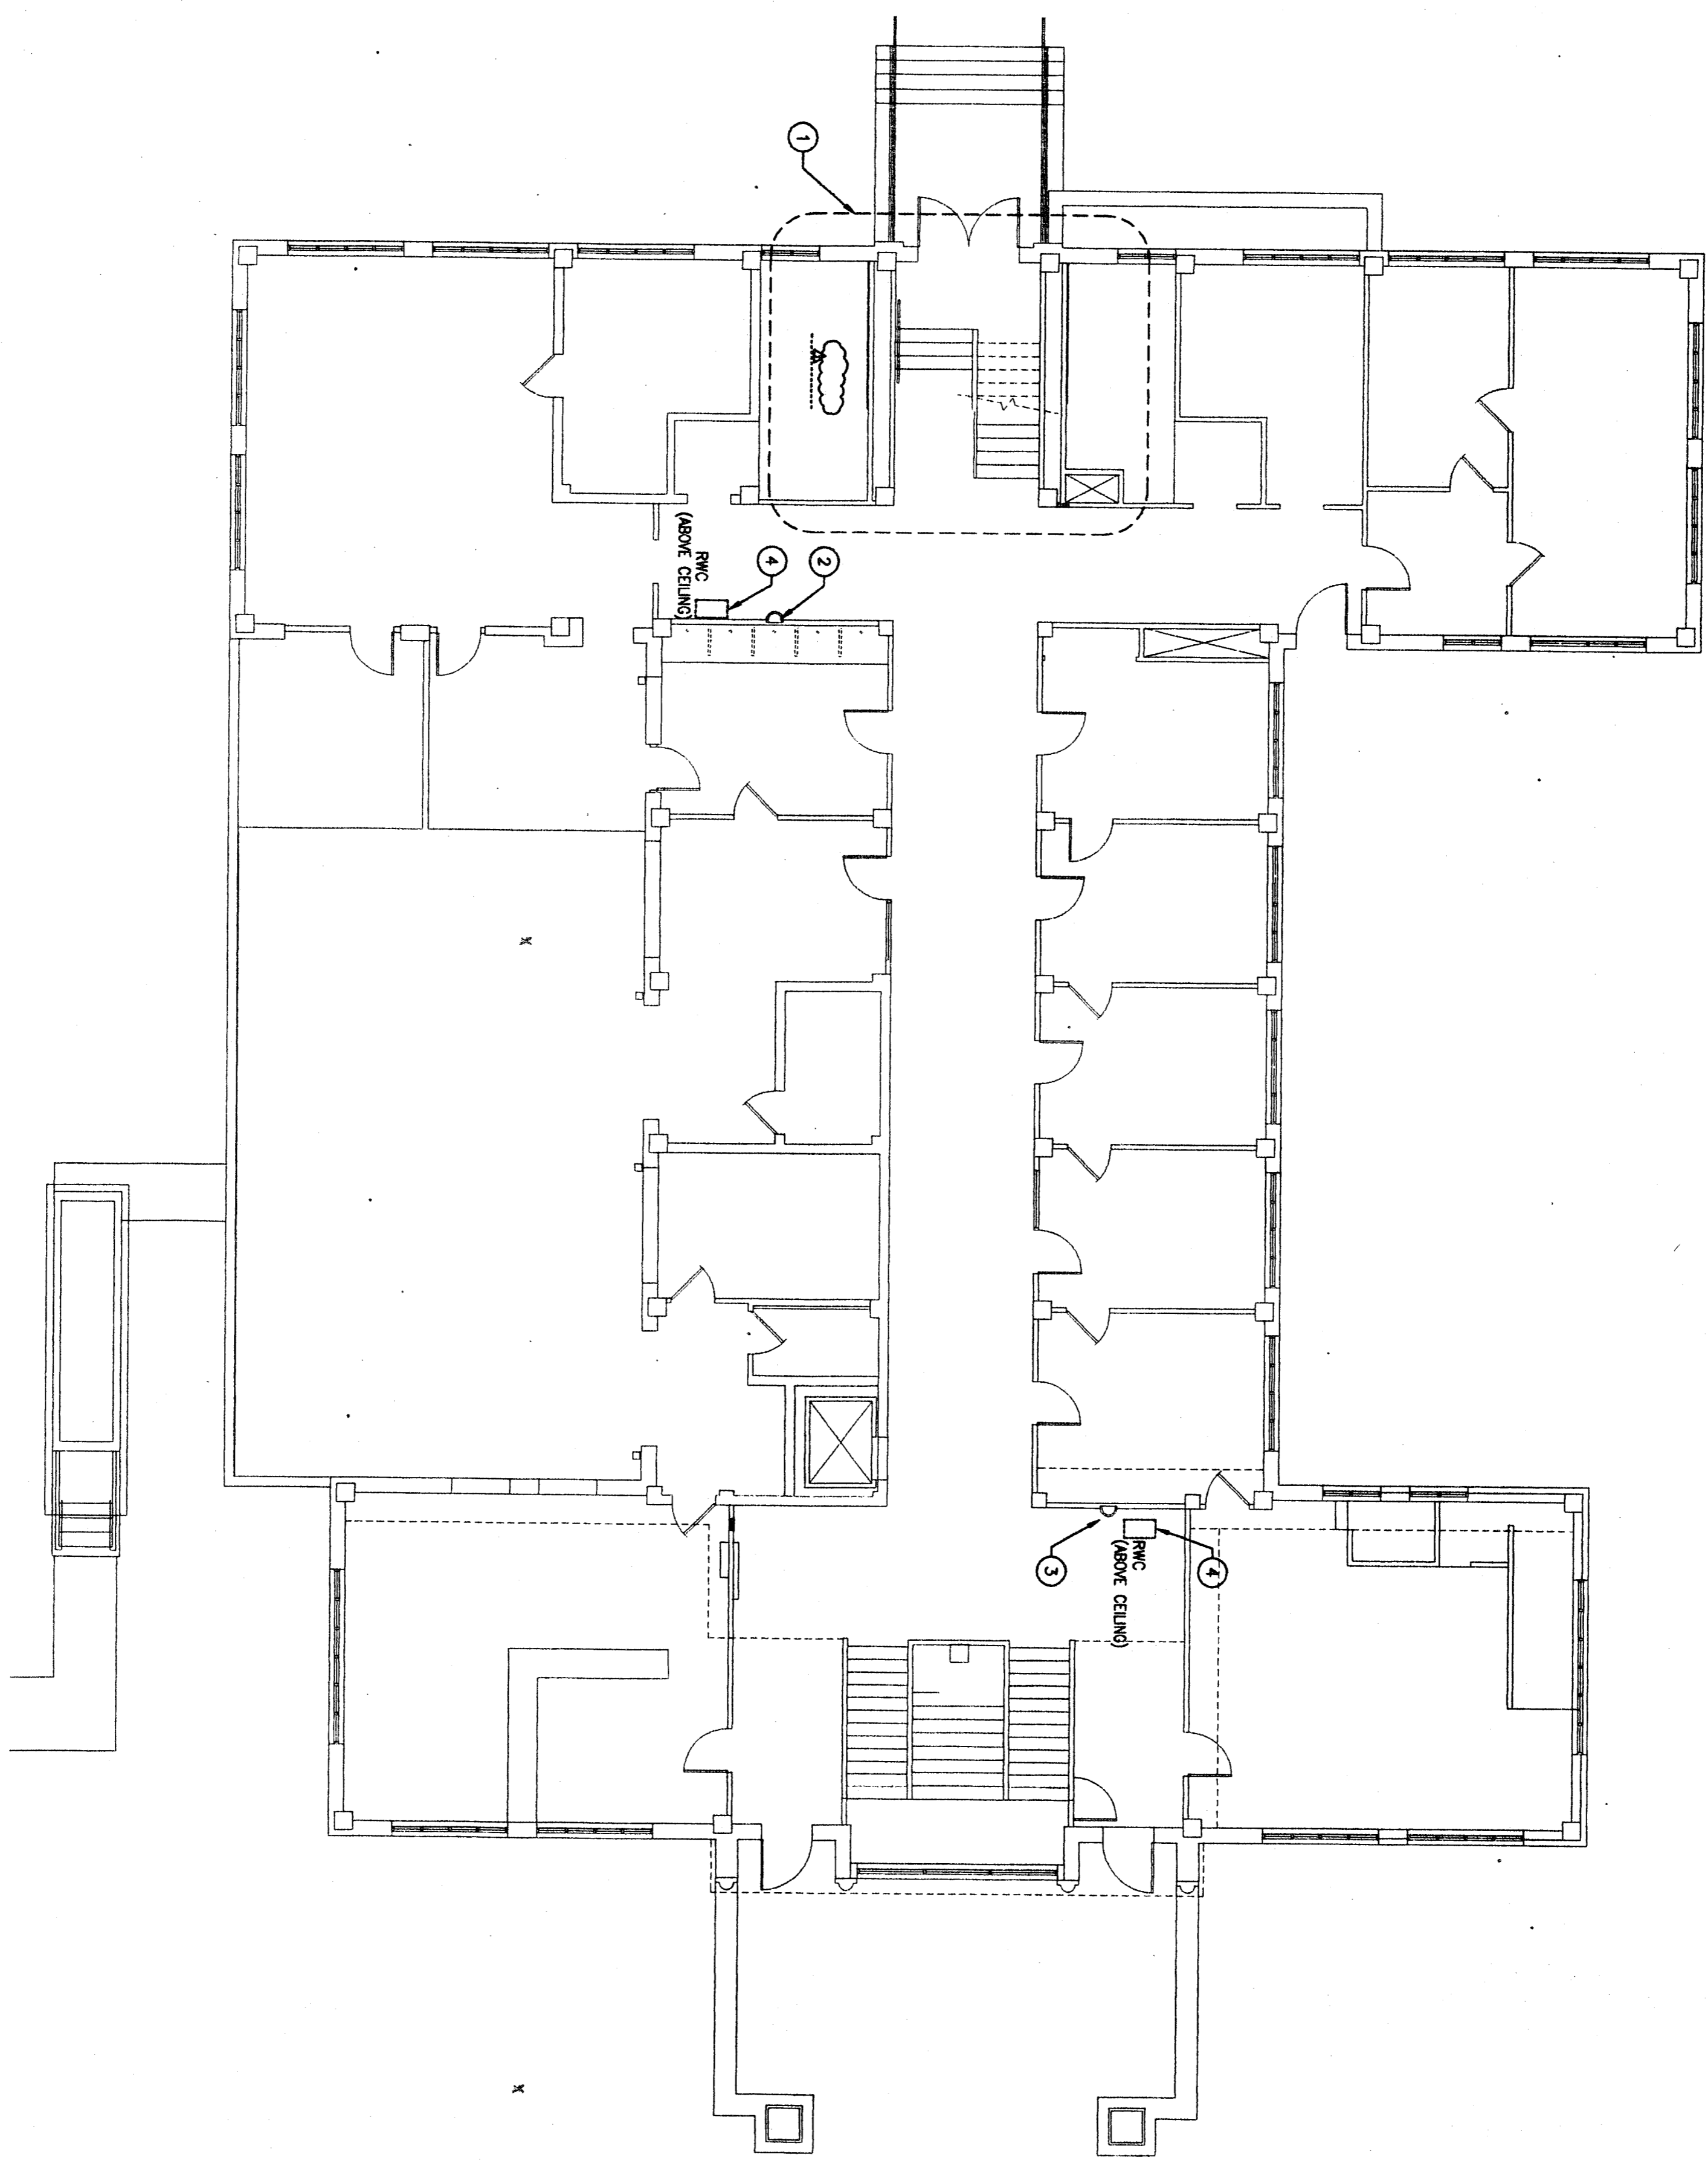

01 FIRST FLOOR PLAN - PLUMBING
SCALE: 1/8" = 1'-0"



02 FIRST FLOOR PLAN - PLUMBING
SCALE: 1/4" = 1'-0"

TRIPLE
DESIGN GROUP
P.O. Box 8000
1801 W. Loop West
Dallas, TX 75215
(214) 888-5881

AS BUILT
10/21/02

M
MYERS &
A
ASSOCIATES

This document, the ideas and designs incorporated herein are the property of Myers & Associates. These documents are not to be used or altered, in whole or in part, without the written consent of Myers & Associates. one they to be assigned to any third party without written permission from Myers & Associates.
M & A job no.: 01-003

FIRST FLOOR PLAN PLUMBING

Project:
BURNETT COUNTY COURTHOUSE
BURNETT, TEXAS

11
13

ELSON THOMPSON ARCHITECTS INC.
407 S. ROCK BLVD. SUITE 102
GROESBECK, TEXAS 75645
TEL: 512.899.1144 FAX: 512.899.1362

Date: 06/10/2002
Sheet:
Drawn By: MA
Issued As: BID

P1.2


GENERAL NOTES

1. REFER TO FUTURE CONNECTION SCHEDULE SHEET P1.4 FOR MINIMUM PIPE SIZES TO EACH FIXTURE.


KEYED NOTES

THESE NOTES APPLY TO THIS SHEET ONLY.

1. INSTALL NEW FIXTURES PER ADA AND IAS REQUIREMENTS. REFER TO ENLARGED NEW CO. SHEET P1.3. MODIFY EXISTING DRAIN, VENT AND WATER PIPING FOR NEW ARRANGEMENT. SEE FUTURE SCHEDULE FOR NEW FIXTURES.
2. PROVIDE NEW WATER PIPING TO CONNECT TO DRINKING FOUNTAIN ABOVE CEILING. PROVIDE AND INSTALL RELIABLE COOLING UNIT FOR DRINKING FOUNTAIN. COORDINATE ELECTRICAL REQUIREMENTS WITH ELECTRICAL CONTRACTOR.
3. INSTALL DRINKING FOUNTAIN SUPPLIED BY THE OWNER. RE-USE EXISTING WATER, WASTE AND VENT PIPING WHERE PIPING AS REQUIRED. THOROUGHLY CLEAN DRINKING FOUNTAIN PRIOR TO INSTALLATION.
4. INSTALL WATER HEATER (WH-1) IN DRAIN PAN ON SHELF ABOVE MOP SINK (SHOWN OFFSET FOR CLARITY). ROUTE TAP RELIEF VALVE DISCHARGE AND PAN DRAIN TO MOP SINK. INSULATE ALL HOT WATER PIPING.
5. EXTEND NEW WATER PIPING TO EXISTING WATERLINE SERVING RESTROOM FIXTURES. VERIFY EXACT LOCATION OF CONNECTION POINT IN FIELD.
6. CONNECT NEW WASTEWATER PIPING TO EXISTING WASTEWATER DRAIN SERVING RESTROOM FIXTURES. VERIFY EXACT LOCATION OF CONNECTION POINT IN FIELD.
7. RECONNECT EXISTING FLOOR DRAIN TO NEW DRAIN PIPING.
8. CONNECT NEW VENT PIPING TO EXISTING VENT THROUGH ROOF. OFFSET ABOVE CEILING AS REQUIRED.

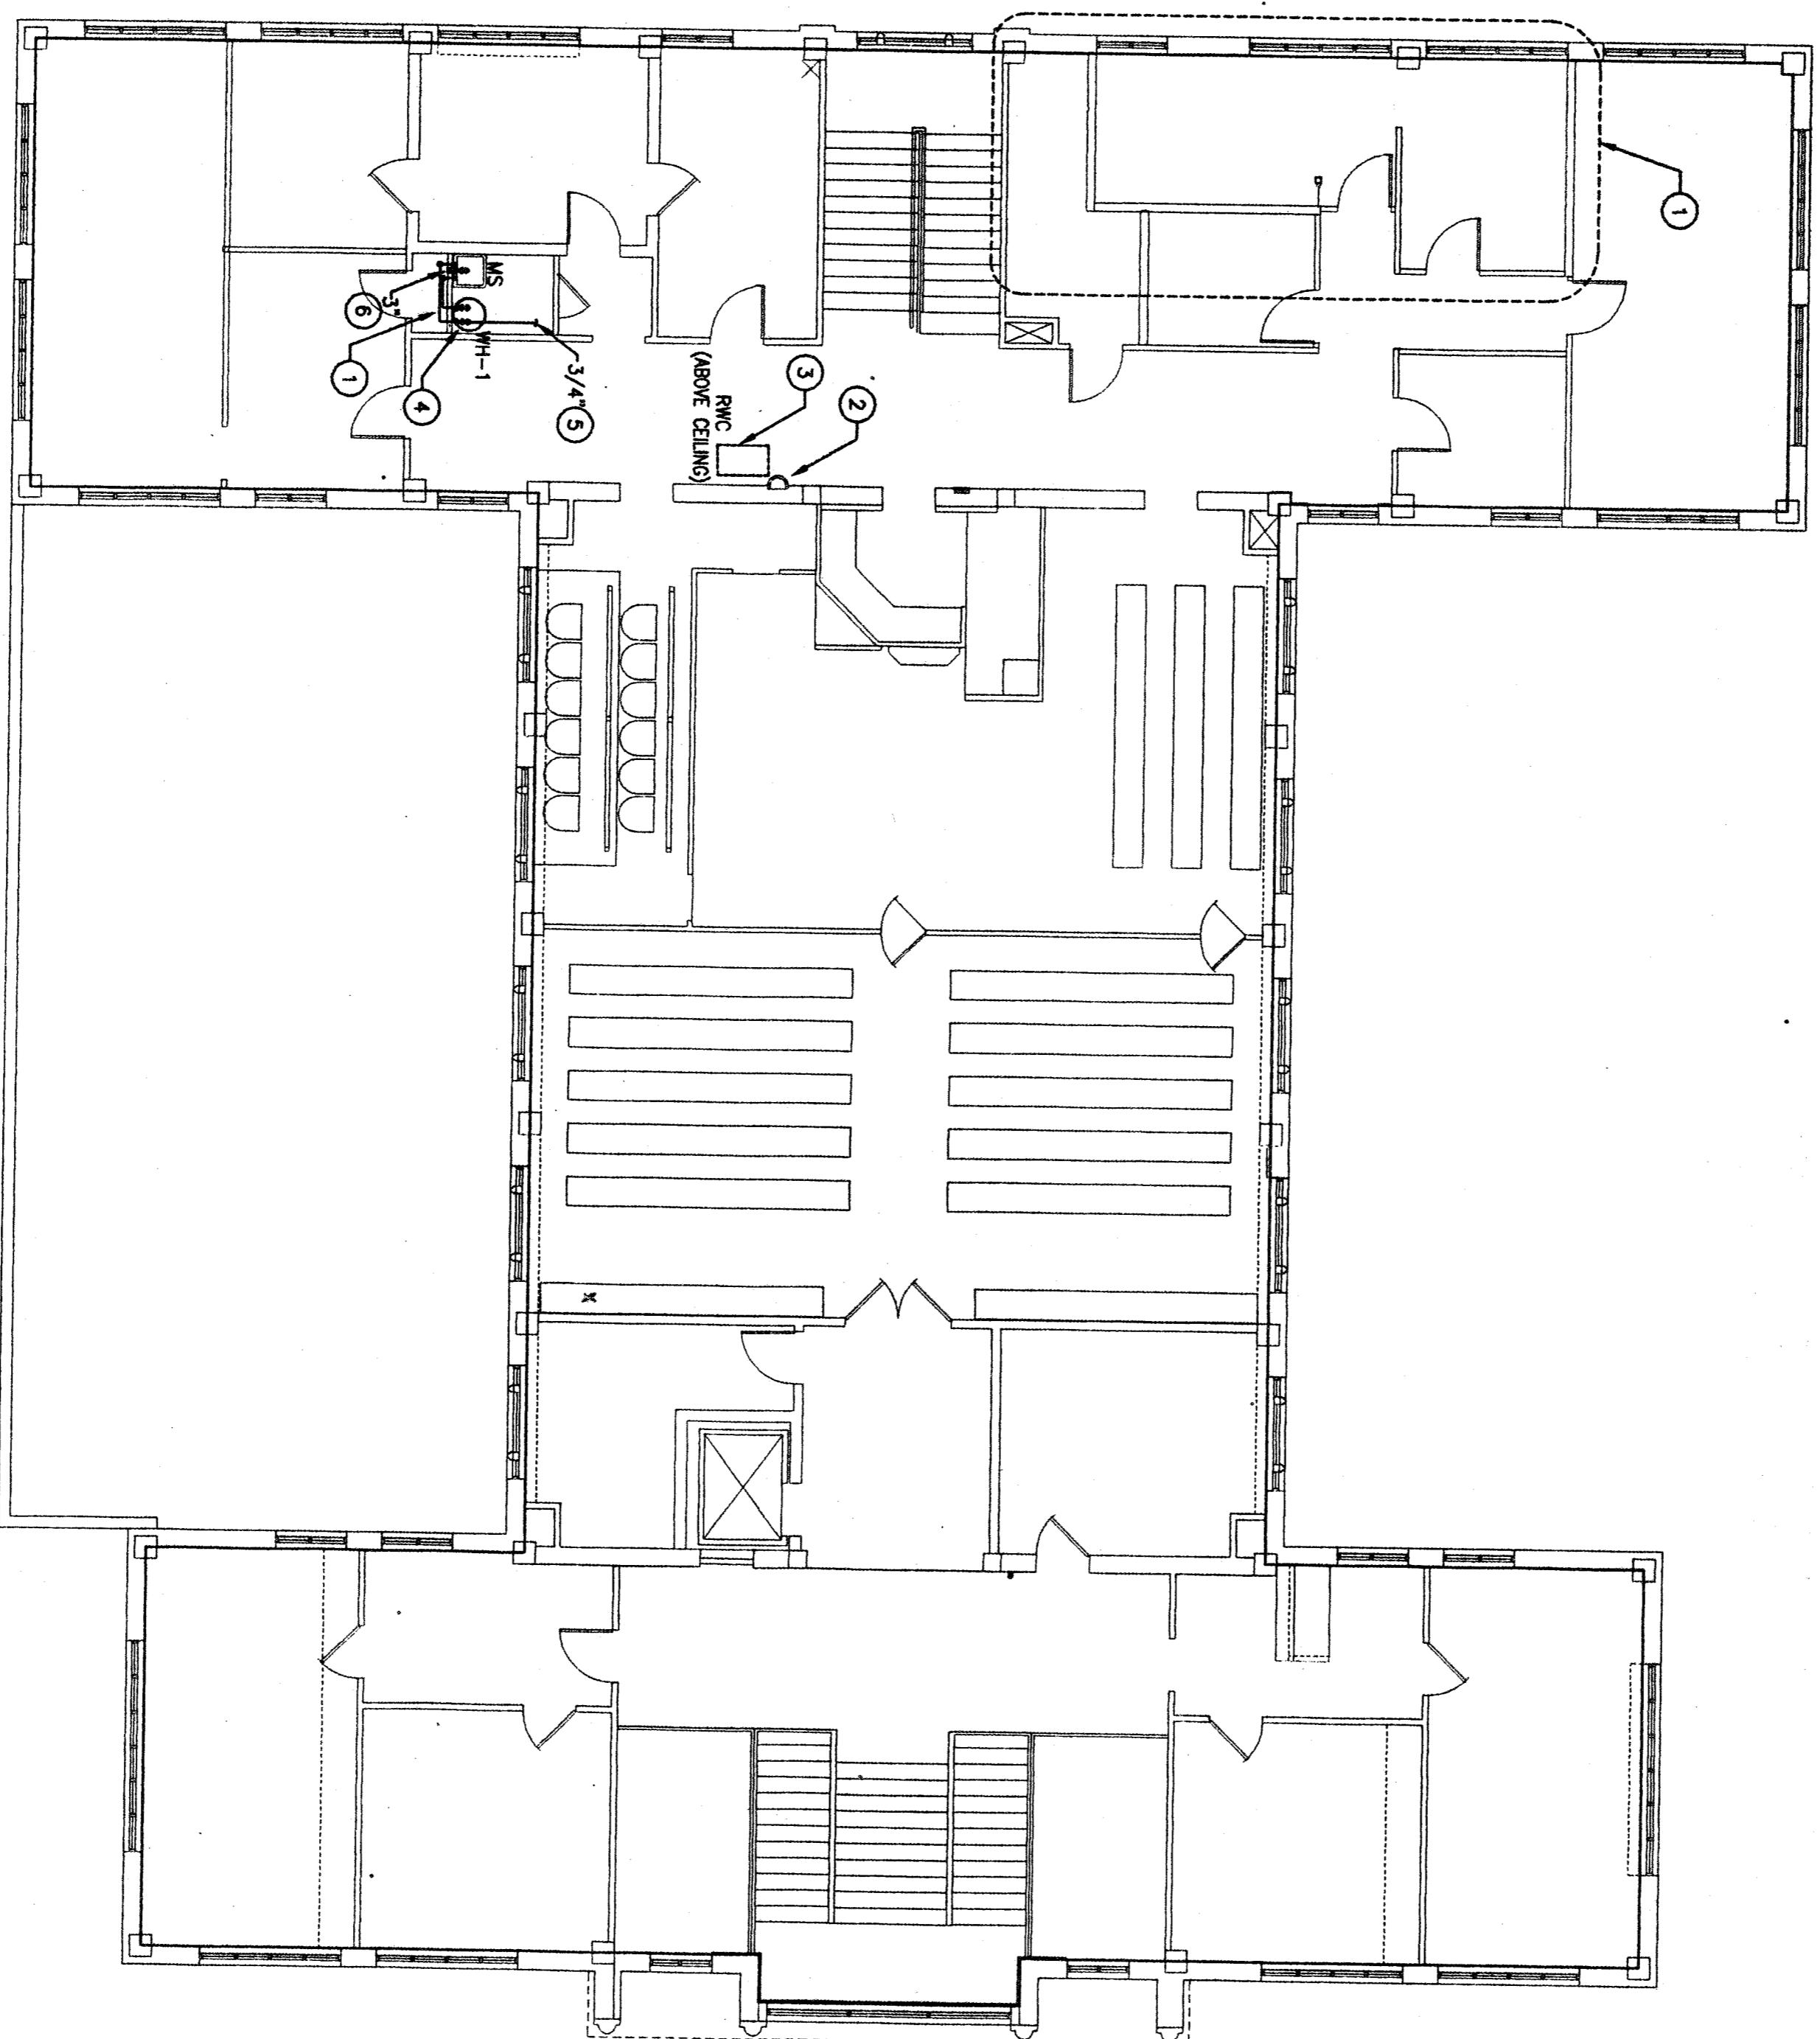

01 SECOND FLOOR PLAN - PLUMBING
SCALE: 1/8" = 1'-0"

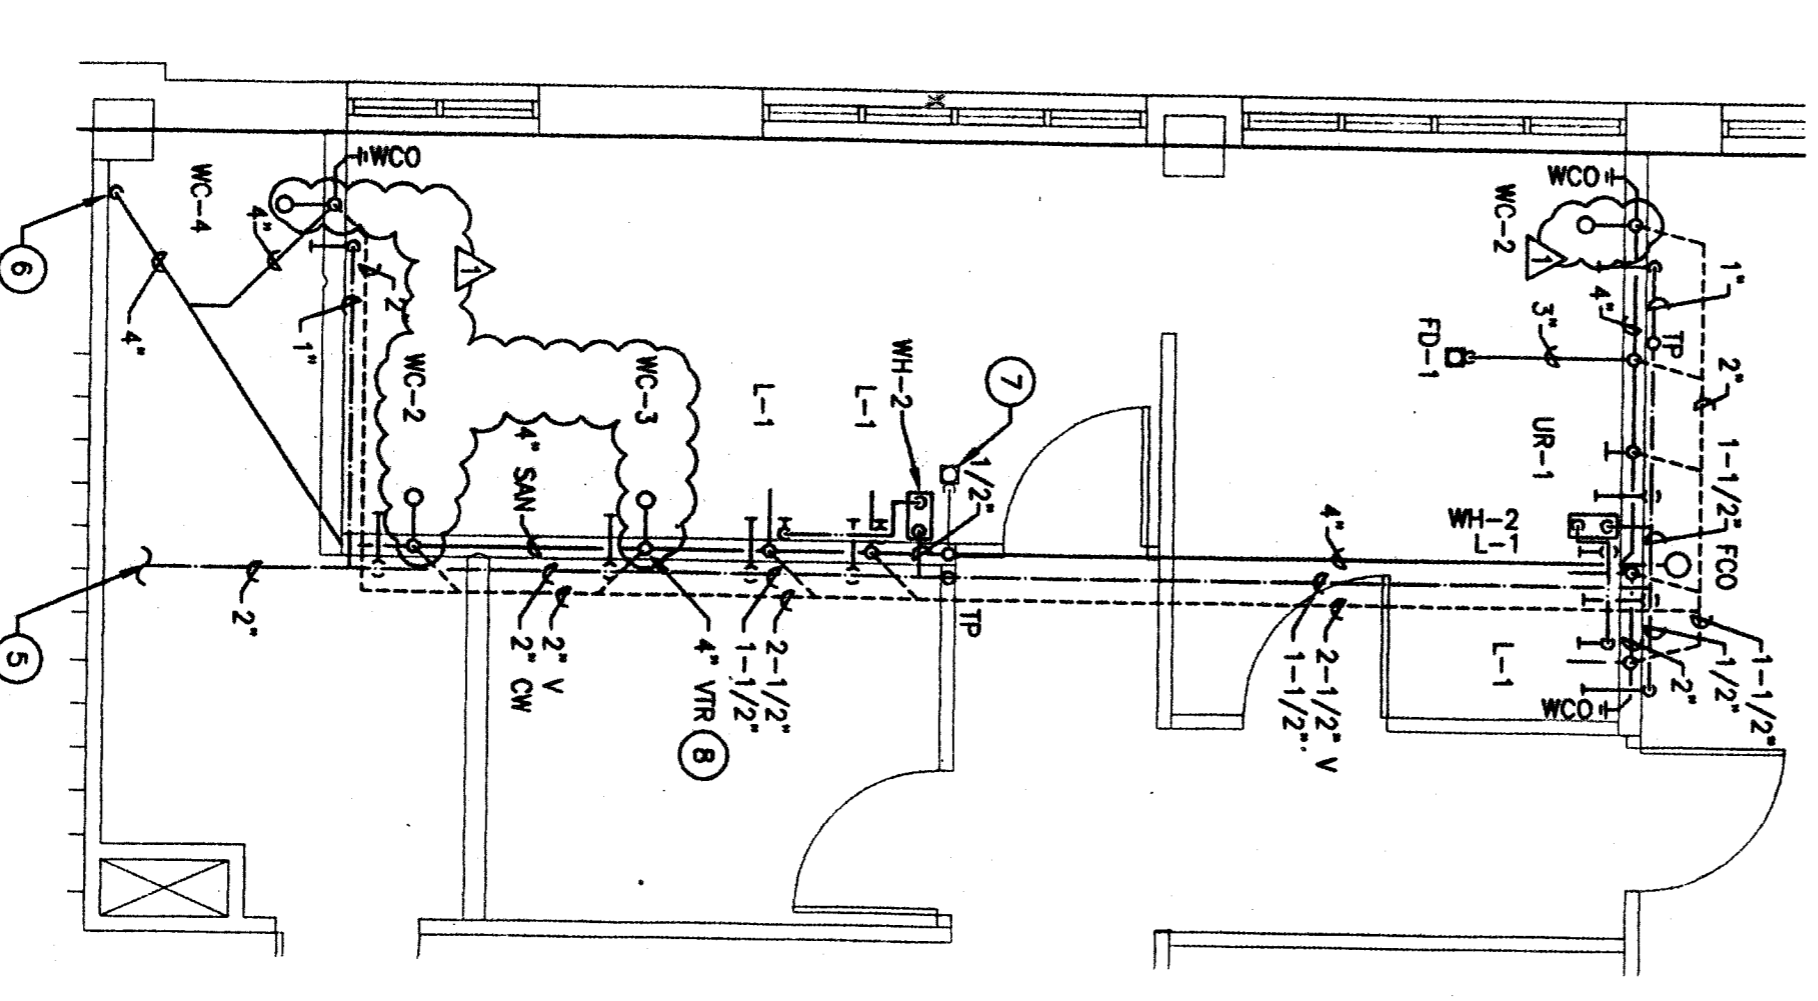

02 SECOND FLOOR PLAN - PLUMBING
SCALE: 1/4" = 1'-0"

REVISIONS

REVISION - ASI #2 - 07/29/02
REVISION - RFP #5 - 08/09/02

MYERS & ASSOCIATES

This document, the ideas and designs incorporated herein, are the property of Myers & Associates. These documents are not to be used for any other project or in any other form without the original intended use, nor are they to be assigned to any other party without the written consent of Myers & Associates.

M & A Job no.: 01-003

Sheet Title:
SECOND FLOOR PLAN PLUMBING


Project:
BURNET COUNTY COURTHOUSE
BURNET, TEXAS



ELLYN TEBERTEN ARCHITECTS INC.
407 & ROCK SPRING RD.
ORCKNEYTOWN, TEXAS 78055
TEL 512/893-1104 FAX 512/893-1182

Date: 06/10/2002
Proj. #: **P1.3**
Drawn by: MA
Issued for: BID

AS BUILT
10/21/02

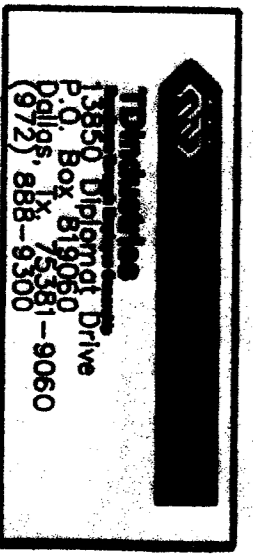

TTP Engineering
13950 Old Orchard Drive
P.O. Box 42289
Dallas, TX 75242-0289
(972) 888-5500

REVISIONS

M
MYERS &
A
ASSOCIATES

This document, the ideas and designs incorporated herein are and shall remain the property of Myers & Associates. These details or altered, in whole or in part, without the written permission of Myers & Associates.

M & A Job no.: 01-003

Blank Title


DETAILS
PLUMBING

Project
BURNETT
COUNTY
COURTHOUSE
BURNETT, TEXAS


11
13
P1.5

ELROY THIBERTSON ARCHITECTS INC.
907 S. ROCK STREET 102
GRANDTOWN, TEXAS 76048
TEL 512.691.1106 FAX 512.691.1382


Date: 06/10/2002
Page #: 11
Drawn By: MA
Issued For: BID

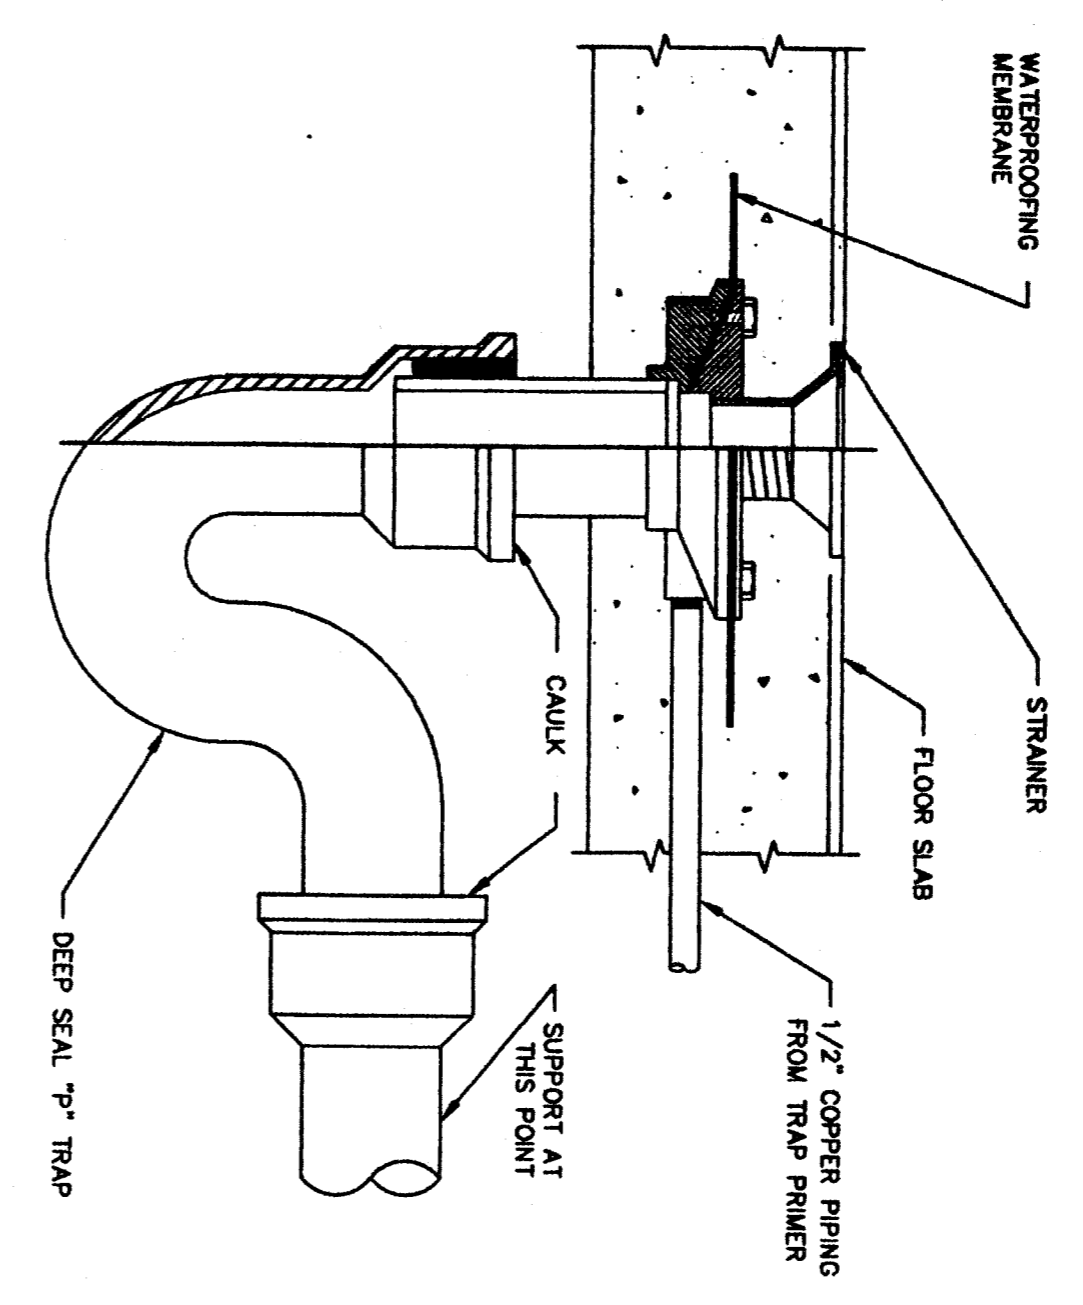


01 FLOOR DRAIN DETAIL
SCALE: N.T.S.

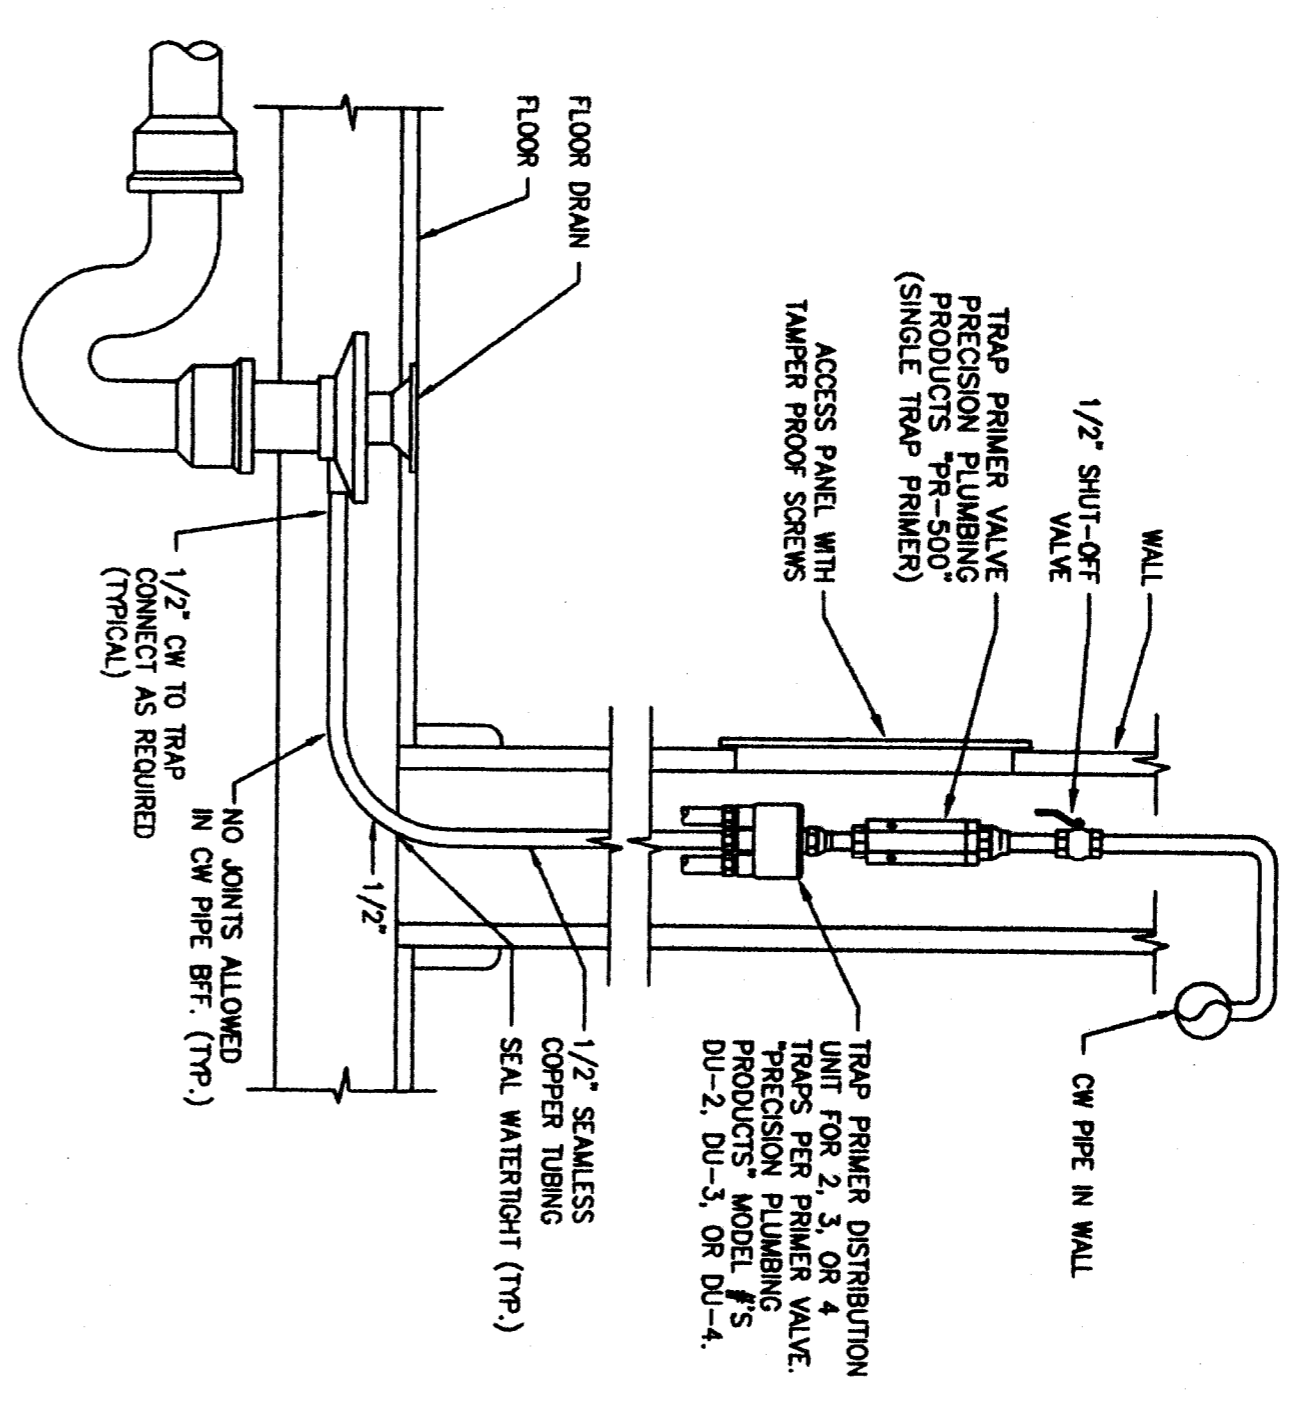


02 MULTIPLE TRAP PRIMER DETAIL
SCALE: N.T.S.

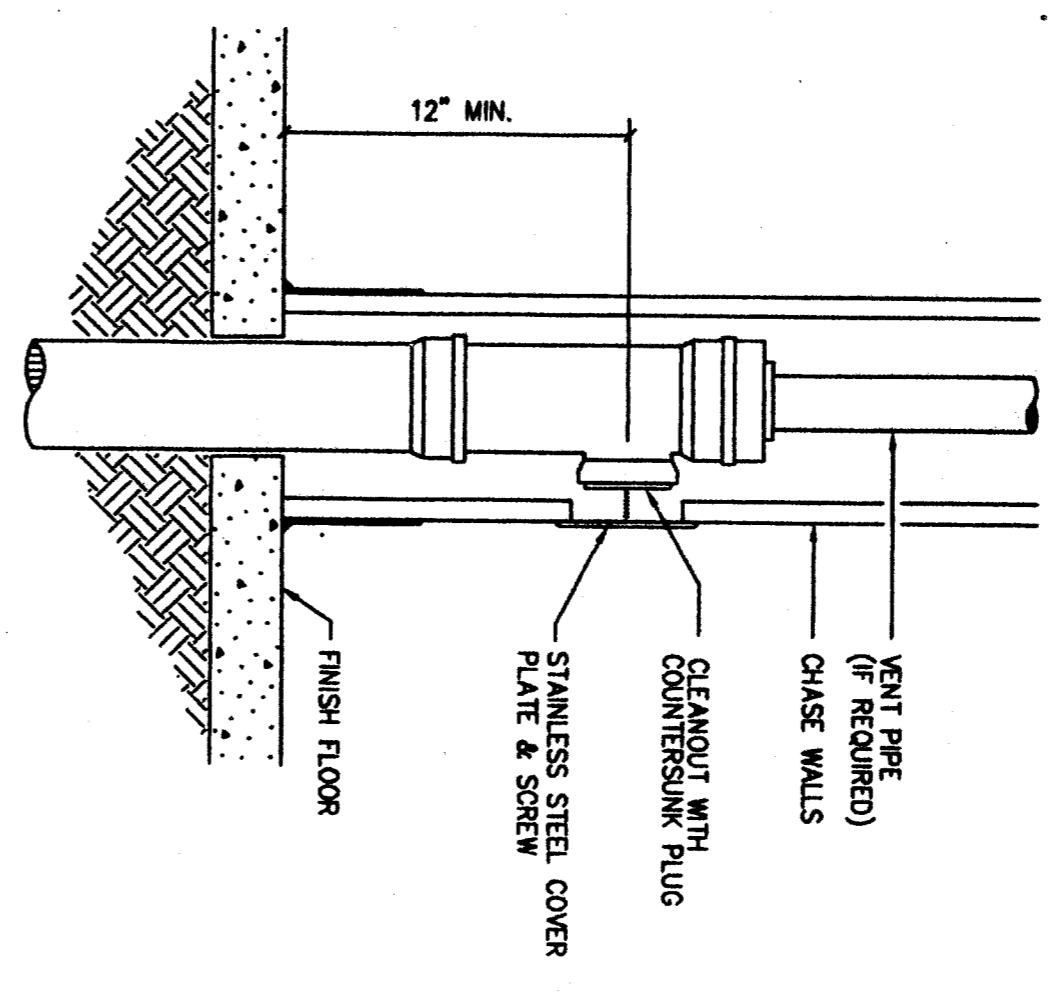


03 WALL CLEANOUT DETAIL
SCALE: N.T.S.

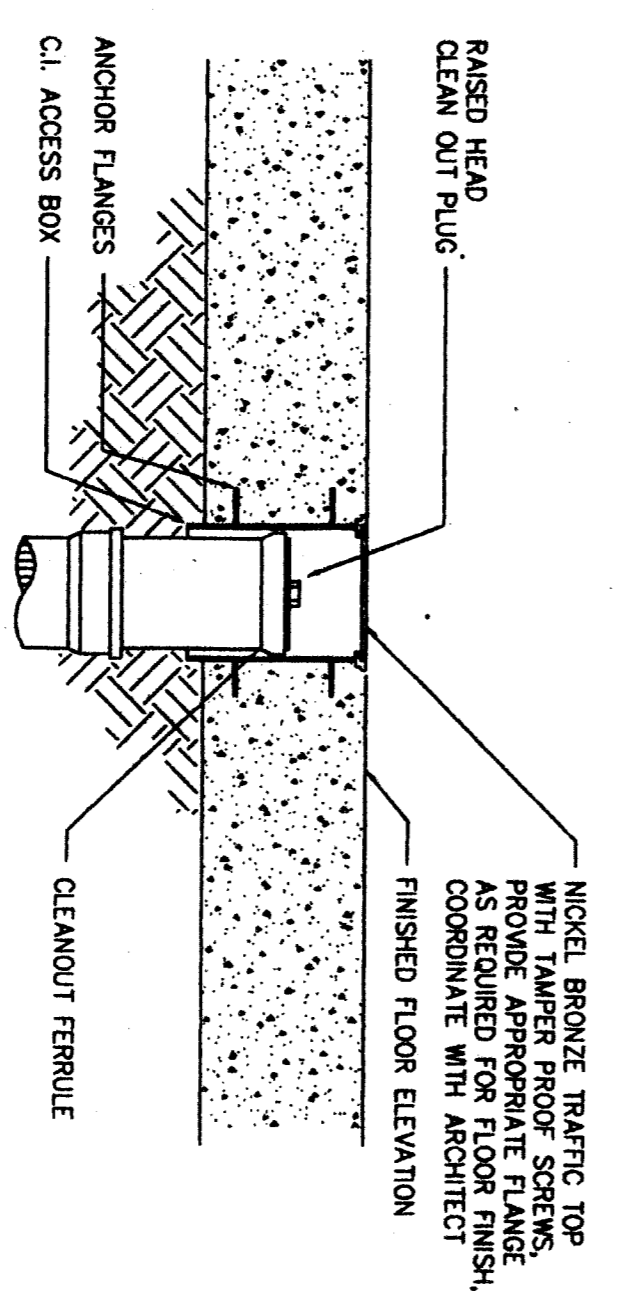

04 INTERIOR FLOOR CLEANOUT DETAIL
SCALE: N.T.S.

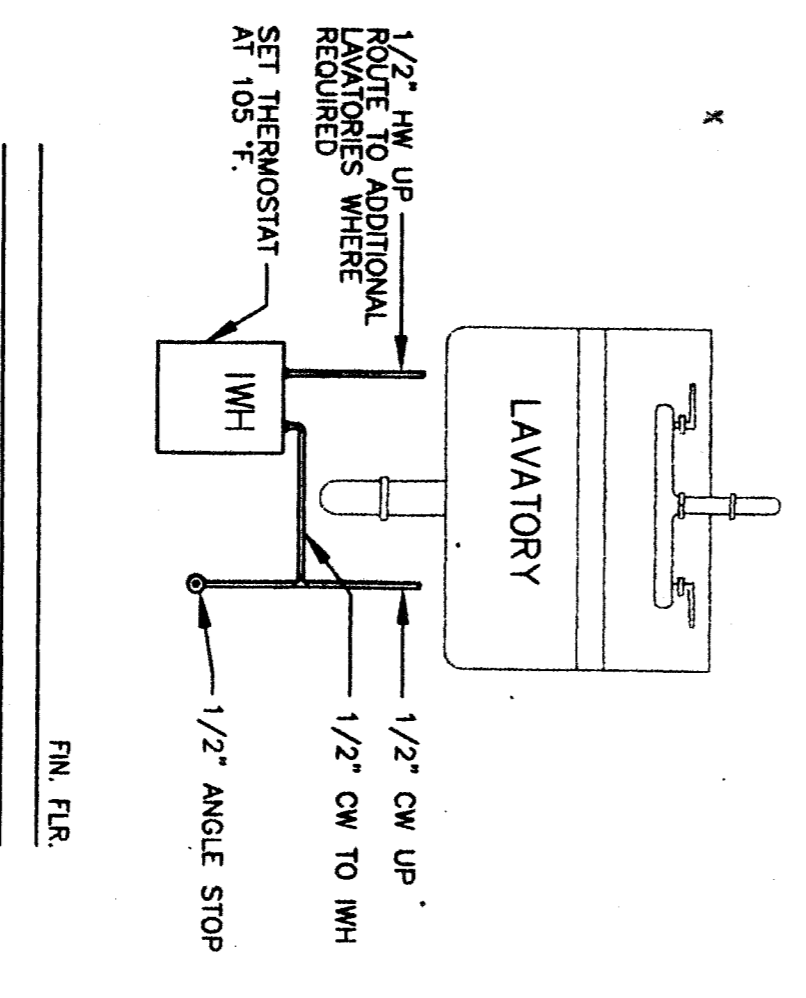

05 WATER HEATER DETAIL
SCALE: N.T.S.

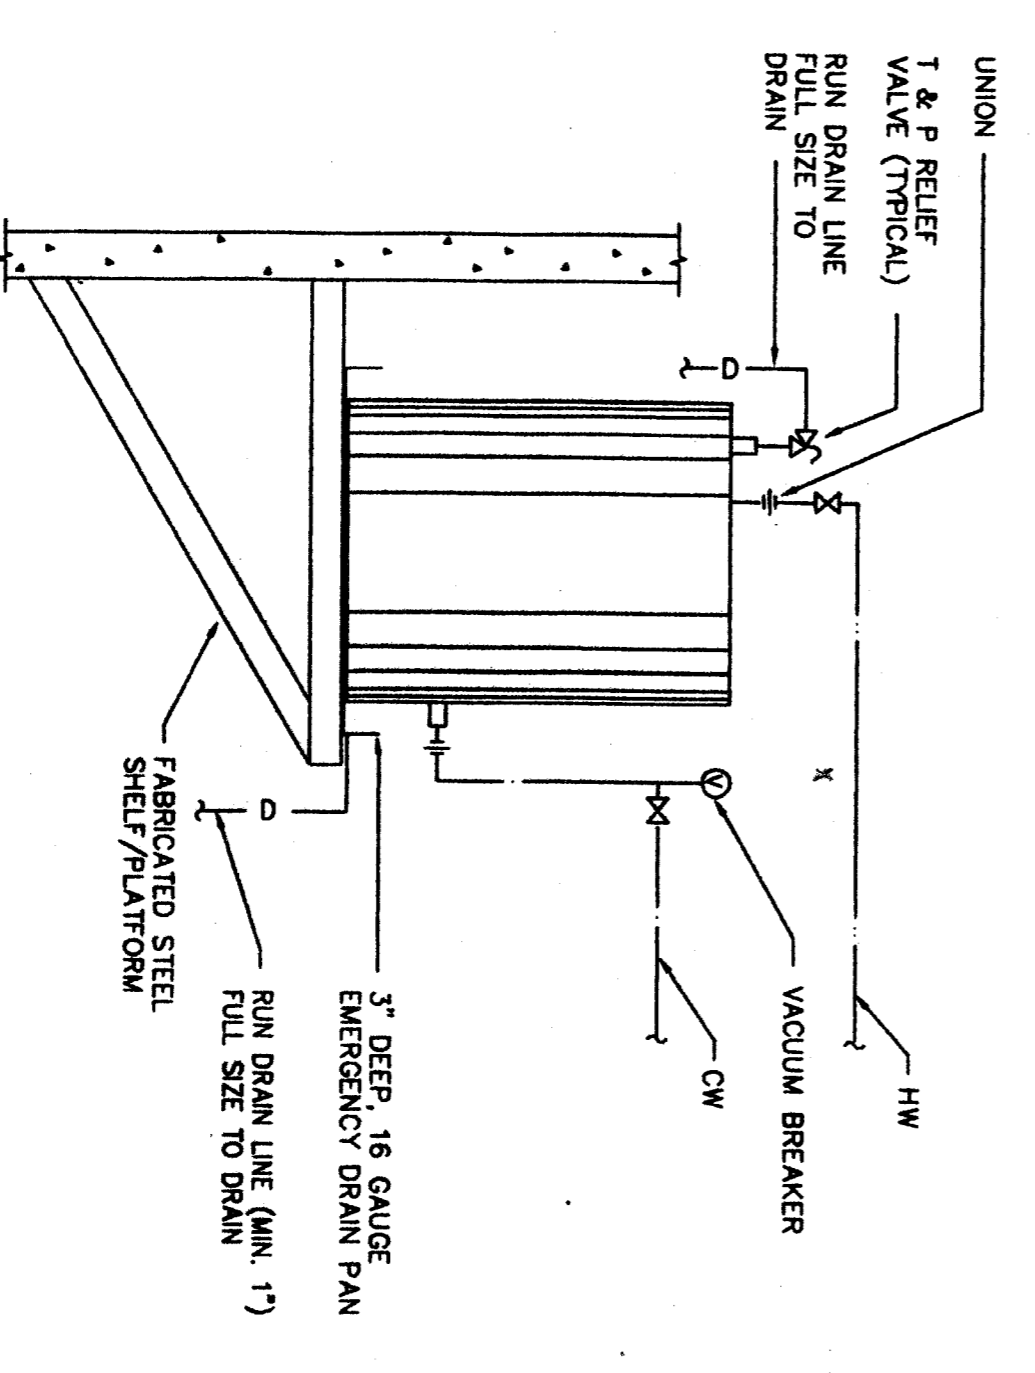

06 WATER HEATER DETAIL
SCALE: N.T.S.


AS BUILT
10/21/02

Thibertson
Architects
P.O. Box 876830
Dallas, TX 75287-6830
Tel: 972.488.5350 - 8060

KEYED NOTES

THESE NOTES APPLY TO THIS SHEET ONLY

- ① RUN DUCT UP INTO EXISTING BASEMENT VENTILATOR. HOLD AS FAR APART AS POSSIBLE.
- ② PROVIDE LOUVER WITH BIRDSCREEN IN EXISTING WINDOW CASING. LOUVER SHALL PROVIDE 400 SQUARE INCHES (218 SQUARE FEET) OF FREE AREA.
- ③ PROVIDE NEW LOUVER WITH BIRDSCREEN IN EXISTING WINDOW CASING. LOUVER SHALL PROVIDE SIX SQUARE FEET OF FREE AREA.
- ④ THE CONDENSATE DRAIN INTO EXISTING LAUNDRY TAIL PECE.

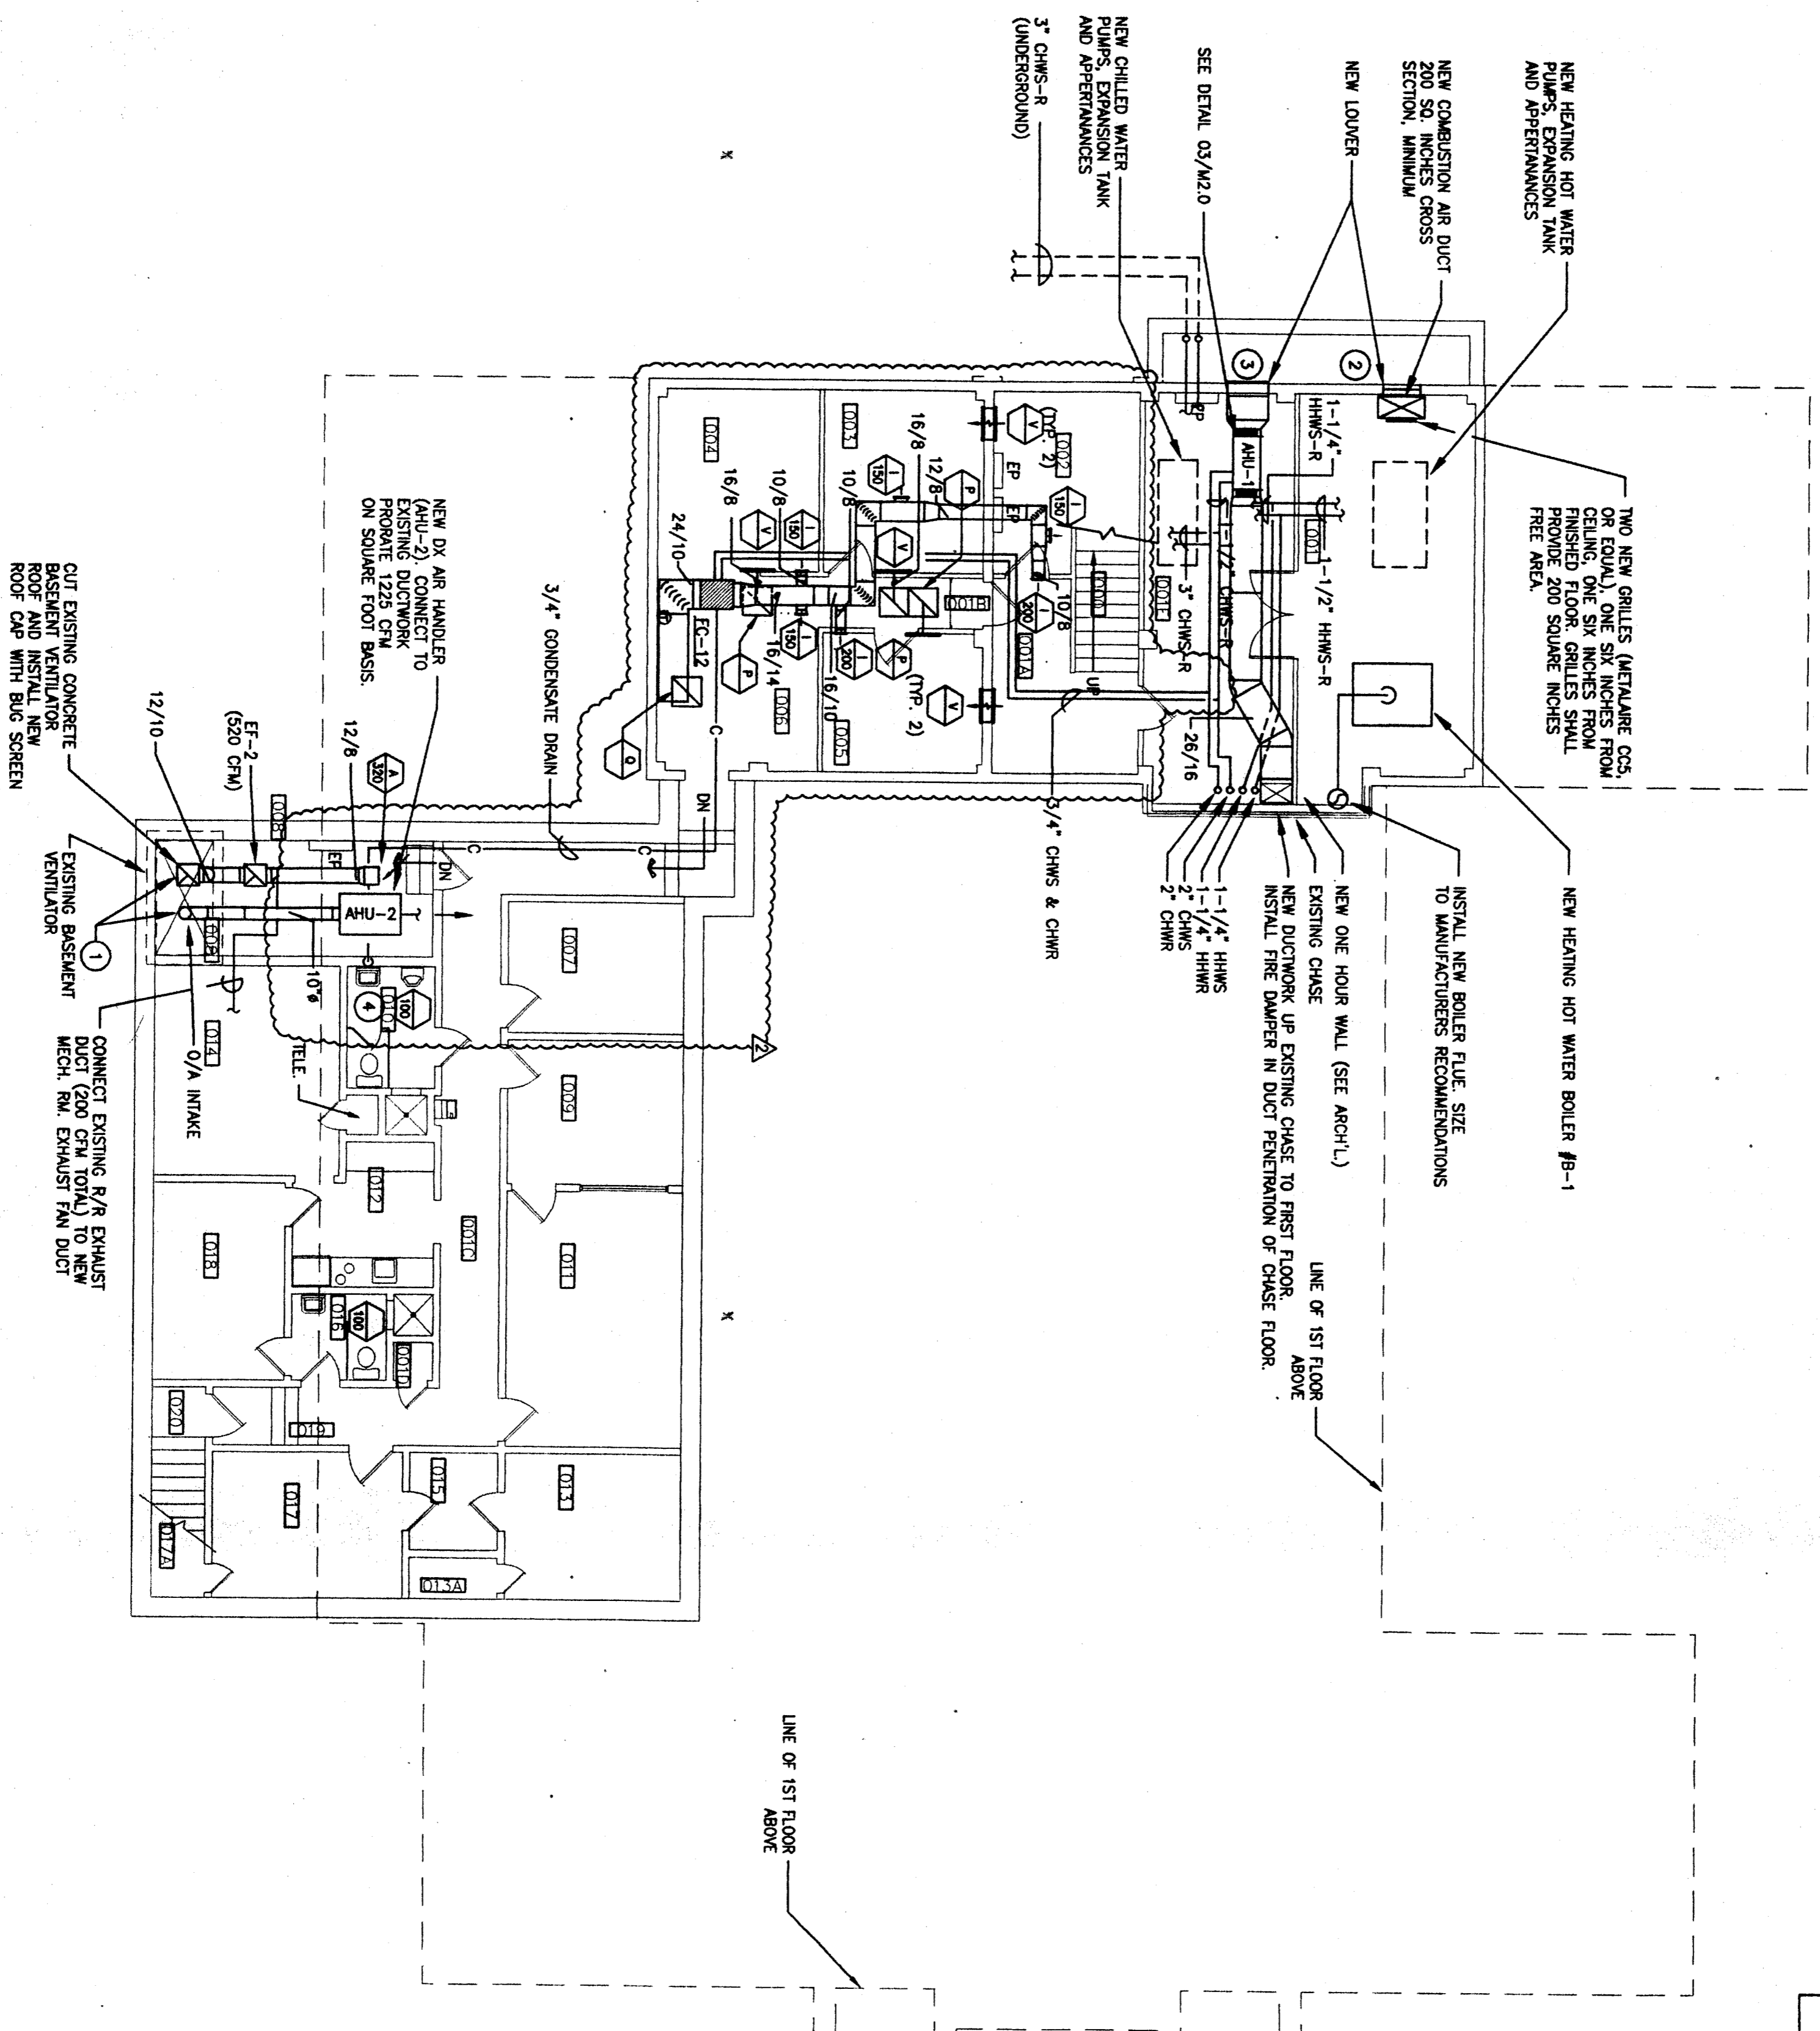

01 BASEMENT FLOOR PLAN - MECHANICAL

SCALE: 1/8" = 1'-0"

REVISIONS

Δ	REVISION - ASI #2 - 0729/02
Δ	REVISION - REP #5 - 08/09/02




This document, the ideas contained herein and all other information herein are the property of Myers & Associates. These documents are not to be used for any other project, in whole or in part, for other than the original intended use, nor are they to be assigned to any other person without the written permission from Myers & Associates.

M & A job no. 01-003

BASEMENT FLOOR PLAN MECHANICAL

Project:
BURNET COUNTY COURTHOUSE
 BURNET, TEXAS

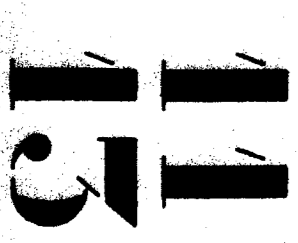

ELEVEN THIRTEEN ARCHITECTS INC.
 WY & BUCK BLDG 102
 COLUMBIA, TEXAS 76801
 TEL: 214/511-1101 FAX: 214/511-1102

Date: 06/10/2002

Sheet #

THE BURNET COUNTY COURTHOUSE
 1000 W. BURNET DRIVE
 BURNET, TEXAS 76801
 TEL: 214/511-1101 FAX: 214/511-1102

REVISIONS

Δ	REVISION - ASI #2 - 07/29/02
Δ	REVISION - RFP #5 - 08/09/02

MYERS & ASSOCIATES

This document, the ideas and design herein, are the property of Myers & Associates. These documents are not to be copied, altered, in whole or in part, for other than the original intended use, nor any third party without written permission from Myers & Associates. © M & A job no. 01-003



Sheet Title:
FIRST FLOOR HVAC PLAN MECHANICAL

Project:
BURNETT COUNTY COURTHOUSE BURNETT, TEXAS



ELVYN THURTELL ARCHITECTS INC.
707 S. ROCK SPRING
GARDEN CITY, TEXAS 75648
TEL 512.861.1100 FAX 512.861.1362


Date: 06/10/2002
Drawn by: MA
Checked by: BJD
M1.2

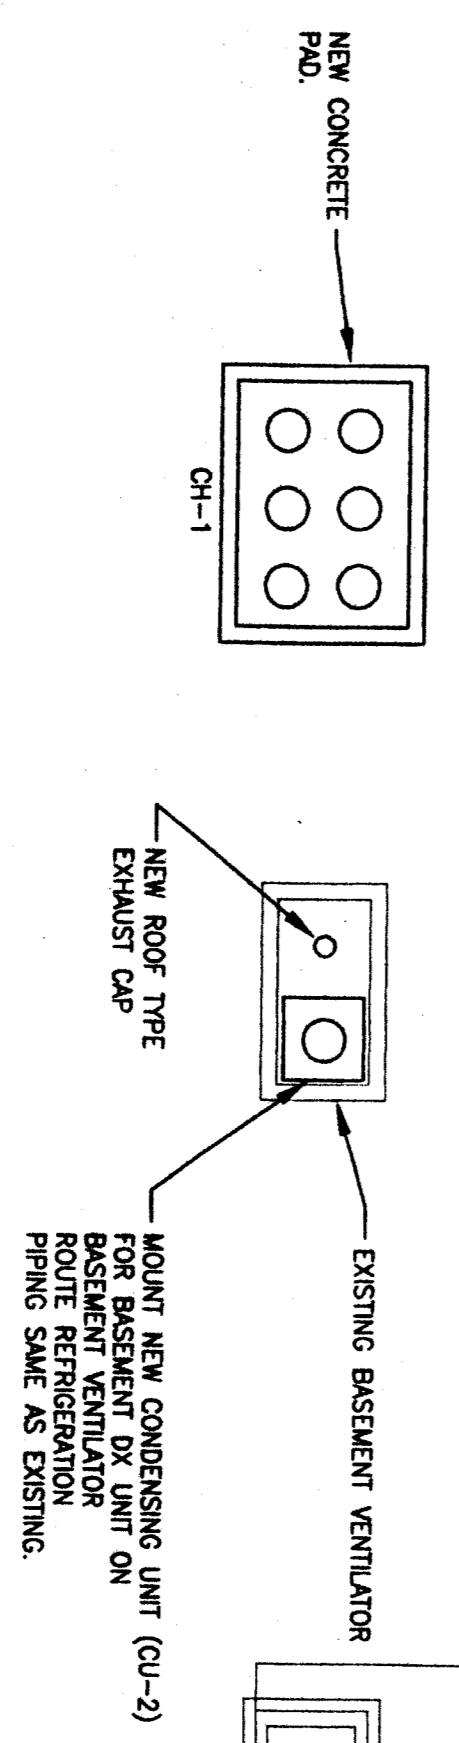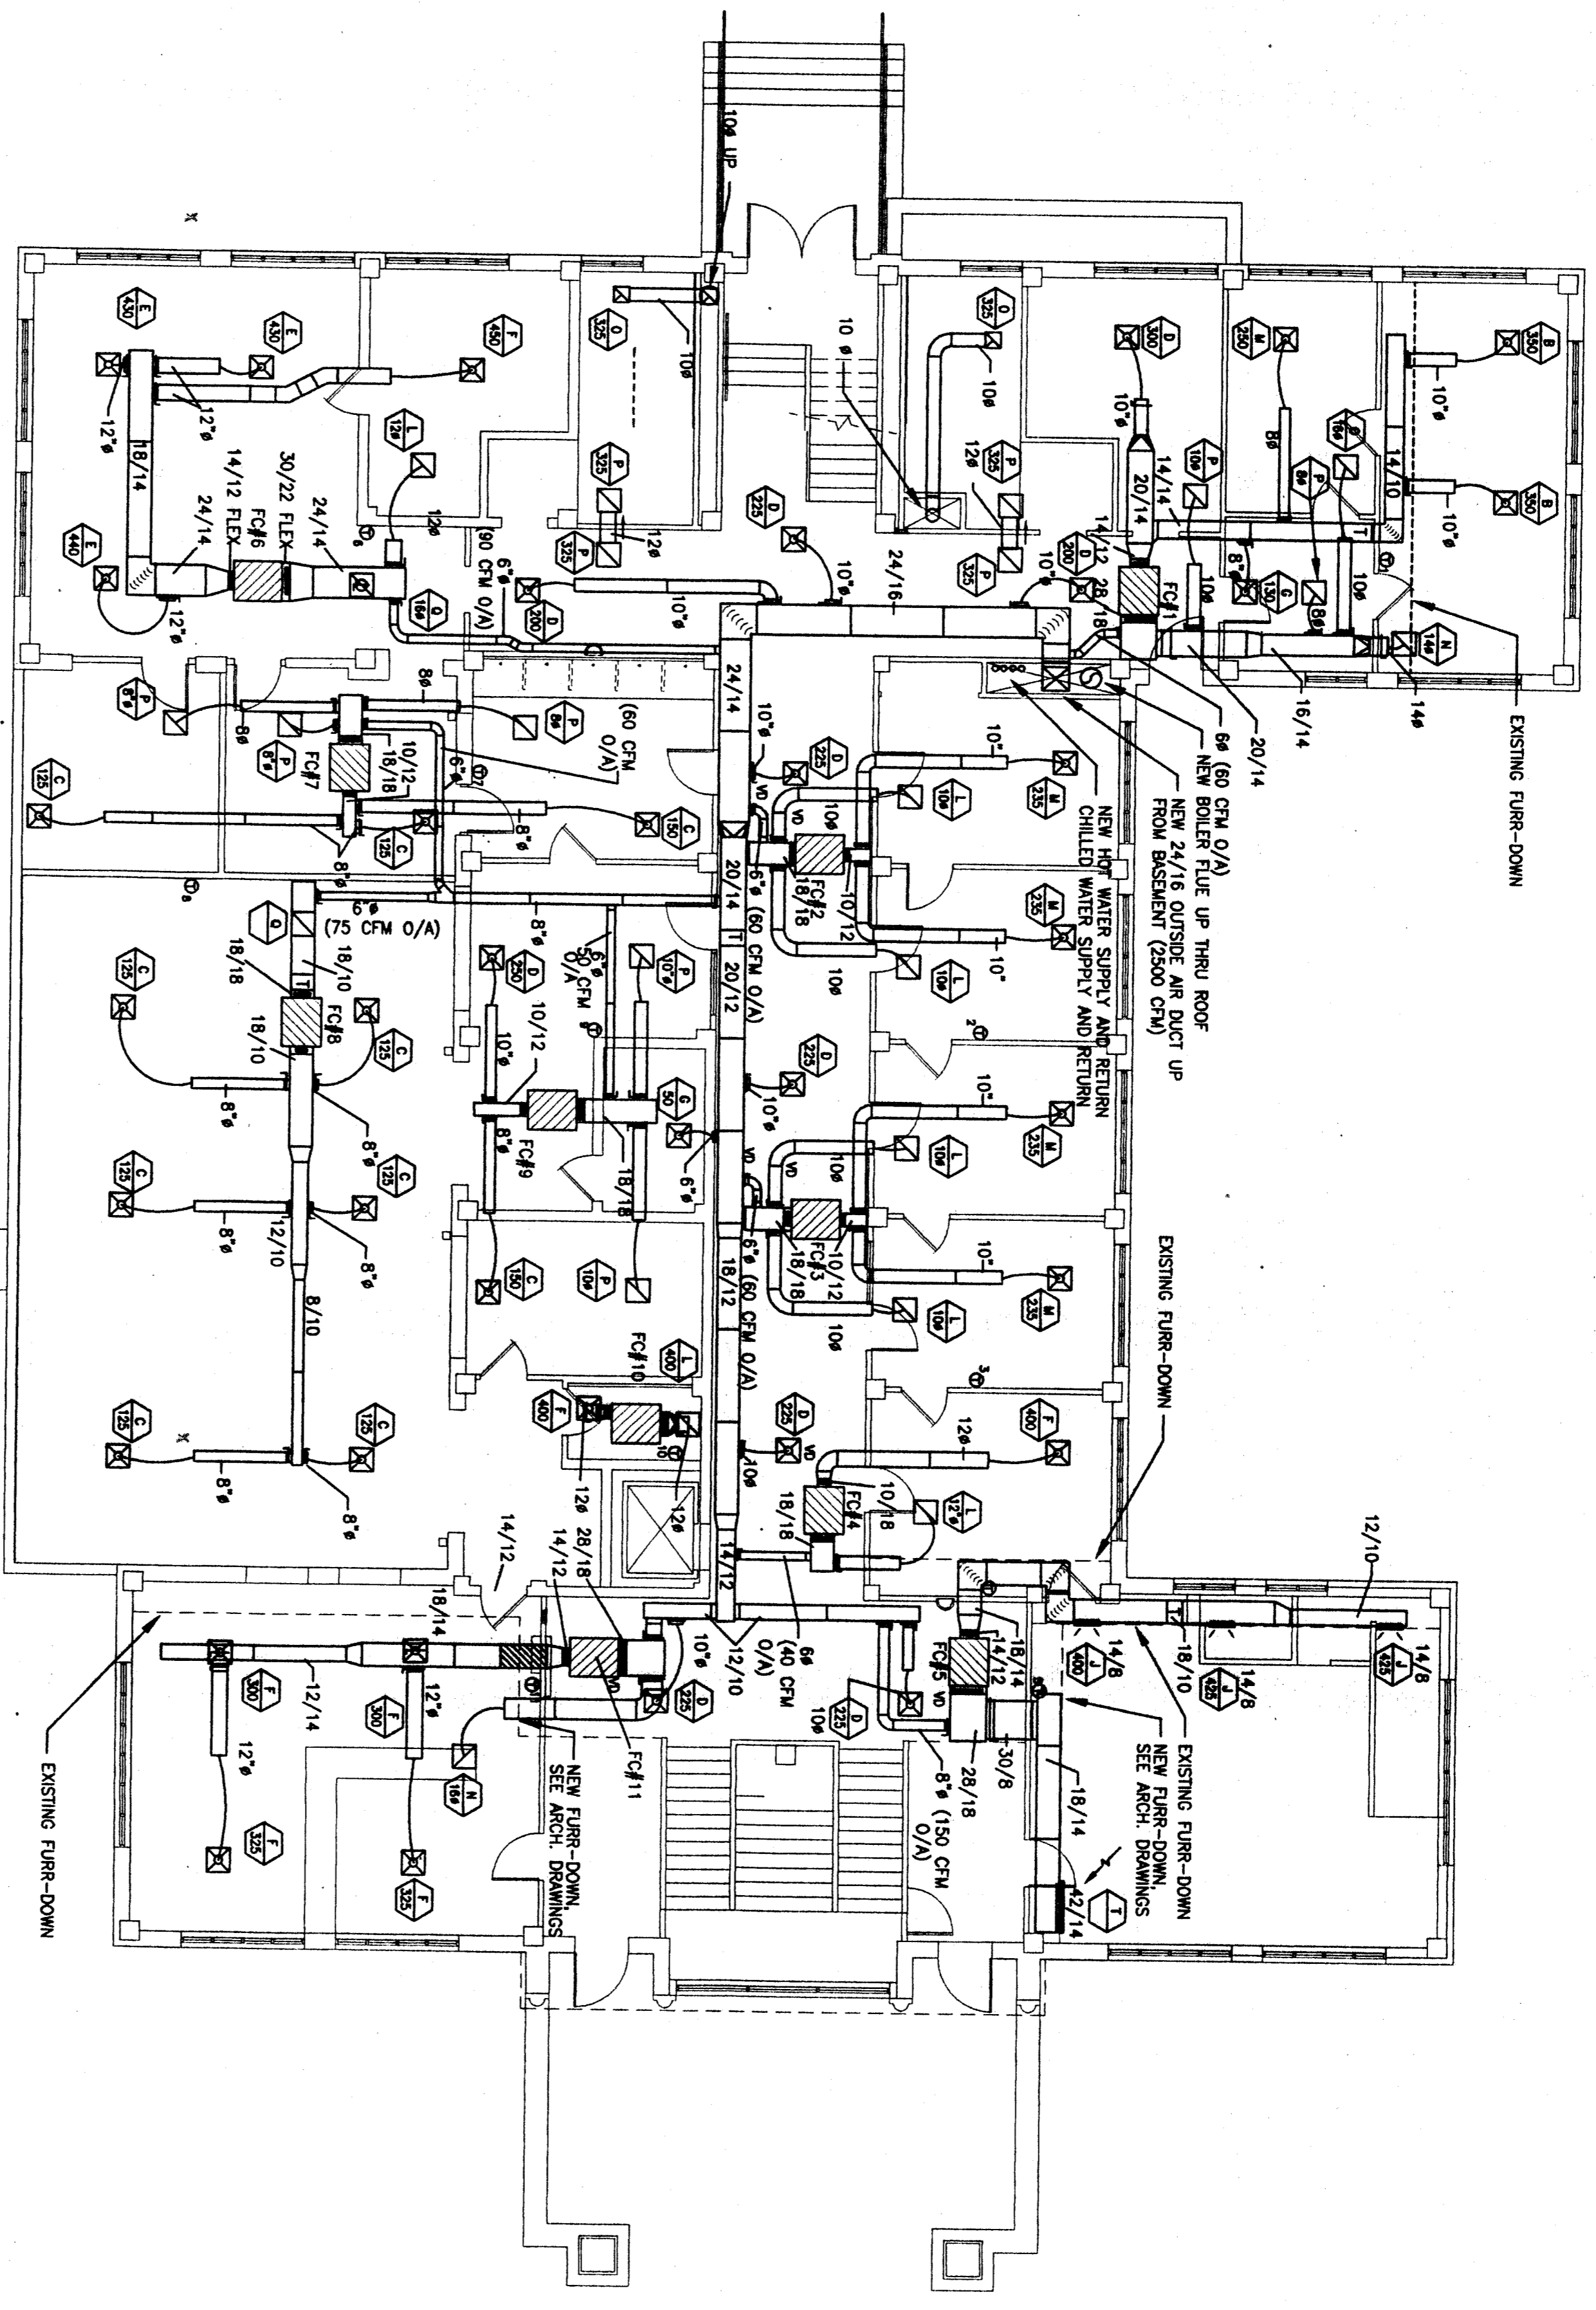

01 FIRST FLOOR HVAC PLAN - MECHANICAL
SCALE: 1/8" = 1'-0"

AS BUILT
10/21/02

THURTELL ARCHITECTS INC.
13959 Oldham Drive
Dallas, TX 75244
(972) 888-8300

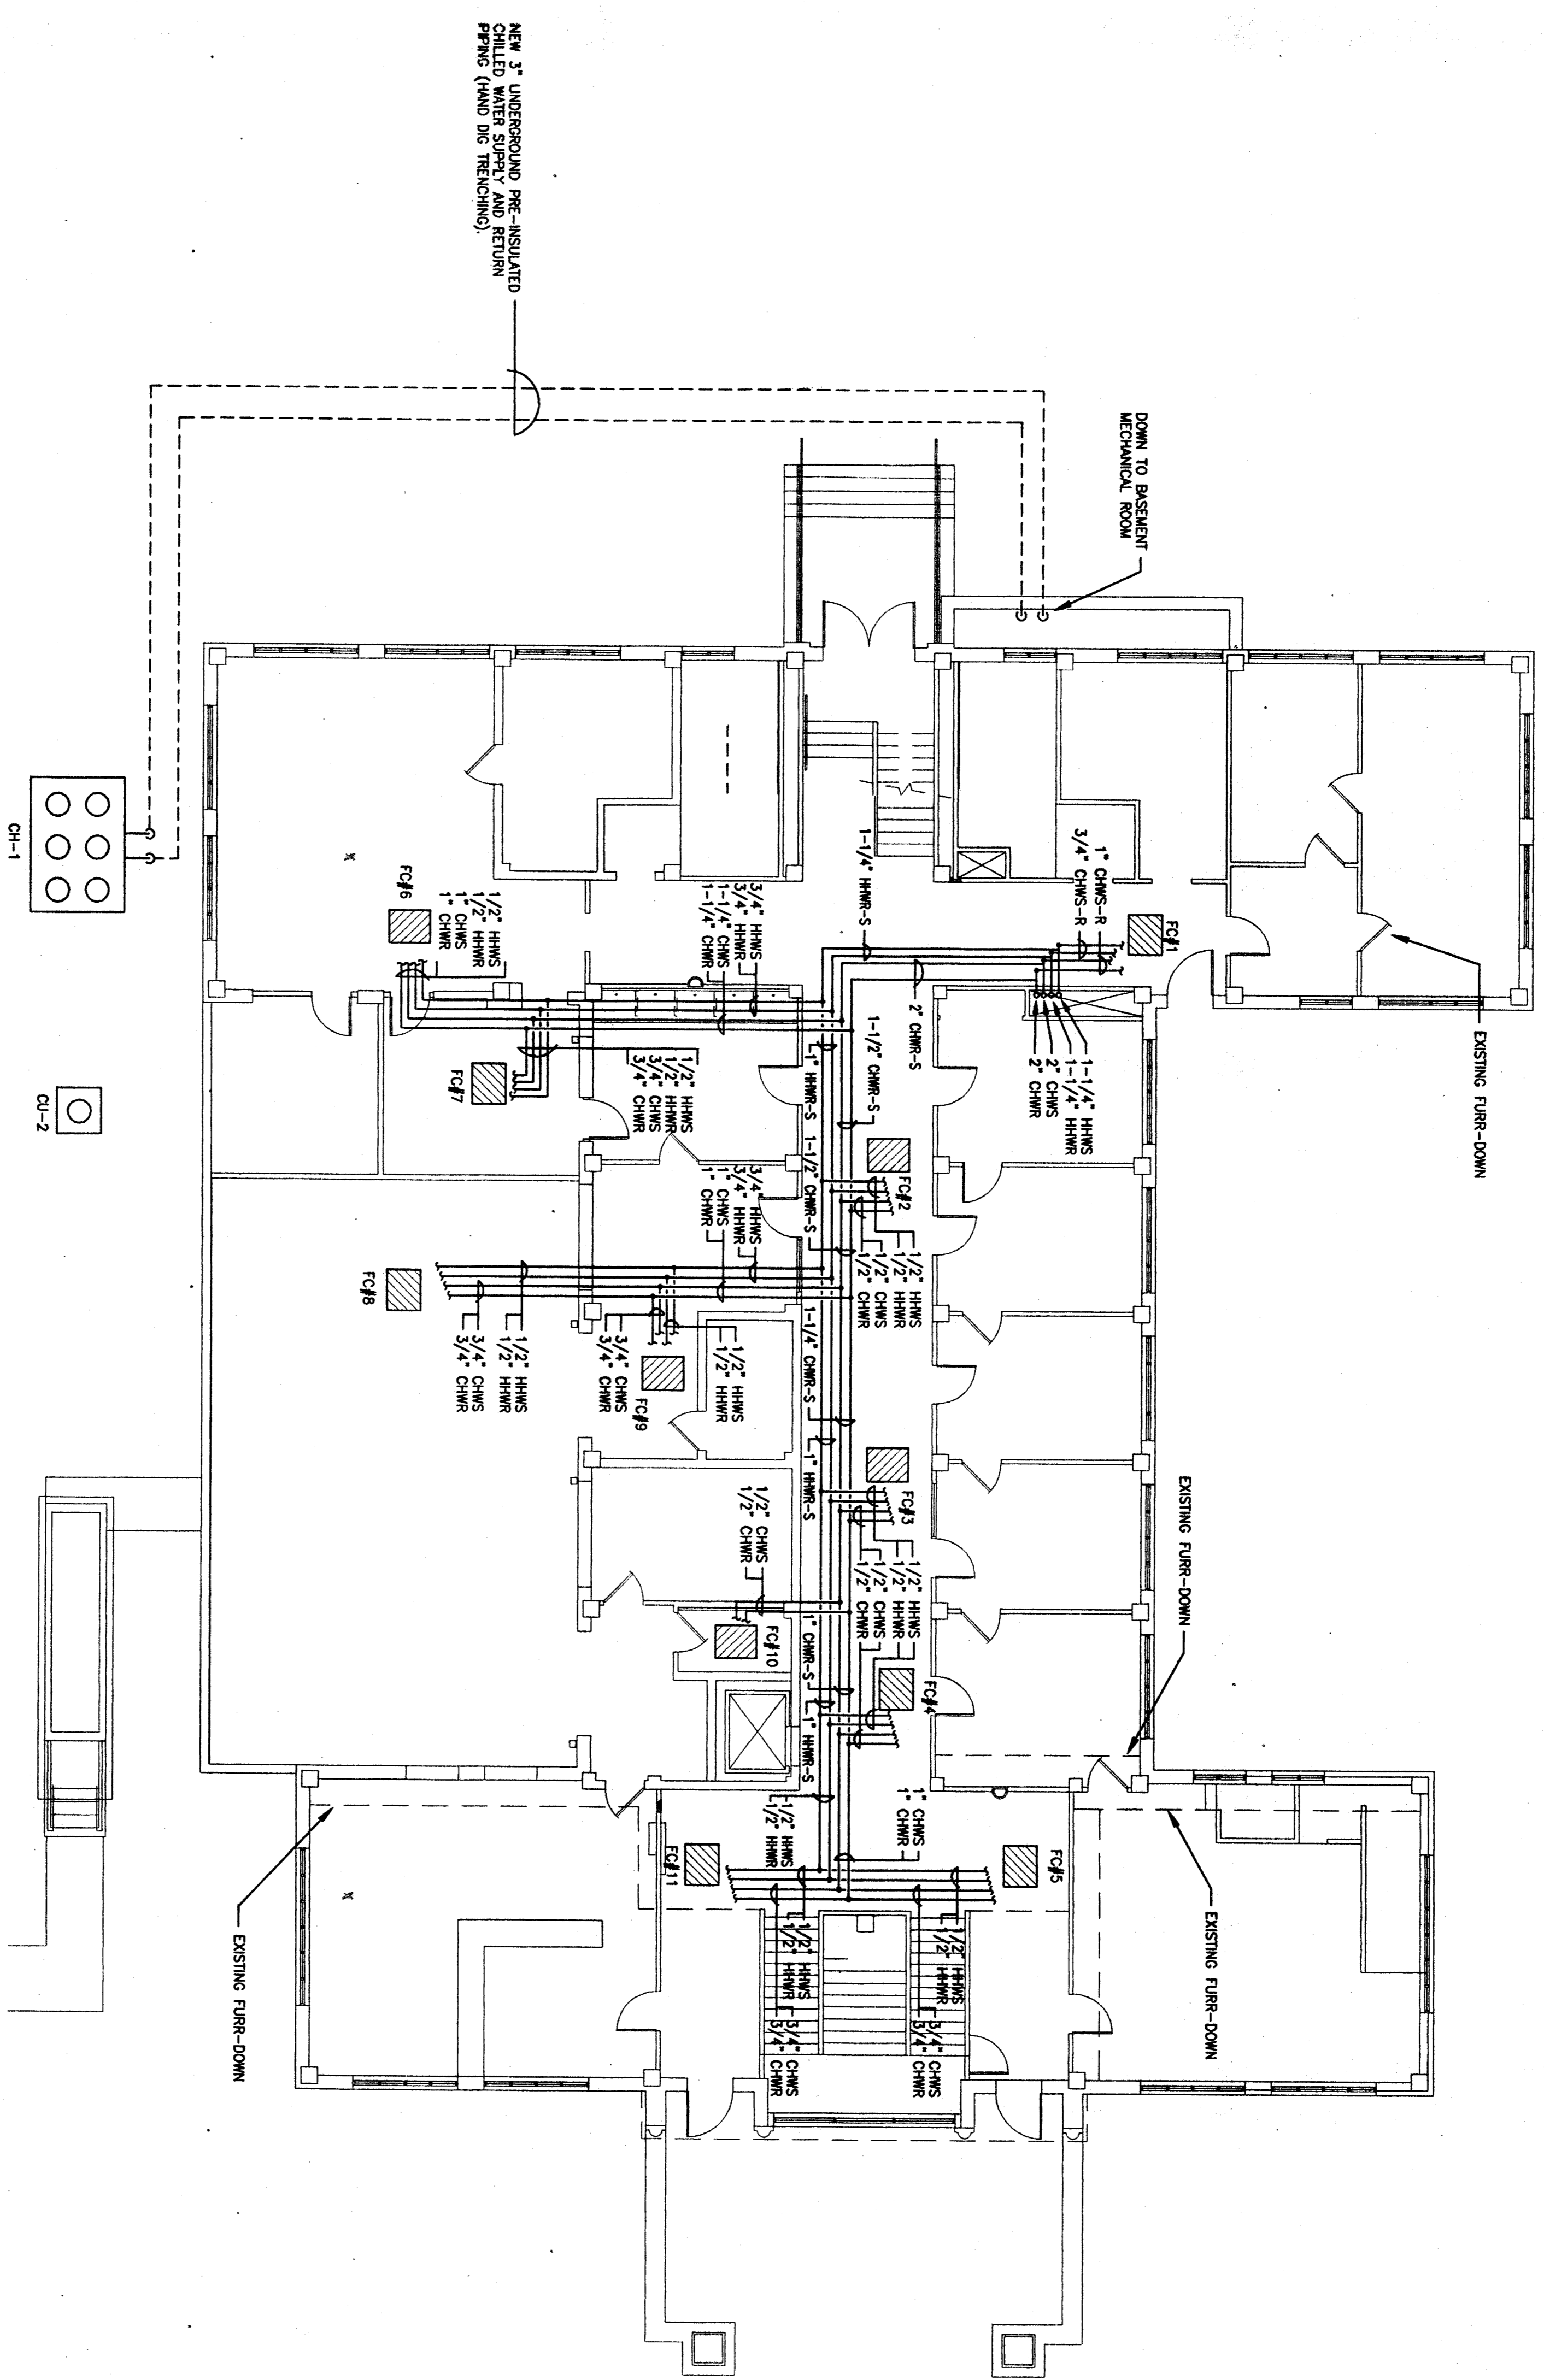

01 FIRST FLOOR PIPING PLAN - MECHANICAL
SCALE: 1/8" = 1'-0"

NEW 3" UNDERGROUND PRE-INSULATED
CHILLED WATER SUPPLY AND RETURN
PIPING (HAND DIG TRENCHING)


DOWN TO BASEMENT
MECHANICAL ROOM

EXISTING FURR-DOWN

EXISTING FURR-DOWN

EXISTING FURR-DOWN

EXISTING FURR-DOWN

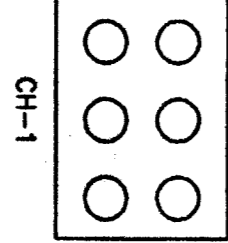

M
YERS &
A
SSOCIATES


This document, the ideas herein are and shall remain the property of Myers & Associates, Inc. These documents are not to be reproduced, copied, or altered, in whole or in part, for other than the original intended use, nor any third party without written permission from Myers & Associates. © M & A Job no.: 01-003

Xref KAG

REVISIONS	
Δ	REVISION - ASI #2 - 07/29/02
Δ	REVISION - RFP #5 - 08/09/02

Sheet Title:
**FIRST FLOOR
PIPING PLAN
MECHANICAL**

Project:
**BURNET
COUNTY
COURTHOUSE
BURNET, TEXAS**

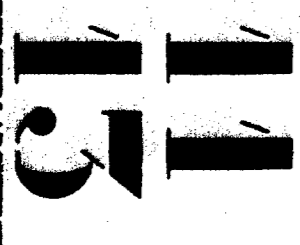

ELEVEN THIRTEEN ARCHITECTS INC.
407 S. ROCK BLVD. SUITE 102
GARDEN CITY, TEXAS 75646
TEL: 972.261.1100 FAX: 972.261.1183

Date: 06/10/2002
Drawn by: MA
Checked by: BJD
M1.3

AS BUILT
13500 Dingsdale Drive
P.O. Box 810000
Dallas, TX 75281-0000
(972) 888-5300

10/21/02



REVISIONS

△	REVISION - ASI #2 - 07/20/02
△	REVISION - RFP #5 - 08/09/02

KEYED NOTES


THESE NOTES APPLY TO THIS SHEET ONLY

- 1 DROP 8/10 RETURN DUCT DOWN EXISTING CHASE TO EXISTING RETURN GRILLE. SEAL BOTTOM OF CHASE.
- 2 EXISTING HIGH RETURN GRILLE. REMOVE AND FINISH WALL.

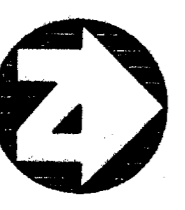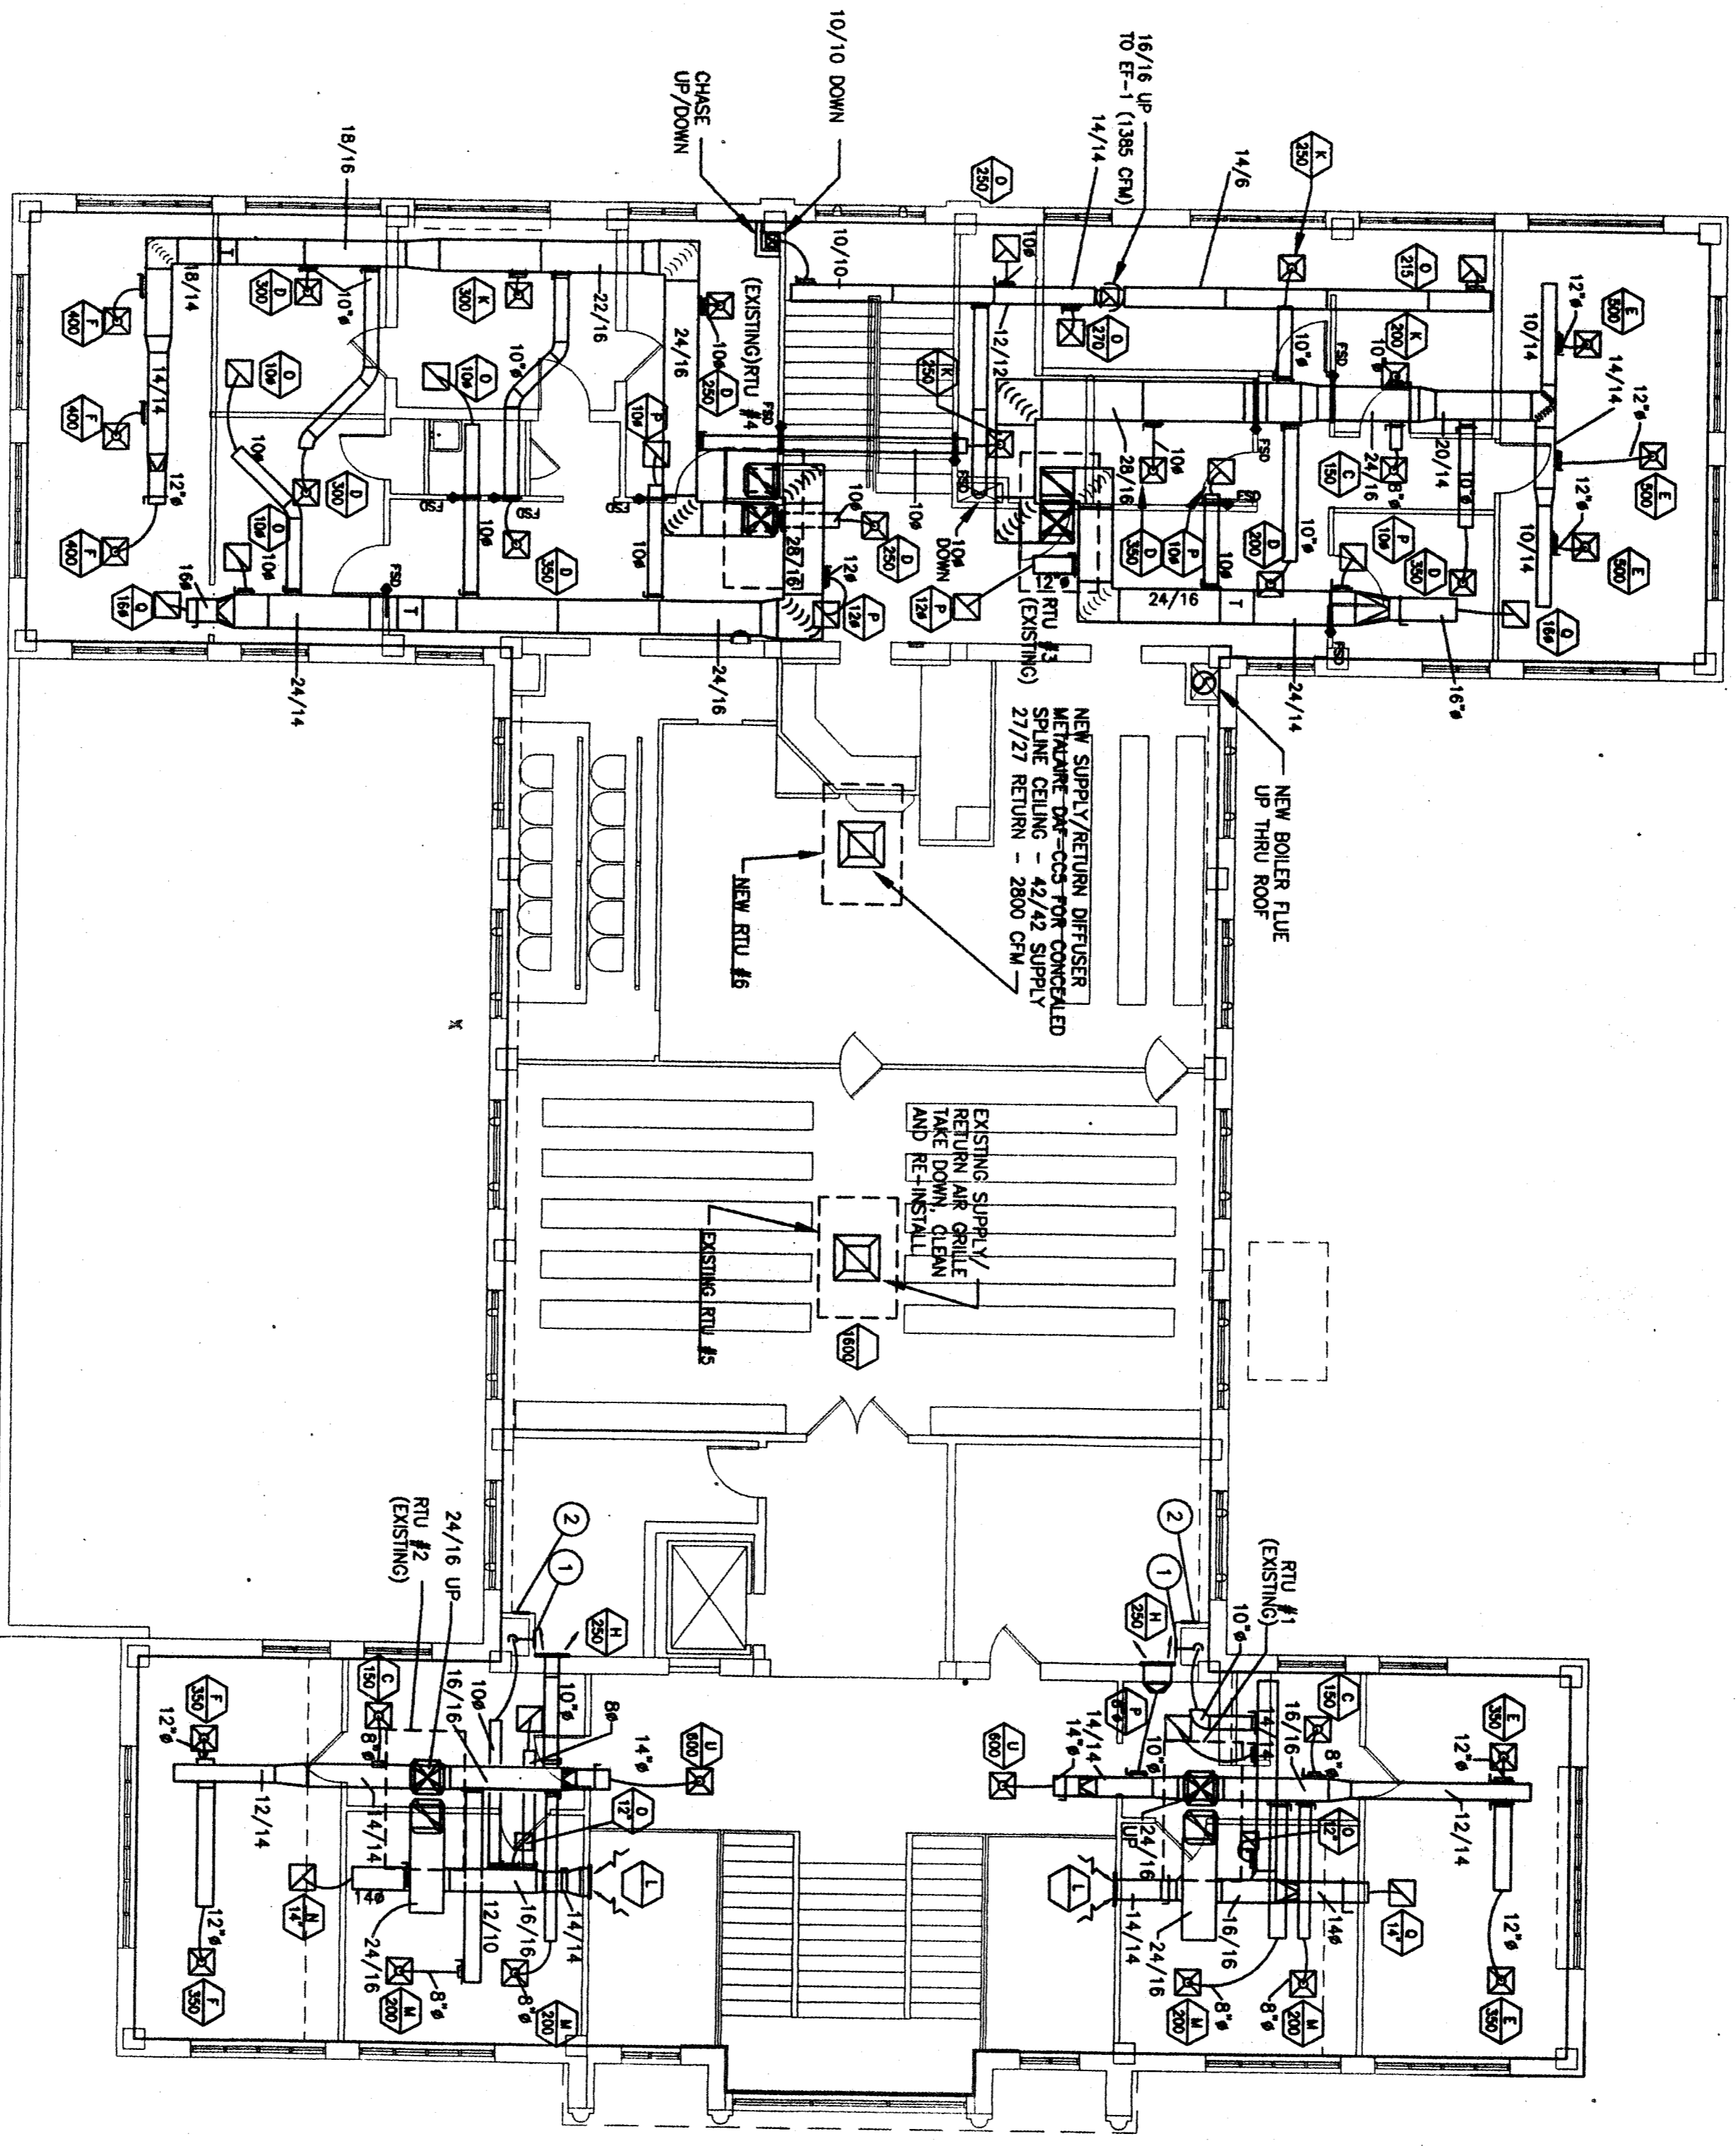

01 SECOND FLOOR HVAC PLAN - MECHANICAL

SCALE: 1/8" = 1'-0"

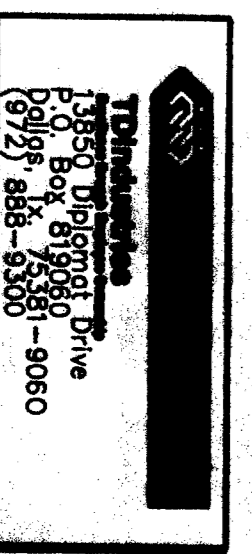

AS BUILT
10/21/02

MYERS & ASSOCIATES

This document, its ideas and designs incorporated herein are and shall remain the property of Myers & Associates. No part of this document may be reproduced or altered, in whole or in part, for other than the original intended use, nor any third party without written permission from Myers & Associates.

M & A Job no.: 01-003

Sheet Title:
SECOND FLOOR HVAC PLAN MECHANICAL

Project:
BURNET COUNTY COURTHOUSE BURNET, TEXAS

11

ELLEN TREMPER ARCHITECTS INC.
600 KENTON, STE 14705
DALLAS, TX 75208
TEL 512.691.1104 FAX 512.691.1342

Date: 06/10/2002
Drawn by: MA
Issued for: BJD

M1.4

REVISIONS	
Δ	REVISION - ASI #2 - 07/29/02
Δ	REVISION - RFP #5 - 08/09/02

Xref KAG

M
YERS &
A
SSOCIATES

This document, the ideas herein, and the work performed hereon are the property of Myers & Associates. These documents are not to be used or altered in whole or in part, for other than the original intended use, nor may they be reproduced or transmitted in any form or by any means, without written permission from Myers & Associates.

M & A Job no.: 01-003


Sheet Title:
**ROOF
PLAN
MECHANICAL**

Project:
**BURNET
COUNTY
COURTHOUSE
BURNET, TEXAS**

11
13

ELEVEN THIRTEEN ARCHITECTS INC.
407 S. ROCK BLVD. 102
GROESBECK, TEXAS 76642
TEL: 312.699.1100 FAX: 312.699.1192

Date: 06/10/2002
Drawn By: MA
Checked By: BJD
Scale: **M1.5**

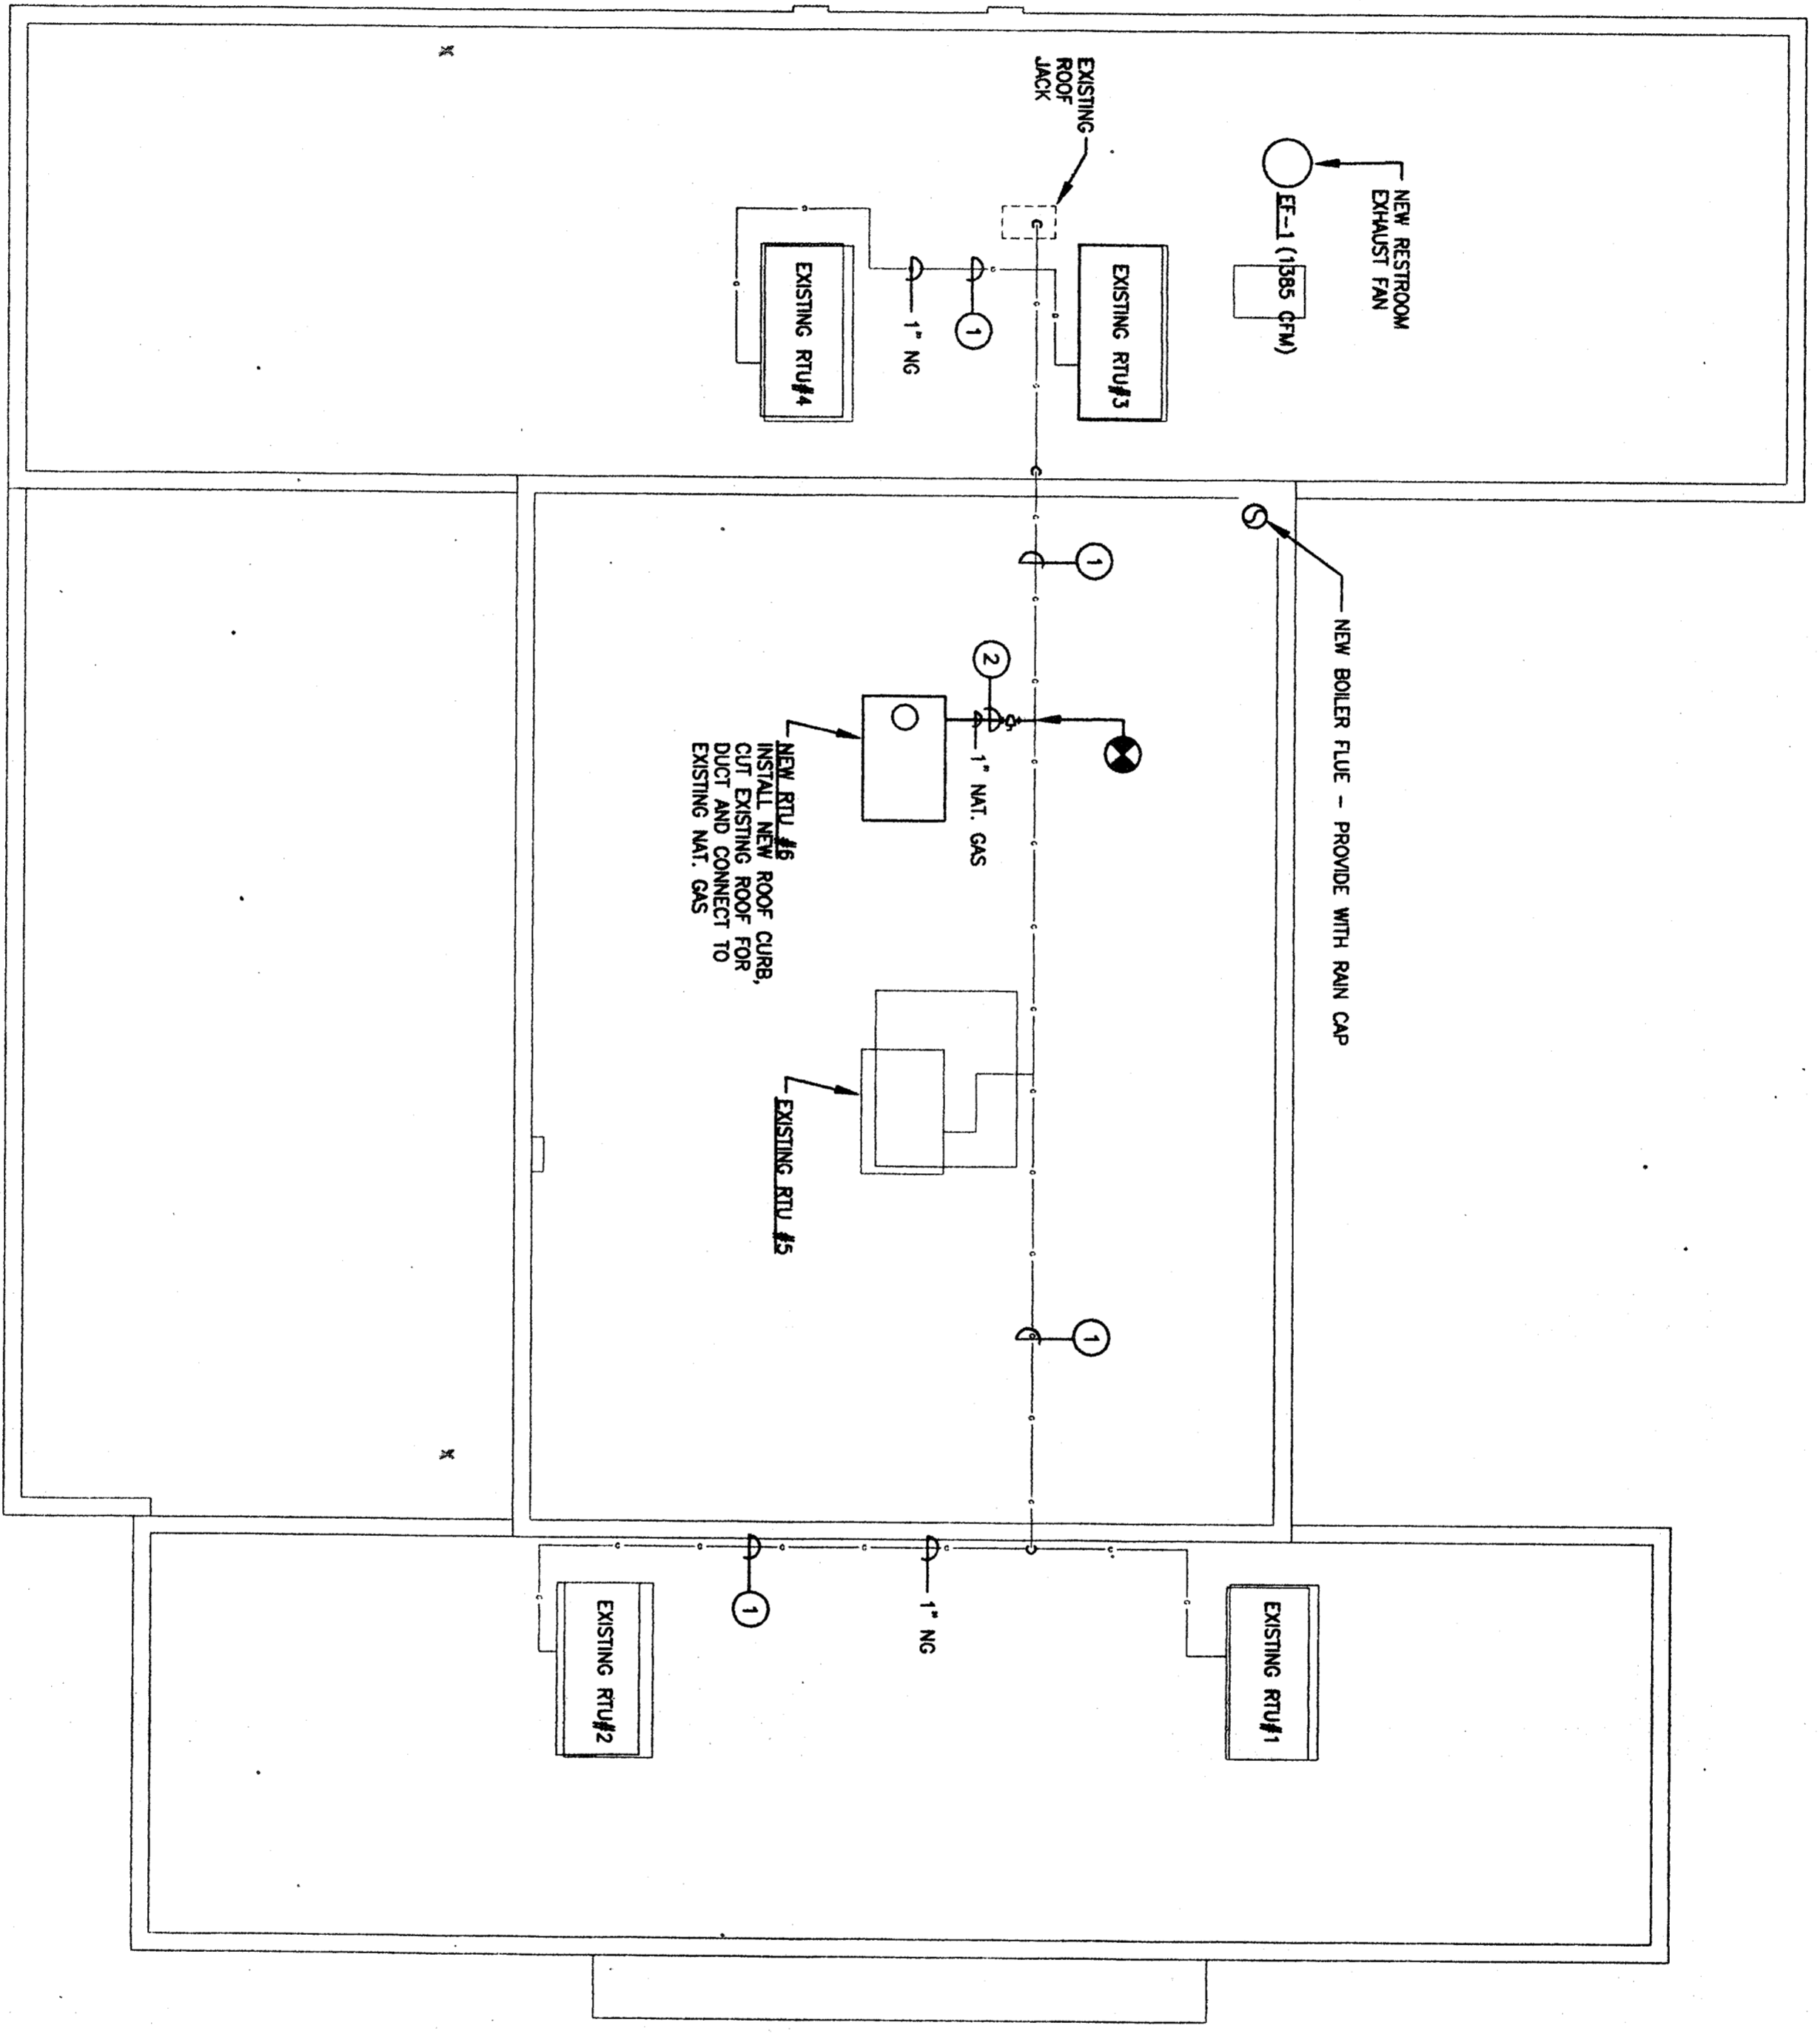

KEYED NOTES

THESE NOTES APPLY TO THIS SHEET ONLY

- ① EXISTING NATURAL GAS PIPING TO REMAIN
- ② NEW NATURAL GAS PIPING TO NEW RTU-6

01 ROOF PLAN - MECHANICAL


SCALE: 1/8" = 1'-0"

AS BUILT
10/21/02


KEYED NOTES

THESE NOTES APPLY TO THIS SHEET ONLY

- 1 EXISTING TRANSFORMERS. NEW TRANSFORMER WITH NEW PAD TO BE PLACED IN SAME LOCATION. COORDINATE WITH PERRY COBLE WITH THE CITY OF BURNET AT (512) 796-2402 FOR EXACT DETAILS.
- 2 EXISTING CITY LIGHTING PANEL AND METER TO REMAIN AND BE SUPPLIED FROM NEW "MSB".
- 3 NEW "MSB". COORDINATE FINAL LOCATION WITH BILL NEW. BURNET COUNTY COMMISSIONER AT (512) 796-4723.
- 4 PROVIDE 2 SETS (4#3/0 & 1#6 GND. IN 2" CONDUIT) FROM "MSB" TO CITY LIGHTING PANEL.
- 5 UNDERGROUND ELECTRIC. COORDINATE EXACT REQUIREMENTS WITH PERRY COBLE.
- 6 TELEPHONE AND DATA SYSTEM HEAD-UPS ARE EXISTING. COORDINATE ANY ADDITIONAL REQUIREMENTS WITH CHRIS LAWRENCE WITH HUCKABEE & ASSOCIATES AT 817-577-2889.

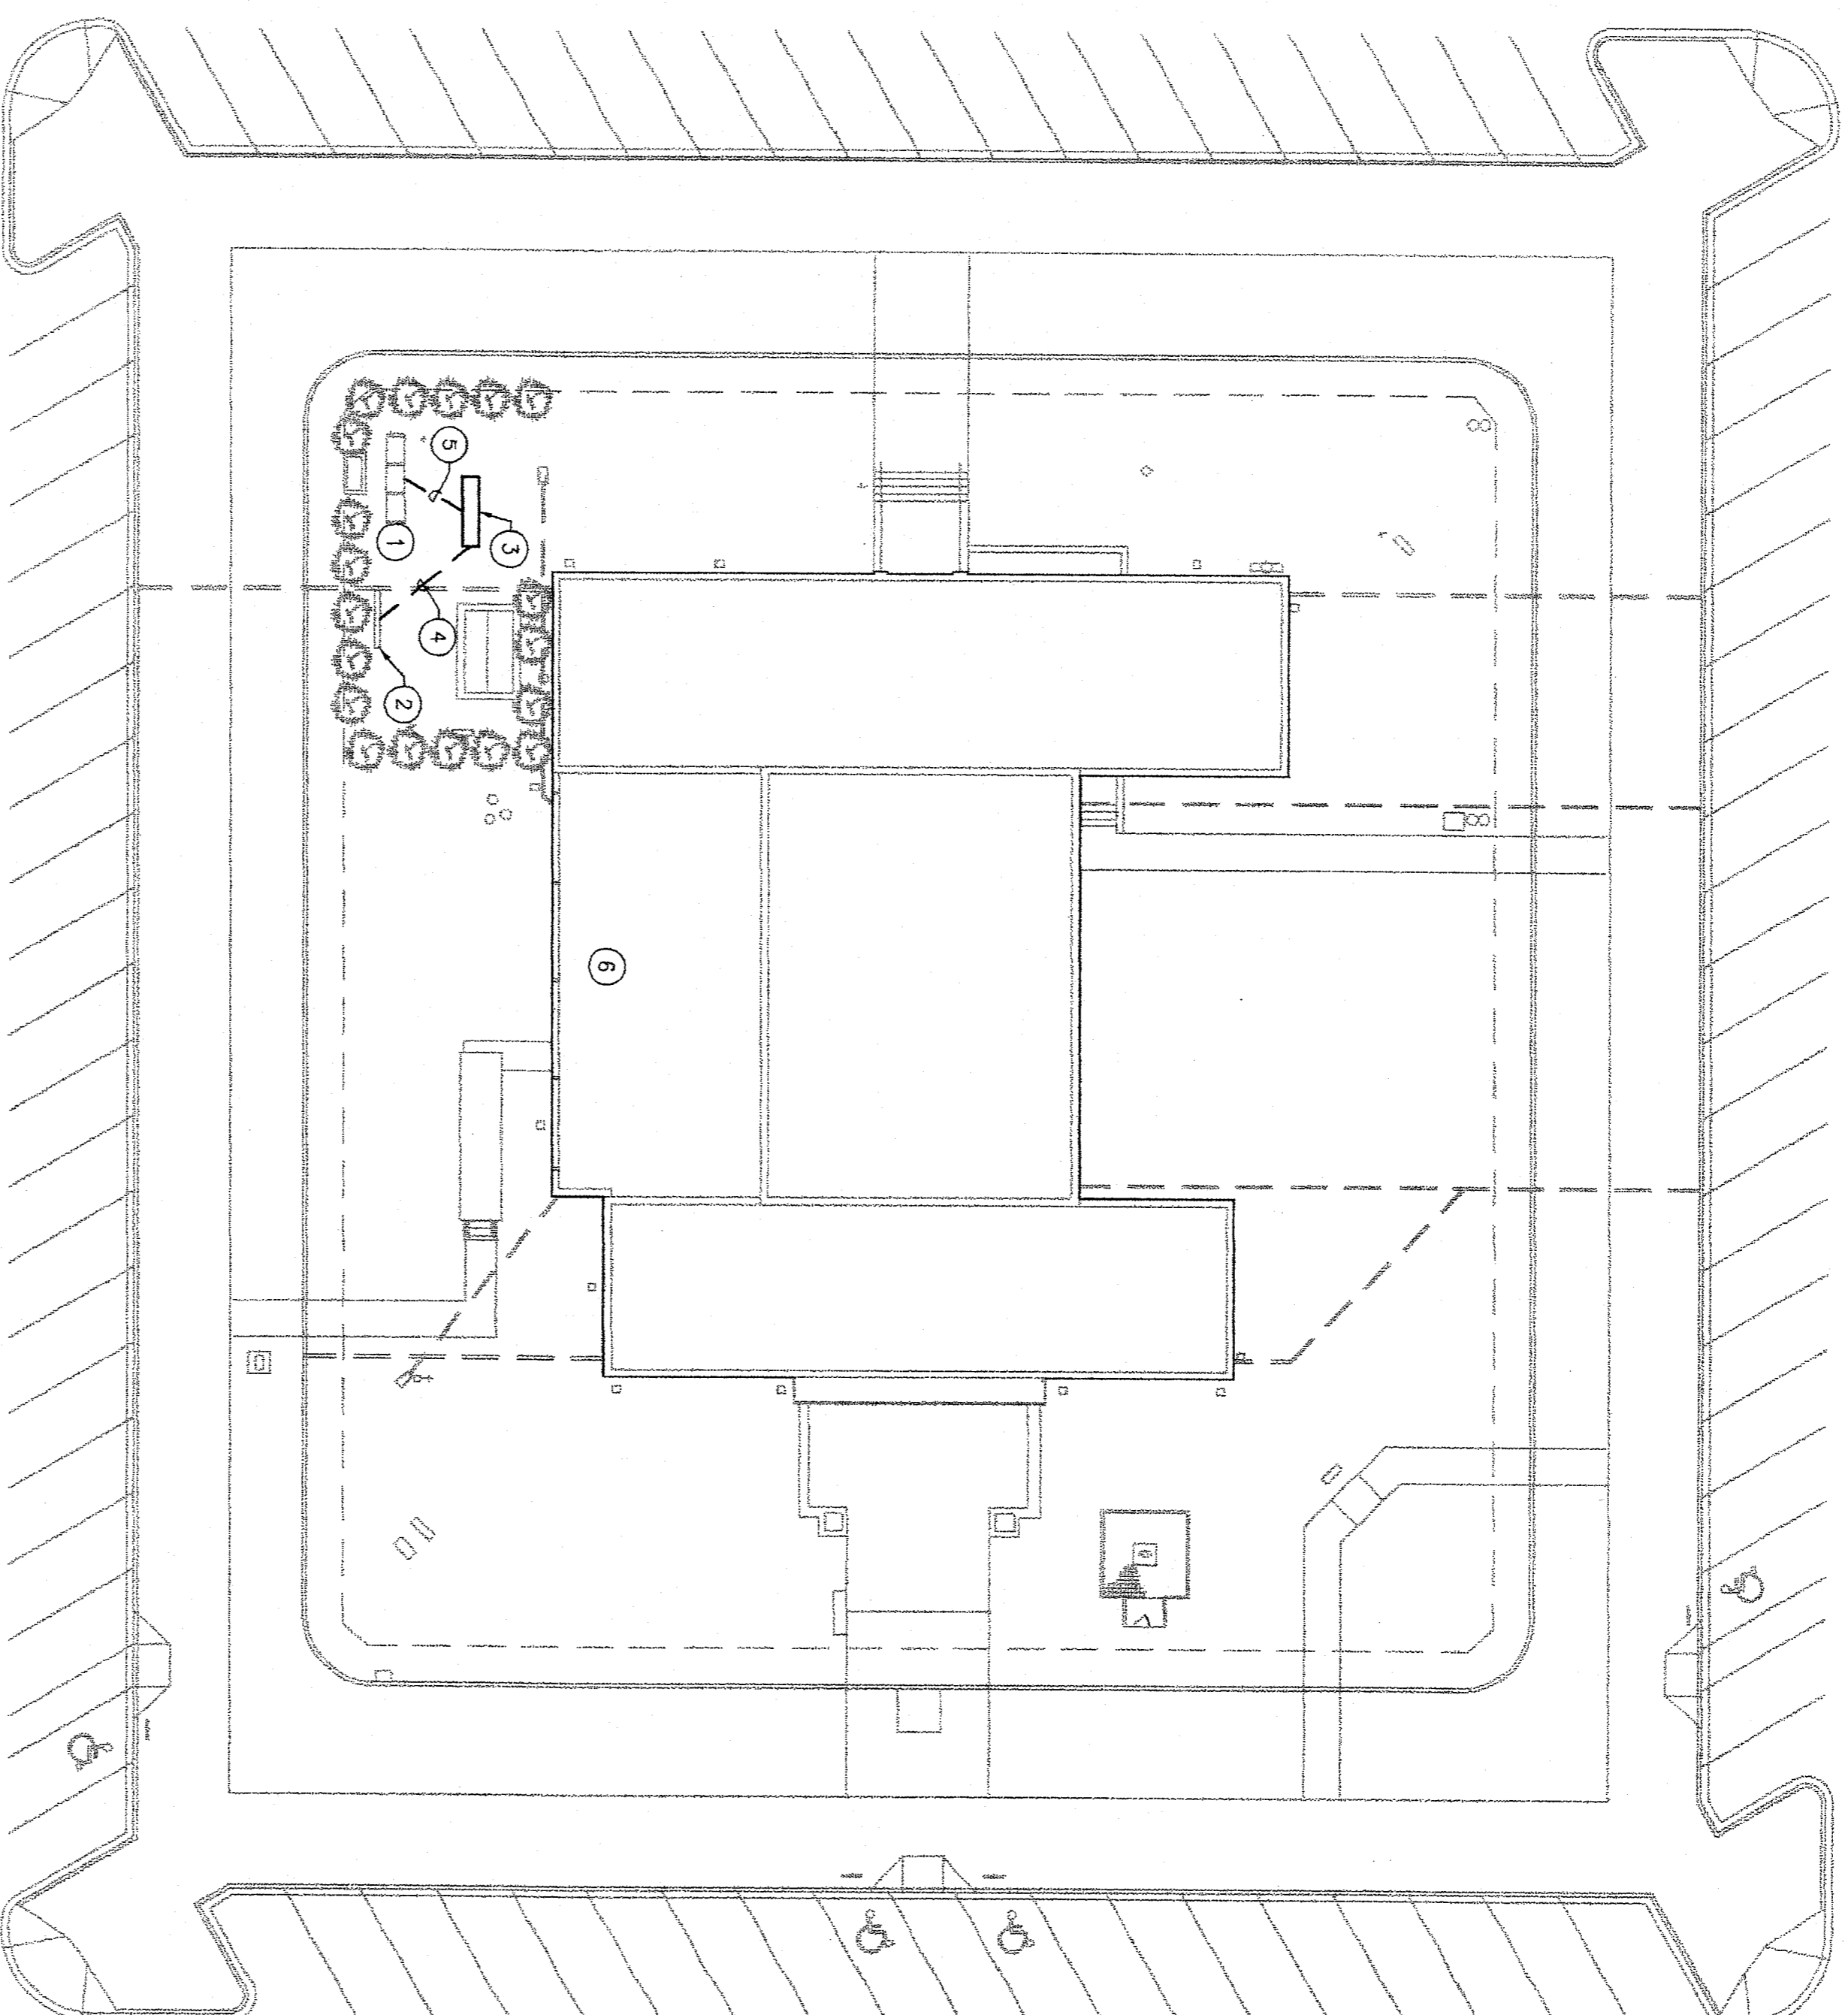


01 ELECTRICAL SITE PLAN
SCALE: 1" = 20'

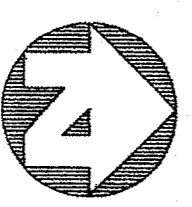

MYERS & ASSOCIATES

This document, the ideas and designs incorporated herein, are the property of Myers & Associates. These documents are not to be used, copied, or reproduced in any part, for other than the original intended use, nor are they to be assigned, loaned, or otherwise transferred without written permission from Myers & Associates.

M & A Job no. 01-003

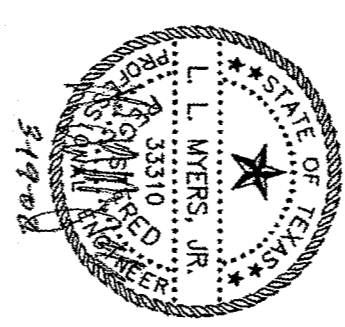

Sheet Title:
ELECTRICAL SITE PLAN

Project:
BURNET COUNTY COURTHOUSE

11
15

HELVEN THIRTEEN ARCHITECTS INC.
807 S. ROCK SOUTH 102
GEORGETOWN, TEXAS 78636
TEL: 512-869-1104 FAX: 512-869-1182

Date: 03/18/2002
Prof. #
Drawn by: MA
Issued for: BHD


ES1.1

KEYED NOTES


THESE NOTES APPLY TO THIS SHEET ONLY

- 1 EXISTING GENERATOR AND ASSOCIATED FUEL LINES, ETC. TO BE REMOVED BY ENVIRONMENTAL ENGINEERS. ATS AND ASSOCIATED ELECTRICAL EQUIPMENT TO BE REMOVED BY ELECTRICAL ENGINEER. COORDINATE WITH ENVIRONMENTAL ENGINEER FOR REMOVAL OF ALL EQUIPMENT IN GENERATOR ROOM.
- 2 LIGHT FIXTURE AND SWITCHES SHOWN ARE TO BE REPLACED WITH NEW FLUORESCENT FIXTURES AND NEW SWITCH, TYPICAL FOR ALL BASEMENT AREAS.
- 3 EXISTING SLUMP PUMP TO REMAIN, REFER TO SHEET E1.4 FOR DETAILS.
- 4 EXISTING TELEPHONE EQUIPMENT ROOM, COORDINATE REMOVAL REQUIREMENTS WITH CHRIS LAWRENCE WITH MICROBEE AT 817-377-2989. EXISTING ELECTRICAL PANEL TO BE RELOCATED. REFER TO SHEET E1.4 FOR DETAILS.
- 5 EXISTING ELECTRICAL ROOM, REMOVE ALL ELECTRICAL AND TELECOMMUNICATIONS EQUIPMENT.
- 6 EXISTING WAREHOUSE TO BE REMOVED, NEW ELECTRICAL EQUIPMENT TO BE PLACED IN THIS ROOM. REFER TO SHEET E1.4 FOR DETAILS.
- 7 EXISTING BOILER ROOM, REMOVE ALL ELECTRICAL EQUIPMENT. REFER TO SHEET E1.4 FOR NEW WORK.
- 8 EXISTING LIGHT FIXTURES TO REMAIN, REMOVE ALL WIRING AND SWITCHES, CONCEALED CONDUIT TO REMAIN AND BE USED FOR NEW WIRING.

ALL EXISTING ELECTRICAL EQUIPMENT TO BE REMOVED EXCEPT EXISTING LIGHT FIXTURES WHICH ARE TO BE RETROFITTED AND INCANDESCENT LIGHT FIXTURES TO BE REMOVED. ALL WIRING DEVICES, WIRING AND SURFACE MOUNTED CONDUIT AND OTHER EQUIPMENT TO BE REMOVED. THE ONLY EQUIPMENT TO REMAIN SHALL BE CONCEALED CONDUIT AND J-BOXES. COORDINATE WITH OWNER FOR TELECOMMUNICATIONS EQUIPMENT. NOT ALL EQUIPMENT IS SHOWN. VERIFY EXACT FIELD CONDITIONS PRIOR TO ANY WORK.

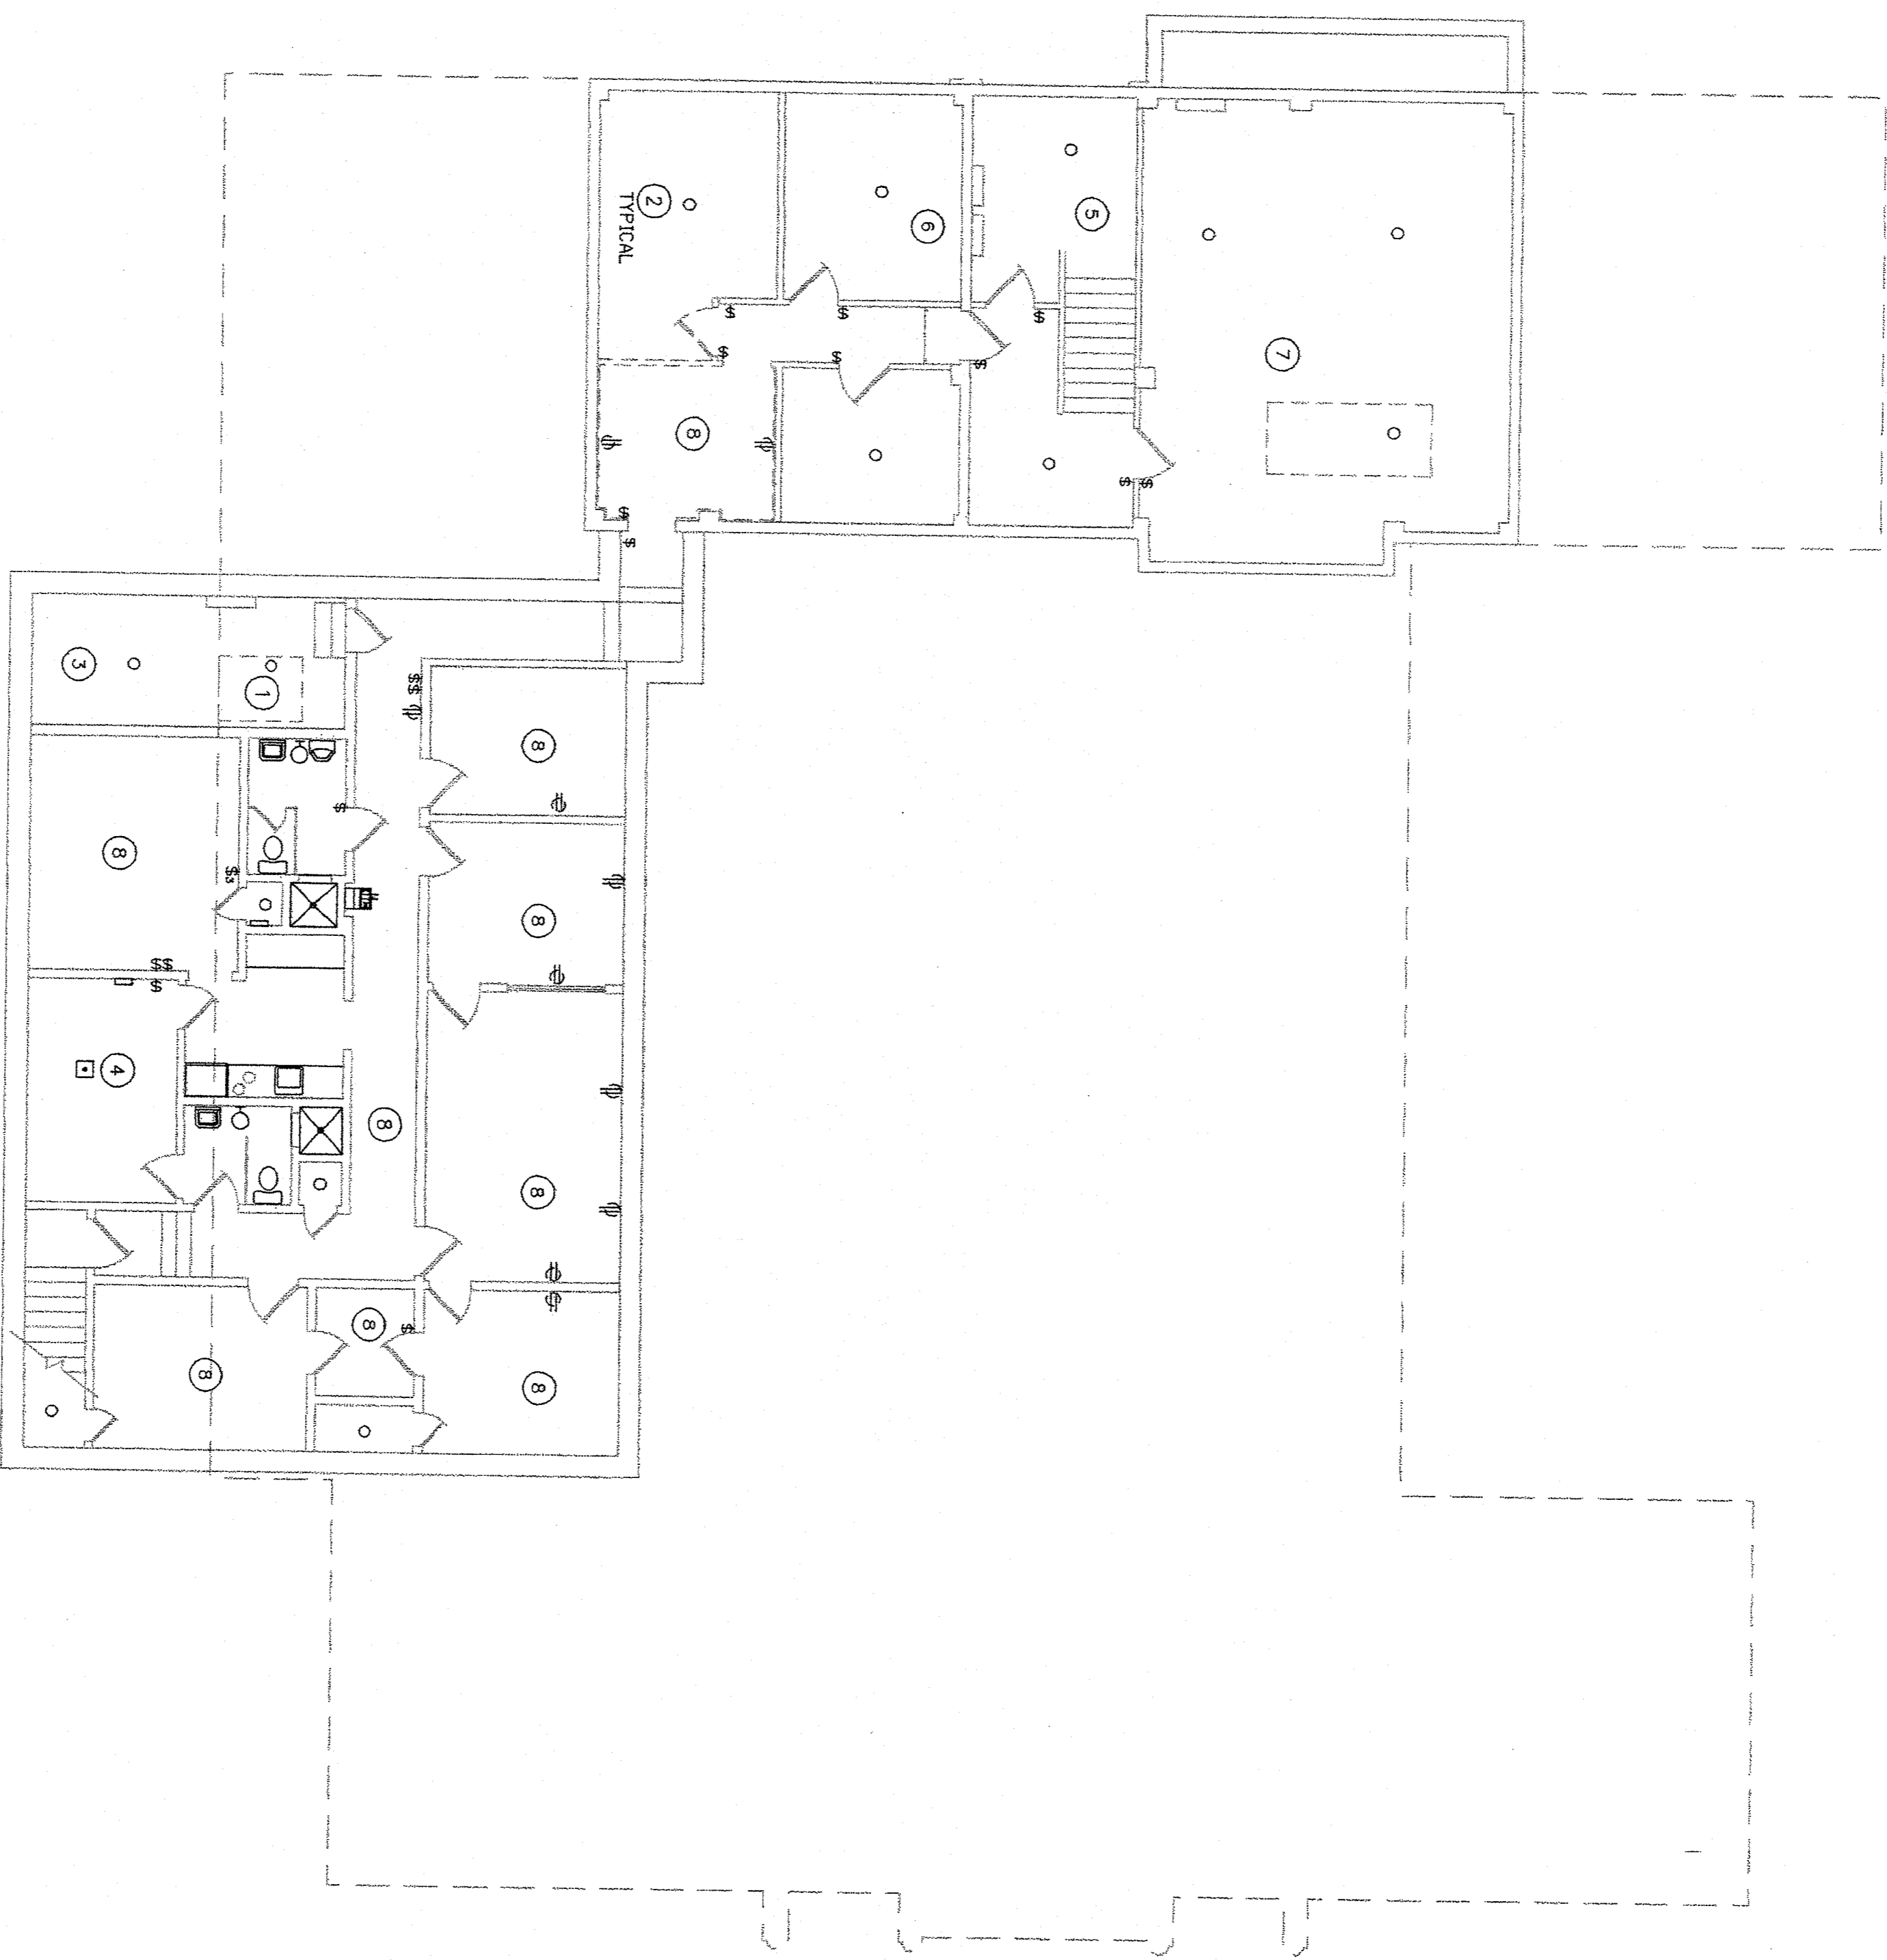

01 BASEMENT DEMOLITION PLAN - ELECTRICAL
SCALE: 1/8" = 1'-0"

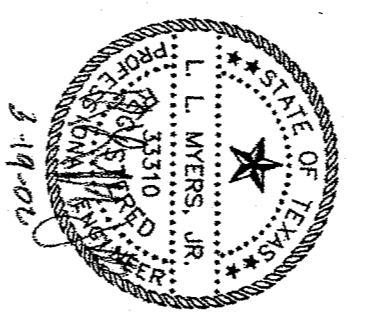

MYERS & ASSOCIATES
This document, the ideas and designs incorporated herein, are the property of Myers & Associates. These documents are not to be used, reproduced, or otherwise transmitted in any form or by any means, without the original intended use, nor are they to be assigned to any third party, without the written consent of Myers & Associates.
M & A 394 no. 01-003

Sheet Title:
BASEMENT DEMOLITION ELECTRICAL
Project:
BURNETT COUNTY COURTHOUSE

11
13

ELVERN THRENTERS ARCHITECTS INC.
87 S. ROCK SUIITE 02
GEORGETOWN, TEXAS 78626
TEL: 512.869.1194 FAX: 512.869.1342
Date: 03/18/2002
Page #: 1
Drawn by: MA
Issued for: BHD



ED1.1

KEYED NOTES

THESE NOTES APPLY TO THIS SHEET ONLY


- ① WALL MOUNTED DOORBELL. VERIFY WITH OWNER EXACT REQUIREMENTS. IF BELL IS NOT TO BE USED IN FUTURE REMOVE BELL AND ALL ASSOCIATED WIRING.
- ② EXISTING PANELBOARDS TO BE REMOVED.
- ③ EXISTING LIGHT FIXTURE TO REMAIN. REFER TO SHEET E1.2 FOR DETAILS.
- ④ EXISTING FLOOR BOX TO REMAIN. REFER TO SHEET E1.2 FOR DETAILS.
- ⑤ EXISTING POWER POLE TO BE REMOVED.
- ⑥ EXISTING WIRELOID TO BE REMOVED.
- ⑦ EXISTING LAN EQUIPMENT TO BE REMOVED.

ALL EXISTING ELECTRICAL EQUIPMENT TO BE REMOVED. THIS INCLUDES ALL WIRING, PIPING, CONDUIT, AND SURFACE MOUNTED CONDUIT LOAD CENTERS AND PANELBOARDS. THE ONLY EQUIPMENT TO REMAIN SHALL BE CONCEALED CONDUIT AND J-BOXES. COORDINATE WITH OWNER FOR REMOVAL OF TELECOMMUNICATIONS EQUIPMENT TO REMAIN. ALL FIELD CONDITIONS PRIOR TO ANY WORK. ALL CEILING FANS ARE TO BE REMOVED, STORED AND REINSTALLED IN NEW LOCATIONS AS SHOWN ON NEW WORK PLANS.

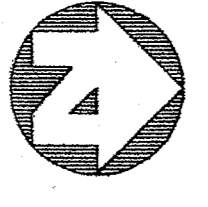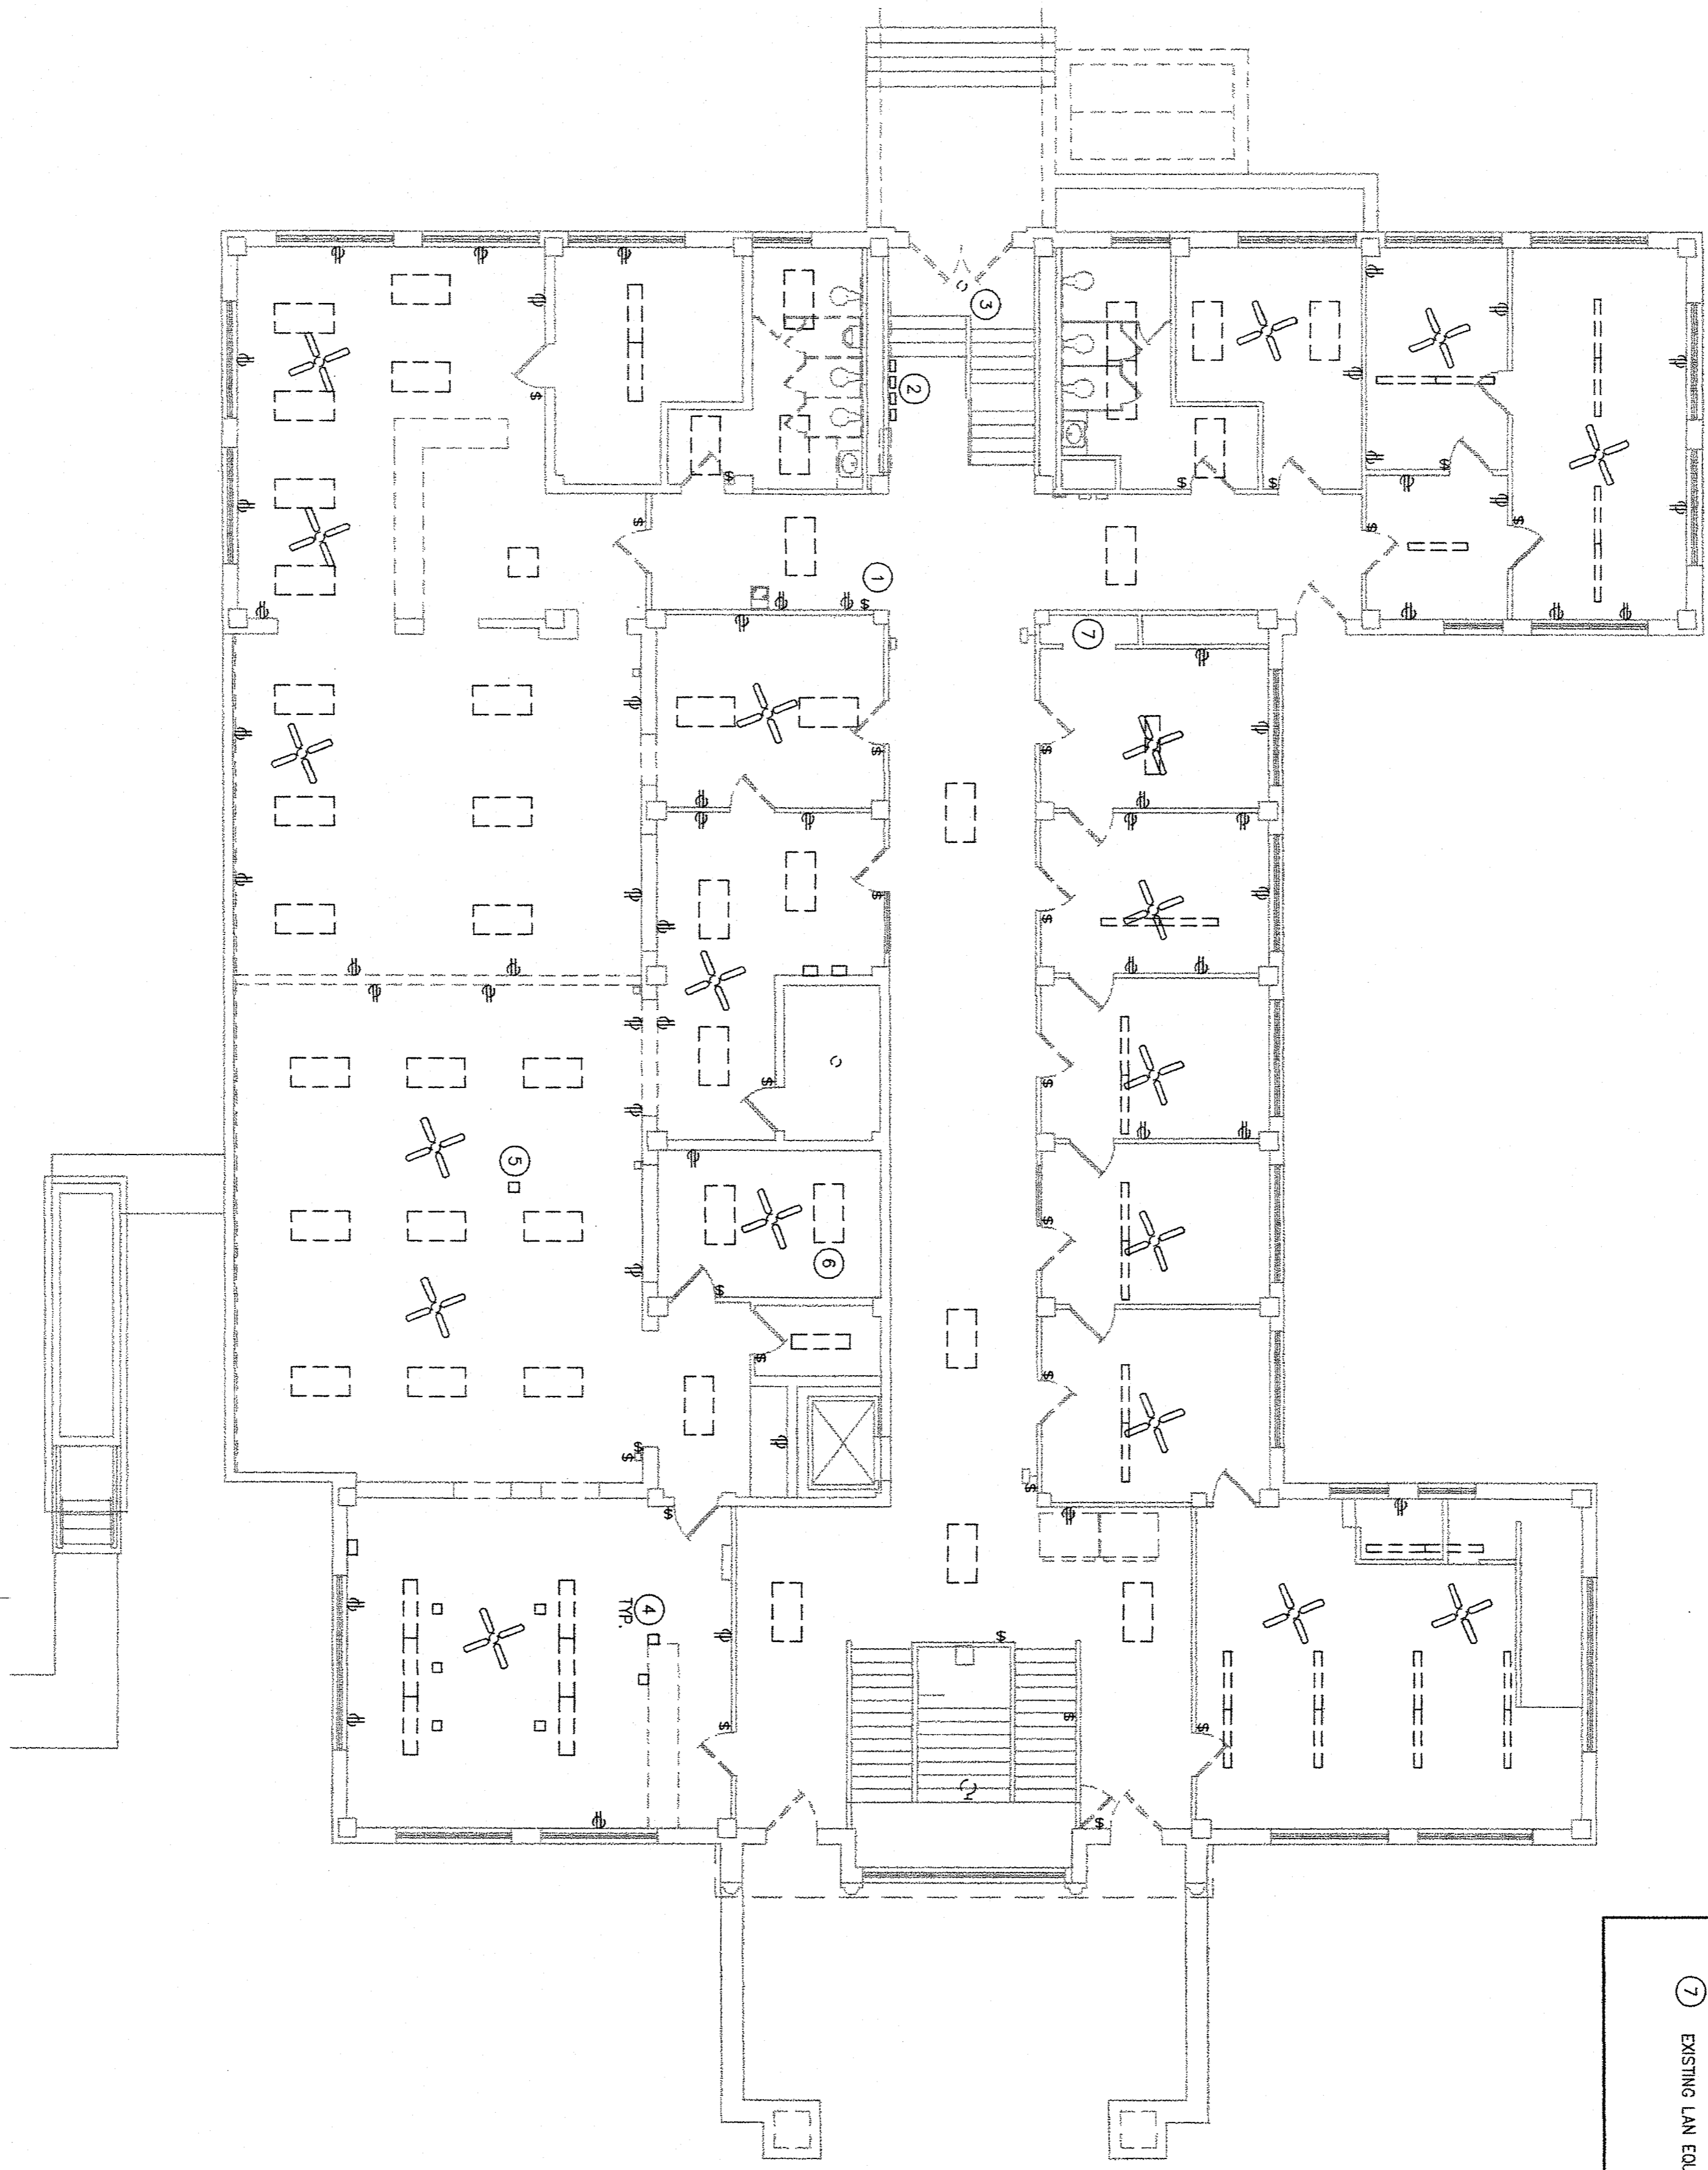

01 FIRST FLOOR DEMOLITION PLAN - ELECTRICAL

SCALE: 1/8" = 1'-0"

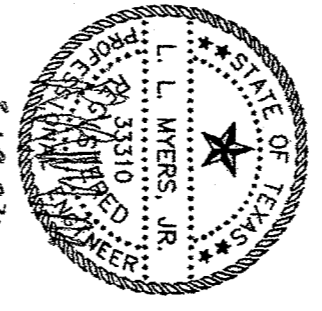

MYERS & ASSOCIATES

This document, the ideas and designs incorporated herein, are and shall remain the property of Myers & Associates. No part of this document is to be used or altered, in whole or in part, for other than the project for which it was prepared, without the written permission from Myers & Associates.

Sheet Title:
FIRST FLOOR DEMOLITION ELECTRICAL

Project:
BURNETT COUNTY COURTHOUSE

11 / 13

ELLEN J. MYERS ARCHITECTS INC.
807 S. ROCK SUIITE 102
GEORGETOWN, TEXAS 78626
TEL. 512.869.1104 FAX 512.869.1382



Date: 03/18/2002
Proj. #: **ED1.2**
Drawn by: MA
Issued for: BJD

KEYED NOTES

THESE NOTES APPLY TO THIS SHEET ONLY.

- ① LIGHT SWITCH LOCATED IN SHOWER STALL TO BE REMOVED.
- ② AIR RETURN GRILL TO REMAIN.
- ③ FIXTURES MOUNTED AT TWO CEILING HEIGHTS.
- ④ EXISTING PANEL BOARD TO BE REMOVED.
- ⑤ EXISTING ALARM AND MICROPHONE SYSTEM, COORDINATE WITH COUNTY ABOUT PLACEMENT, EQUIPMENT SPECIFICATIONS AND REQUIREMENTS. CONCEAL ALL WIRING ABOVE CEILING.

ALL EXISTING ELECTRICAL EQUIPMENT TO BE REMOVED. THIS TO INCLUDE ALL LIGHT FIXTURES, ALL WIRING DEVICES, ALL WIRING, SURFACE MOUNTED CONDUIT AND PANELBOARDS. THE ONLY EQUIPMENT TO REMAIN SHALL BE CONCEALED CONDUIT TO BE REMOVED WITH THE OWNER FOR TELECOMMUNICATIONS EQUIPMENT. ALL EQUIPMENT IS TO BE REMOVED, NOT ALL EQUIPMENT IS SHOWN. VERIFY EXACT FIELD CONDITIONS PRIOR TO ANY WORK. ALL WIRING IS TO BE REMOVED, STORED AND REINSTALLED IN NEW LOCATIONS AS SHOWN ON NEW WORK PLANS.

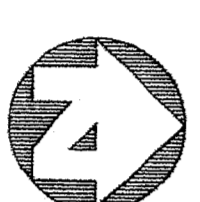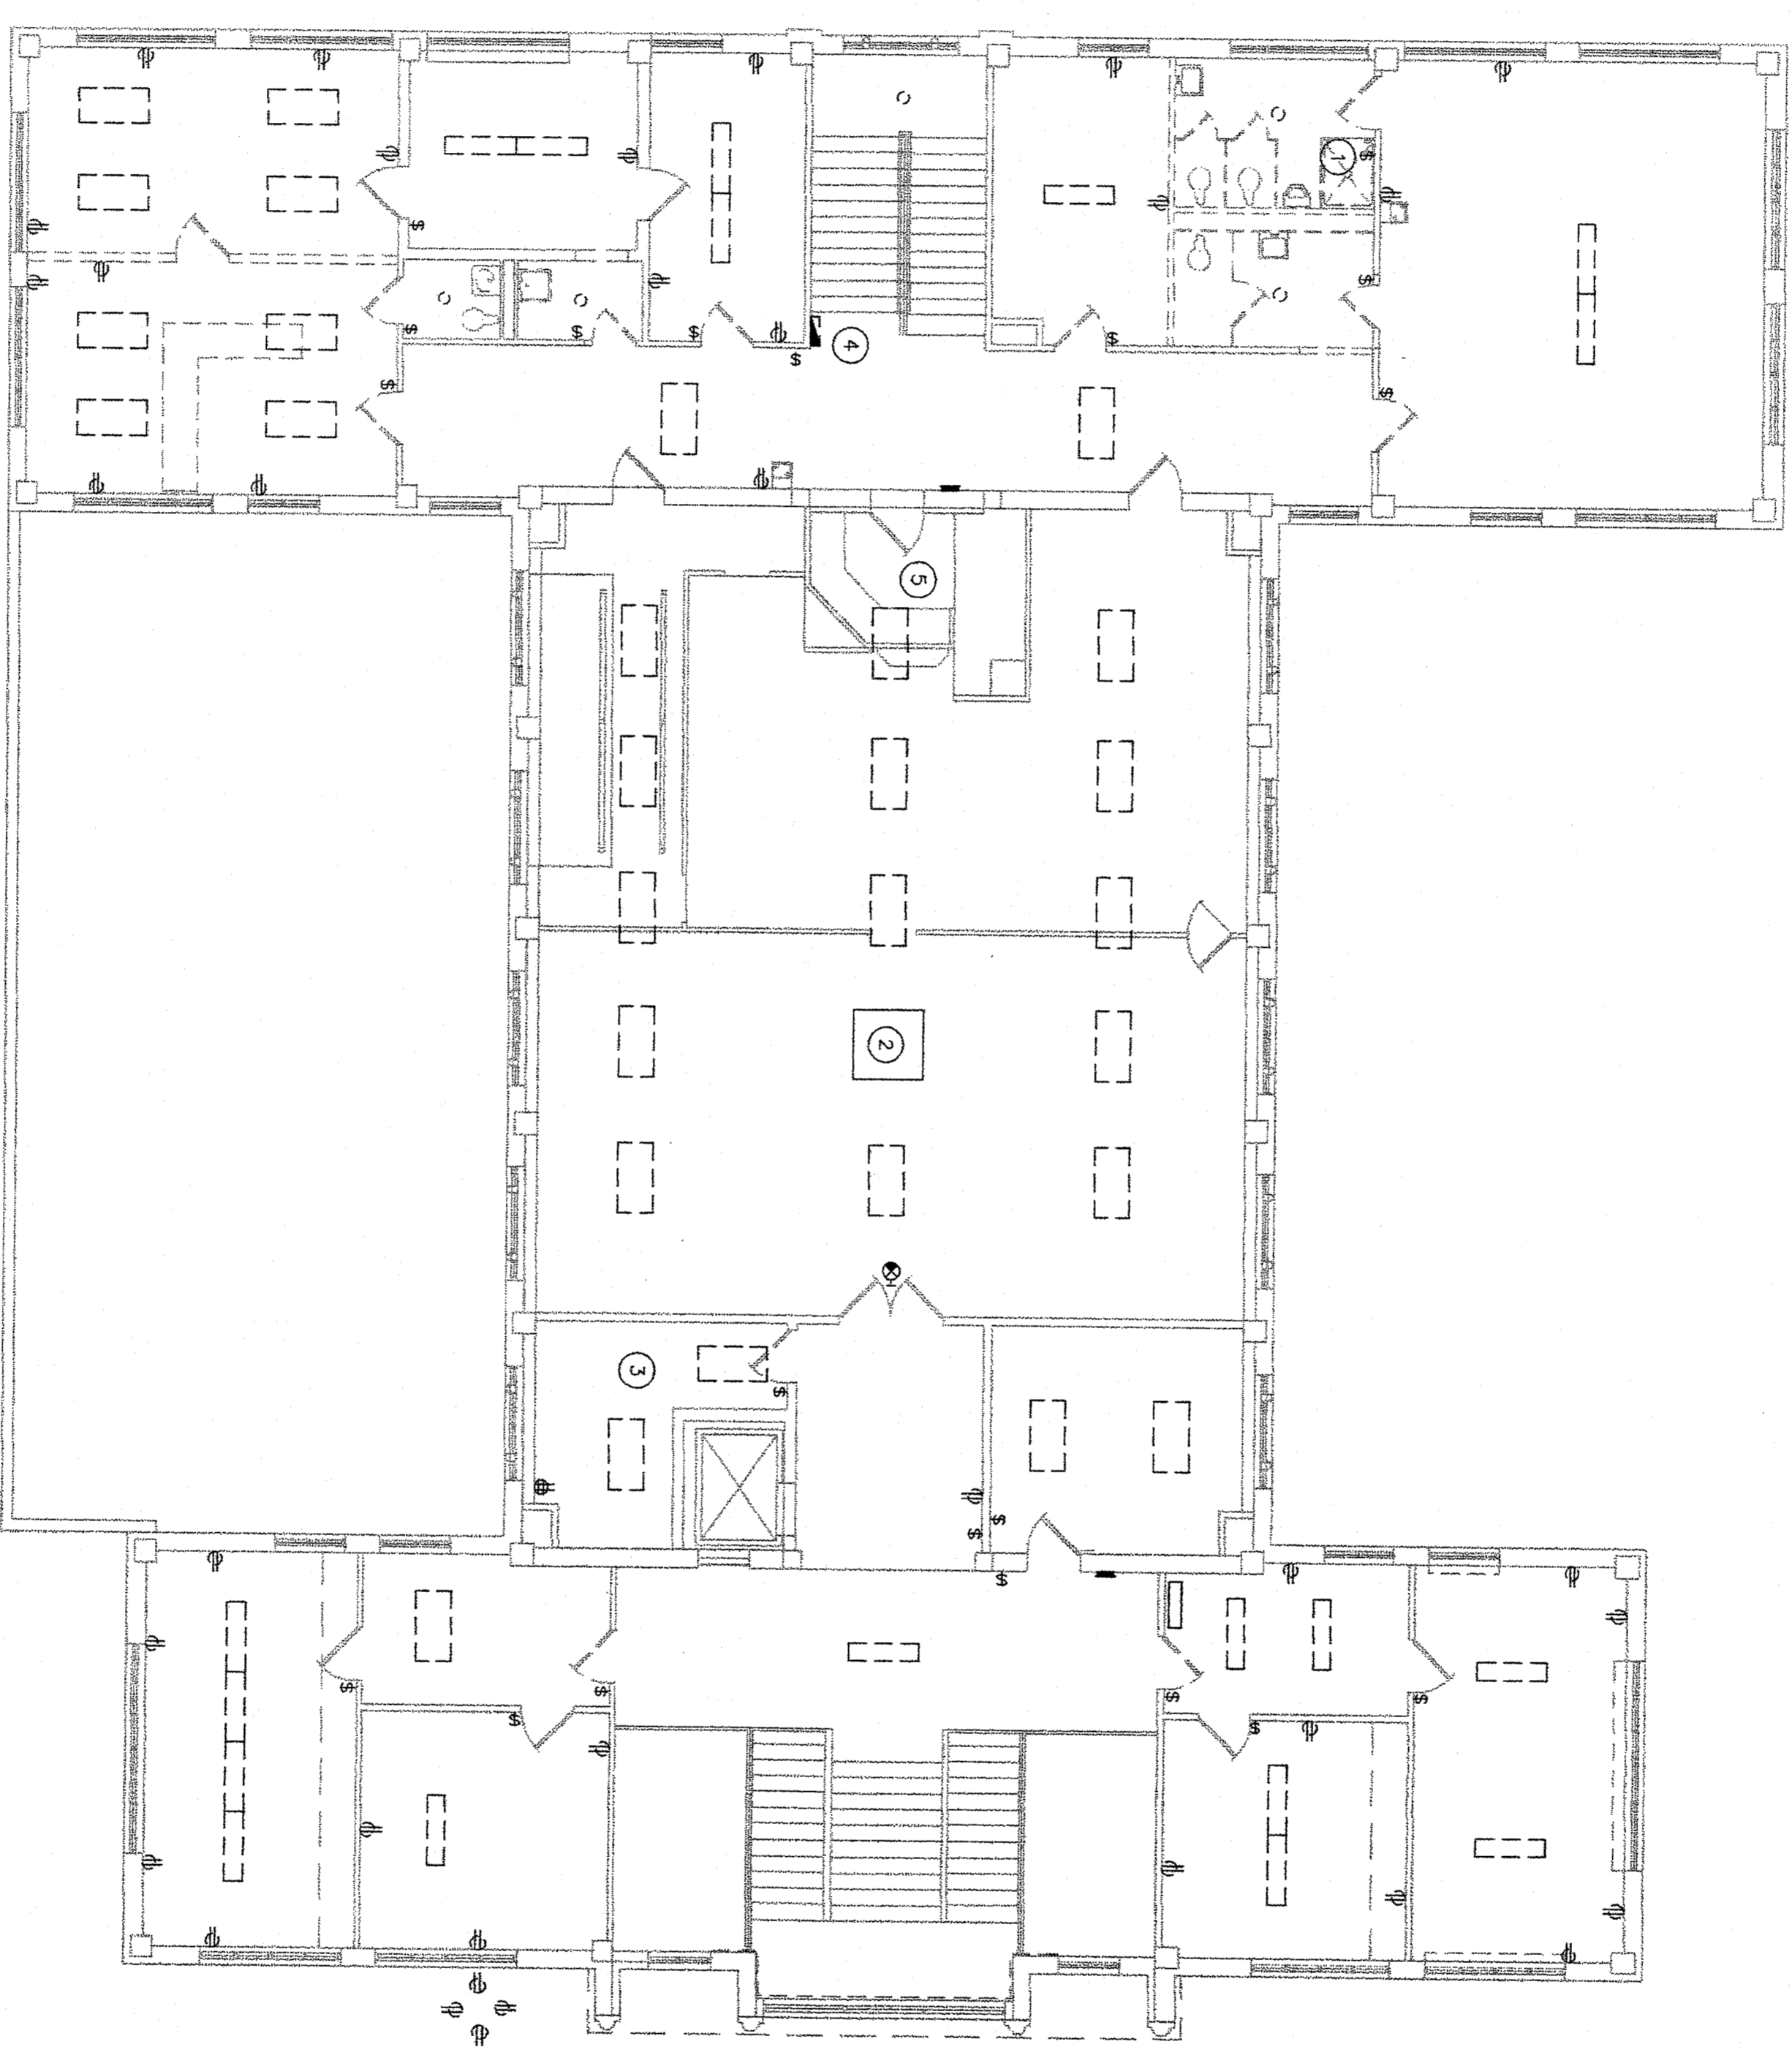


01 SECOND FLOOR DEMOLITION PLAN - ELECTRICAL

SCALE: 1/8" = 1'-0"

**M
YERS
&
A
S
S
O
C
I
A
T
E
S**

This document, the ideas herein, and the information contained hereon are the property of Myers & Associates. These documents are not to be used or otherwise not to be used in part, for other than the original intended use, nor any part of it, without the written permission from Myers & Associates.

M & A job no.: 01-003

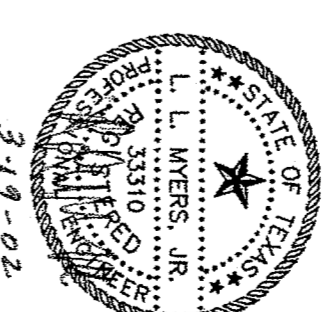

Sheet Title:
**SECOND FLOOR
DEMOLITION
ELECTRICAL**

Project:
**BURNETT
COUNTY
COURTHOUSE**

**11
/13**

ELVEN THIRTEEN ARCHITECTS INC.
807 S. ROCK SUITE 102
GEOURGETOWN, TEXAS 78626
TEL 512.869.104 FAX 512.869.1962

Date: 03/18/2002
Proj #
Drawn by: MA
Issued for: BID

ED1.3


KEYED NOTES

THESE NOTES APPLY TO THIS SHEET ONLY

- ① IN NEW BOILER ROOM REPLACE EXISTING KEYSLESS FIXTURE AND ADD (1) ONE ADDITIONAL FIXTURE. RELOCATE AS REQUIRED TO ACCOMMODATE BOILER AND ANY OTHER EQUIPMENT IN ROOM. CIRCUIT AS SHOWN. PROVIDE NEW SWITCH AND COVER PLATE.
- ② FOR ALL EXISTING FLUORESCENT FIXTURES RETROFIT WITH T8 ELECTRONIC BALLAST AND RELOCATE TO NEW ELECTRICAL PANEL. PROVIDE NEW BASEMENT LIGHT FIXTURES ROOMS 007 THROUGH 017A. RELOCATED TO NEW PANEL 11A. NEW SWITCHES AND COVERPLATES AS REQUIRED.
- ③ PROVIDE EMERGENCY BATTERY BACK-UP IN (3) THREE RETROFITTED FIXTURES IN ROOMS 007 THROUGH 017A. PROVIDE NEW SWITCHES AND COVERPLATES WITH OWNER EXACT SWITCHING REQUIREMENTS FOR CORRIDOR.
- ④ REPLACE EXISTING INCANDESCENT FIXTURE AND PROVIDE NEW SWITCH. CIRCUIT AS SHOWN ON PLANS.
- ⑤ REPLACE EXISTING INCANDESCENT FIXTURE AND PROVIDE ADDITIONAL FIXTURE. PROVIDE NEW SWITCH AND CIRCUIT AS SHOWN ON PLANS.
- ⑥ CONNECT EXIT TO SAME CIRCUIT AS CORRIDOR LIGHTING. EXITS ARE TO BE UNSWITCHED.

ALL LIGHT FIXTURES IN BASEMENT ARE TO BE REPLACED OR RETROFITTED. ALL WIRING TO BE NEW. ALL CONDUIT TO BE CONCEALED AND NEW SWITCHES TO BE REPLACED WITH NEW AND SINGLE POLE SWITCHES AS REQUIRED. VERIFY EXISTING FIELD CONDITIONS PRIOR TO PURCHASE OF FIXTURES.

- 1 Changed to Type A Fixture
- 2 Changed to type AE fixture
- 3 Changed to type A fixture
- 4 Exit light moved to Corr. 016 (see 4A)
- 5 Type G fixture replaced with two wall panel fixtures. Closet is split and has door on each side
- 6 Switch deleted
- 7 Switch relocated to inside closet
- 8 Added one type B fixture (LA-78)
- 9 Added one light fixture in stairwell (LA2-40)

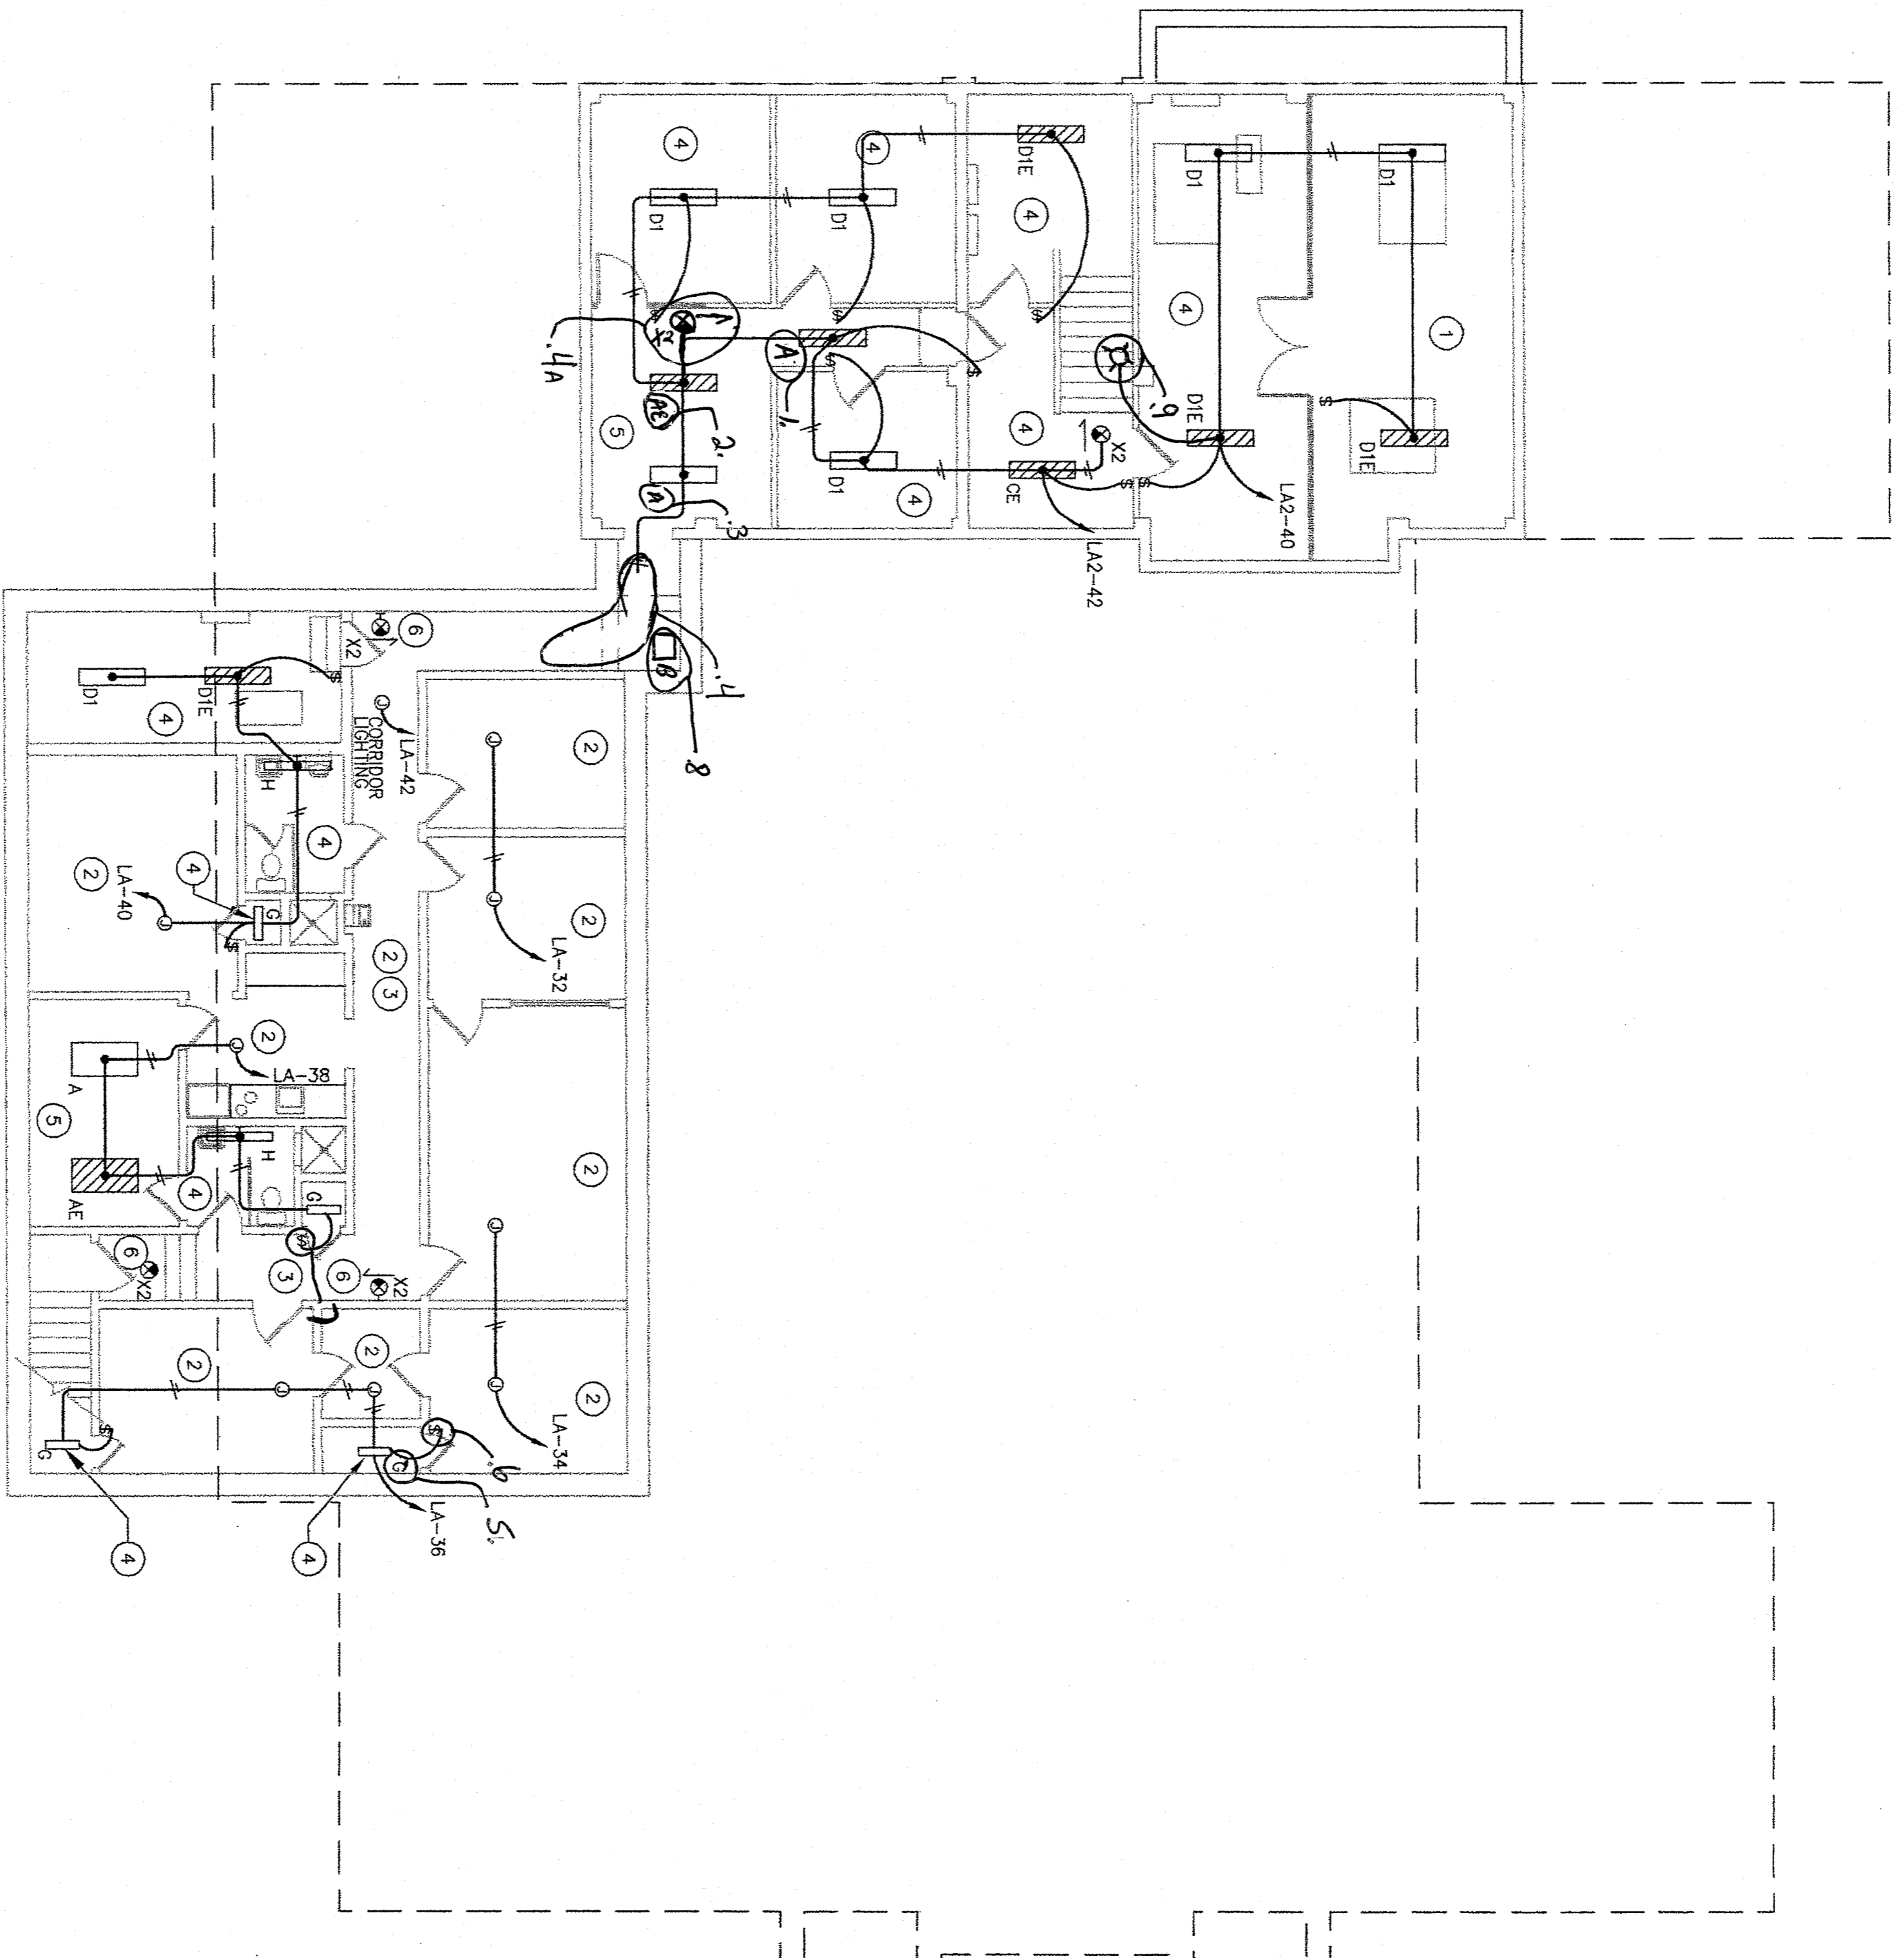


01 BASEMENT FLOOR PLAN - LIGHTING
SCALE: 1/8" = 1'-0"

MYERS & ASSOCIATES

This document, the ideas and designs incorporated herein, are the property of Myers & Associates. These documents are not to be used in whole or in part, for other than the original intended use, nor are they to be assigned, loaned, or otherwise disseminated without the written permission of Myers & Associates.

M & A, Inc. reg. no. 01-003

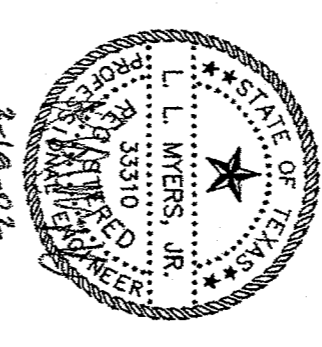

Sheet Title:
BASEMENT FLOOR PLAN LIGHTING

Project:
BURNET COUNTY COURTHOUSE



HEAVIN THIERTHEN ARCHITECTS INC.
807 S. HOOK BLVD. 102
GROCKTOWN, TEXAS 78636
TEL: 512.891.1104 FAX: 512.891.1362


Date: 03/18/2002
Proj. #: **E1.1**
Drawn by: MA
Issued for: BID

KEYED NOTES

THESE NOTES APPLY TO THIS SHEET ONLY

- 1 RELOCATED CEILING FANS. ALL CEILING FANS ARE TO BE MOUNTED ABOVE LIGHT FIXTURES. VERIFY PENDANT LENGTHS PRIOR TO ANY WORK. TYPICAL FOR ALL CEILING FANS.
- 2 NEW LIGHT STANDARDS TO REPLACE EXISTING. EACH TO HAVE TWO (2) TYPE "D" FIXTURES MOUNTED INSIDE. REFER TO ARCHITECTURAL DETAILS FOR EXACT MOUNTING REQUIREMENTS.
- 3 EXISTING FIXTURES TO BE REFURBISHED. REMOVE FIXTURES DURING CONSTRUCTION AND THOROUGHLY CLEAN FIXTURE INSIDE AND OUT. REPAIR AS NEEDED. RETROFIT FIXTURES WITH ONE (1) 40W BAY LAMP AND ELECTRONIC BALLAST EACH.
- 4 COORDINATE WITH OWNER FOR EXACT TIMECLOCK PROGRAMMING. TIMECLOCK TO BE LOCATED IN MAIN ELECTRIC ROOM IN BASEMENT.
- 5 FIXTURES LOCATED BELOW STAIR. COORDINATE WITH OWNER FOR EXACT MOUNTING LOCATIONS AND REQUIREMENTS.
- 6 EXISTING FIXTURE TO BE REFURBISHED. REMOVE FIXTURE. THOROUGHLY CLEAN AND RE-USE AS REQUIRED. RE-FIT WITH SCREW-IN TYPE COMPACT FLUORESCENT LAMP. PROVIDE NEW GLOBE TO MATCH ORIGINAL.
- 7 PENDANT MOUNT FIXTURES TO BE MOUNTED AT 12'-0" AFF. VERIFY EXACT PENDANT LENGTHS PRIOR TO ORDER. TYPICAL FOR ALL PENDANT MOUNT FIXTURES.


Not possible

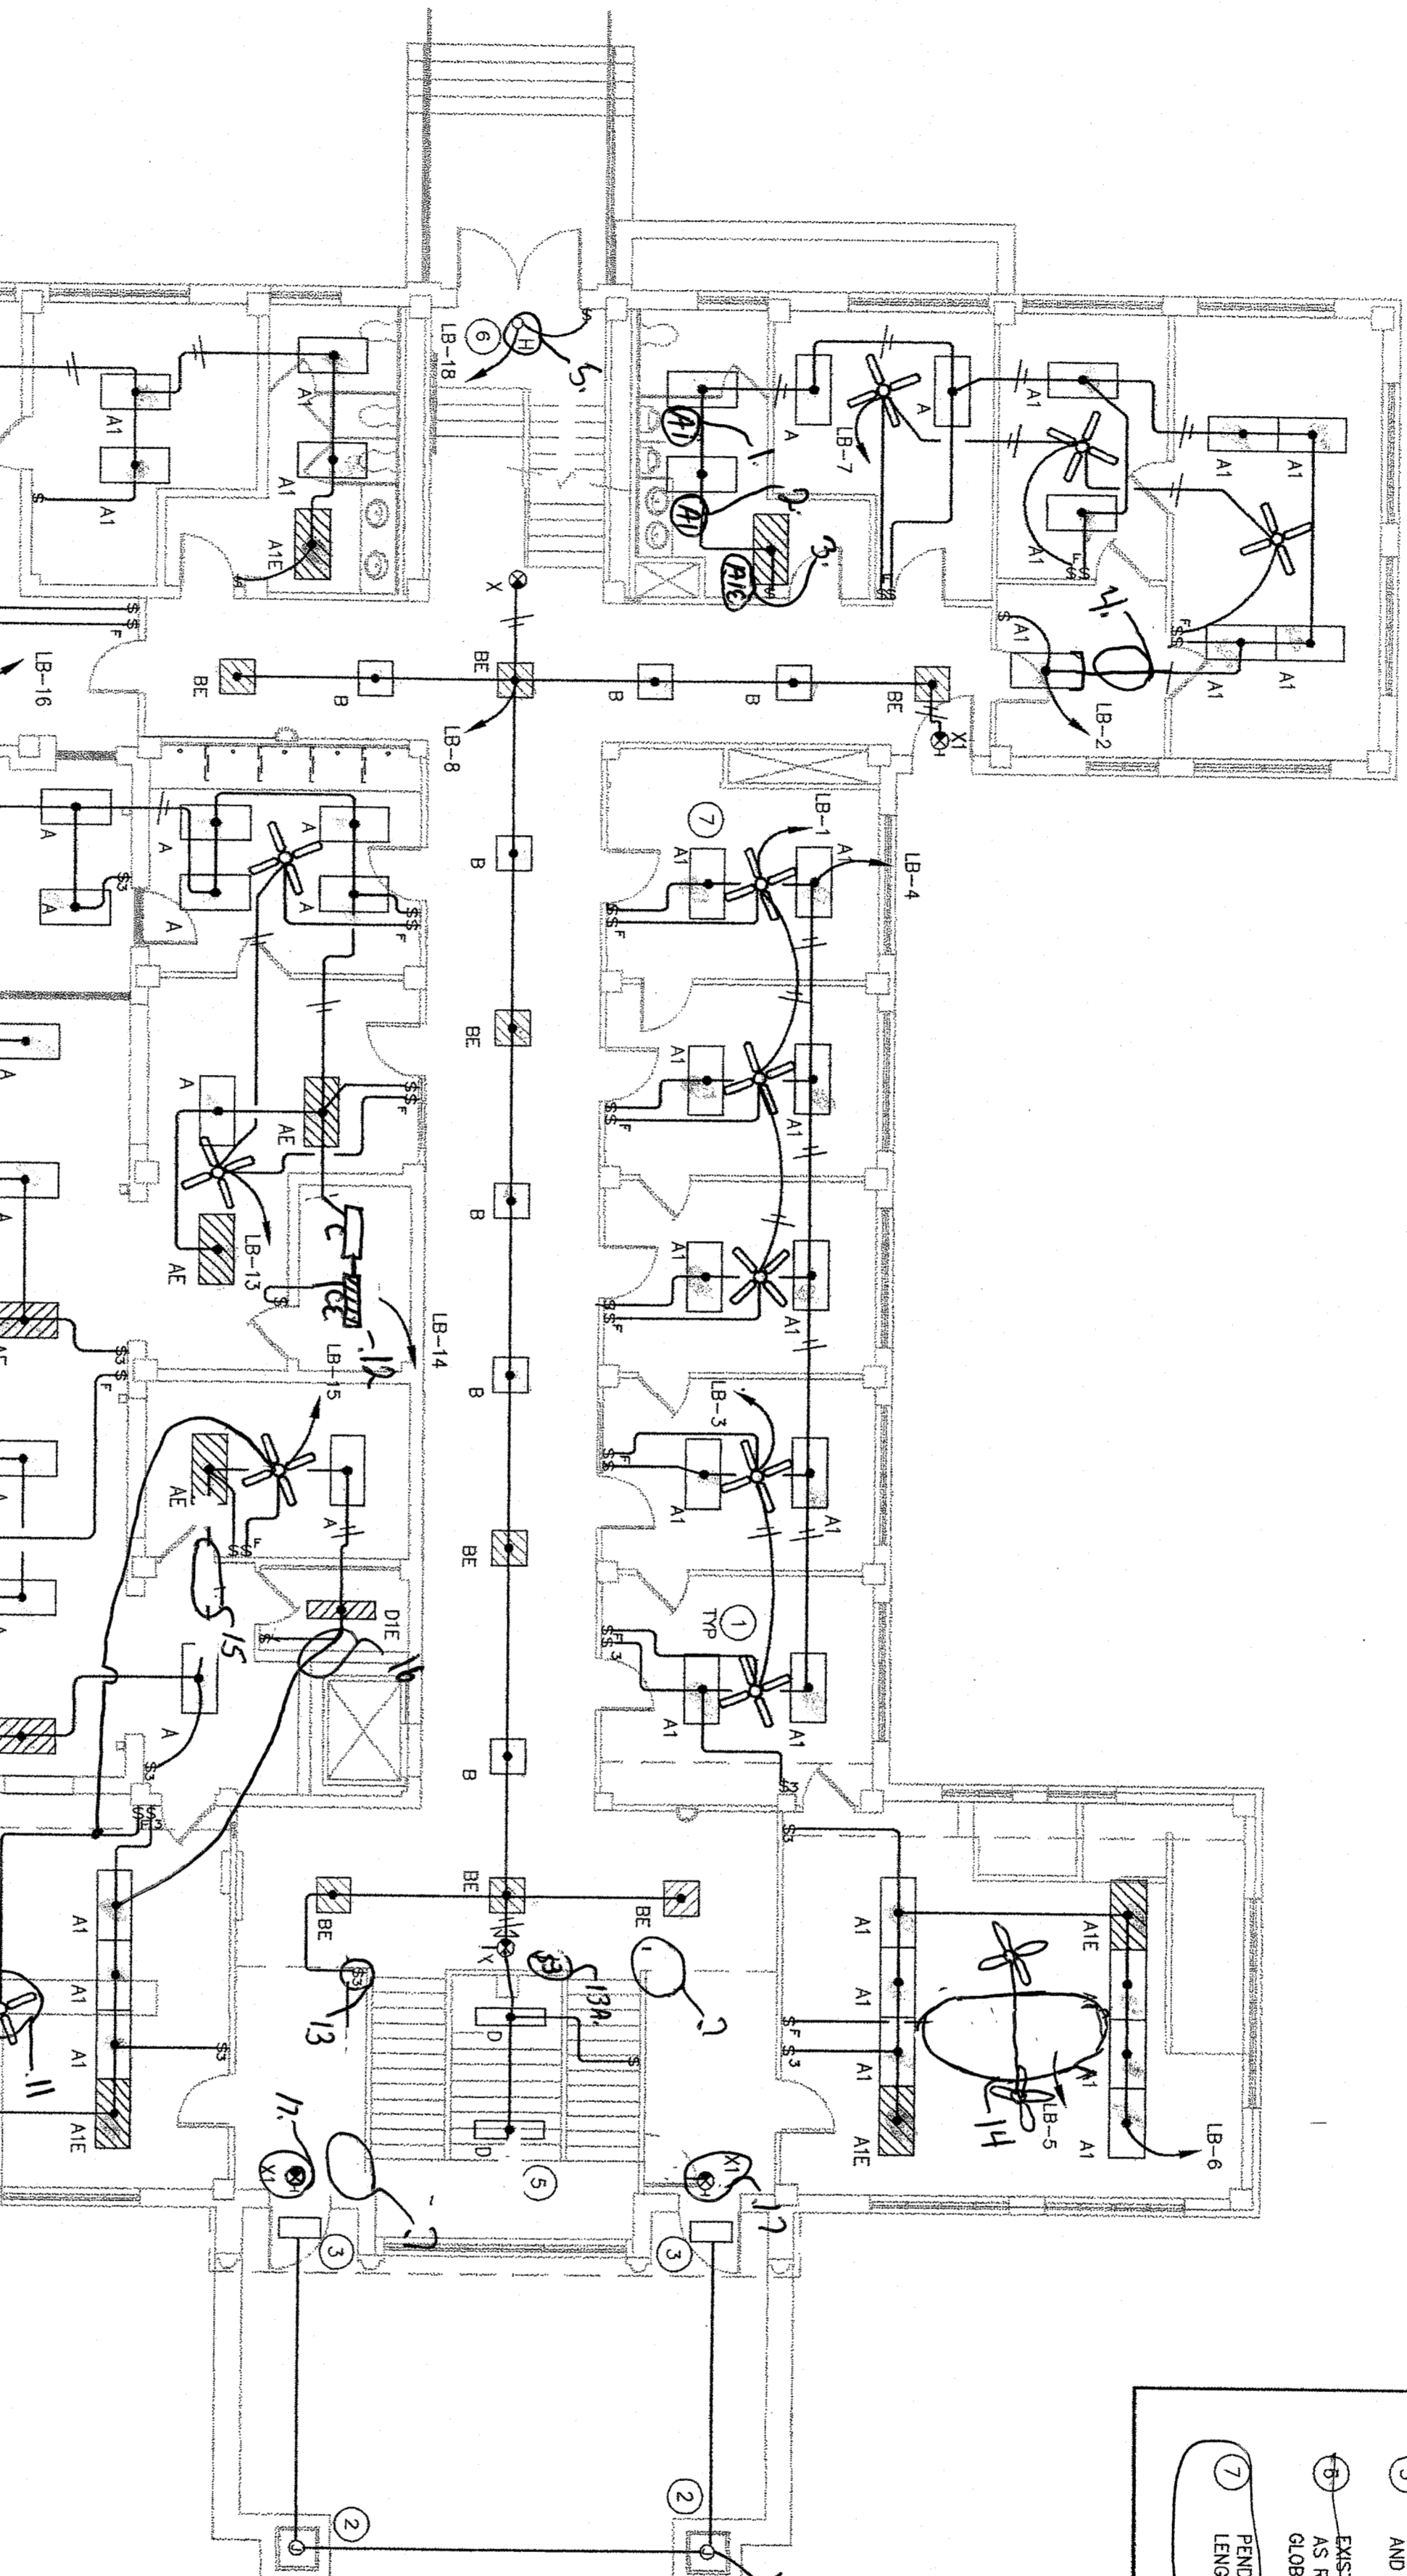

1. Changed to Type A1 Fixture.
2. Changed to Type A1 Fixture.
3. Changed to Type A1C Fixture
4. Deleted
5. Changed to 18x12" Loopback Fluorescent Fixture.
6. Changed to LB-11
7. Deleted
8. Added to LB-9
9. Changed to LB-9
10. Deleted
11. Added to LB-15
12. Deleted
13. Moved to front of stairwell see 13A.
14. Relocated to row east to west in center of room
15. Deleted
16. Added to LB-10
17. Replaced with self contained Exit Light.

01 FIRST FLOOR PLAN - LIGHTING

SCALE: 1/8" = 1'-0"

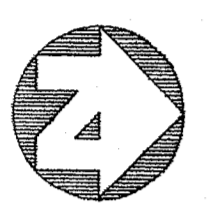

MYERS & ASSOCIATES

This document, the ideas and designs incorporated herein, are the property of Myers & Associates. These documents are not to be used, copied, or otherwise reproduced without the written permission of Myers & Associates.

M & A Job no. 01-003



Sheet Title:
FIRST FLOOR PLAN LIGHTING

Project:
BURNET COUNTY COURTHOUSE

11
13

ELDEN THOMPSON ARCHITECTS INC.
807 S. ROCK SUITE 102
GROBERTOWN, TEXAS 78626
TEL. 512.869.1104 FAX 512.869.1542


Date: 03/18/2002
Proj #
Drawn by: MA
Issued for: BID

E1.2

KEYED NOTES

THESE NOTES APPLY TO THIS SHEET ONLY

- ① GENERAL EXACT SWITCH LOCATION WITH OWNER FRONT TO ANY WORK.
- ② PENDANT FIXTURES TO BE MOUNTED AT 17'-0" A.F.F. VERIFY PENDANT LENGTHS PRIOR TO ORDER.
- ③ COORDINATE LIGHT FIXTURE INSTALLATION IN THIS LOCATION WITH FLASHER SOUTH LOCATION AND CEILING GRID.
- ④ EXISTING FIXTURE TO BE REFURBISHED. REMOVE FINISHES THOROUGHLY CLEAN AND RESTORE AS COMPACT FLUORESCENT LAMP.
- ⑤ CUSTOM LIGHT TROUGH REFER TO ARCHITECTURAL DETAILS FOR SPECIFICATIONS AND INSTALLATION REQUIREMENTS. REFER TO LIGHT FIXTURE SCHEDULE FOR LAMPING.
- ⑥ PROVIDE WITH FLANGE FOR PLASTER CEILING.

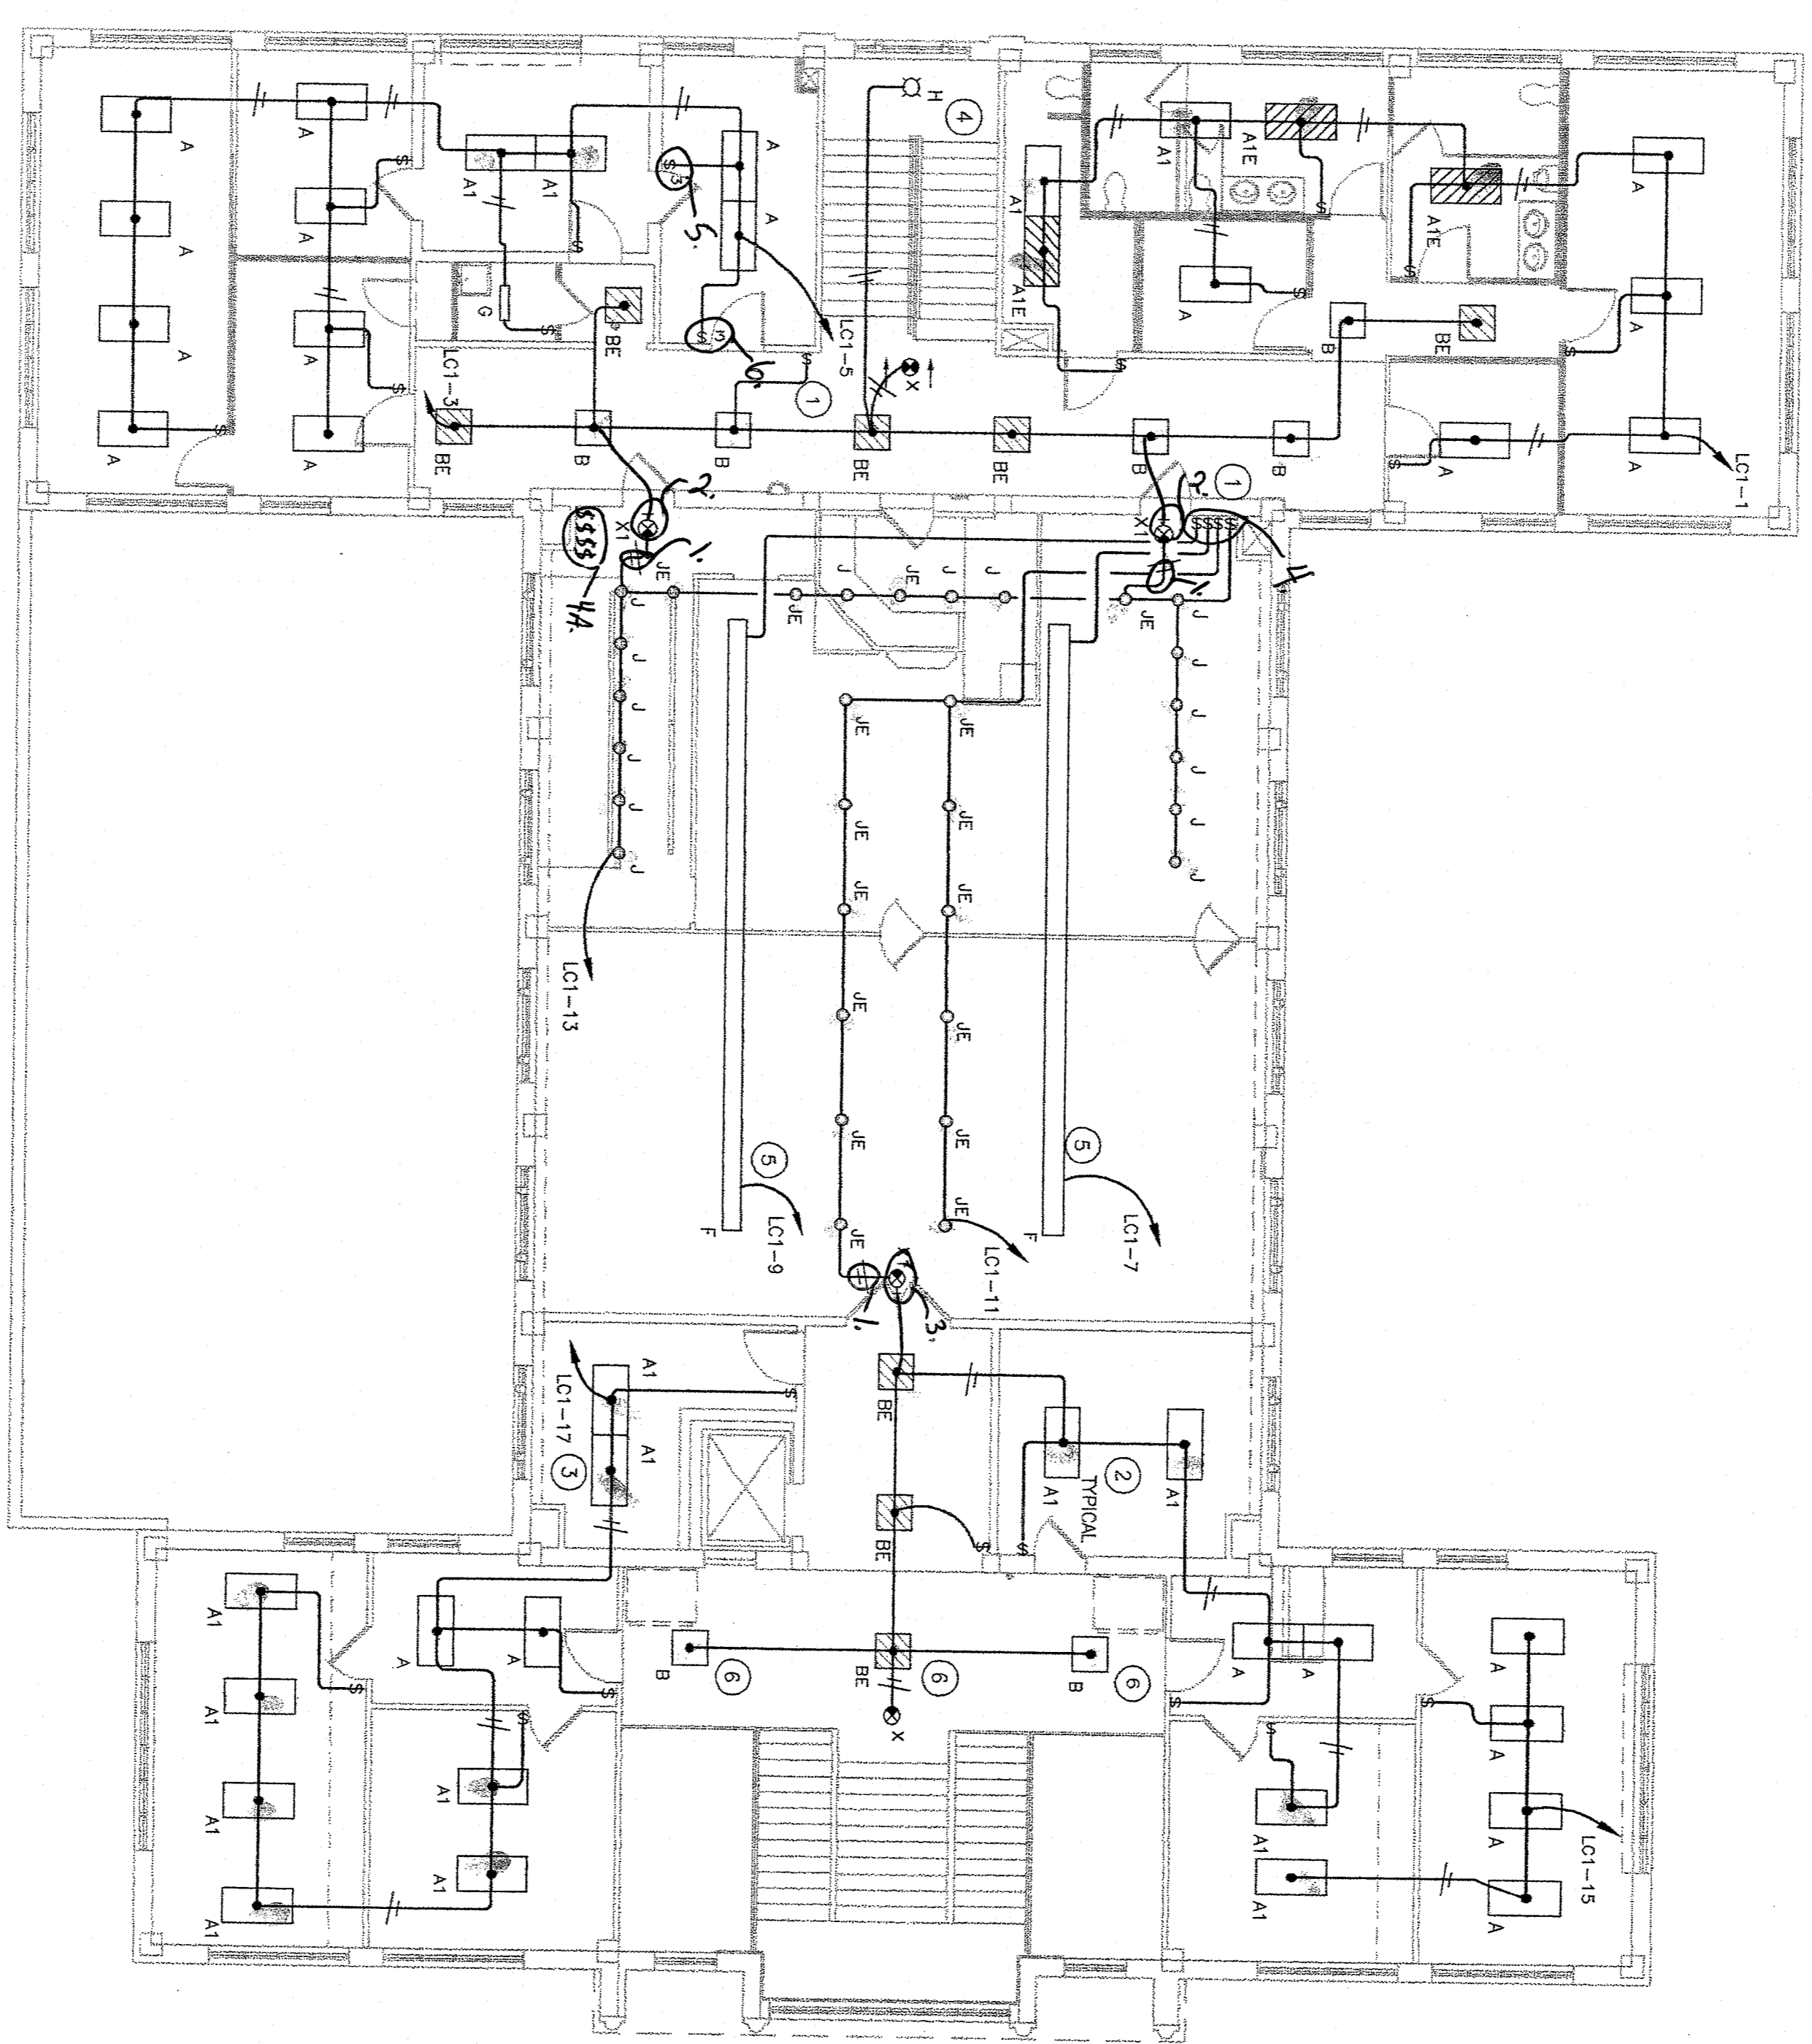

- 1 Deleted
- 2 Added to LCI-3
- 3 Added to LCI-15
- 4 Relocated to South side of Room see 4A
- 5 Deleted
- 6 Changed to single pole Switch.


0 1 SECOND FLOOR PLAN - LIGHTING
SCALE: 1/8" = 1'-0"

MYERS & ASSOCIATES
3-28-02

This document, the ideas herein are and shall remain the property of Myers & Associates. These documents shall not be used, in whole or in part, for other than the original intended use, nor any third party without written permission from Myers & Associates.
M & A Job no.: 01-003

Sheet Title:
SECOND FLOOR PLAN LIGHTING

Project:
BURNETT COUNTY COURTHOUSE

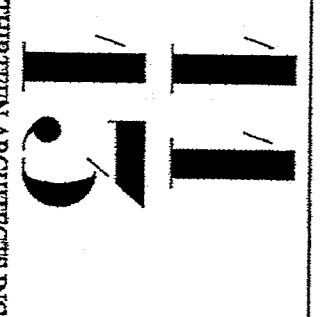

ELLEN THARTER ARCHITECTS INC.
807 S. ROCK SUITE 102
GROBERTOWN, TEXAS 78626
TEL: 512.699.1104 FAX: 512.699.1262


Date: 03/18/2002
Proj. #: 03182002
Drawn by: MA
Issued for: BID

E1.3

KEYED NOTES

THESE NOTES APPLY TO THIS SHEET ONLY

- 1 EXISTING PANEL TO BE REPLACED WITH NEW PANEL "JA".
- 2 EXISTING PANEL TO BE REPLACED WITH NEW PANEL "JA". THIS PANEL TO BE FOR ALL TELEPHONE AND DATA LOCATED IN SAME ROOM. COORDINATE WITH CHRIS LAWRENCE WITH HUBCABELE AT 817-377-2989 FOR EQUIPMENT ELECTRICAL REQUIREMENTS.
- 3 PROVIDE 6 RECESSED DUPLEX RECEPTACLES IN EACH ROOM. RE-USE EXISTING RECESSED JUNCTION BOXES AND CONCEALED CONDUIT AS MUCH AS POSSIBLE. REQUIREMENTS PRIOR TO ANY WORK.
- 4 MOUNT DISCONNECTS FOR WH-3 UNDER CABINET ADJACENT TO WATER HEATER. REQUIREMENTS PRIOR TO ANY WORK.
- 5 CONNECTION TO EXISTING LIFT STATION PUMP. VERIFY EXACT ELECTRICAL REQUIREMENTS PRIOR TO ANY WORK.
- 6 CONNECTION TO EXISTING SLUMP PUMP. VERIFY EXACT ELECTRICAL REQUIREMENTS PRIOR TO ANY WORK.
- 7 COORDINATE DISTRIBUTION FEEDERS FROM BASEMENT TO FIRST AND SECOND FLOOR WITH ARCHITECT.


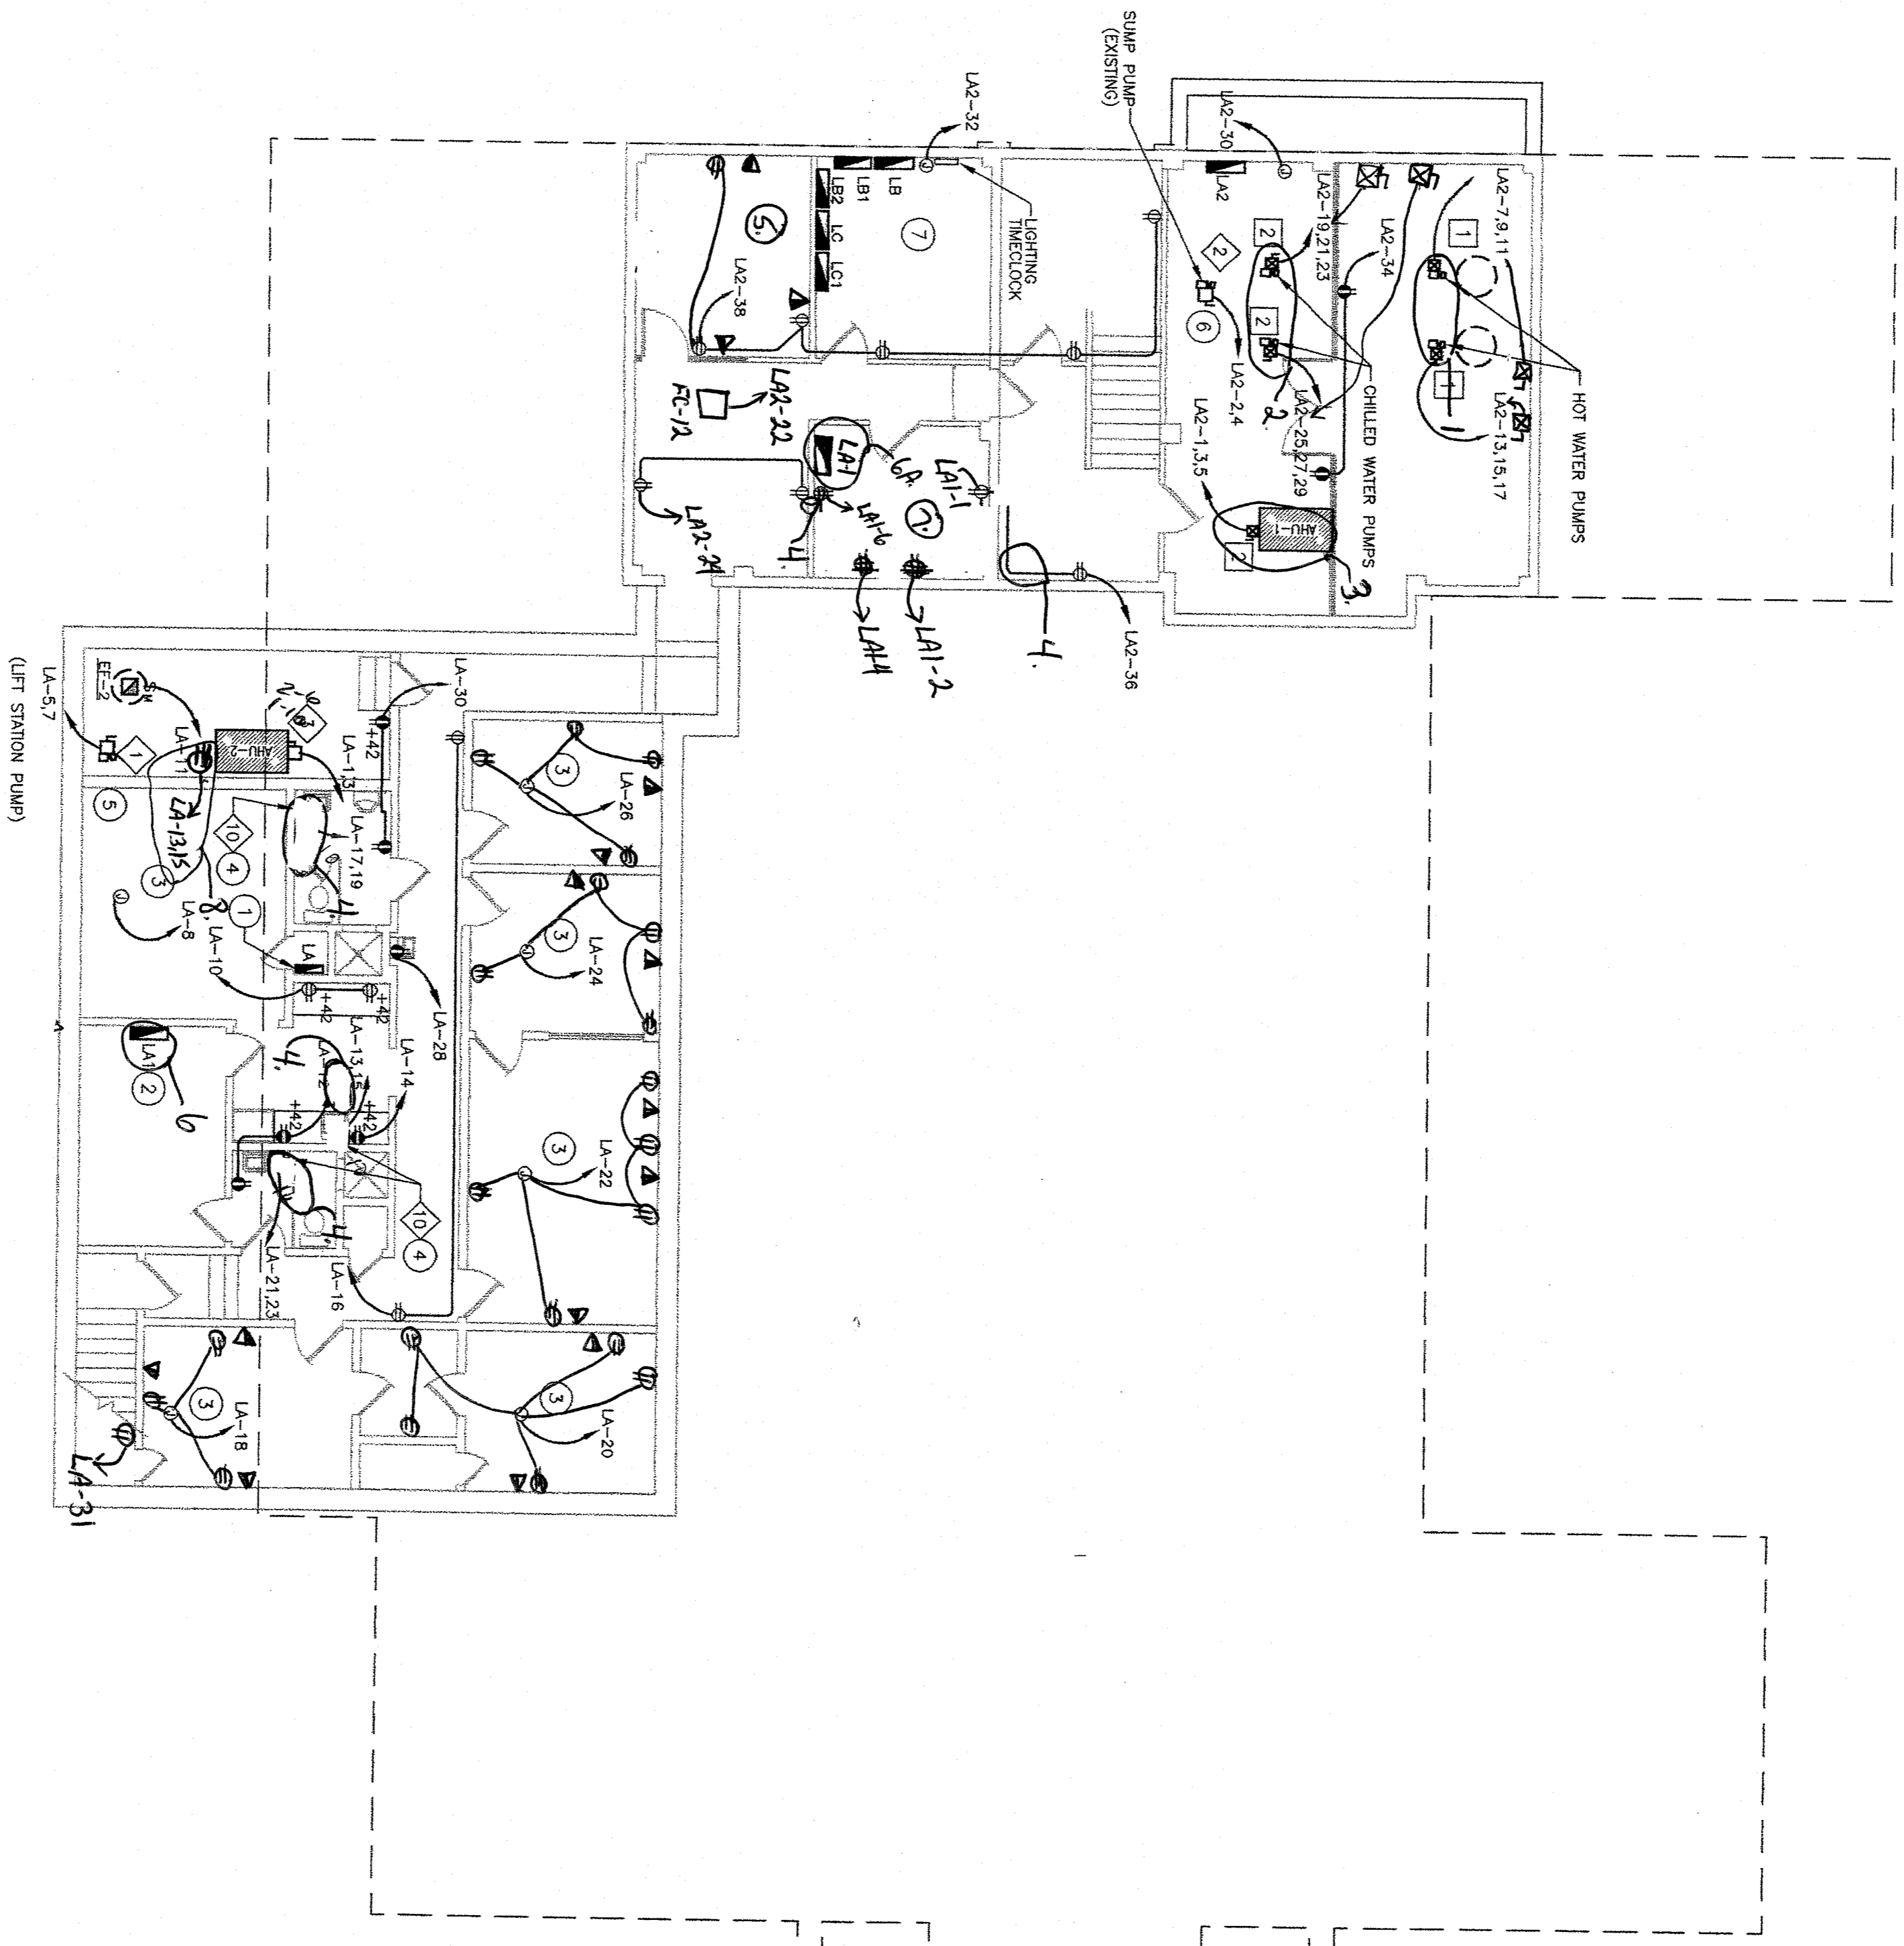


ALL NEW CONDUIT IN EXISTING WALLS TO BE RUN VERTICALLY FROM EACH BOX TO ABOVE CEILING. SAW-CUT AS REQUIRED. NO CONDUIT TO BE RUN HORIZONTALLY EXCEPT ABOVE CEILING.

1. Relocated to North wall Rm. 001
2. Relocated to West wall Rm. 001
3. Relocated to center of Rm. 001E
4. Deleted
5. Rm. 004 Add one outlet and three data
6. Relocate Panel LH1 to Rm. 005 See 6A
7. Remove one duplex outlet and add three Quads.
8. Added outlet for 60g. water Heater

01 BASEMENT FLOOR PLAN - POWER

SCALE: 1/8" = 1'-0"

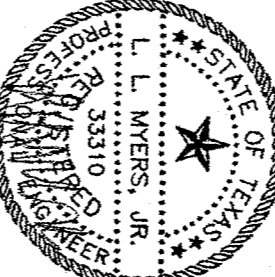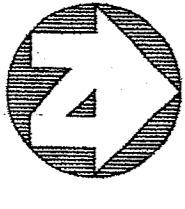

3-14-02

MYLERS & ASSOCIATES

This document, the ideas and designs incorporated herein are the property of Mylers & Associates. These documents are not to be used or altered, in whole or in part, without the written consent of Mylers & Associates. The © symbol is the property of Mylers & Associates. M & A Job No: 01-0033

Sheet Title:
BASEMENT FLOOR PLAN POWER

Project:
BURNETT COUNTY COURTHOUSE


11

ELWYN THIBERTS ARCHITECTS INC.

807 S. ROCK SPRING RD.
GEORGETOWN, TEXAS 78656
TEL. 512.869.1104 FAX 512.869.1362

E1.4

Date: 03/18/2002
Proj. #
Drawn by: MA
Issued for: BID

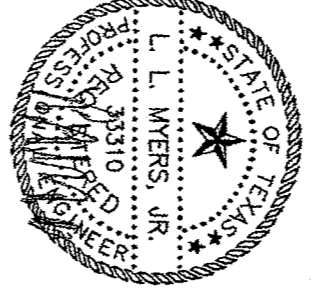

3-28-02

MYERS & ASSOCIATES

This document, the ideas herein, or any part thereof shall remain the property of Myers & Associates, and shall not be reproduced, copied, or altered, in whole or in part, for other than the original intended use, nor any third party without written permission from Myers & Associates. © M & A, job no.: 01-003


Sheet Title:
**FIRST FLOOR PLAN
POWER**

Project:
BURNETT COUNTY COURTHOUSE

11
15

ELBYN THRENTON ARCHITECTS, INC.
877 S. ROCK STREET, 102
GROGHTOWN, TEXAS 78666
TEL: 512/869-1104 FAX: 512/869-1562

Date: 03/18/2002
Proj. #: **E1.5**
Drawn By: MA
Issued For: BID

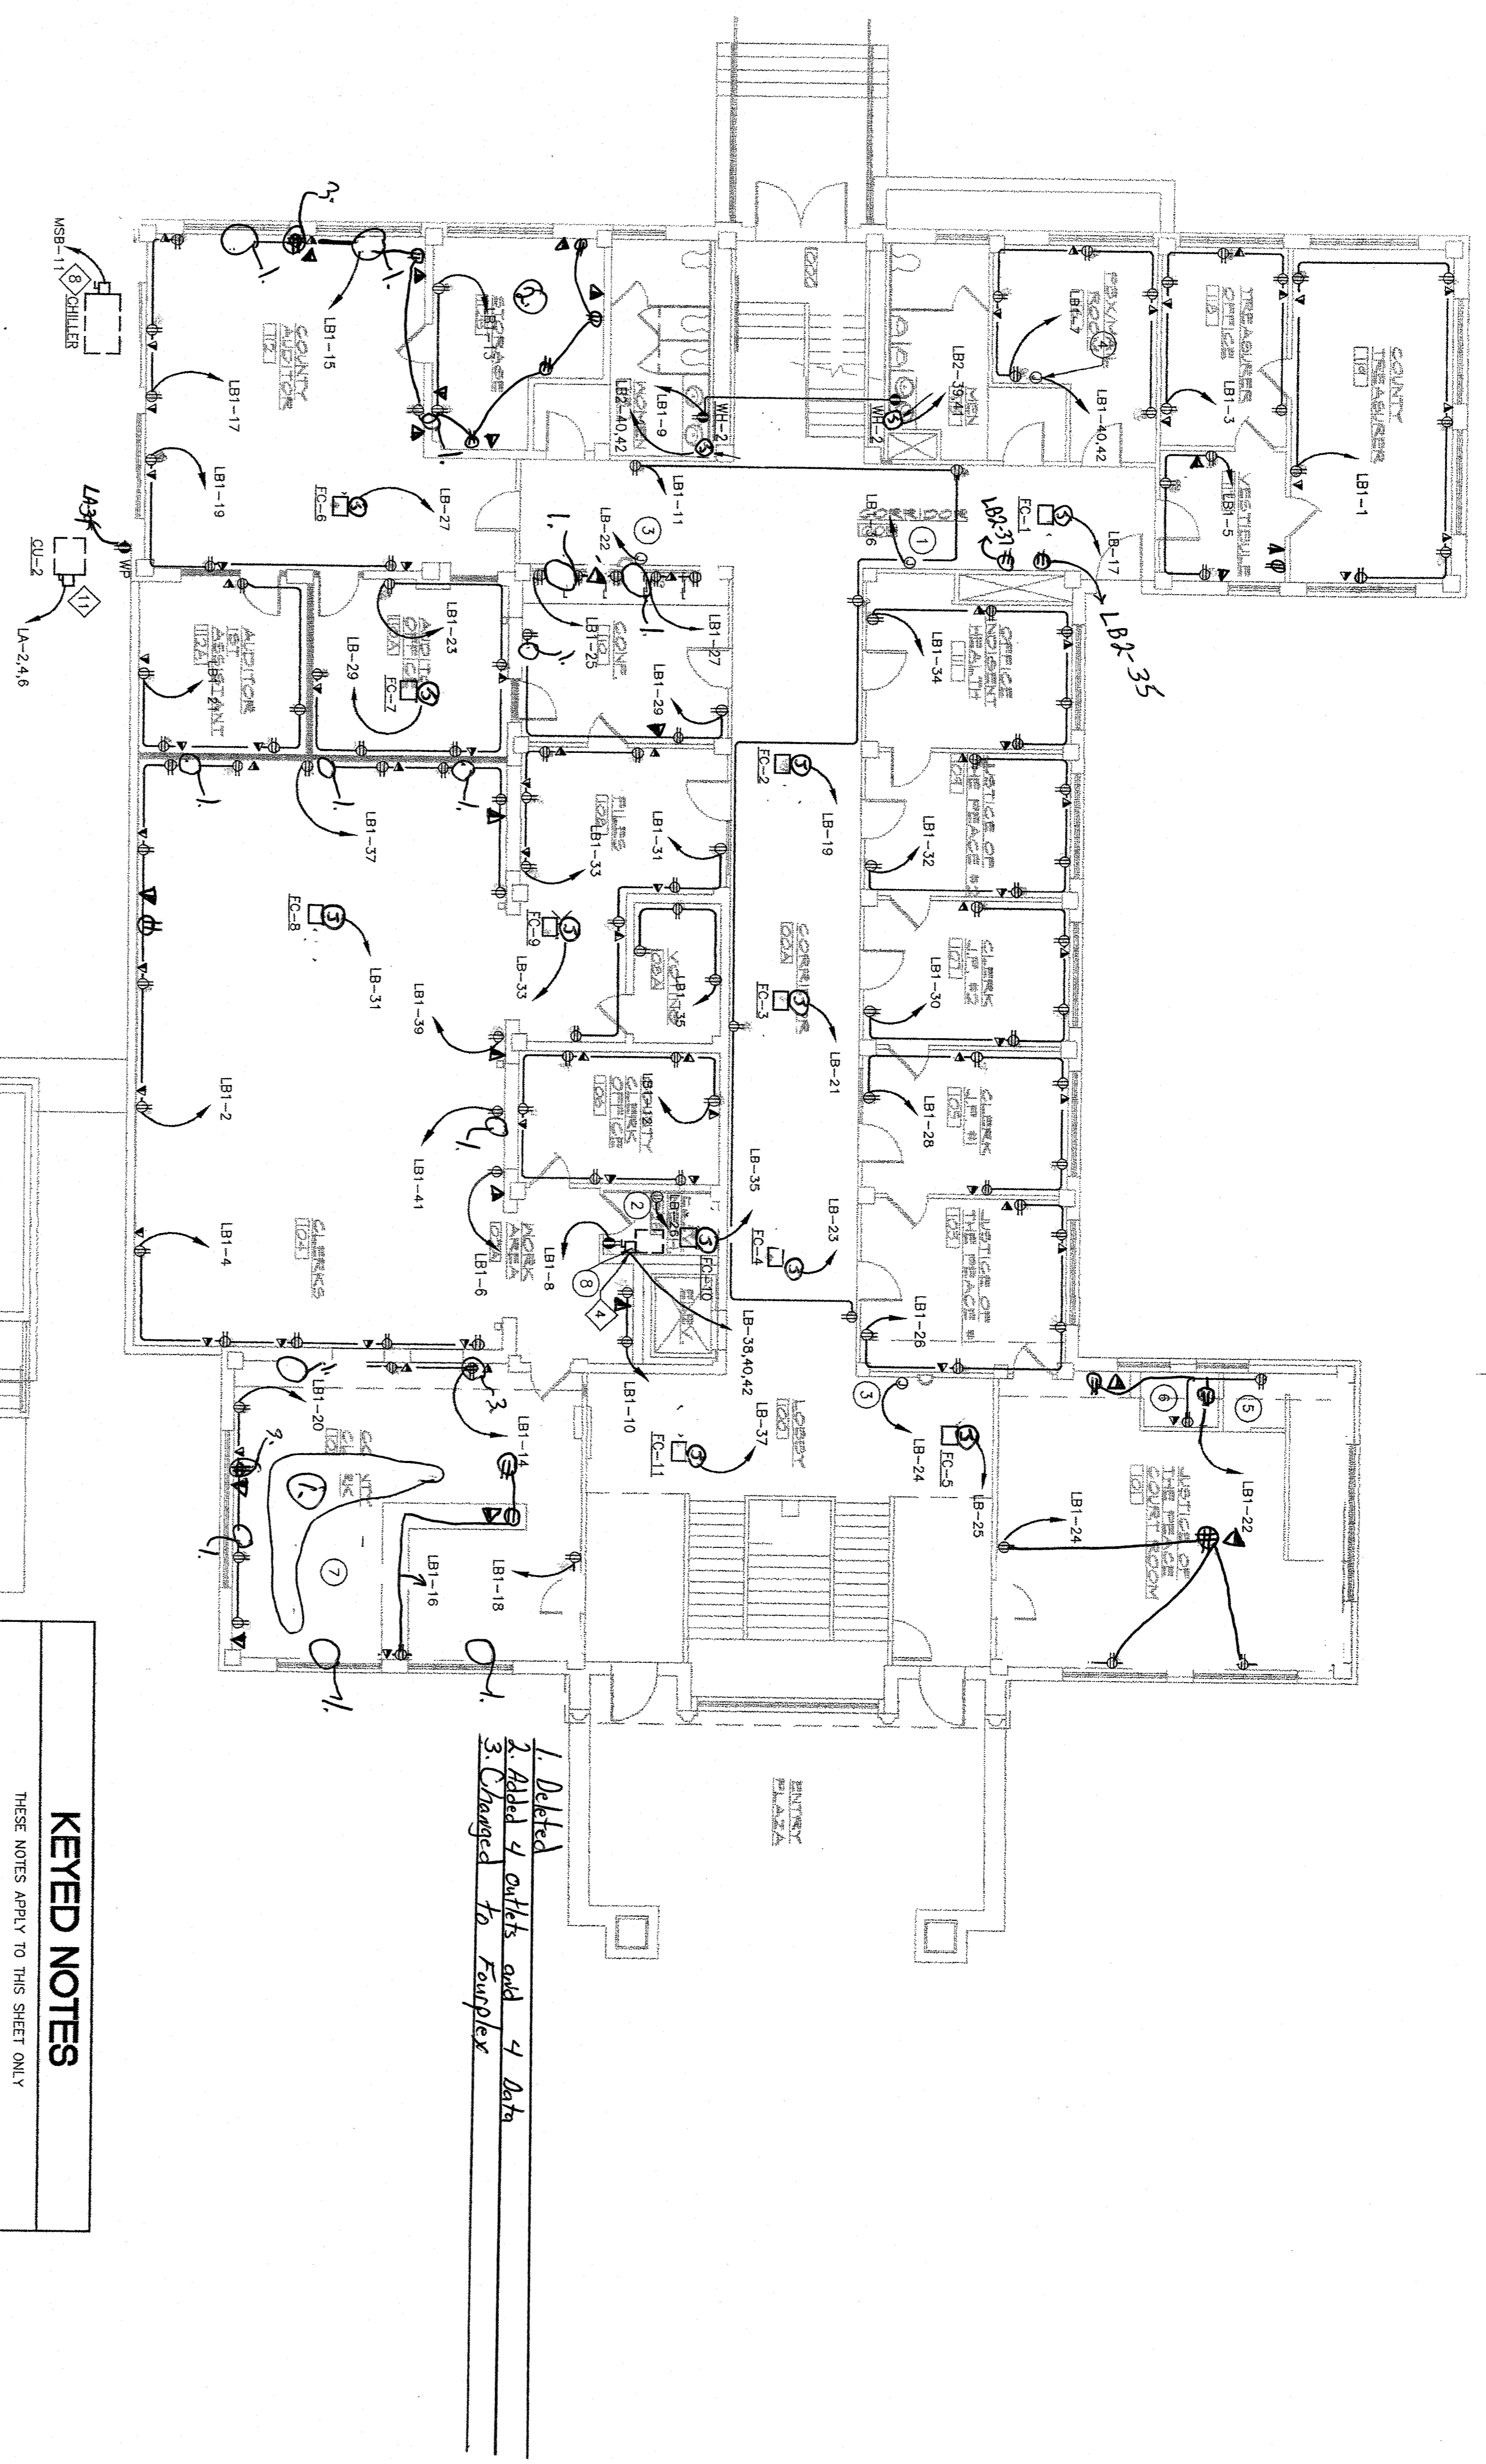

KEYED NOTES


THESE NOTES APPLY TO THIS SHEET ONLY.


- 1 FOR CONNECTION TO FACP.
- 2 PROVIDE LOCKABLE ENCLOSED CIRCUIT BREAKER, SQUARE D #00120 CIRCUIT BREAKER FOR CONNECTION TO ELEVATOR CAB LIGHTS AND VENTILATION FAN.
- 3 MOUNT JUNCTION BOX ABOVE CEILING FOR CONNECTION TO WATER PUMP COMPRESSOR. VERIFY EXACT ELECTRICAL REQUIREMENTS FROM TO ANY WORK.
- 4 FOR CONNECTION TO COPPER. COORDINATE WITH OWNER FOR EXACT REQUIREMENTS.
- 5 FOR CONNECTION TO MICROPHONE AND ALARM. COORDINATE WITH OWNER FOR EXACT MOUNTING AND ELECTRICAL REQUIREMENTS.
- 6 LOCATE DEVICES IN MILLWORK. COORDINATE EXACT LOCATION WITH OWNER.
- 7 EXISTING FLOOR BOXES. PROVIDE NEW DEVICES AND BRASS COVERPLATES. CIRCUIT AS SHOWN ON PLAN.
- 8 EXISTING ELEVATOR MOTOR. PROVIDE NEW DISCONNECT WITH AUXILIARY CONTACT WITH INTERFACE FOR FIRE ALARM. REFER TO DISCONNECT SCHEDULE.
- 9

ALL NEW CONDUIT IN EXISTING WALLS TO BE RUN VERTICALLY FROM EACH BOX TO ABOVE CEILING. SAW-CUT AS REQUIRED. NO CONDUITS TO BE RUN HORIZONTALLY EXCEPT ABOVE CEILING AND IN NEW WALLS.

01 FIRST FLOOR PLAN - POWER

SCALE 1/8" = 1'-0"

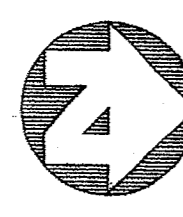

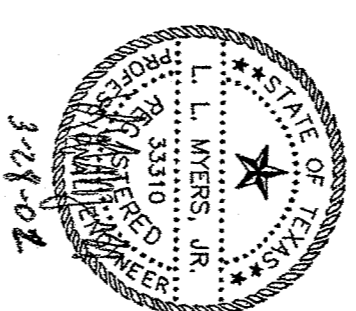

3/28/02

MYERS & ASSOCIATES

This document, the Plans and designs incorporated herein are and shall remain the property of Myers & Associates. These Plans and designs are not to be used or altered, in whole or in part, for any other project or original intended use, nor are they to be assigned to any other person without the written permission from Myers & Associates.

M & A job no. 01-003


Sheet Title
SECOND FLOOR PLAN POWER

Project
BURNET COUNTY COURTHOUSE



ELLEN THURTELL ARCHITECTS, INC.
 1115 BURNET STREET
 GEORGETOWN, TEXAS 78624
 TEL. 512.869.1104 FAX 512.869.1342

Date: 03/18/2002
 Proj #
 Drawn by: MA
 Checked by: BDD
 Scale: **E1.6**

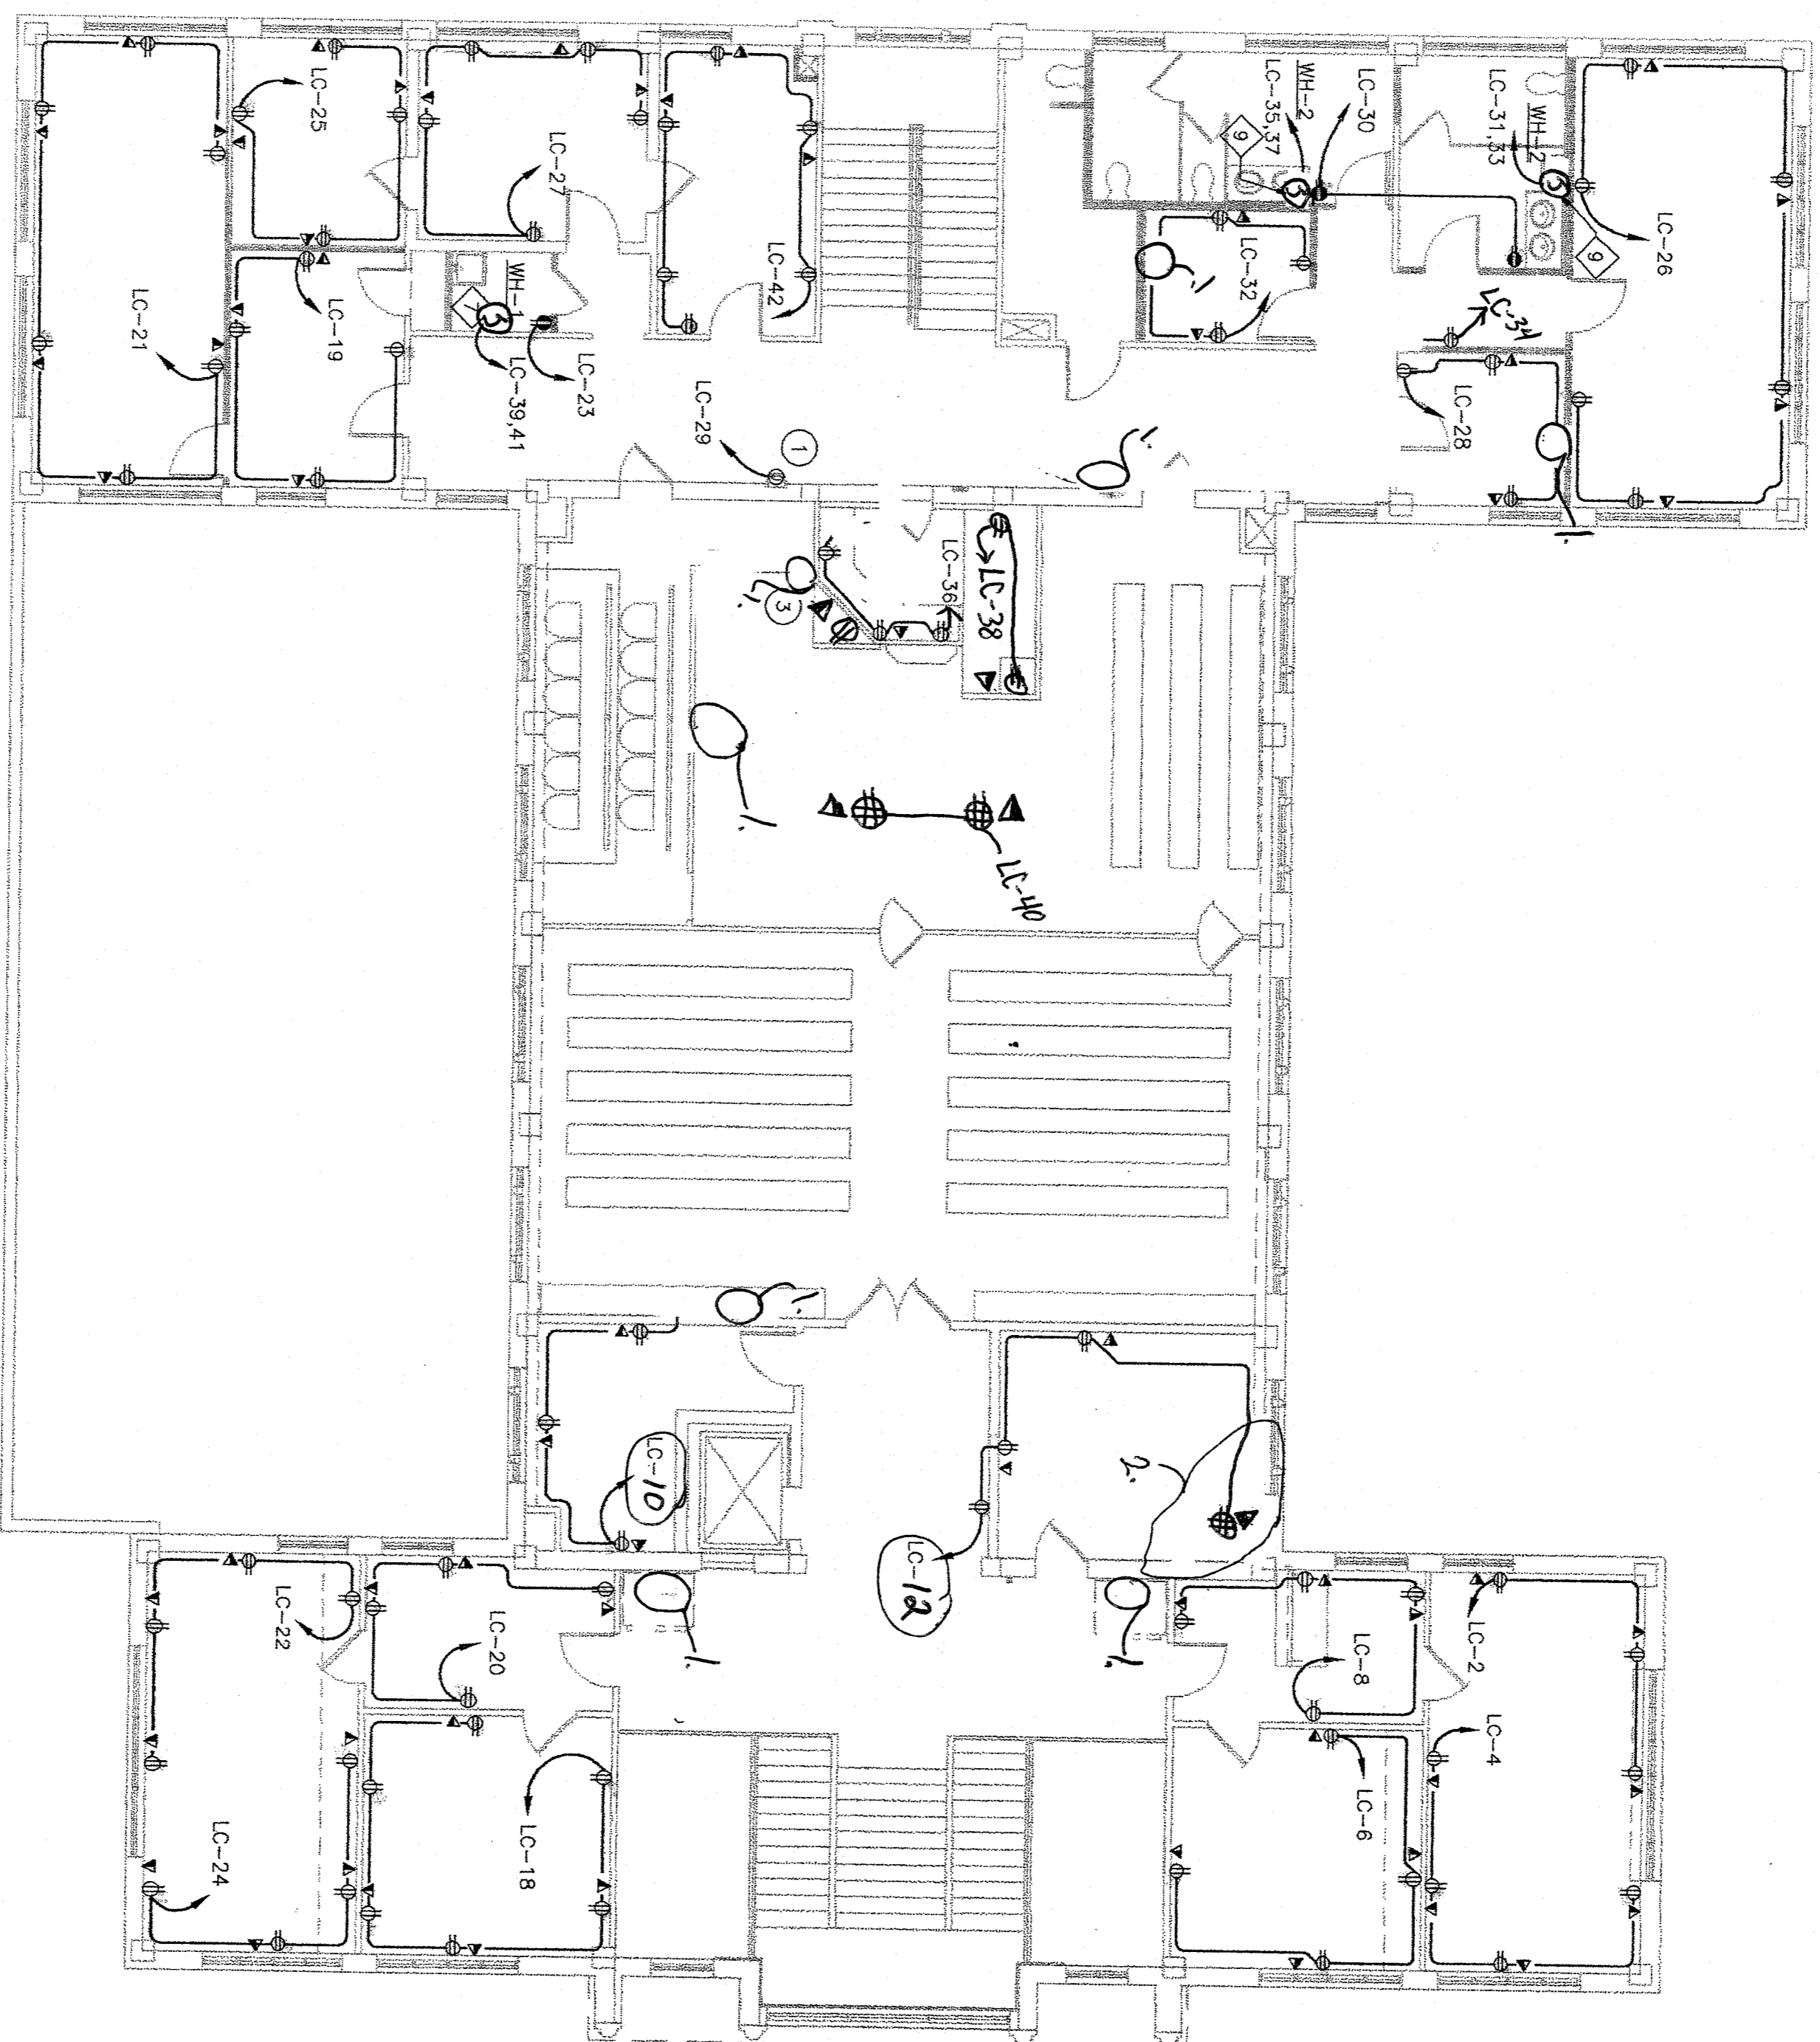


1. Deleted
 2. Deleted two Angler receptacles and added one GPOUT.

KEYED NOTES

THESE NOTES APPLY TO THIS SHEET ONLY

- 1 MOUNT JUNCTION BOX ABOVE CEILING FOR CONNECTION TO REMOVE WATER FROM ANY WORK.
- 2 MOUNT RECEPTACLE IN REAR OF JURY BOX. VERIFY EXACT LOCATION WITH OWNER PRIOR TO ANY WORK.
- 3 MOUNT RECEPTACLE IN REAR OF WITNESS BOX. VERIFY EXACT LOCATION WITH OWNER PRIOR TO ANY WORK.
- 4 FOR CONNECTION TO MICROPHONE AND ALARM. COORDINATE WITH OWNER FOR EXACT REQUIREMENTS. MOUNT ALL DEVICES IN JUDGE'S STAND AS DIRECTED BY OWNER.

ALL NEW CONDUIT IN EXISTING WALLS TO BE RUN VERTICALLY FROM EACH BOX TO ABOVE CEILING. SAW-CUT AS REQUIRED. NO CONDUIT TO BE RUN HORIZONTAL EXCEPT ABOVE CEILING AND IN NEW WALLS.

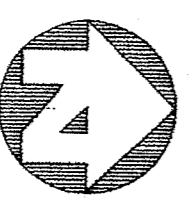


01 SECOND FLOOR PLAN - POWER
 SCALE 7/8" = 1'-0"

KEYED NOTES


THESE NOTES APPLY TO THIS SHEET ONLY

- ① PROVIDE AND INSTALL NEW LIGHTNING PROTECTION SYSTEM PER SECTION 16451 OF ELECTRICAL SPECIFICATIONS.
- ② REDISTAL MOUNTED PANEL "LP" FEEDER FROM "MS" TO BE RUN THROUGH EXISTING CHASE FROM BASEMENT TO ROOF LOCATED APPROXIMATELY WHERE PANEL IS SHOWN ON PLAN.

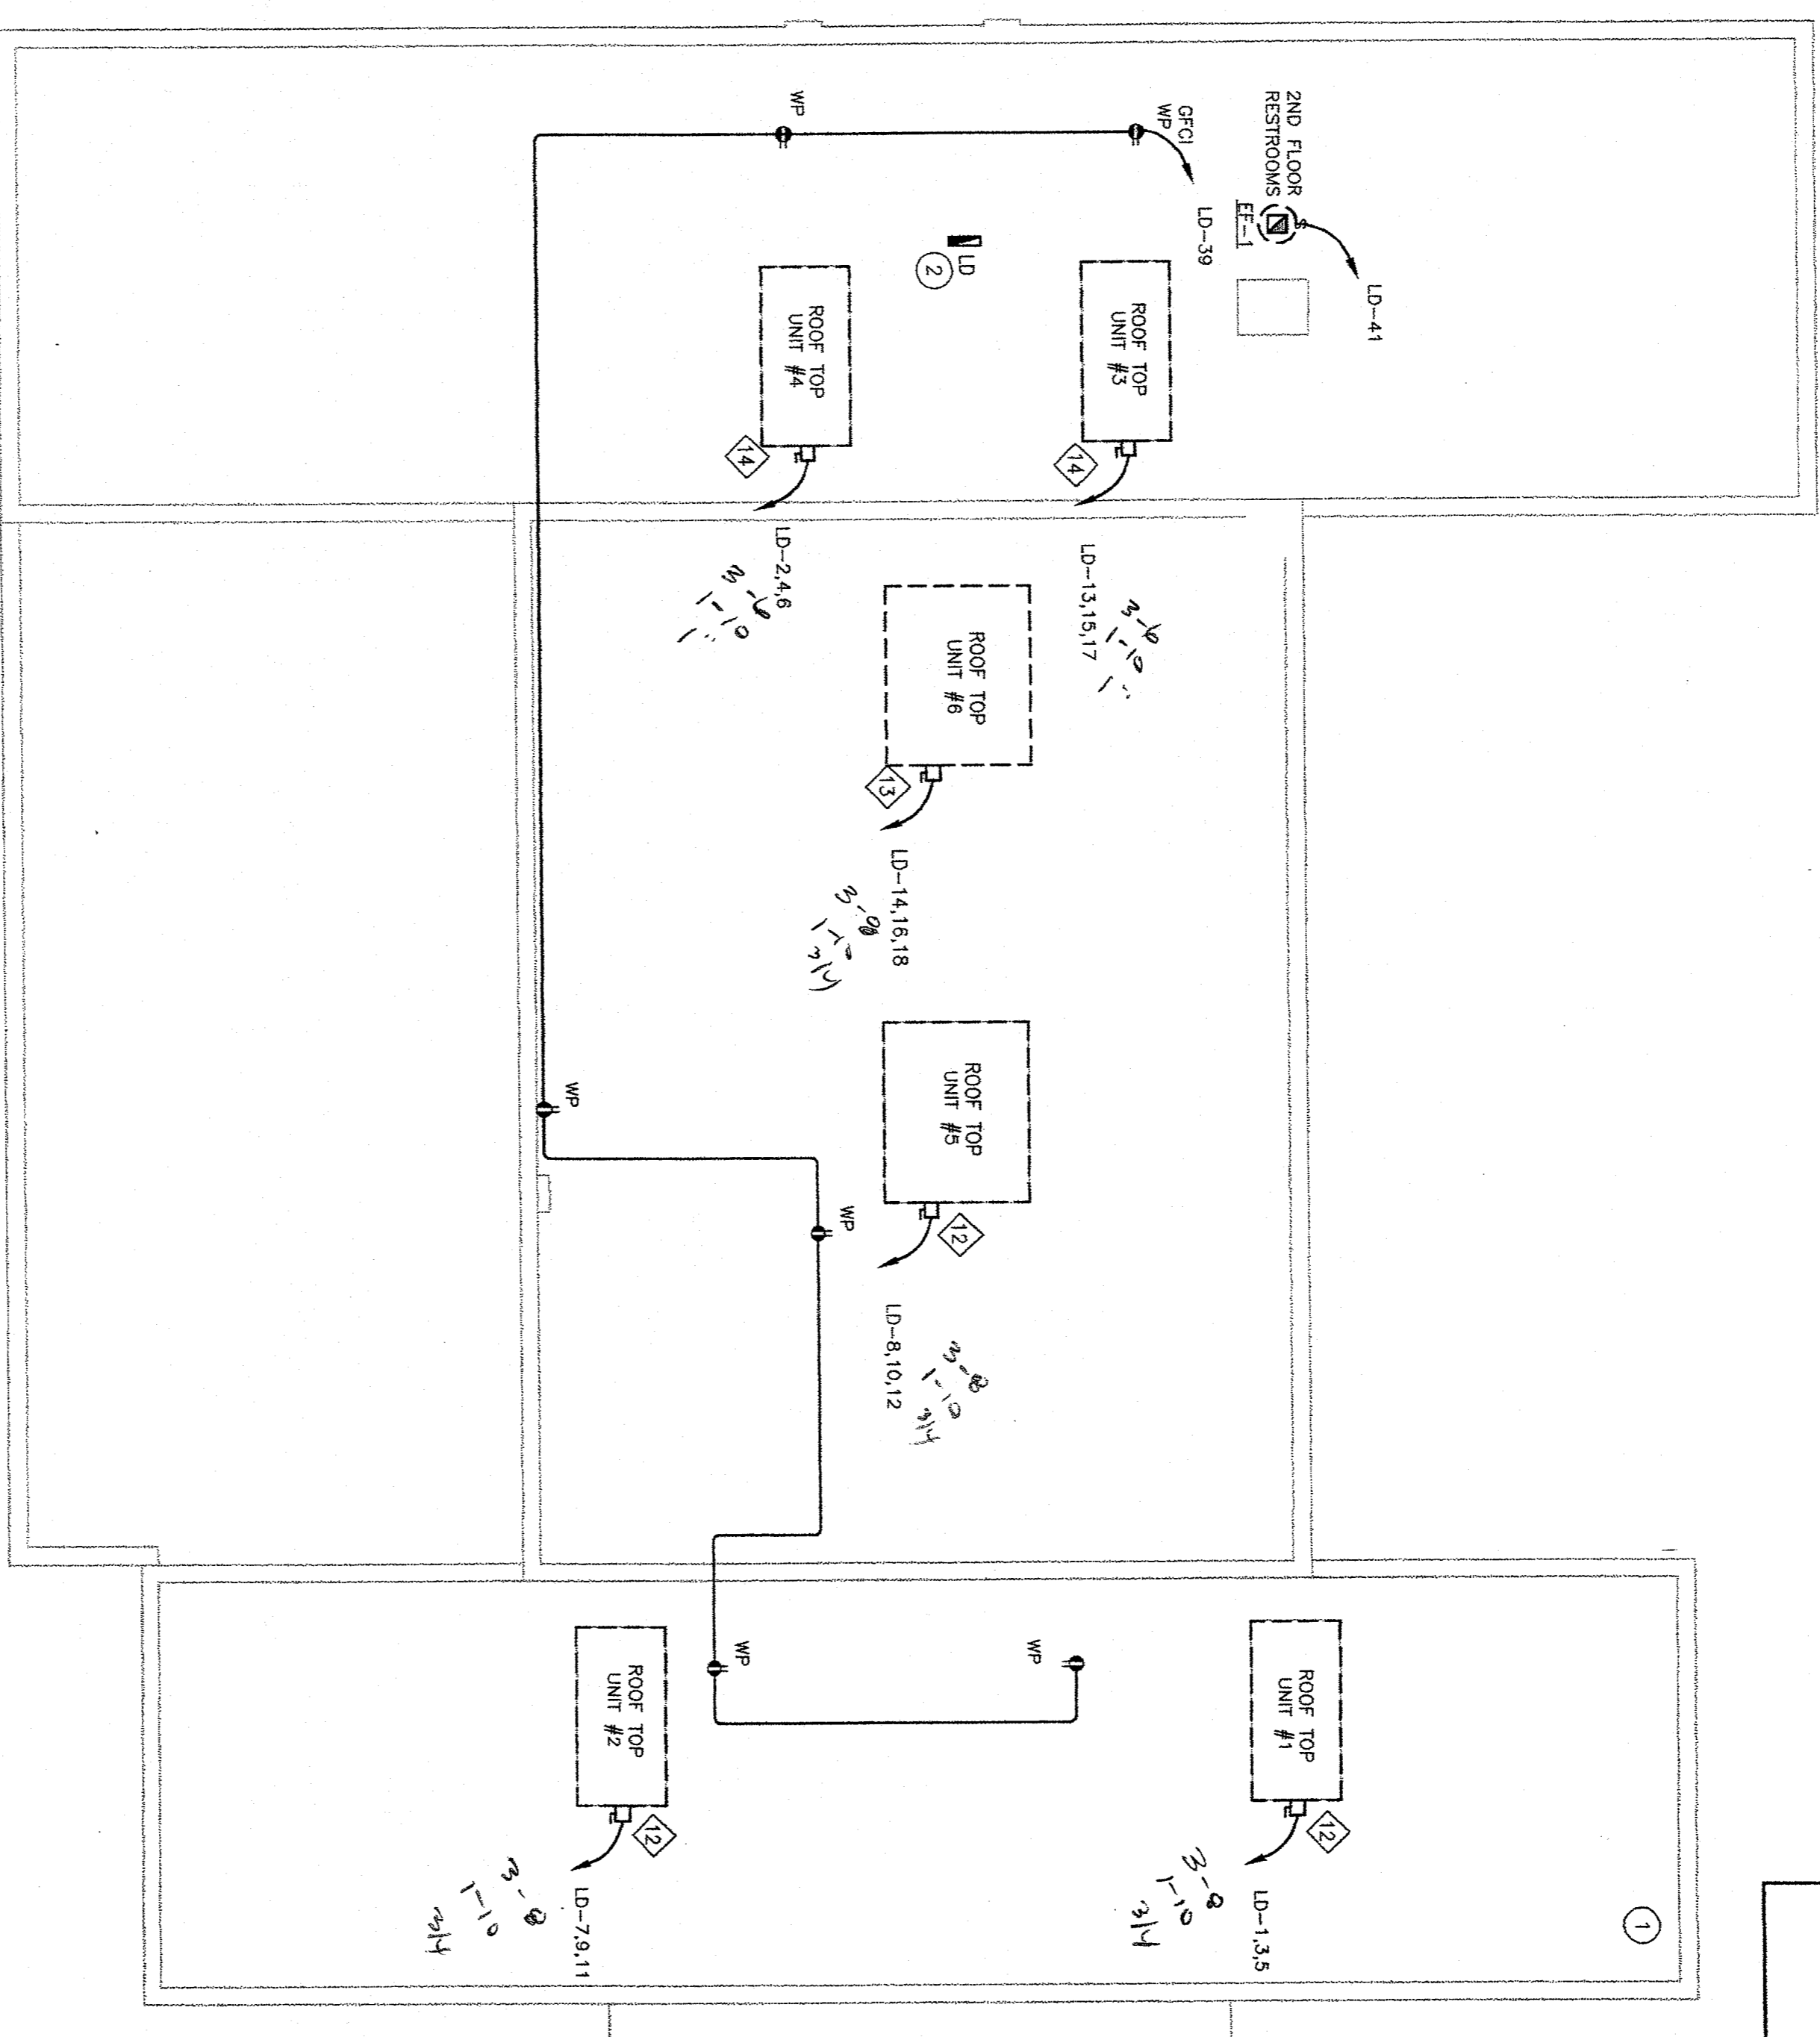

01 ROOF PLAN - POWER

SCALE: 1/8" = 1'-0"

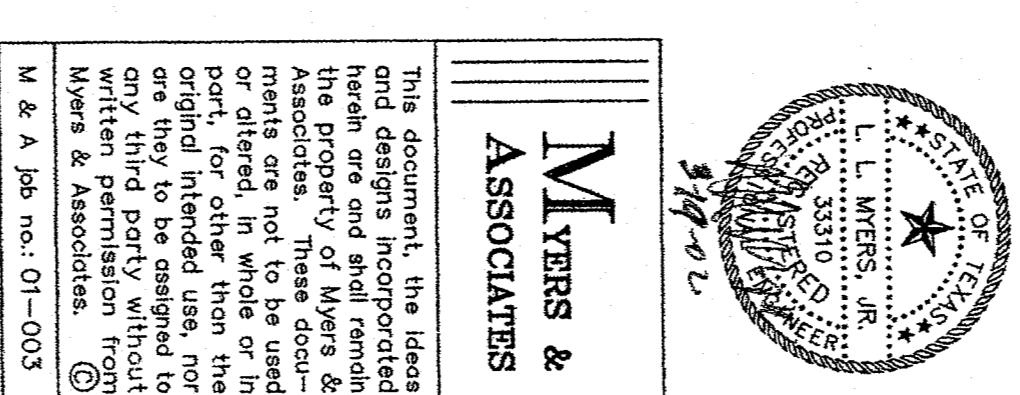

MYERS & ASSOCIATES

This document, the ideas and designs incorporated herein are and shall remain the property of Myers & Associates. No part of this document or any part thereof shall be used or altered in whole or in part, for other than the original project, without the written permission of Myers & Associates. M & A Job no.: 01-003

Roof Plan Power

Project:
**BURNETT
COUNTY
COURTHOUSE**

HELVEN THIRTEEN ARCHITECTS INC.
807 S. ROCK SOUTH DR.
GERRYSTOWN, TEXAS 75846
TEL: 512.861.1104 FAX: 512.861.1882

**11
13**

E1.7

Date: 03/18/2002
Proj #
Drawn by: MA
Issued for: BID

DISCONNECT SWITCH SCHEDULE

REMARKS:
COORDINATE PANEL RISE SIZES WITH EQUIPMENT BEING PROVIDED.
VERIFY EXISTING EQUIPMENT DISCONNECT AND RISE SIZES.

VOLTAGE	AMPERES RATING	POLES	ENCL.	FUSES	REMARKS
120		2	NEMA 1	10A	
240		2	NEMA 3R	10A	
277		2	NON-FUSED		
480		2	NON-FUSED		
1 PHASE		2			
3 PHASE		3			
50		2			
100		2			
200		2			
400		2			
800		2			
1		2			
2		2			
3		2			
4		2			
5		2			
6		2			
7		2			
8		2			
9		2			
10		2			
11		2			
12		2			

Not used

ELECTRICAL LOAD ANALYSIS

NOTES:

- LIGHTING LOAD: 28.1 KW x 1.25 = 35.1 KW
- RECREATION LOAD: 44.9 KW x 50% = 22.4 KW
- EQUIPMENT LOAD: 13.8 KW + 10 KW = 23.8 KW
 - A. A/C = 20.7 KW
 - B. HEAT = 14.8 KW
 - C. WATER HEATER(S) = 31.4 KW
 - D. ELEVATOR = 22.4 KW
 - E. MISCELLANEOUS = 29.8 KW
- KITCHEN LOAD: 0.0 KW
- 25% OF LARGEST MOTOR: 1.0 KW
- TOTAL CONNECTED LOAD (KW): 375.7 KW
- TOTAL CONNECTED LOAD (KVA): 417.4 KVA
- FUTURE LOAD: 417.4 KVA
- TOTAL AMP LOAD OF: 1548 AMPS AT 208 VOLT, 3 PHASE, 4 WIRE = 517.4 KW

REMARKS: 100% SERVICE
***PORTION OF FUTURE LOAD INCLUDES CONNECTION FOR CITY LIGHTS

COMBINATION STARTER/DISCONNECT SWITCH SCHEDULE

REMARKS:
COORDINATE PANEL RISE SIZES WITH EQUIPMENT BEING PROVIDED.


VOLTAGE	AMPERES RATING	NEMA SIZE	POLES	ENCL.	FUSES	REMARKS
120		1	2	NEMA 1		
240		2	2	NEMA 3R		
277		3	2	NON-FUSED		
480		4	2	NON-FUSED		
1 PHASE		1	2			
3 PHASE		3	3			
50		1	2			
100		2	2			
200		3	2			
400		4	2			
800		5	2			
1		1	2			
2		2	2			
3		3	2			
4		4	2			
5		5	2			
6		6	2			
7		7	2			
8		8	2			
9		9	2			
10		10	2			
11		11	2			
12		12	2			

SWITCHBOARD MBSB

65 K RMS SWB AMPS

LOCATION: 7400
MAIN SWITCH
422.3 KW
498 KW
TOTAL AMPS: 1304
TOTAL LOAD: 422.3 KW
DIVIDED BY 0.8 PF = 527.9 KW
TOTAL AMPS: 1304
FEEDER SIZE: 5 SETS (4 #400 KCMIL & 1# 600, IN 4" CONDUIT)

CR#	LOAD DESCRIPTION	LOAD KW	SWITCH SIZE	FUSE RATING	POLES	FEEDER SIZE
1	PANEL 1A-C	47	225	225/RM1	3	4#4/0 & 1#4 GND, IN 2 1/2" CONDUIT
2	PANEL 1A-C	9	225	225/RM1	3	4#4/0 & 1#4 GND, IN 2 1/2" CONDUIT
3	PANEL 1A-C	24	225	225/RM1	3	4#4/0 & 1#4 GND, IN 2 1/2" CONDUIT
4	PANEL 1B	61	225	225/RM1	3	4#4/0 & 1#4 GND, IN 2 1/2" CONDUIT
5	PANEL 1B	20	225	225/RM1	3	4#4/0 & 1#4 GND, IN 2 1/2" CONDUIT
6	PANEL 1B-C	14	100	100/RM1	3	4#4/0 & 1#4 GND, IN 1 1/2" CONDUIT
7	PANEL 1B-C	28	225	225/RM1	3	4#4/0 & 1#4 GND, IN 2 1/2" CONDUIT
8	PANEL 1D	13	100	100/RM1	3	4#4/0 & 1#4 GND, IN 1 1/2" CONDUIT
9	PANEL 1D	80	400	400/RM1	3	2 SETS (4#5/0 & 1#6 GND, IN 2" CONDUIT)
10	CHILLER	96.6	400	350/RM1	3	2 SETS (4#5/0 & 1#6 GND, IN 2" CONDUIT)
11	EXISTING CITY LIGHTING PANEL	400	400	400/RM1	3	2 SETS (4#5/0 & 1#6 GND, IN 2" CONDUIT)
12	SPARE	20	225	225/RM1	3	

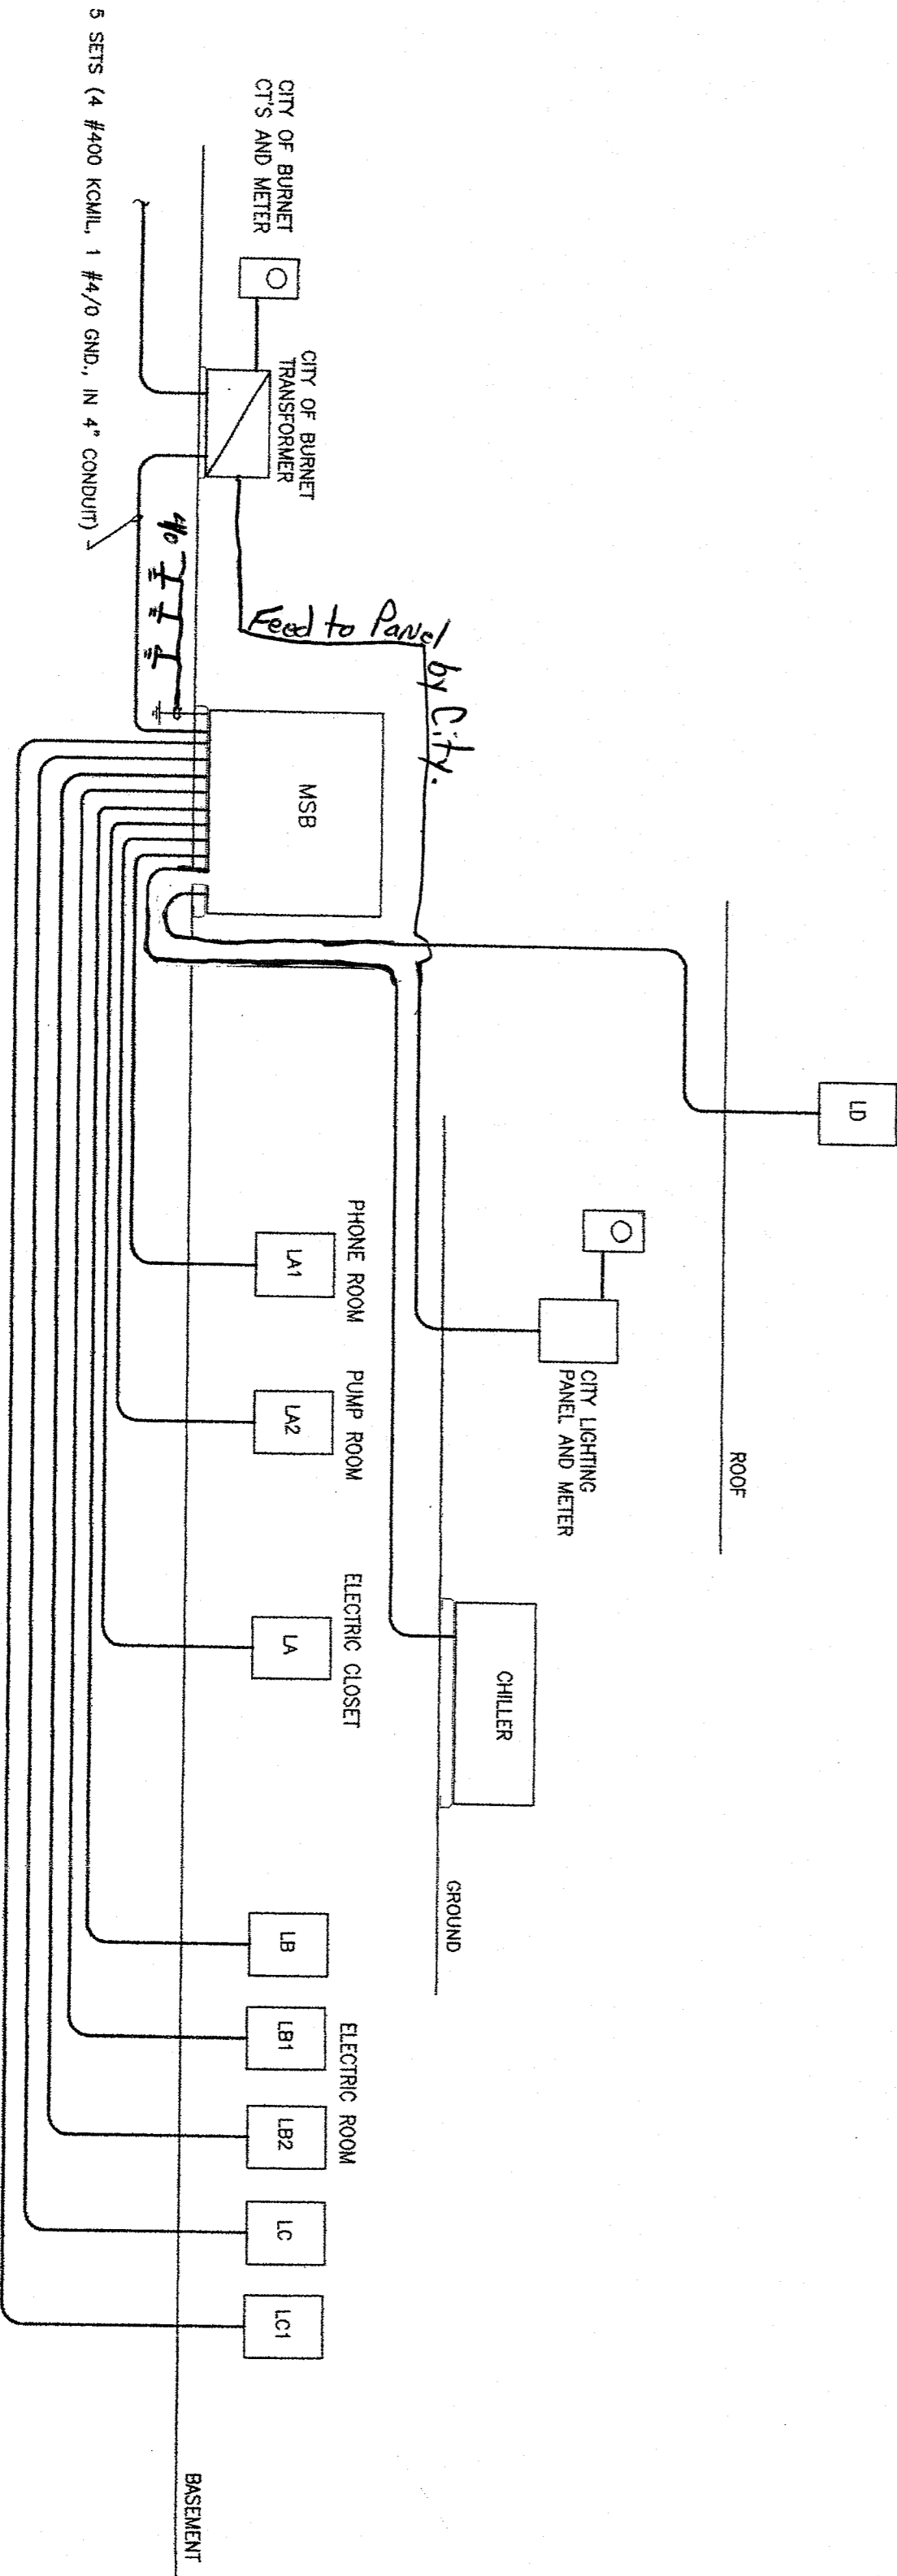


01 ELECTRICAL RISER DIAGRAM

SCALE: N.T.S.

M
YERS &
ASSOCIATES

This document, the ideas and designs incorporated herein, are the property of Myers & Associates. These documents are not to be used, copied, or reproduced in any form, for other than the original intended use, nor are they to be assigned, loaned, or otherwise disseminated without the written permission from Myers & Associates.

M & A job no.: 01-003

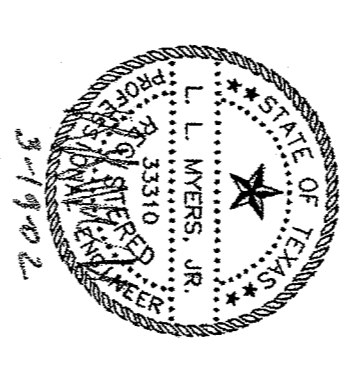

Sheet:
ELECTRICAL RISER DIAGRAM

Project:
BURNET COUNTY COURTHOUSE

11

ELLYN HARTMAN ARCHITECTS, INC.
807 S. ROCK SUTTE 102
GROESBECK, TEXAS 76636
TEL 512.869.1104 FAX 512.869.1842

E1.10

Date: 03/18/2002
Proj #
Drawn by: MA
Issued for: BID